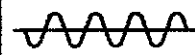
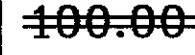


FED. ROAD DIST. NO.	STATE	FED.AID PROJ. NO.	FISCAL YEAR	SHEET NO.	TOTAL SHEETS
HAWAII	HAW.	STP-250(006)	2011	19	20

PAVEMENT REPAIR AREA SCHEDULE							
PROJECT NO. (HWY.SECTION)	STATION		OFFSET FROM RD. C TO CENTER RECON. AREA (L.F.)		LENGTH (L.F.)	WIDTH (L.F.)	APPROX. AREA (SQ. FT.)
	FROM	TO	LEFT	RIGHT			
FAP E-11A (250A)	642+39	642+75	2.0		34	4	136
	644+13	644+67	2.0		54	4	216
	647+50	647+80		2.0	30	4	120
	657+50	658+60	1.0		110	2	220
	659+00	659+50		2.5	50	5	250
	660+45	661+87	3.0		142	6	852
	662+50	663+00	2.5		50	5	250
	666+25	666+75		2.0	50	4	200
	677+20	677+50	3.0		30	6	180
	750+00	750+20	1.5		20	3	60
	753+50	753+65		2.0	15	4	60
	754+05	754+13	2.5		8	5	40
	763+14	763+30	3.0		16	6	96
	766+27	766+53		1.0	26	2	52
	770+00	770+31	5.0		31	10	310
	771+00	771+50	5.0		50	10	500
TOTALS							3,542.0

UTILITY SCHEDULE						
PROJECT	STATION	OFFSET FROM O.B.L. C		TYPE	REMARKS/COMMENTS	
		LEFT	RIGHT			
FAP E-11-A	760+60		20.3	WMH	2.0' dia.	NO ADJUSTMENT
	760+64		19.9	WMH	2.0' dia.	"
	760+65		24.0	WV	1.0' dia.	"
	760+67		21.3	WV	1.0' dia.	"
	773+10	13'0"		WV	1.0' dia.	RAISED
Legend : WMH - Water Manhole 2 Total WV - Water Valve 2 Total						

ORIGINAL PLAN	SURVEY PLOTTED BY	DATE
NOTE BOOK	DESIGNED BY	
	QUANTITIES BY	
	CHECKED BY	

LEGEND FOR AS-BUILT POSTINGS	
	Squiggly line for as-built deletion
	Double line for as-built deletion
Roadway	Text for as-built posting

STATE OF HAWAII DEPARTMENT OF TRANSPORTATION HIGHWAYS DIVISION
PAVEMENT REPAIR AREA AND UTILITY SCHEDULE
KOHALA MOUNTAIN ROAD PAVEMENT PREVENTIVE MAINTENANCE WAIAKA JUNCTION TOWARD HAWAII Federal Aid Project No. STP-250(006)
Date: April, 2011
SHEET No. 1 OF 1 SHEETS

"AS-BUILT"