




FED. ROAD DIST. NO.	STATE	FED. AID PROJ. NO.	FISCAL YEAR	SHEET NO.	TOTAL SHEETS
HAWAII	HAW.	STP-250(006)	2011	6	20

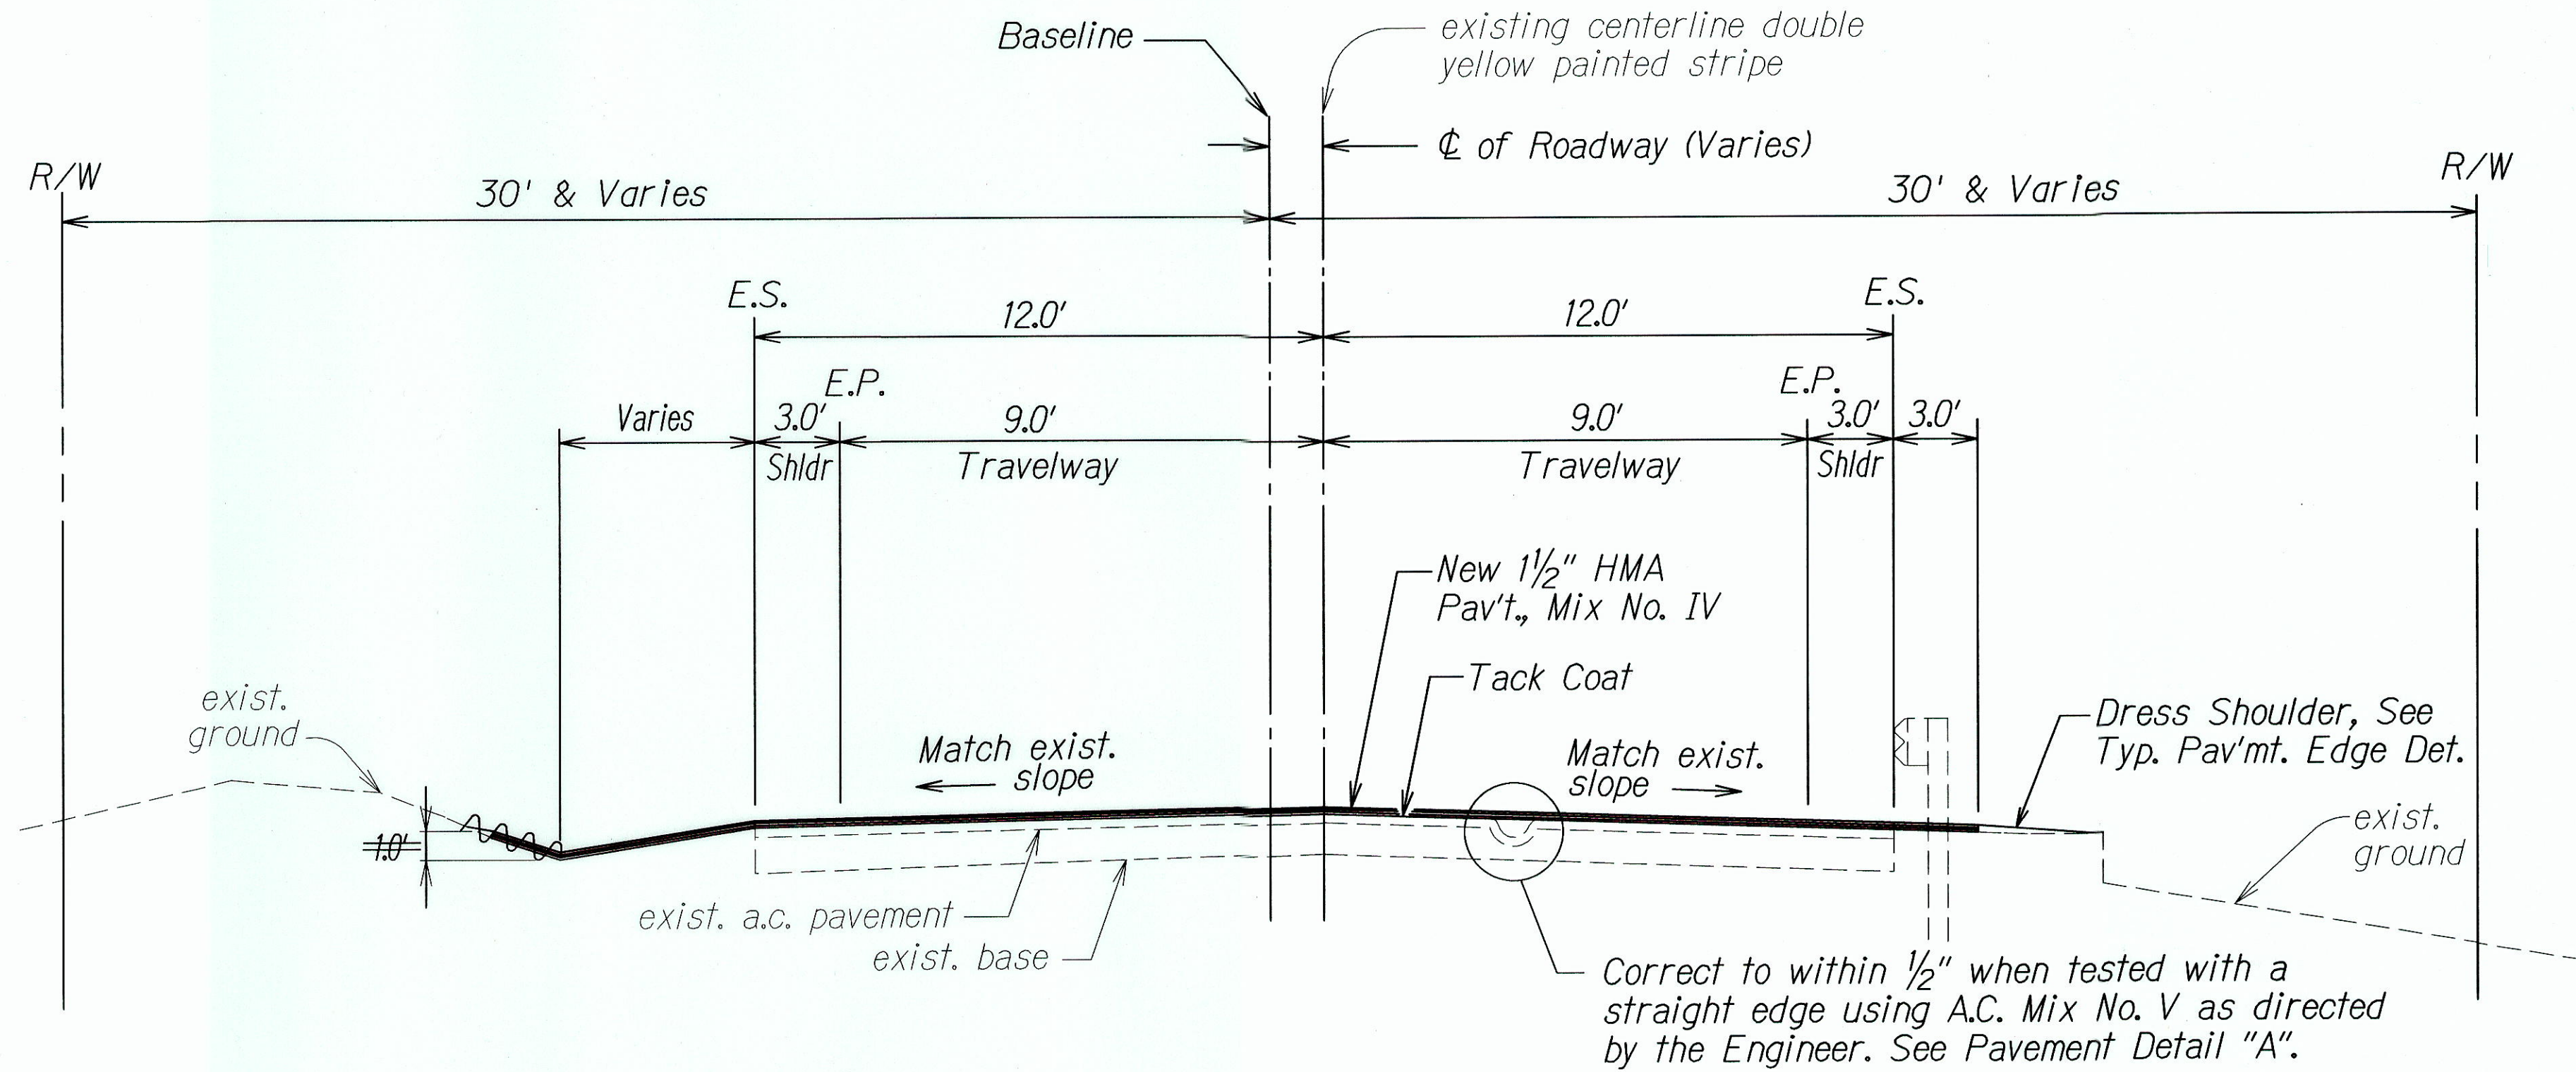

TYPICAL SECTION - KOHALA MOUNTAIN ROAD - NORMAL CROWN  
Not To Scale

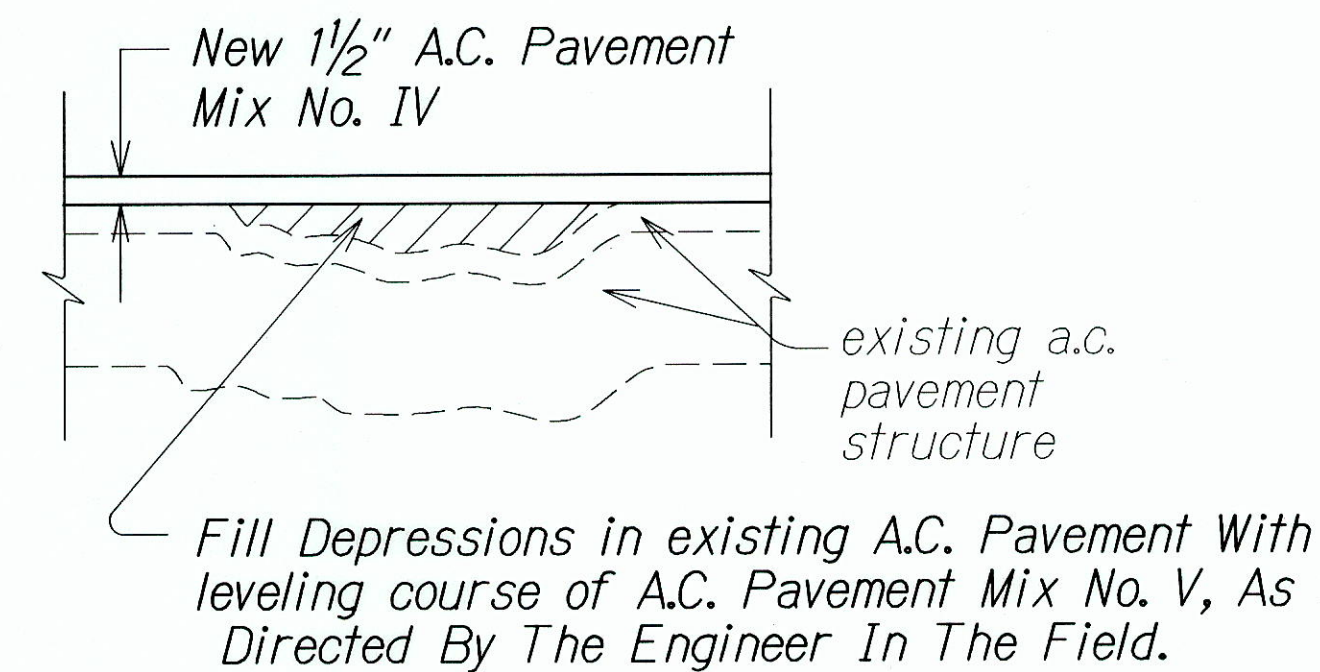

PAVEMENT DETAIL "A"  
Not To Scale

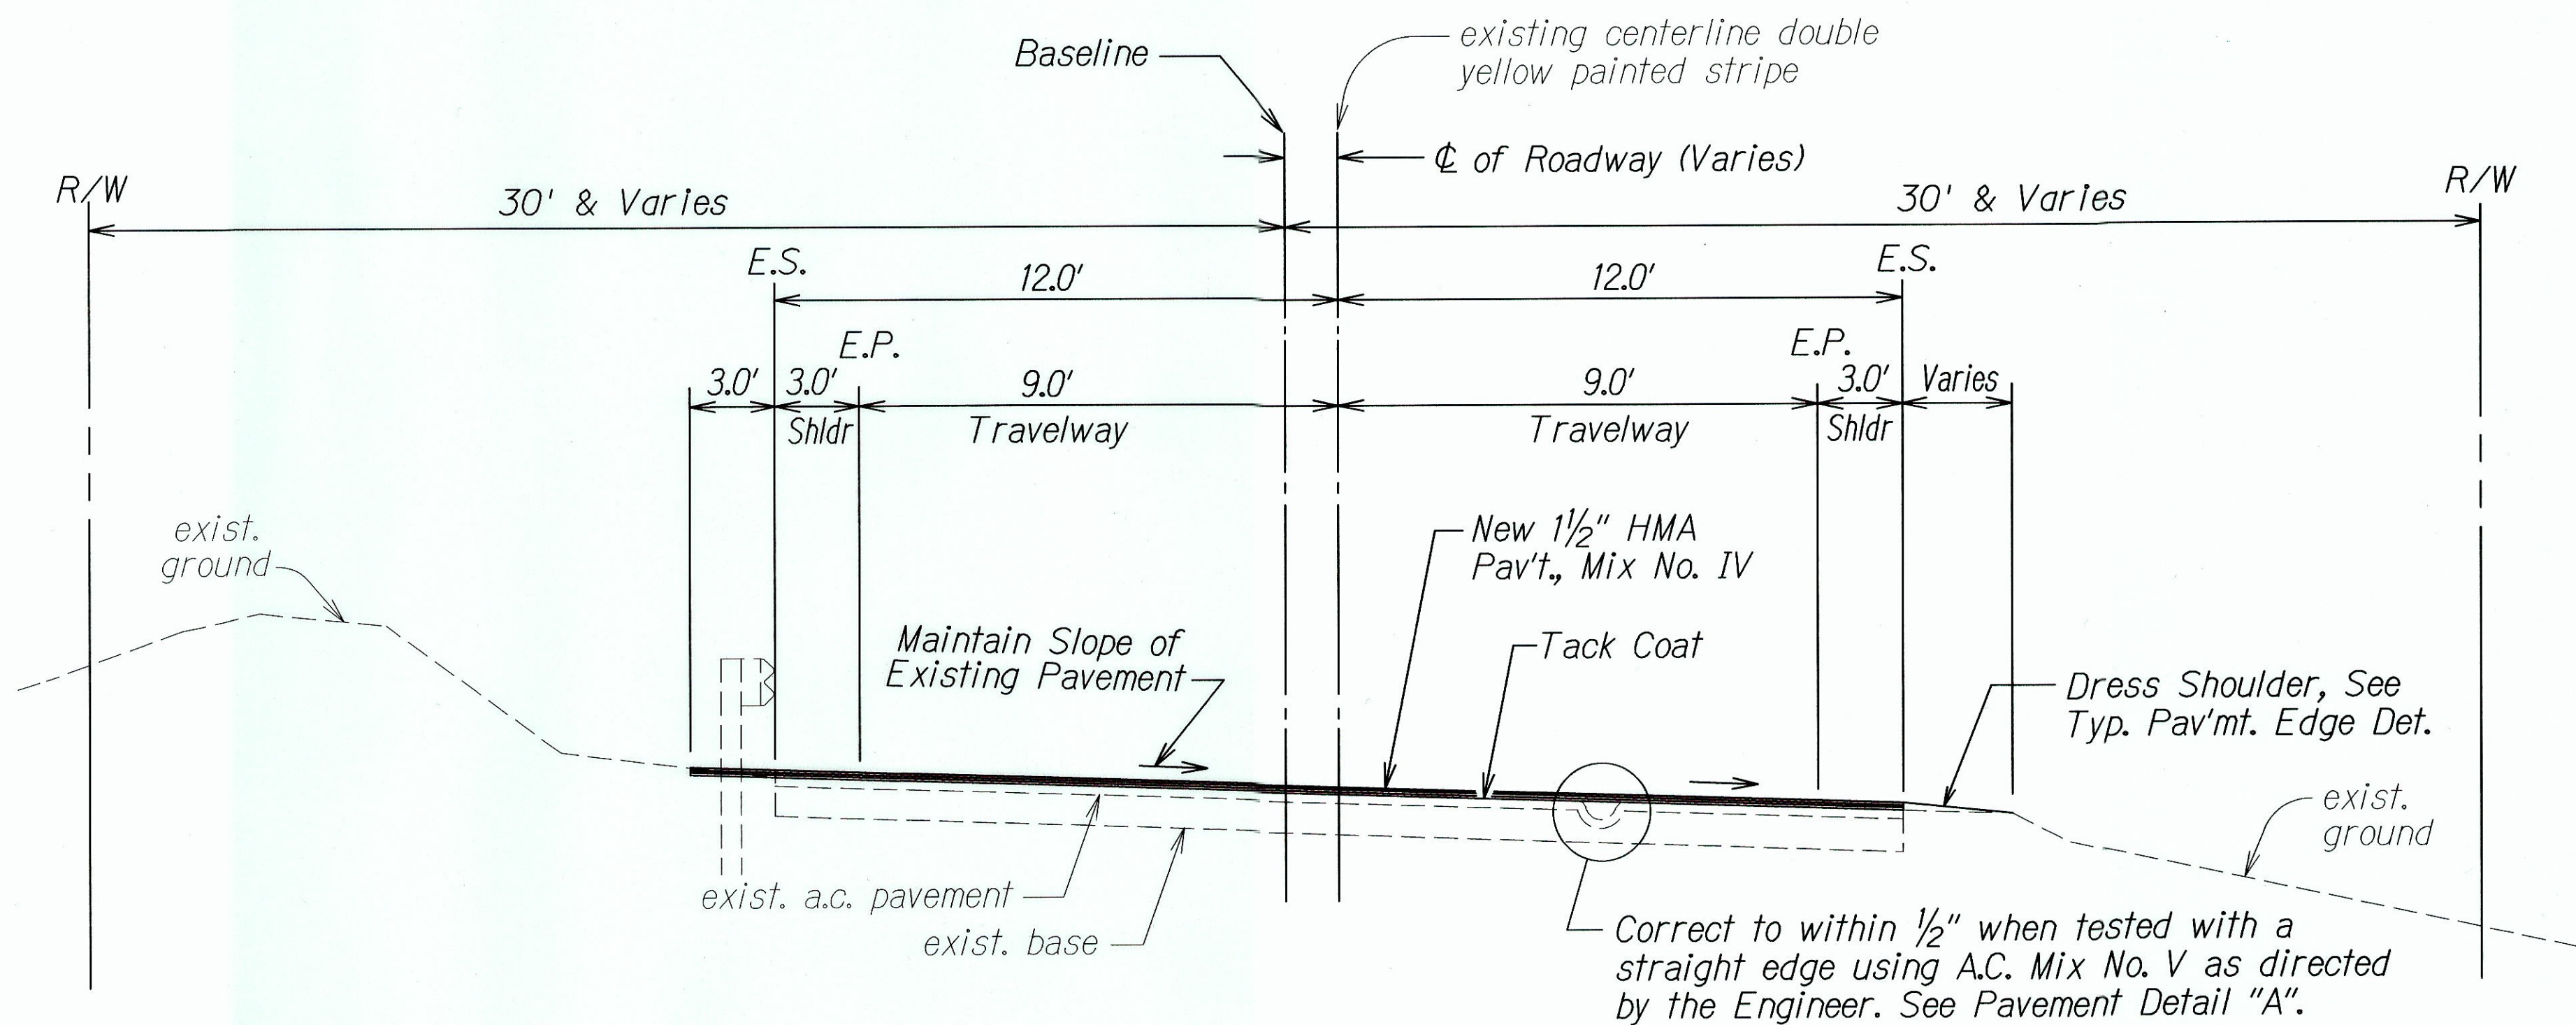

TYPICAL SECTION - KOHALA MOUNTAIN ROAD - SUPERELEVATION SECTION  
Not To Scale

LEGEND FOR AS-BUILT POSTINGS	
	Squiggly line for as-built deletion
	Double line for as-built deletion
Roadway	Text for as-built posting

STATE OF HAWAII DEPARTMENT OF TRANSPORTATION HIGHWAYS DIVISION	
<u>TYPICAL SECTION AND DETAILS</u>	
KOHALA MOUNTAIN ROAD	
PAVEMENT PREVENTIVE MAINTENANCE	
WAIKA JUNCTION TOWARD HAWI	
Federal Aid Project No. STP-250(006)	
Not To Scale	Date: April, 2011
SHEET No. 1 OF 1 SHEETS	

ORIGINAL PLAN	SURVEY PLOTTED BY	DATE
TRACED BY	DRAWN BY	
NOTED BY	CHECKED BY	
DATE		