

FED. ROAD DIST. NO.	STATE	FED. AID PROJ. NO.	FISCAL YEAR	SHEET NO.	TOTAL SHEETS
HAWAII	HAW	11-D	1937	9	11

DATE	BY
4-31	4-31
4-31	4-31
4-31	4-31
4-31	4-31


DATE	BY
4-31	4-31
4-31	4-31
4-31	4-31
4-31	4-31

DATE	BY
4-31	4-31
4-31	4-31
4-31	4-31
4-31	4-31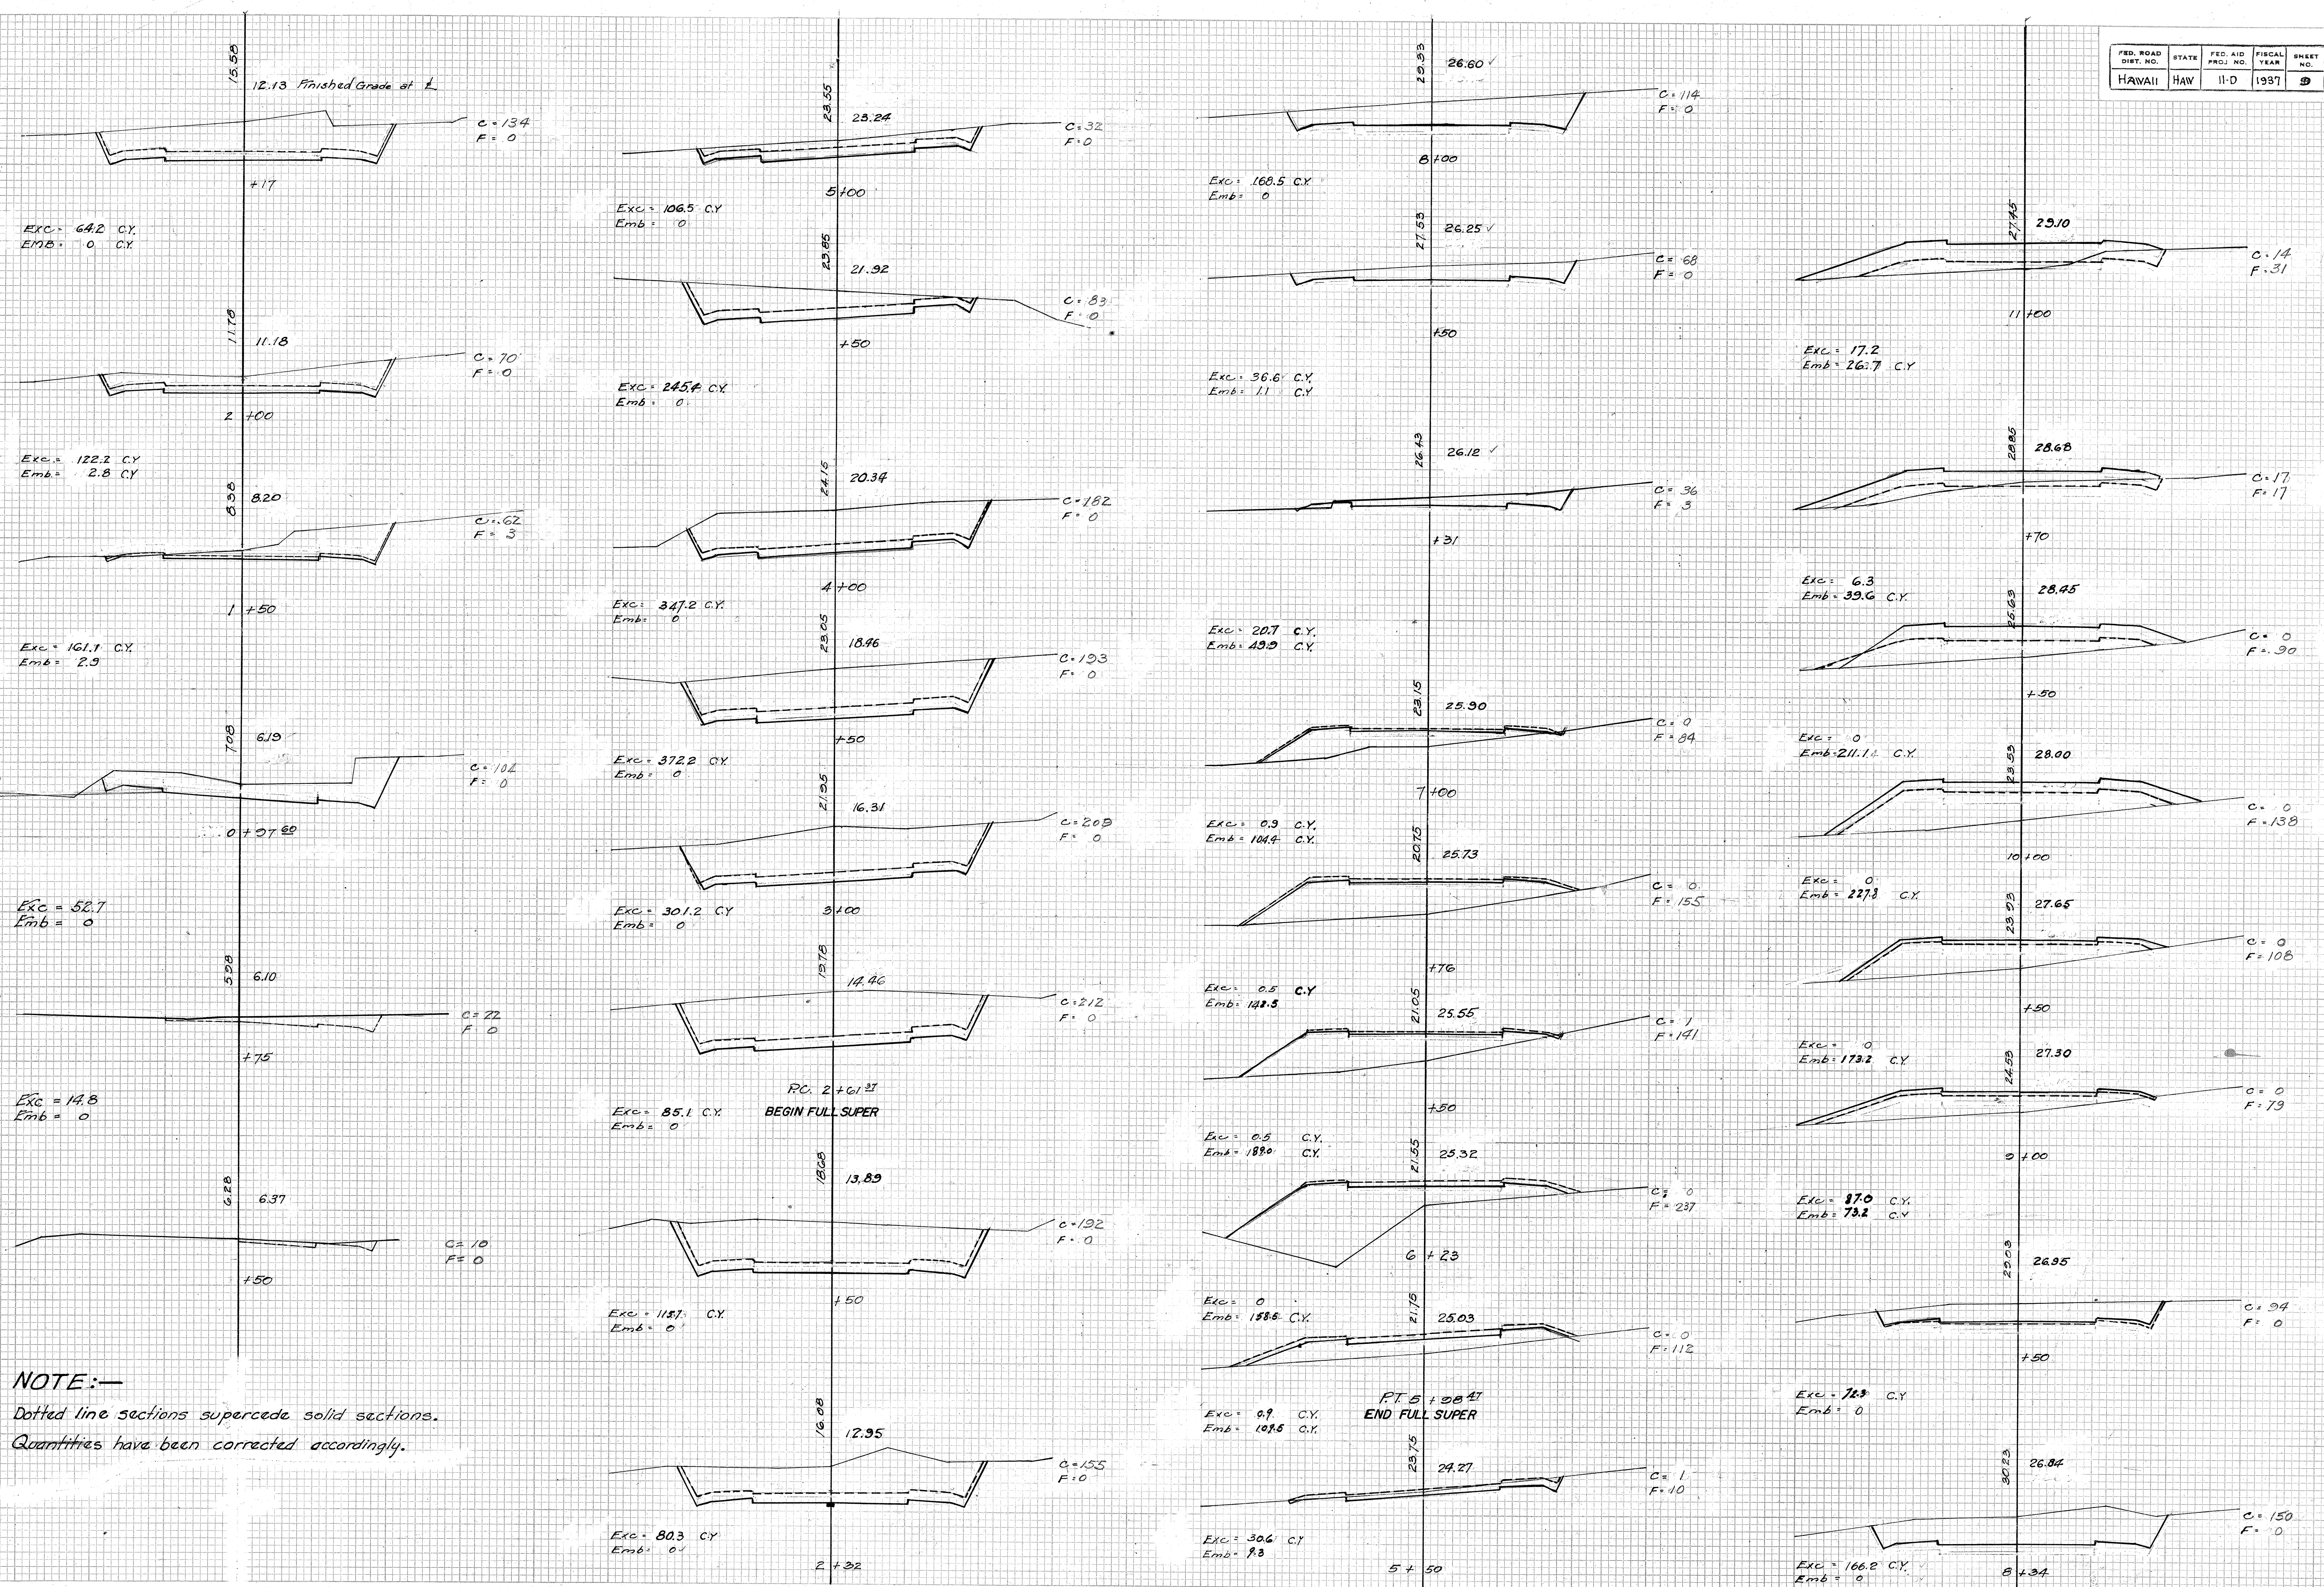

FED. ROAD DIST. NO.	STATE	FED. AID PROJ. NO.	FISCAL YEAR	SHEET NO.	TOTAL SHEETS
HAWAII	HAW	11-D	1937	10	11

DATE	BY	REVISION	NO.
4-31	1	1	1
4-31	2	2	2
4-31	3	3	3
4-31	100	100	100





DATE	BY	REVISION	NO.
4-31	1	1	1
4-31	2	2	2
4-31	3	3	3
4-31	100	100	100

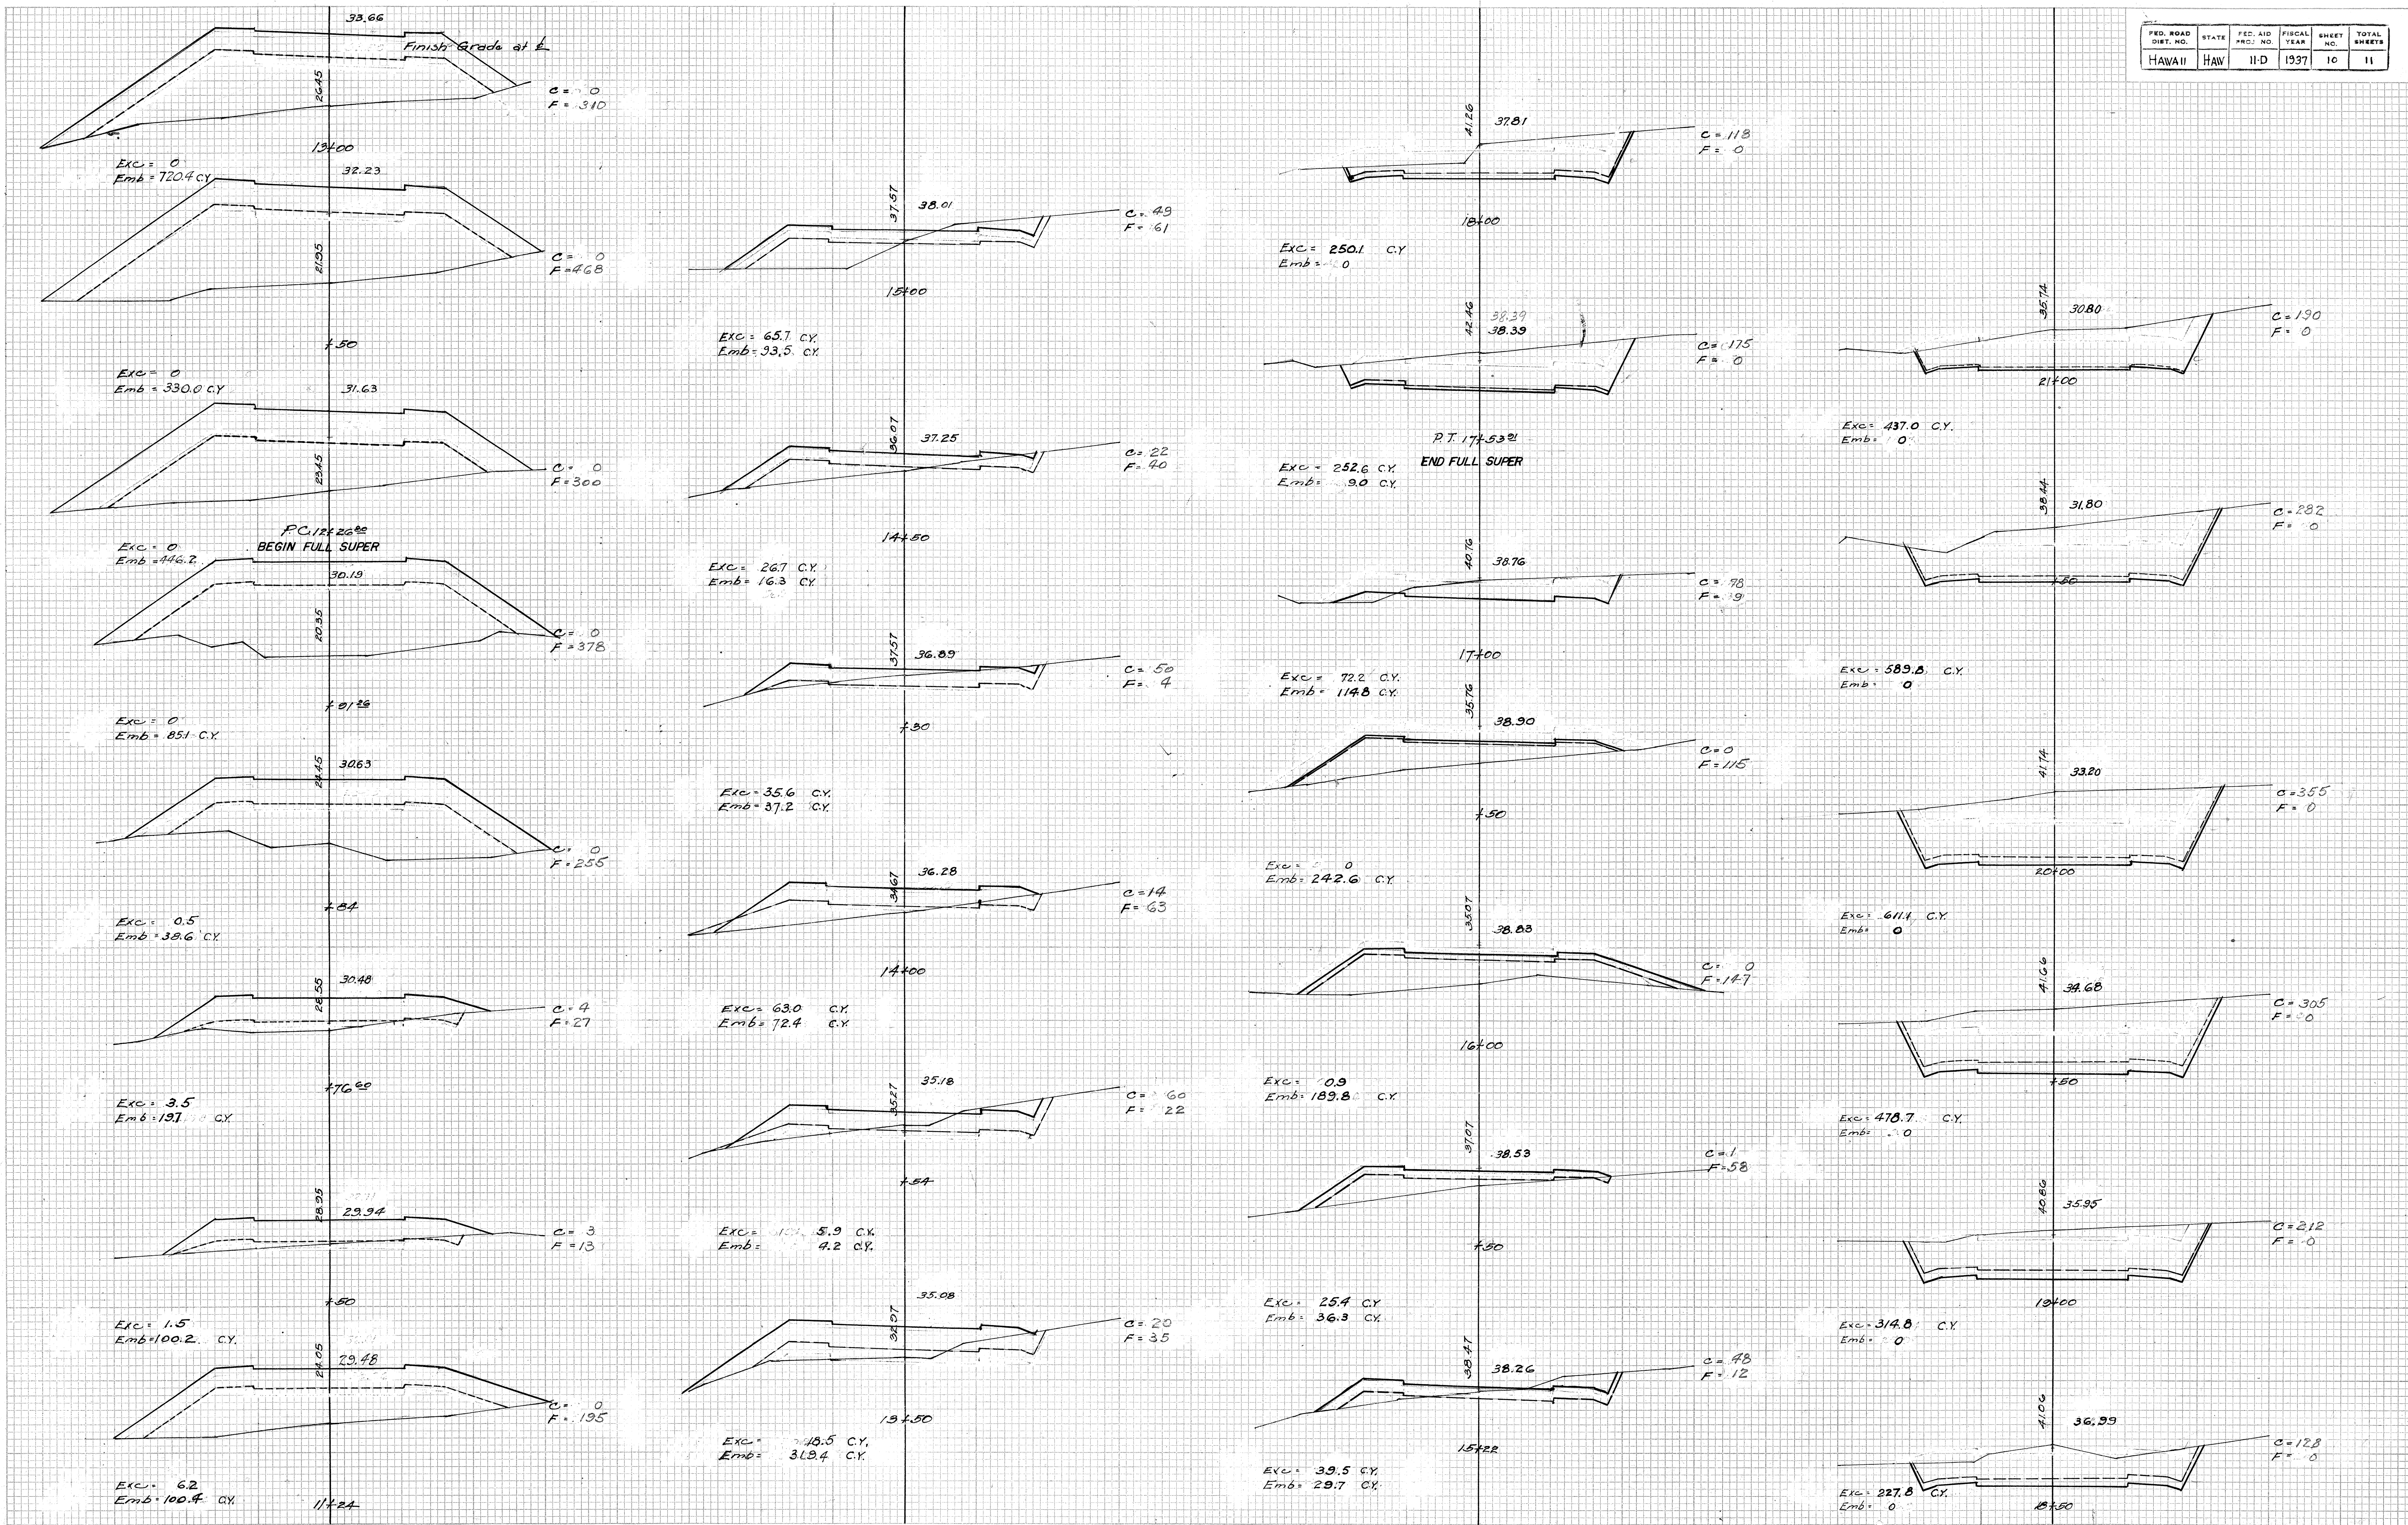

FED. ROAD DIST. NO.	STATE	FED. AID PROJ. NO.	FISCAL YEAR	SHEET NO.	TOTAL SHEETS
HAWAII	HAW	11-0	1937	11	11

FINAL SURVEY	DATE	BY
SURVEYED	4-31	L. Payne
PLOTTED	4-31	L. Payne
NOTE BOOK	4-31	L. Payne
NO. 11-D	4-31	L. Payne

ORIGINAL SURVEY	DATE	BY
SURVEYED	4-31	L. Payne
PLOTTED	4-31	L. Payne
NOTE BOOK	4-31	L. Payne
NO. 11-D	4-31	L. Payne

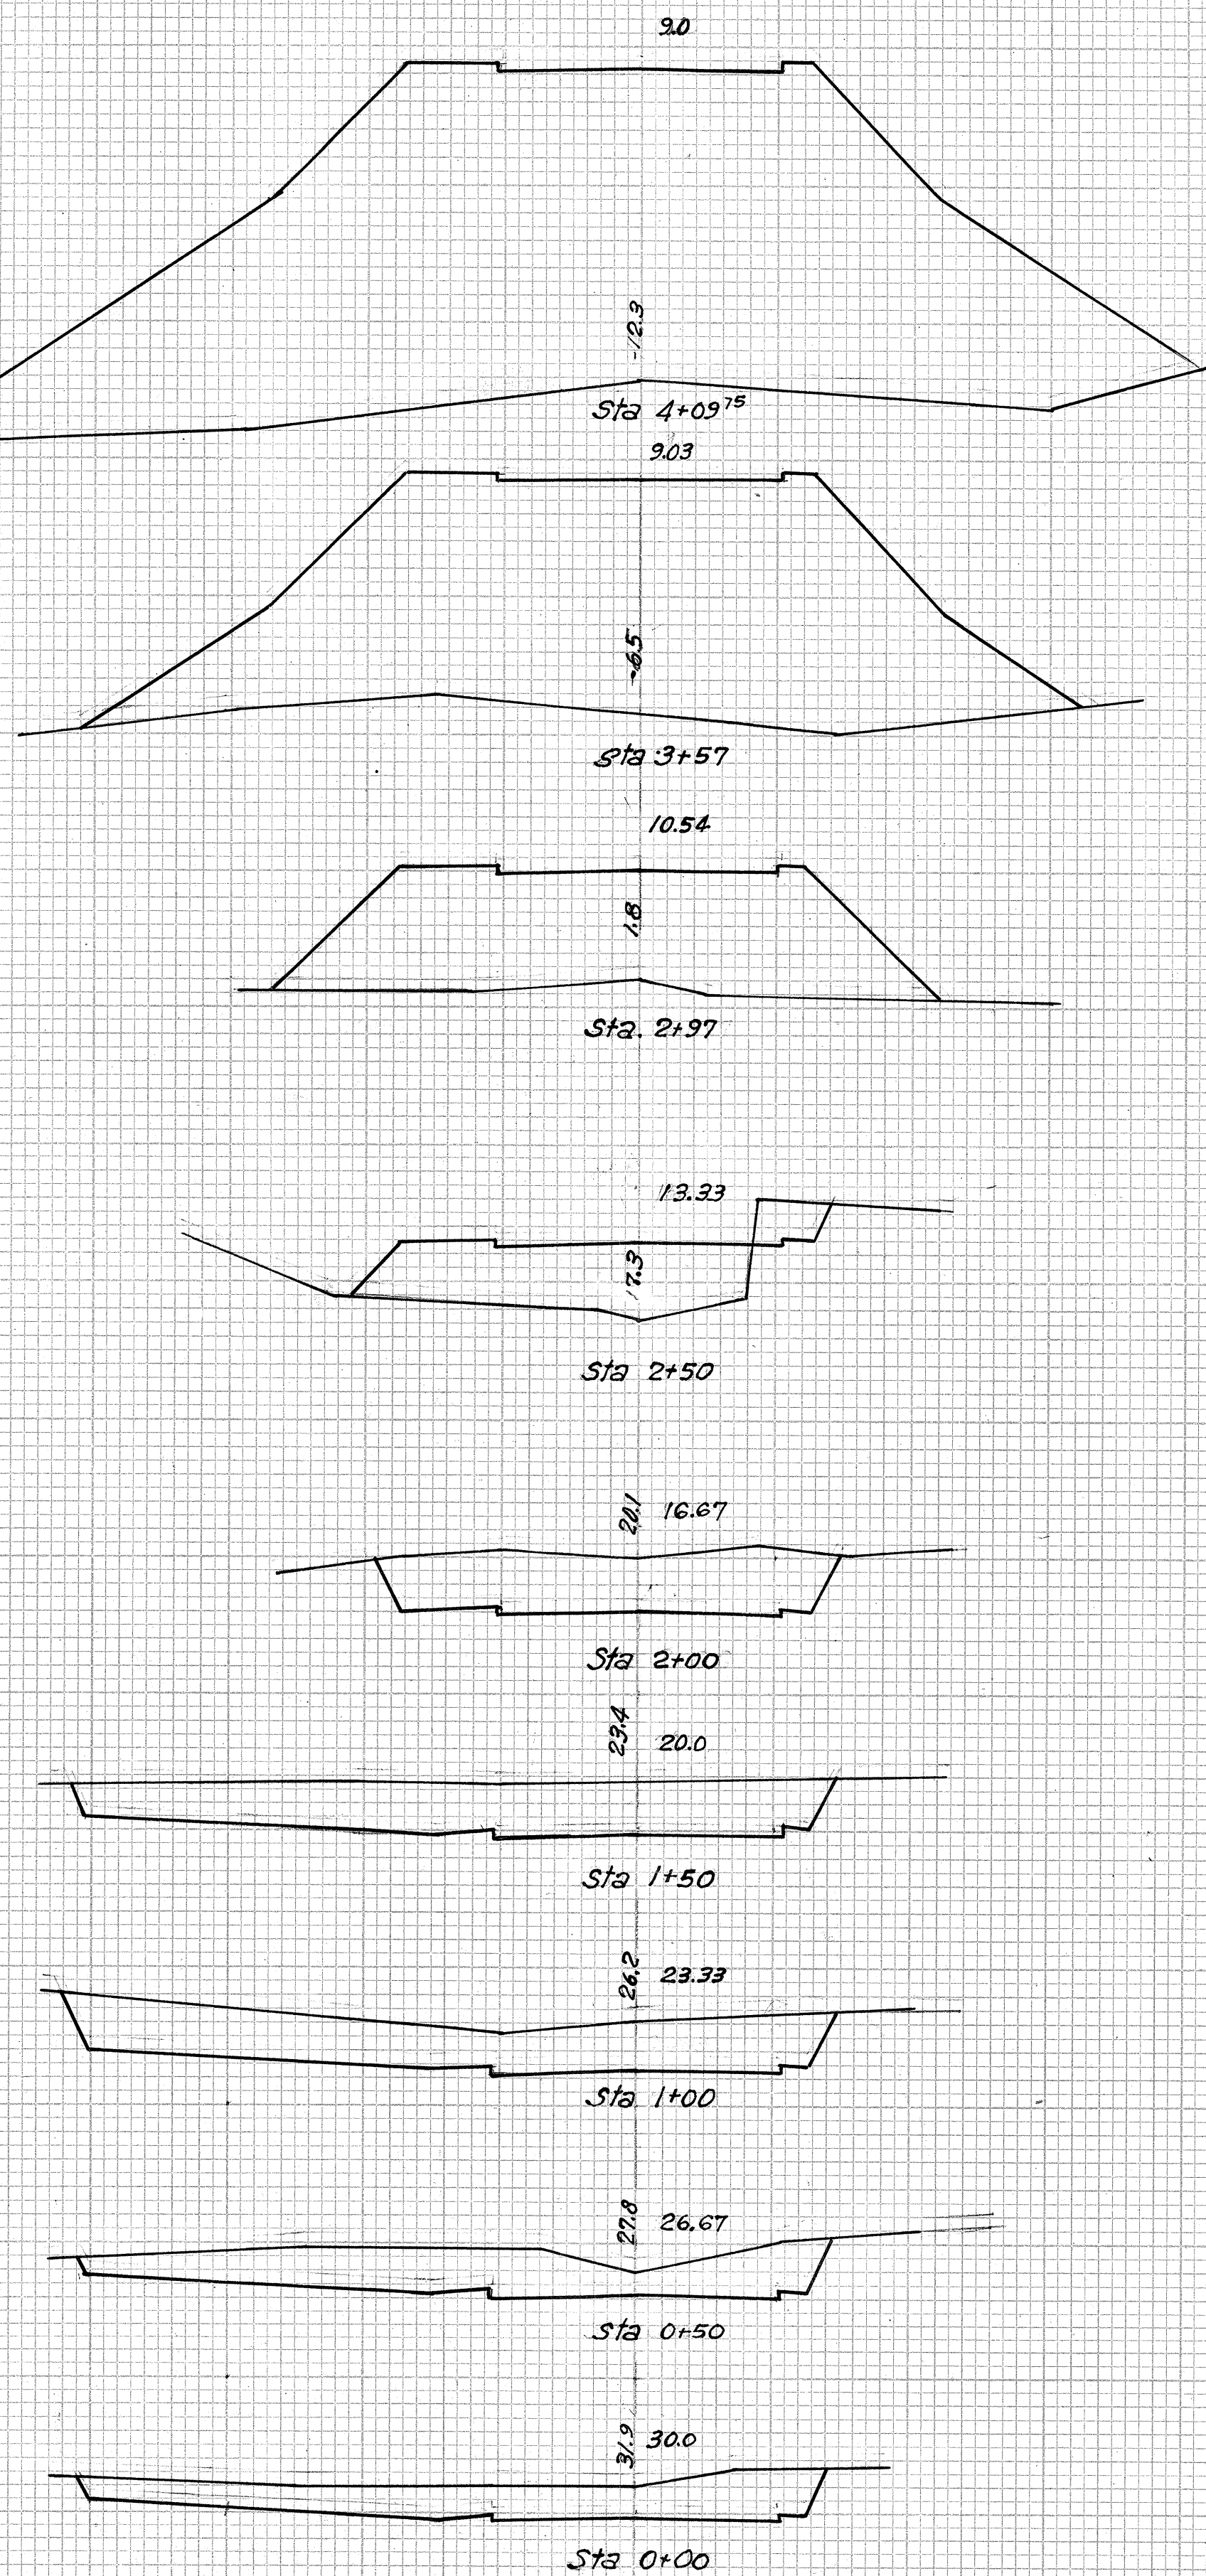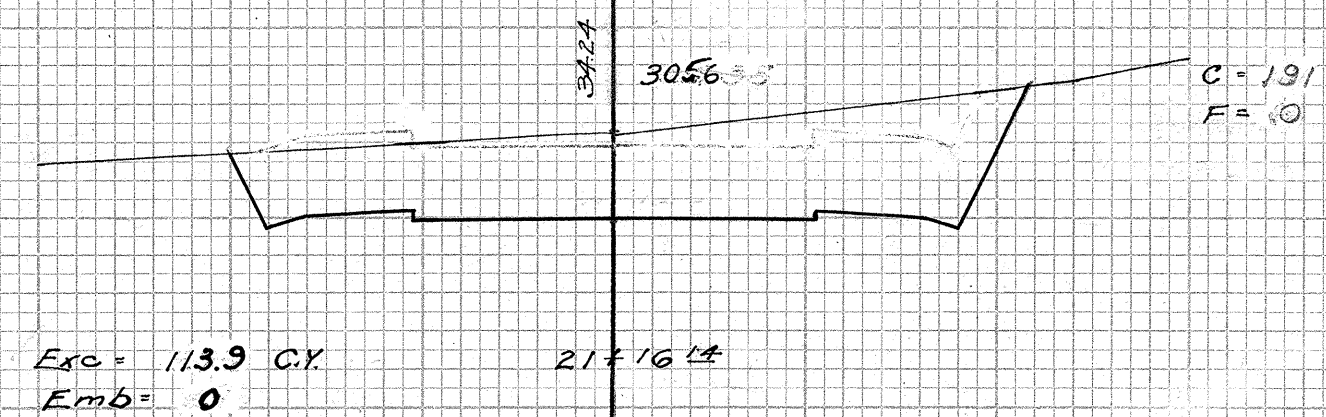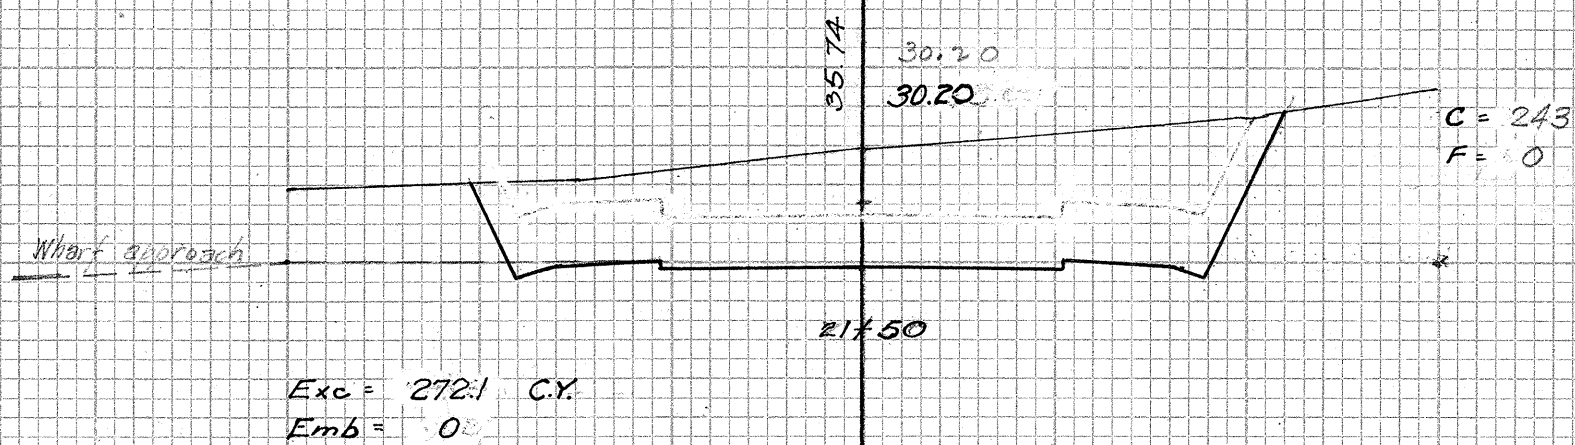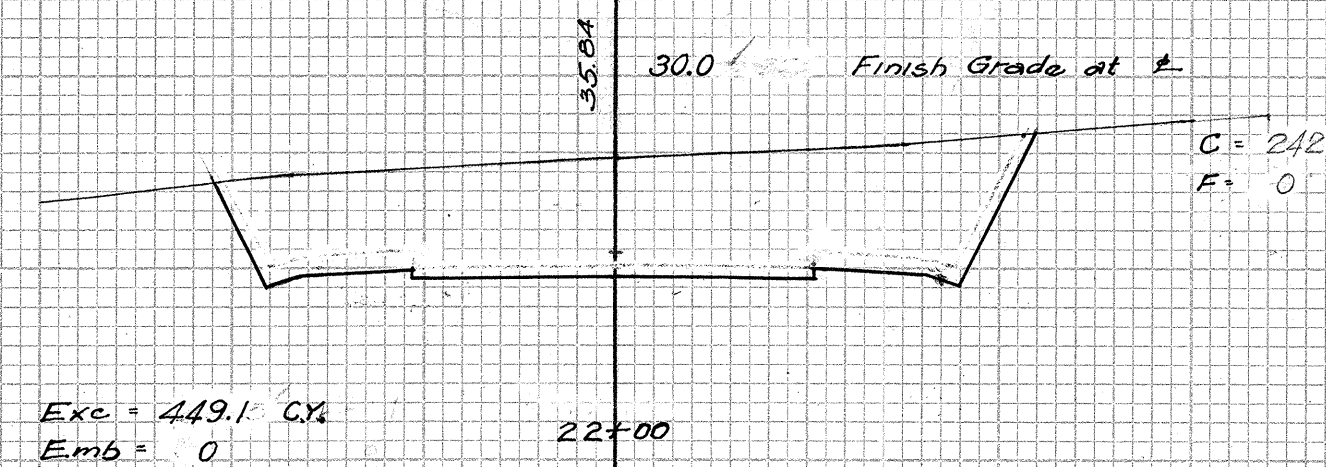

WHARF APPROACH

Note: All earthwork and fine grading on wharf approach has been done by others. Contractor to construct Base Course and 1" Armor Coat only. (See Part 11-11-11)

PLATE 3 - CROSS SECTION C. P. R. & R. E. STANDARD
KEUFFEL & ESSER CO., NEW YORK.

4414.11