

INDEX TO DRAWINGS	
SHEET	DESCRIPTION
1	TITLE SHEET
2	TYPICAL SECTIONS
3-6	PLAN & PROFILE
7	DETAILS OF DETOUR ROAD & RELOCATED 6" C.I. PIPE
8	BOARD OF HARBOR COMMISSIONERS DRAINAGE DITCH
	STANDARD DETAILS
	KAWAIHAE BRIDGE
	MAKAHUNA BRIDGE
	MAKEHUA STREAM BRIDGE
	STANDARD BRIDGE DETAILS
	CROSS SECTIONS

TERRITORY OF HAWAII
TERRITORIAL HIGHWAY DEPARTMENT
HONOLULU T.H.

"AS BUILT"
PLANS OF

KAWAIHAE ROAD


FEDERAL AID SECONDARY PROJECT NO. S-0260(I)

DISTRICT OF SOUTH KOHALA
ISLAND OF HAWAII


SCALE

PLAN 1 IN. = 50 FT.
 PROFILE.....HOR.... 1 IN. = 50 FT.
 VERT... 1 IN. = 5 FT.
 X-SECTION....HOR.... 1 IN. = 10 FT.
 VERT... 1 IN. = 10 FT.

ROADWAY 0.726 MI.
 BRIDGES OVER 20 FEET 0.028 MI.
 GROSS LENGTH OF PROJECT 0.754 MI.

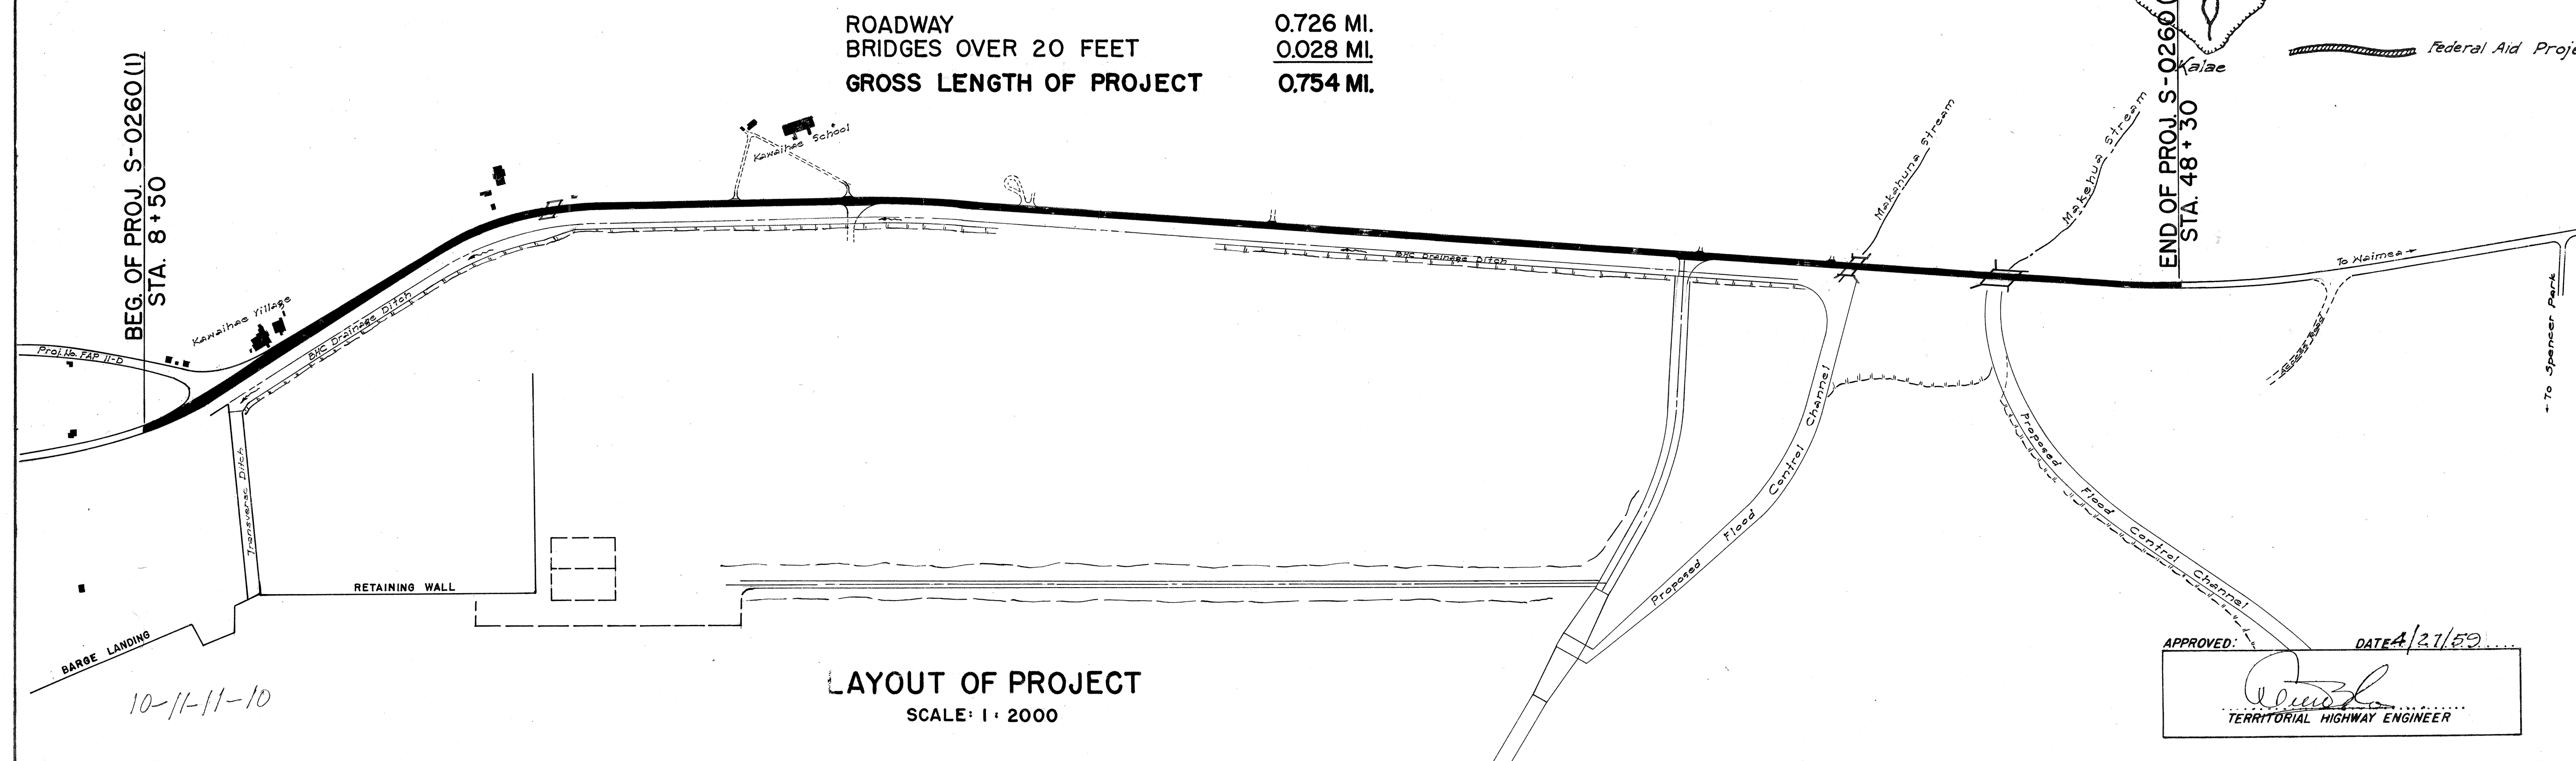

LAYOUT OF PROJECT
SCALE: 1" = 2000'

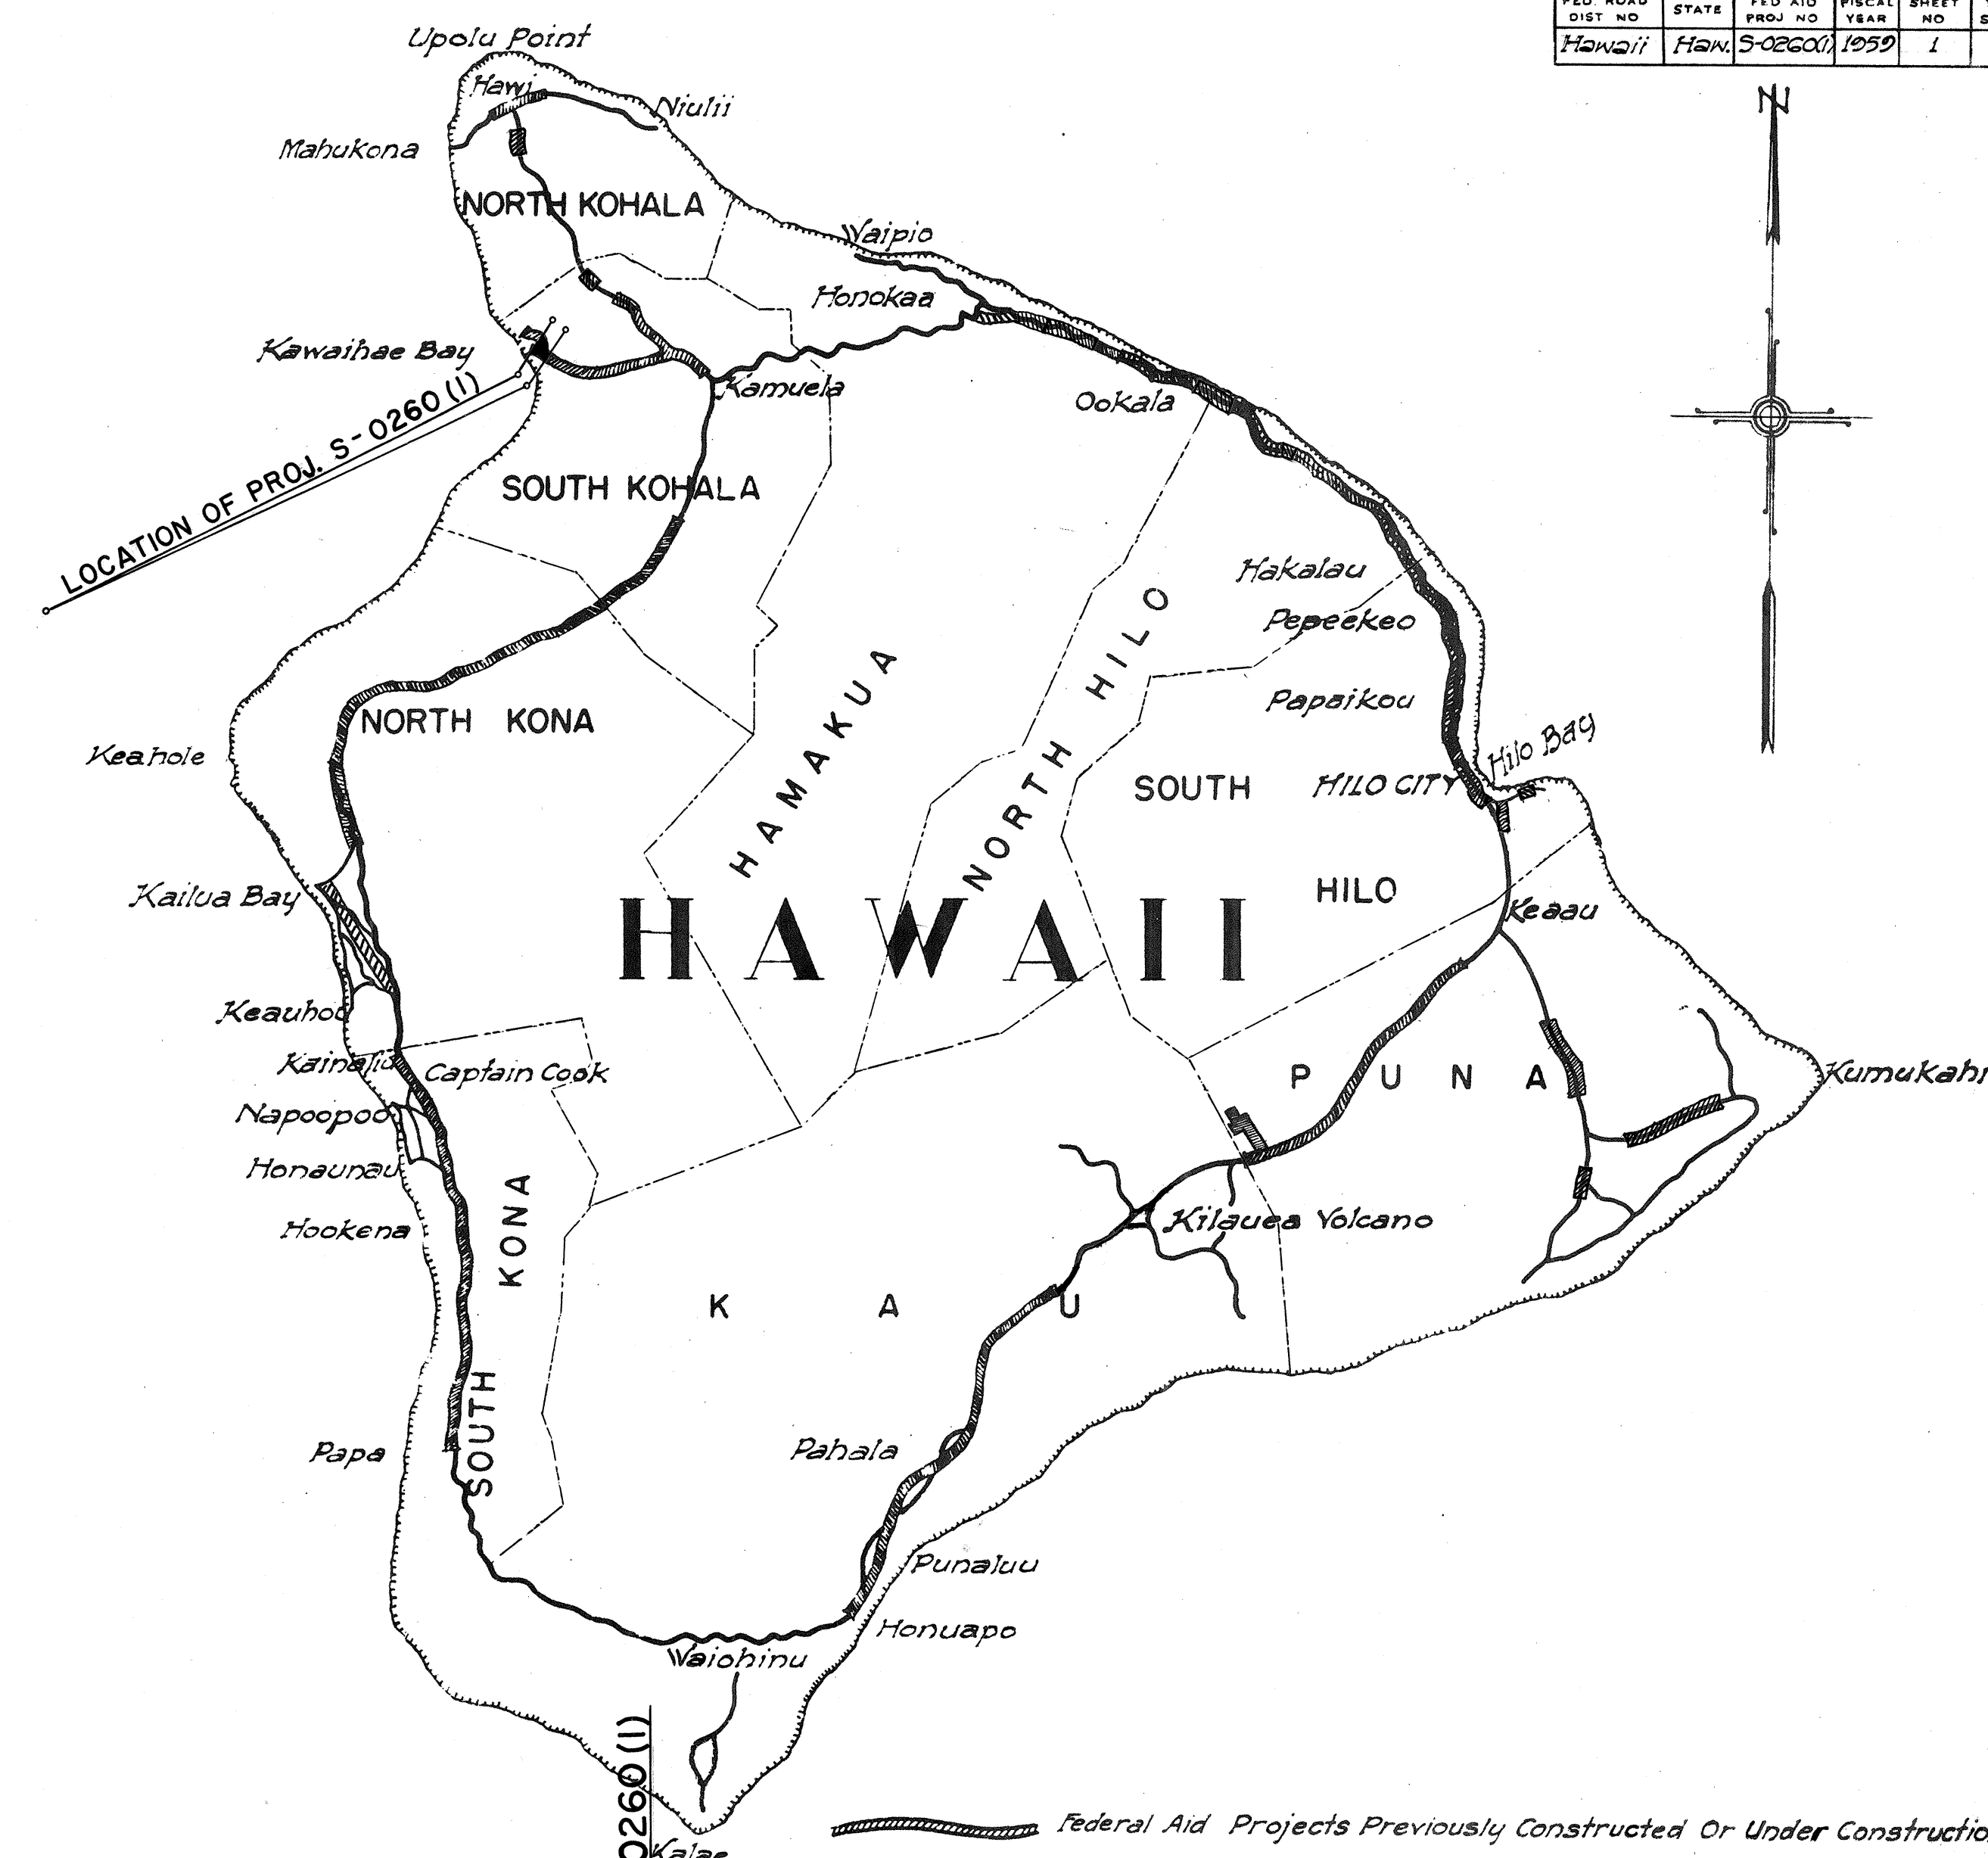

NOTE:
 ALL CHANGES MADE
 DURING CONSTRUCTION
 HAVE BEEN NOTED IN
 RED ON THESE TRAC-
 INGS AND CHECKED BY:
Howard G. Allen
 PROJECT ENGINEER
 5/16/60
 DATE

DEPARTMENT OF COMMERCE
BUREAU OF PUBLIC ROADS
 APPROVED: _____
 DIVISION ENGINEER DATE

APPROVED: _____
 DATE 4/27/59
 TERRITORIAL HIGHWAY ENGINEER