

FINAL SURVEY	SURVEYED	BY	DATE
	PLOTTED		
NOTE BOOK	TEMPLATE		
	AREAS		
NO.	AREAS CHECKED		

[illegible]

PLATE 3 - CROSS SECTION O. P. R. & R. E.
CLEARPRINT PAPER COMPANY, S. F. CAL.
No. 1000H-3





5495.11

FINAL SURVEY NOTE BOOK NO.	BY	DATE	SURVEYED	PLOTTED	DATE
			_____	_____	_____
			_____	_____	_____
			_____	_____	_____

ORIGINAL SURVEY NOTE BOOK NO.	BY	DATE	SURVEYED	PLOTTED	DATE
			_____	_____	_____
			_____	_____	_____
			_____	_____	_____

FED. ROAD DIST. NO.	STATE	FED. AID PROJ. NO.	FISCAL YEAR	SHEET NO.	TOTAL SHEETS
HAWAII	HAW	SP2022	051	12	17

As Built

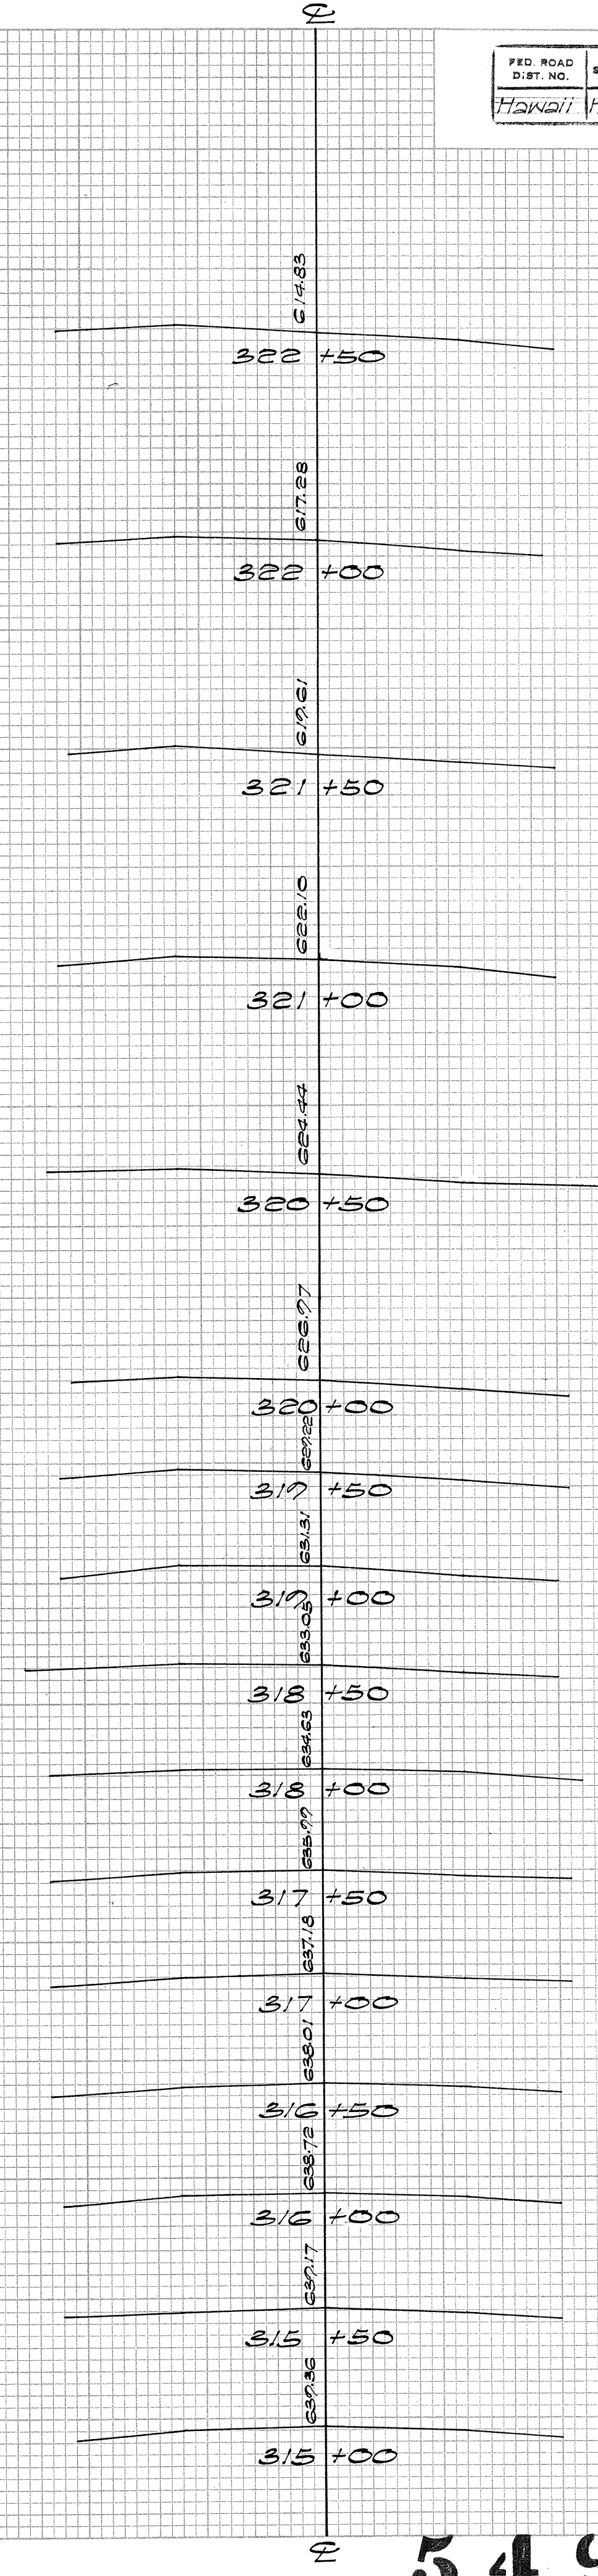
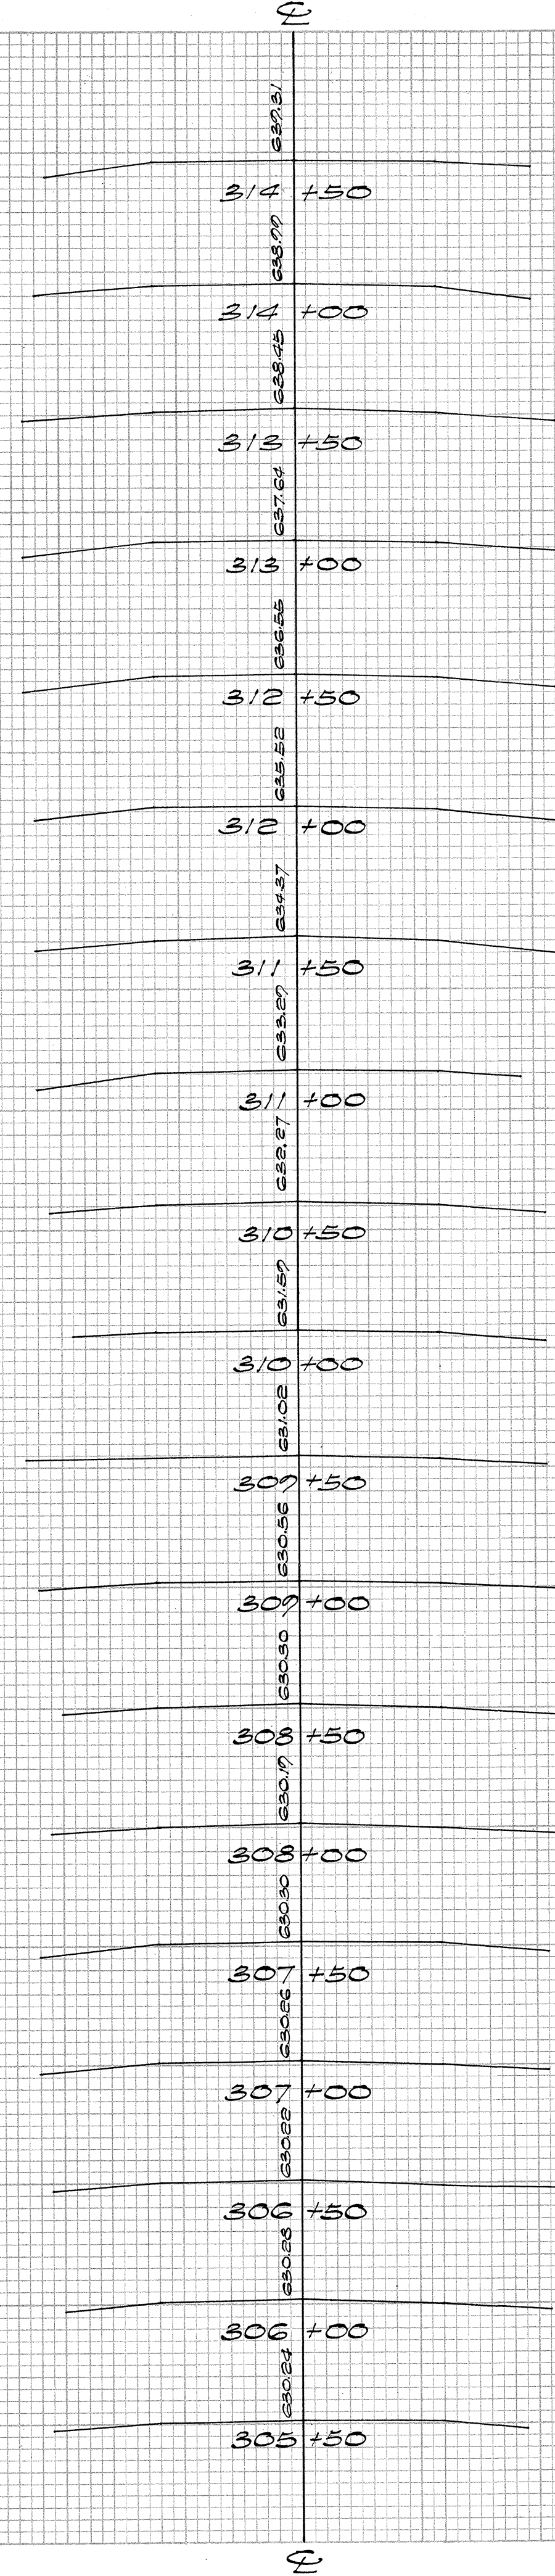
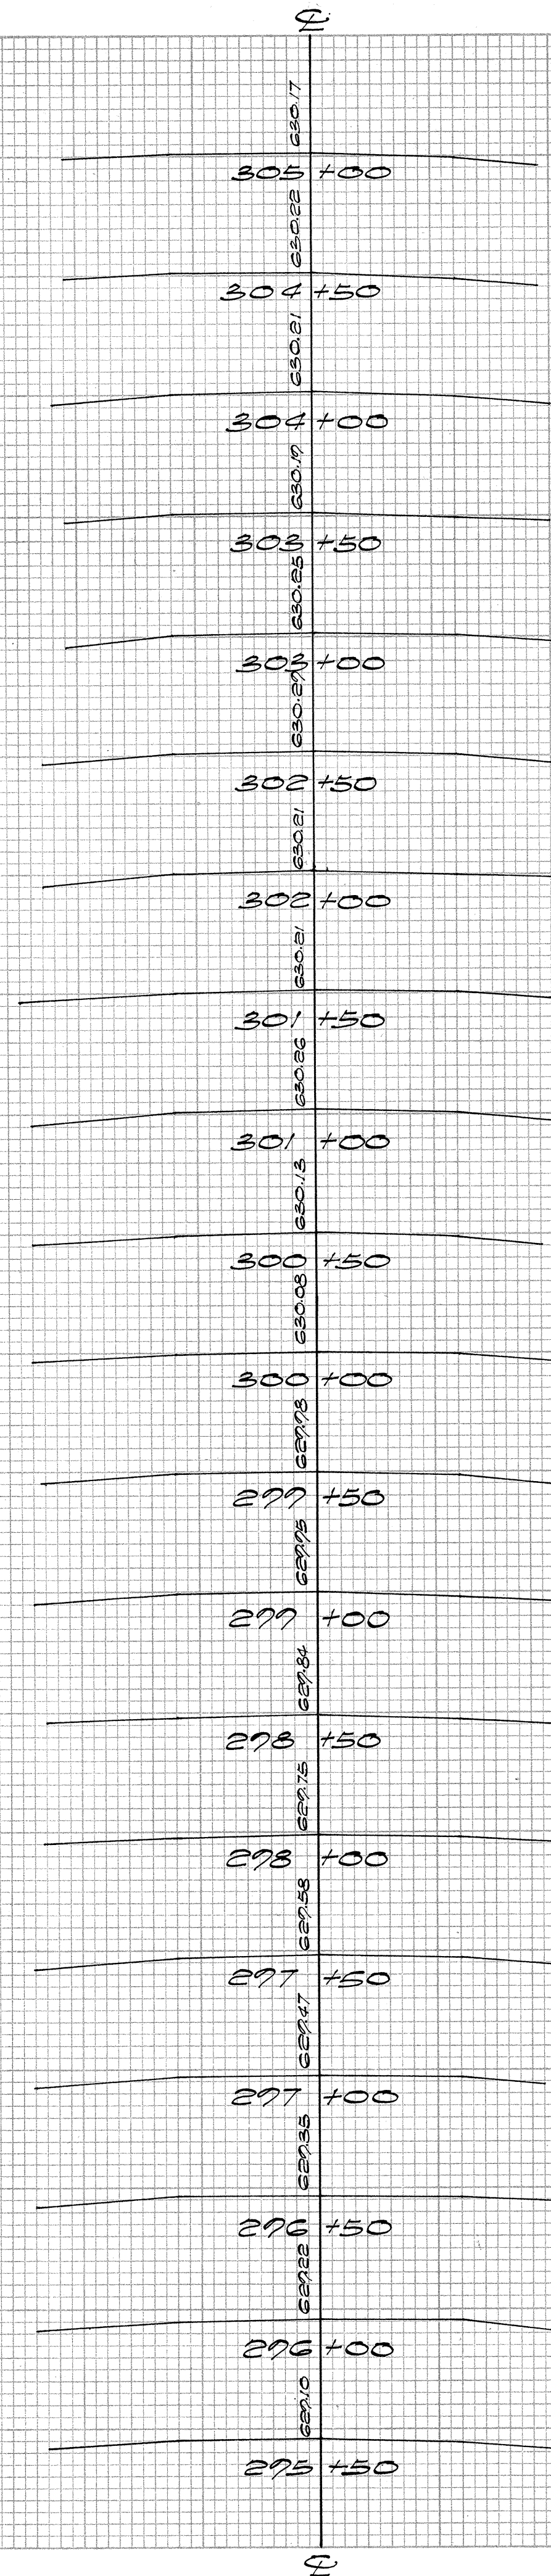
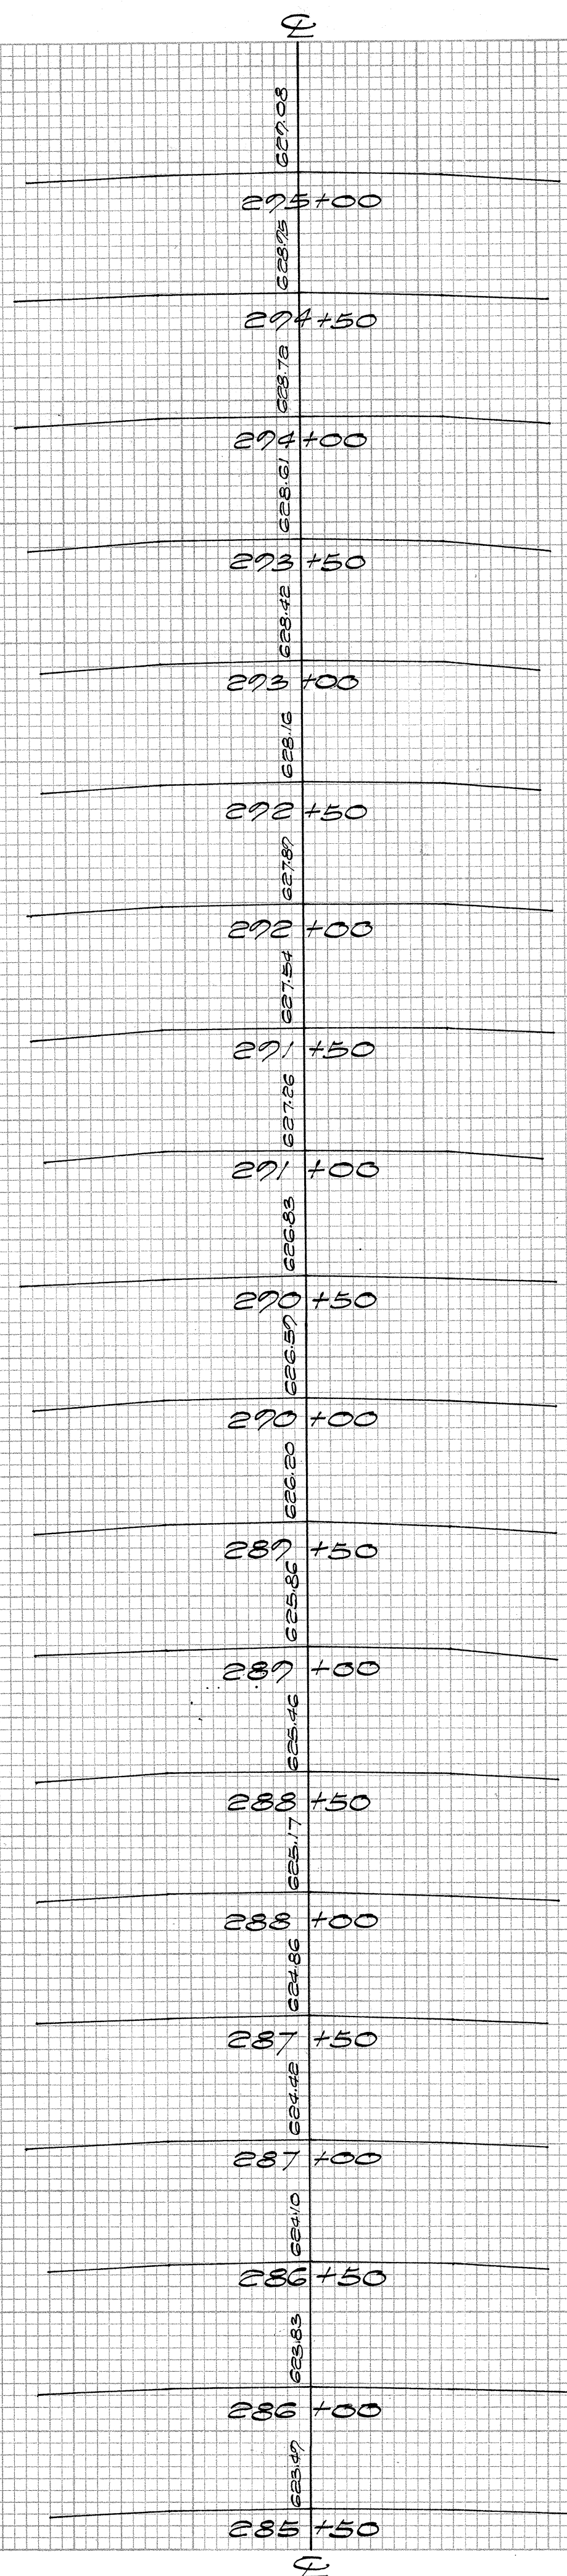


FINAL SURVEY NOTE BOOK NO.	SURVEYED	BY	DATE
	PLOTTED		
	REVIEWED		
	AREAS CHECKED		

ORIGINAL SURVEY NOTE BOOK NO.	SURVEYED	BY	DATE
	PLOTTED		
	REVIEWED		
	AREAS CHECKED		





FED. ROAD DIST. NO.	STATE	FED. AID PROJ. NO.	FISCAL YEAR	SHEET NO.	TOTAL SHEETS
Hawaii	Haw	SP03(2)051	13	17	

As Built

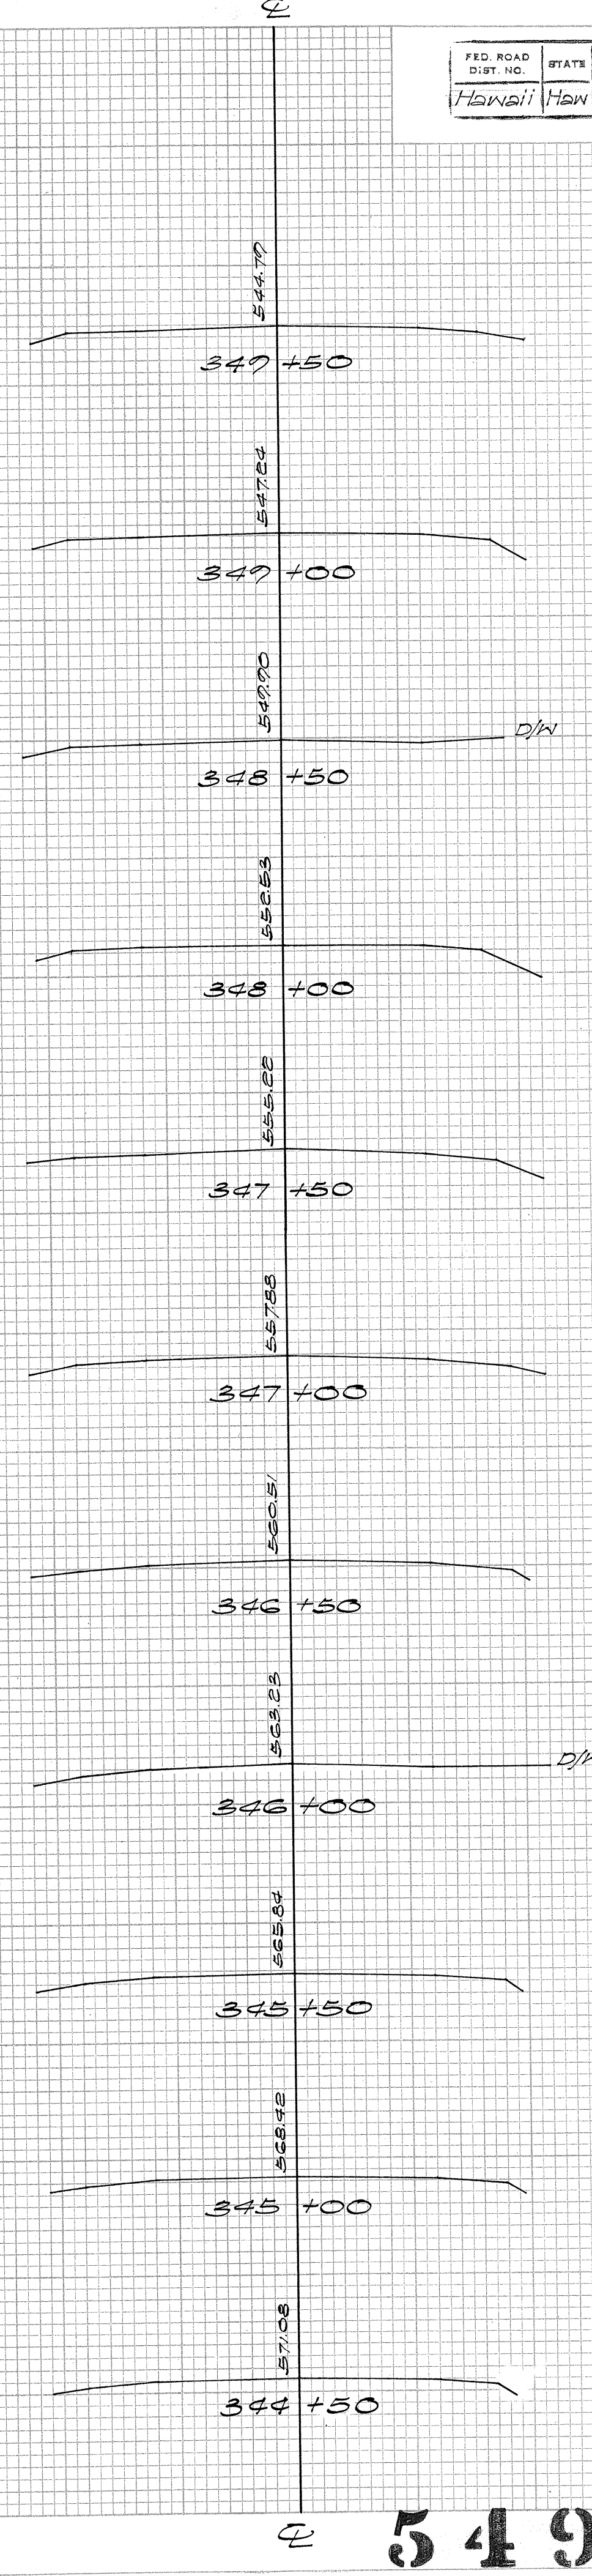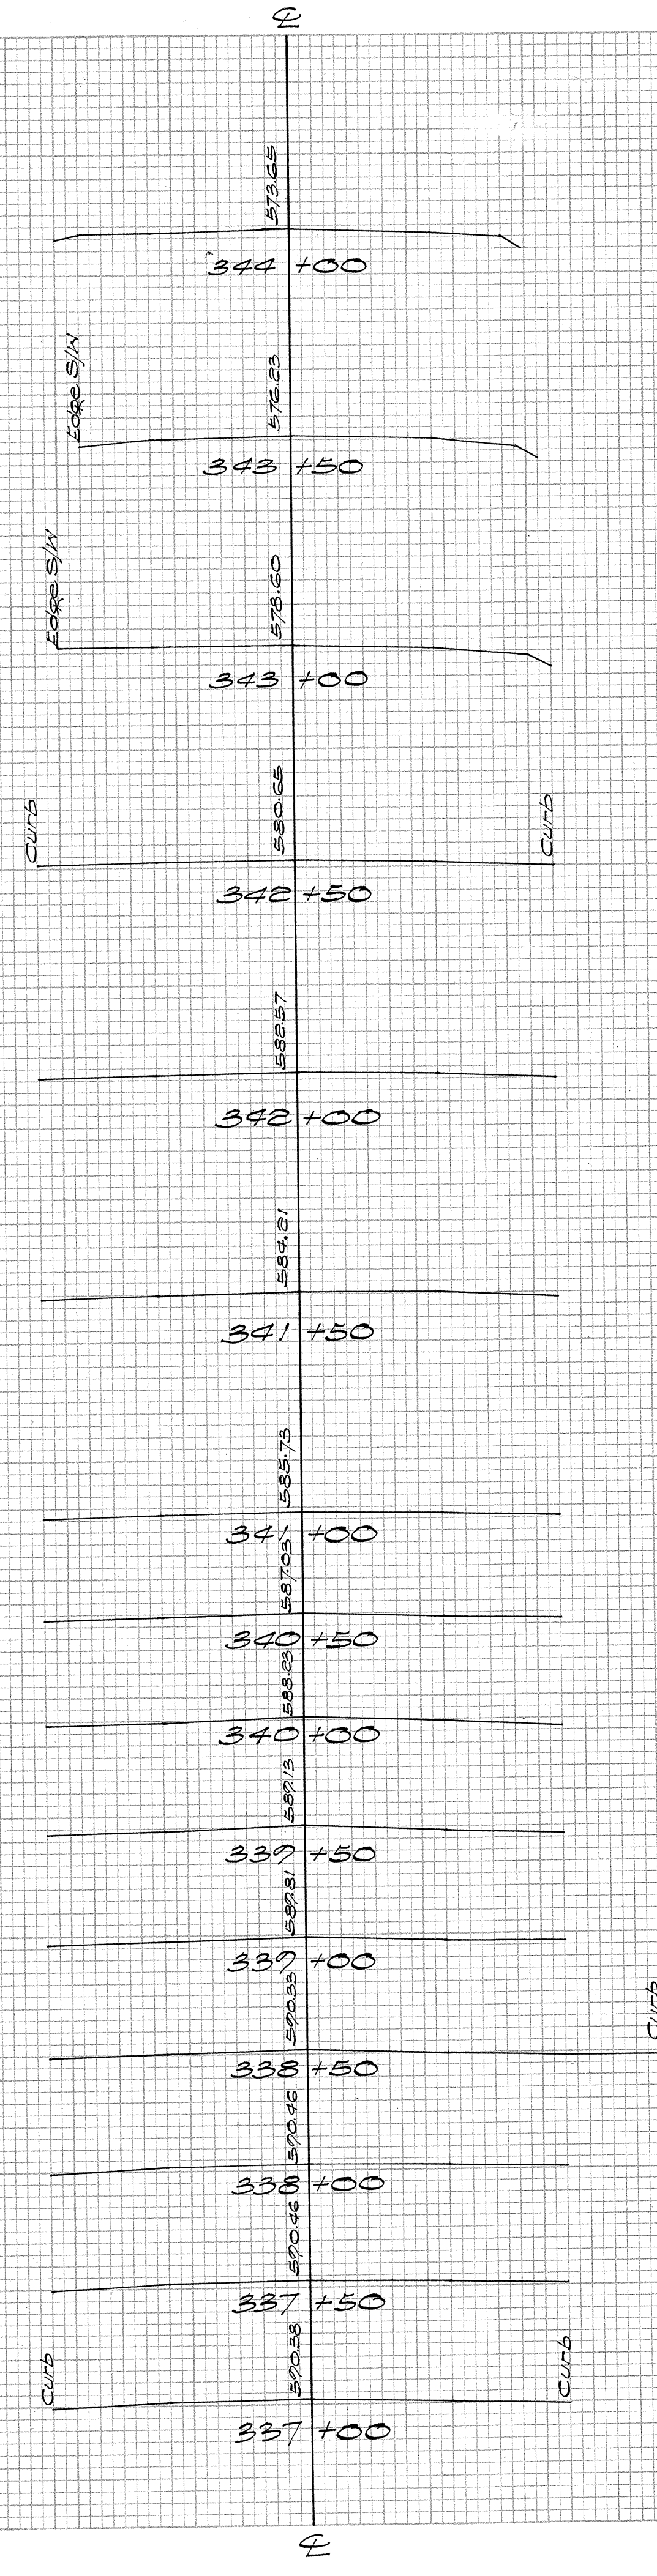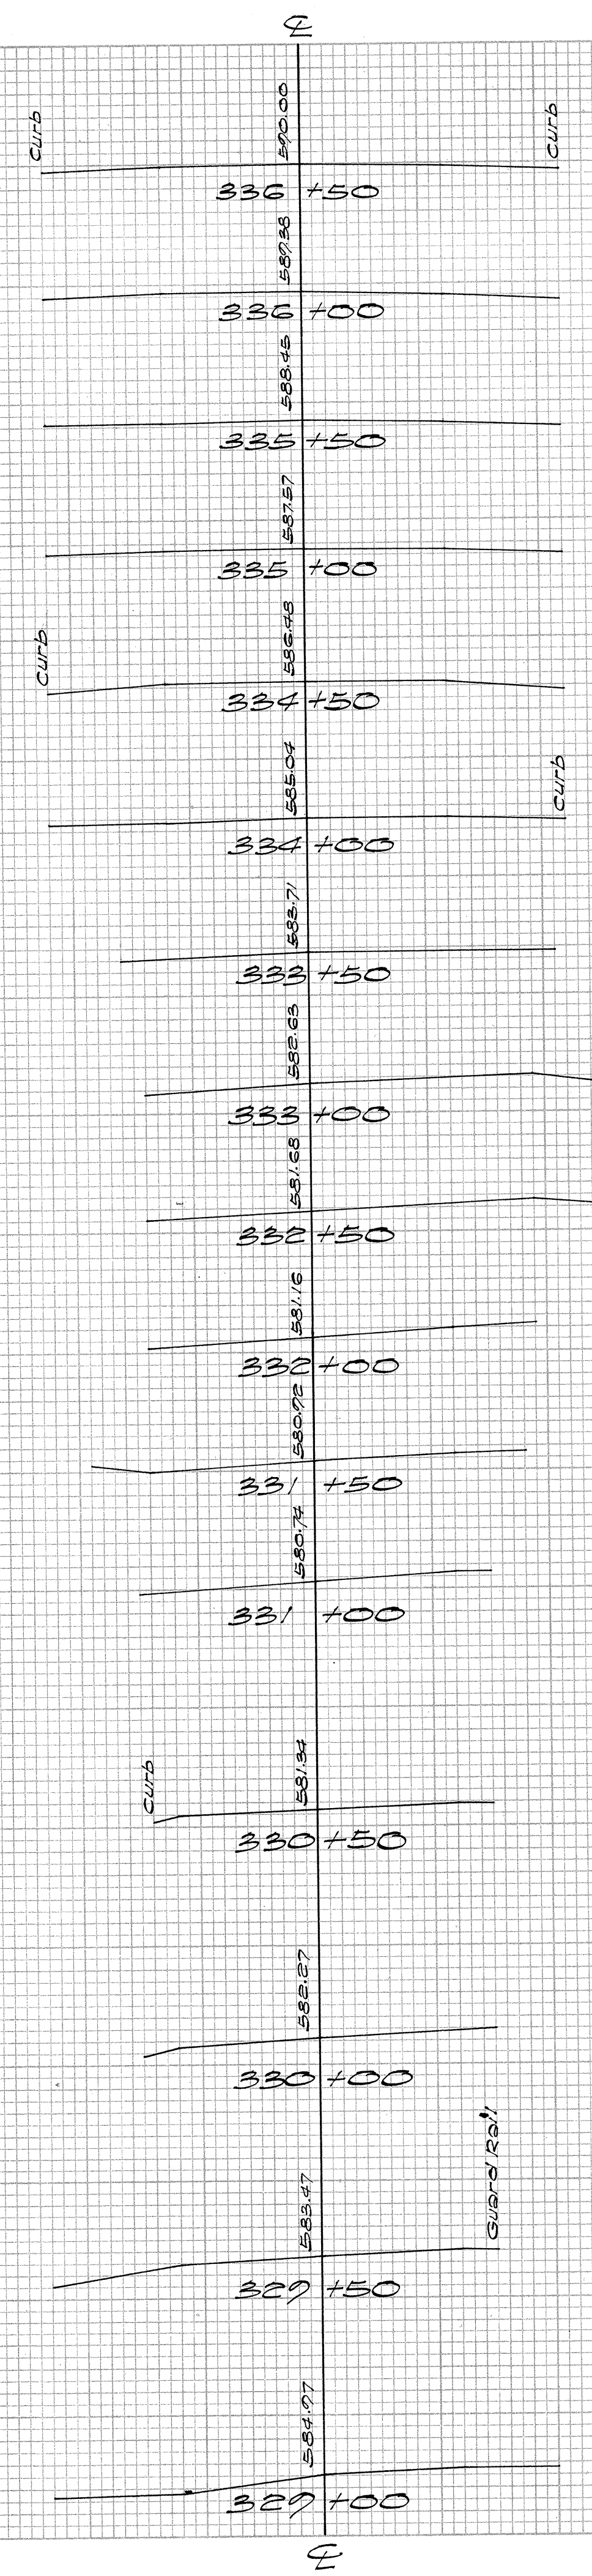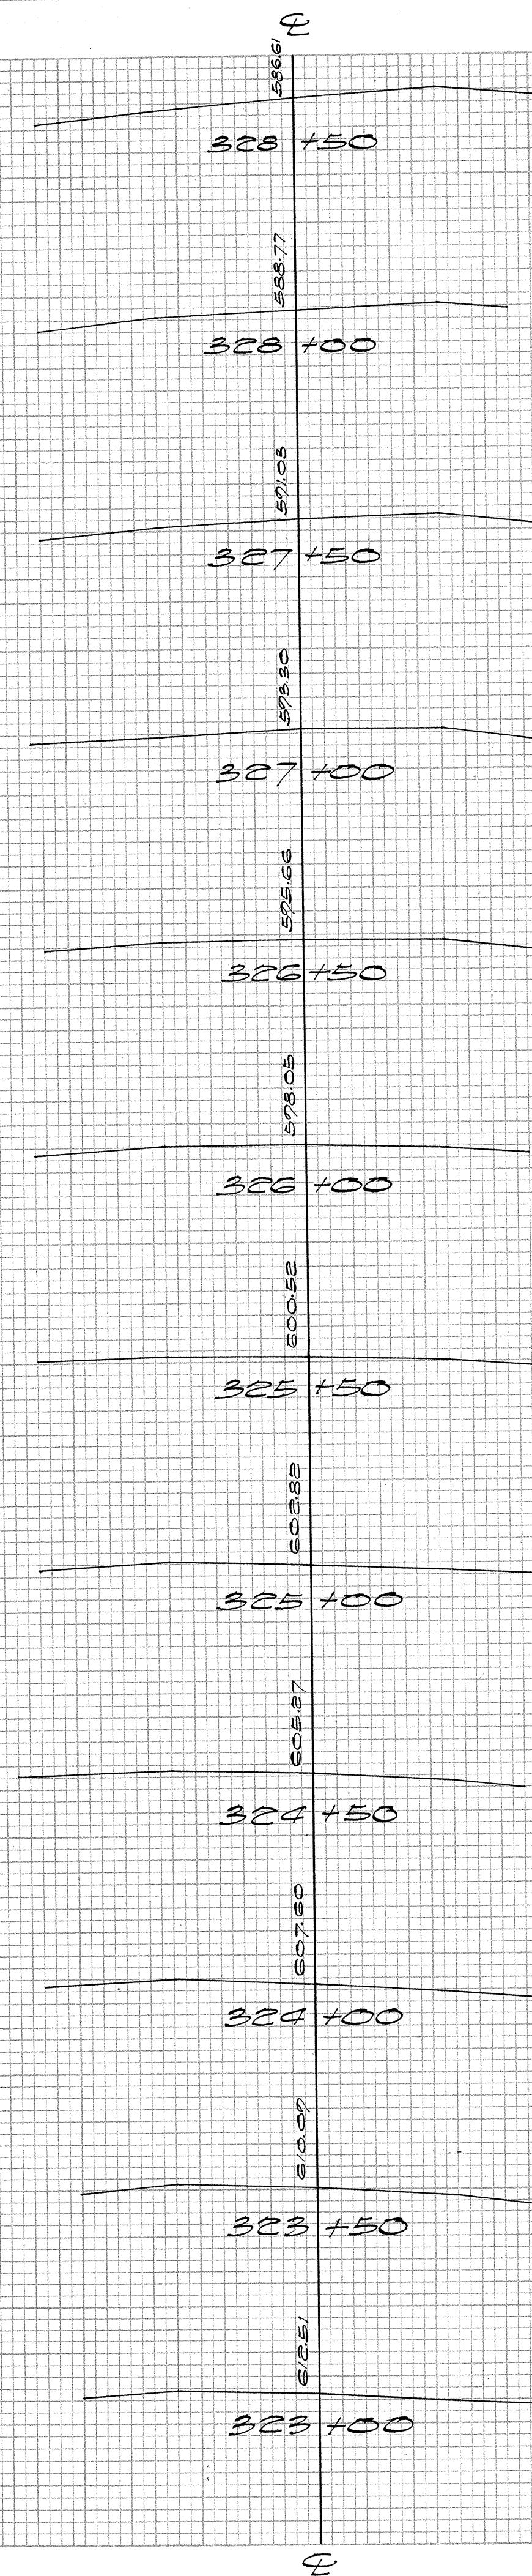





ORIGINAL		BY	DATE
SURVEY			
PLOTTED			
TEMPLATE			
AREAS			

As Built

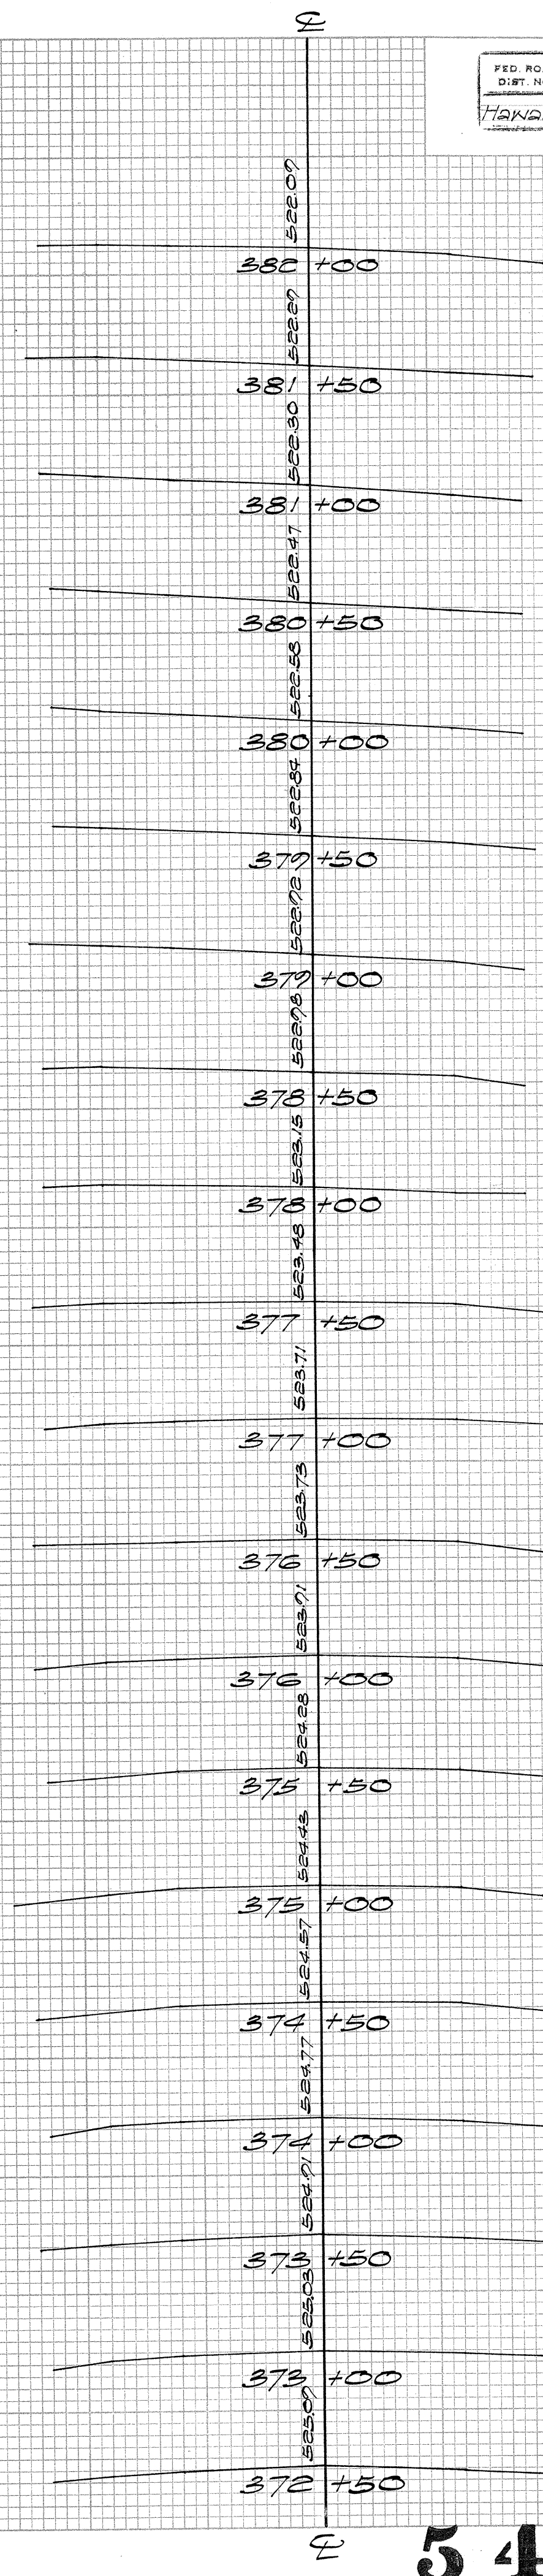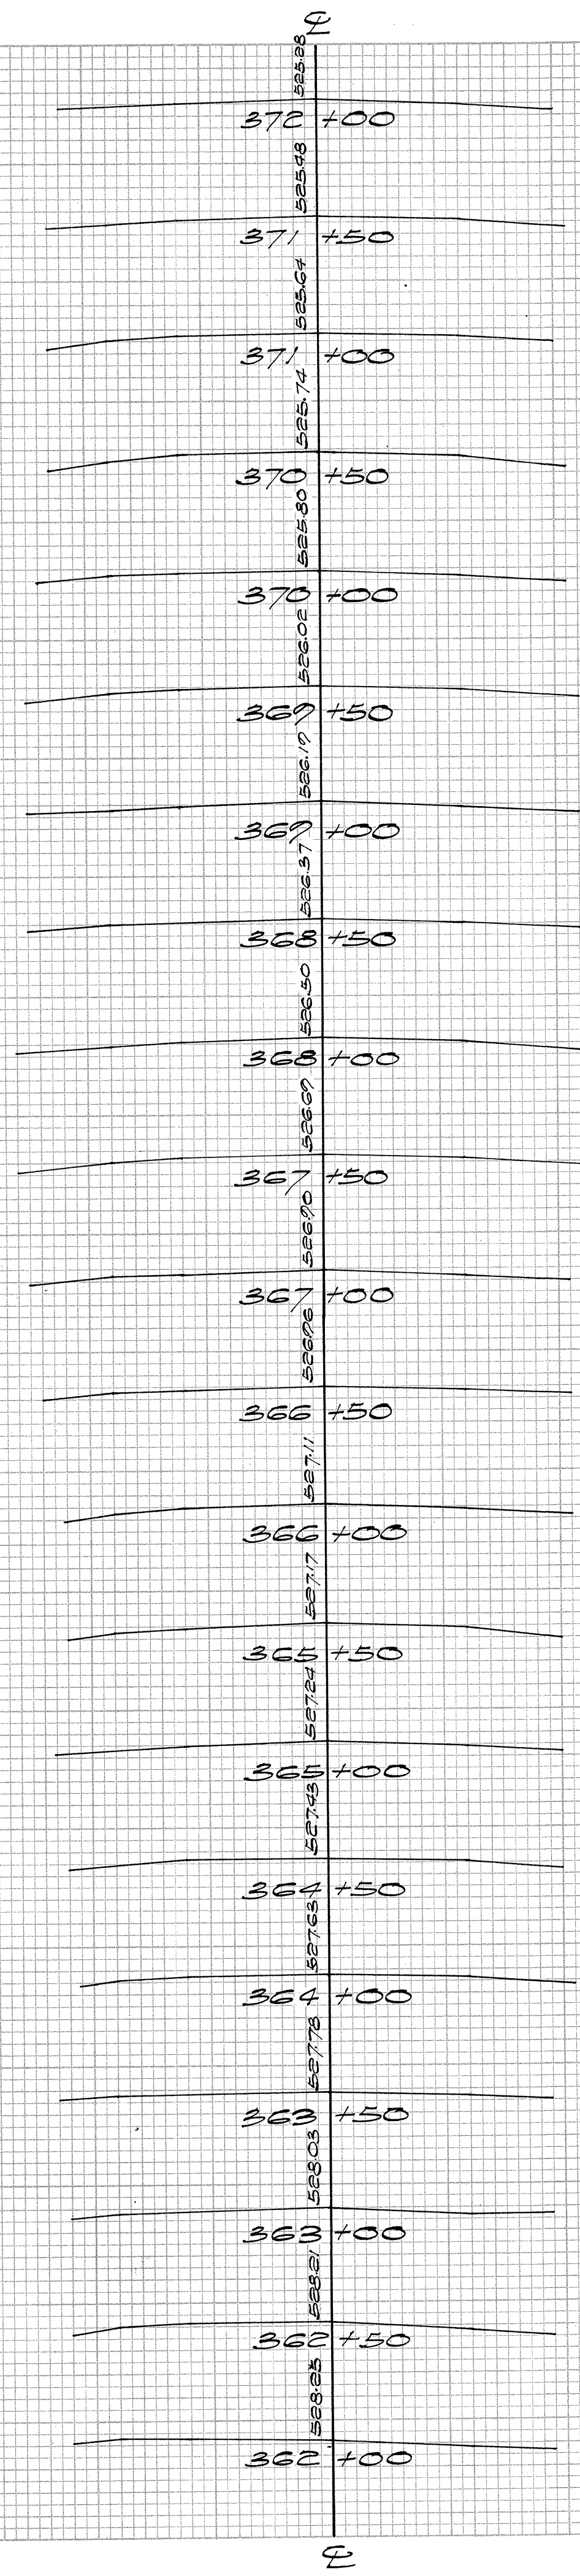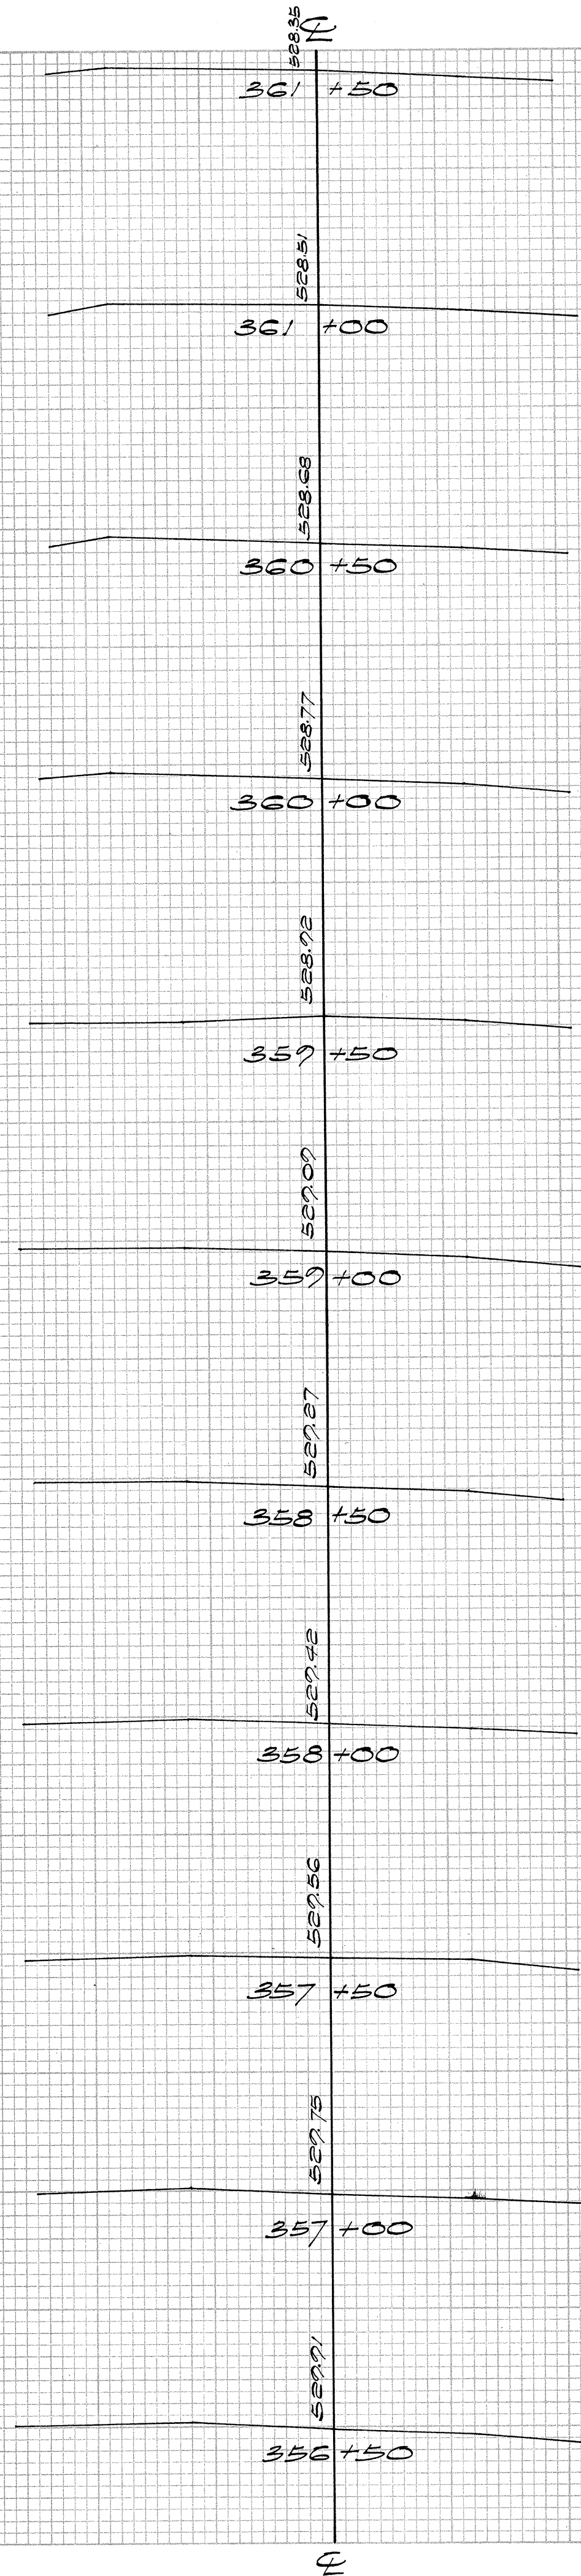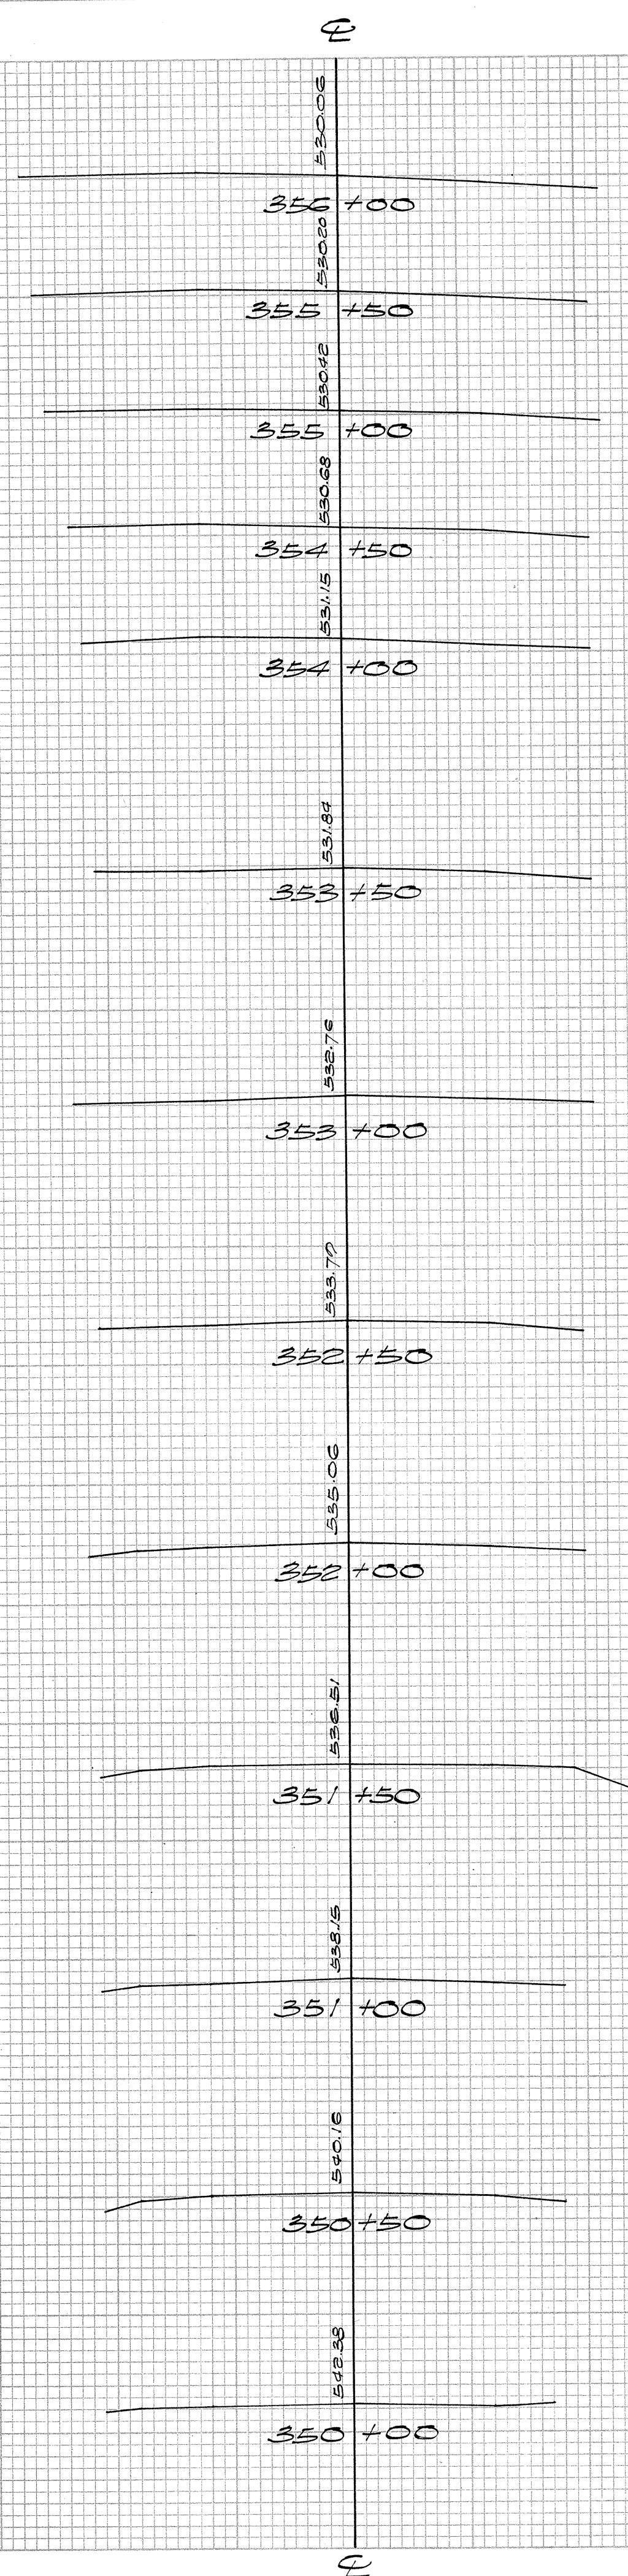

FINAL SURVEY NOTE BOOK NO.	SURVEYED	BY	DATE
	PLOTTED		
	AREAS		
	CHECKED		

ORIGINAL SURVEY NOTE BOOK NO.	SURVEYED	BY	DATE
	PLOTTED		
	AREAS		
	CHECKED		

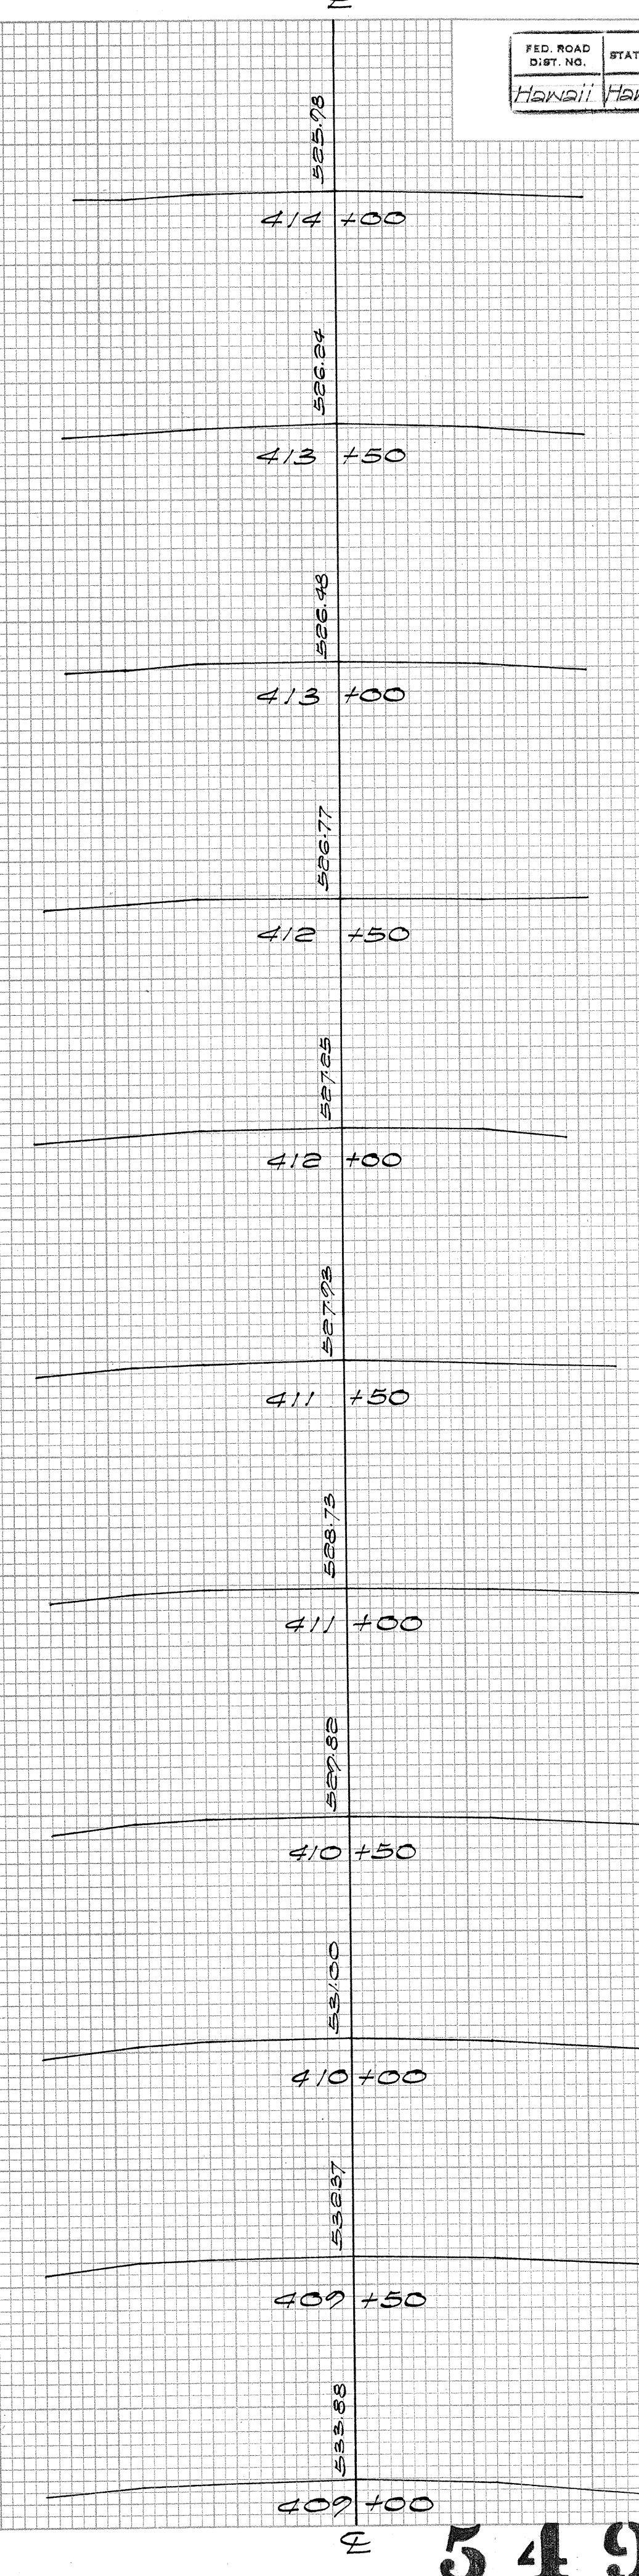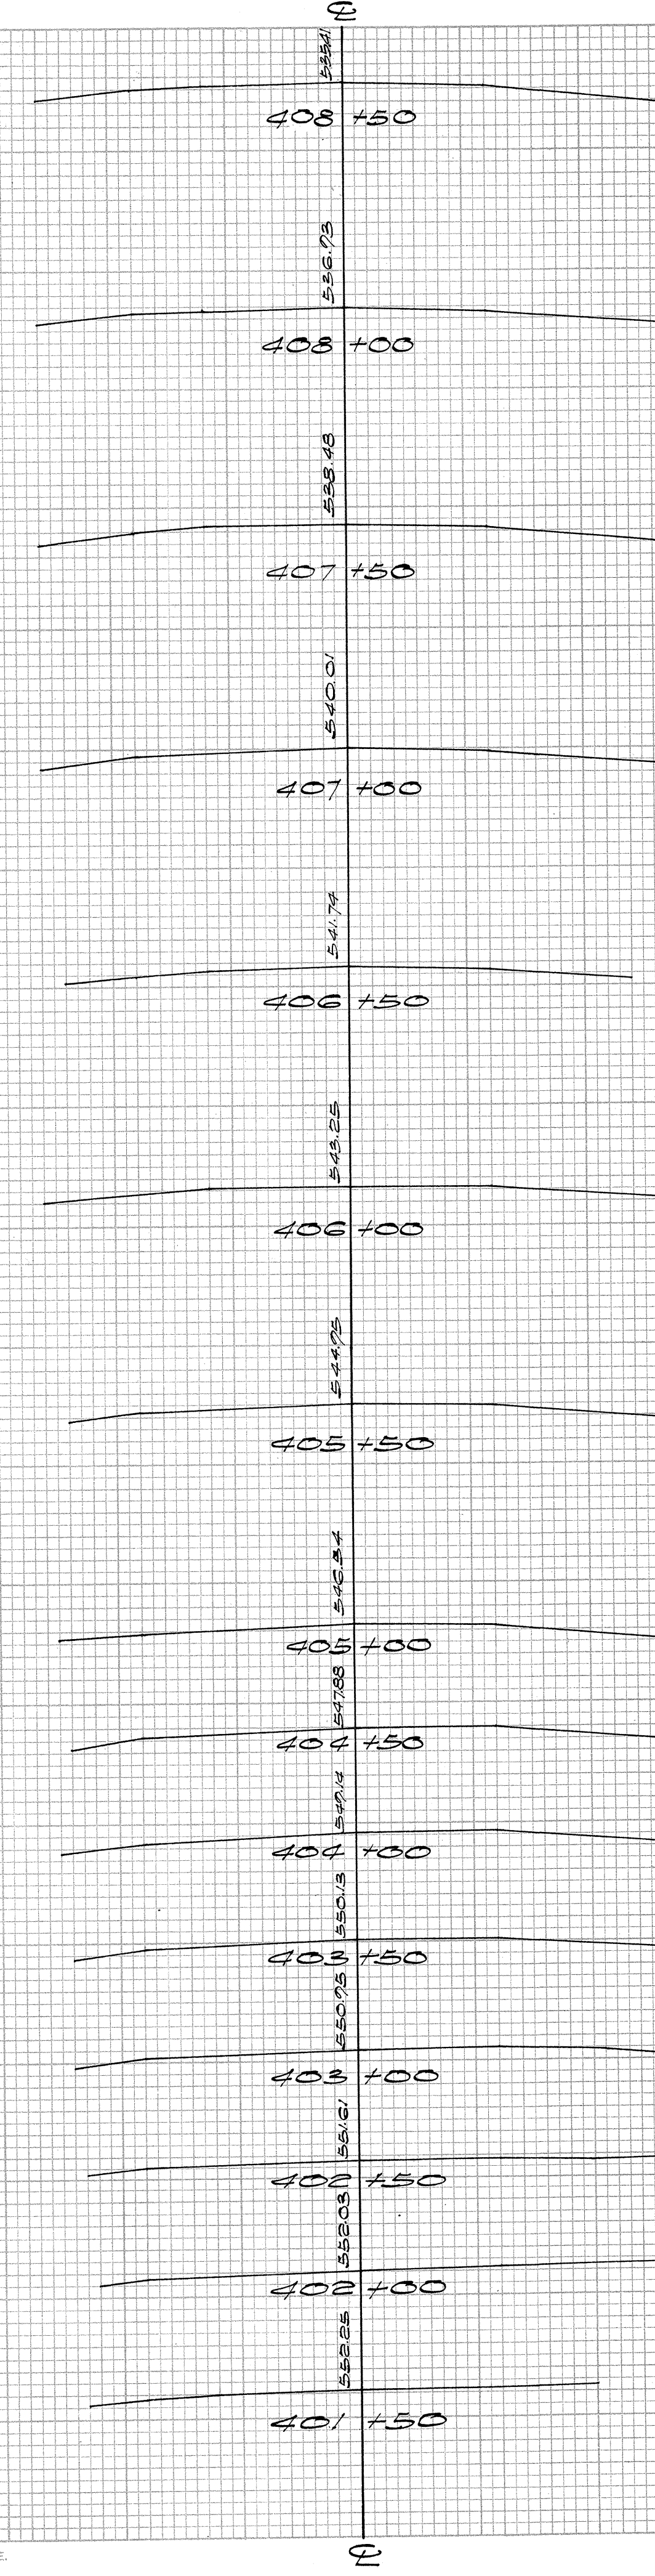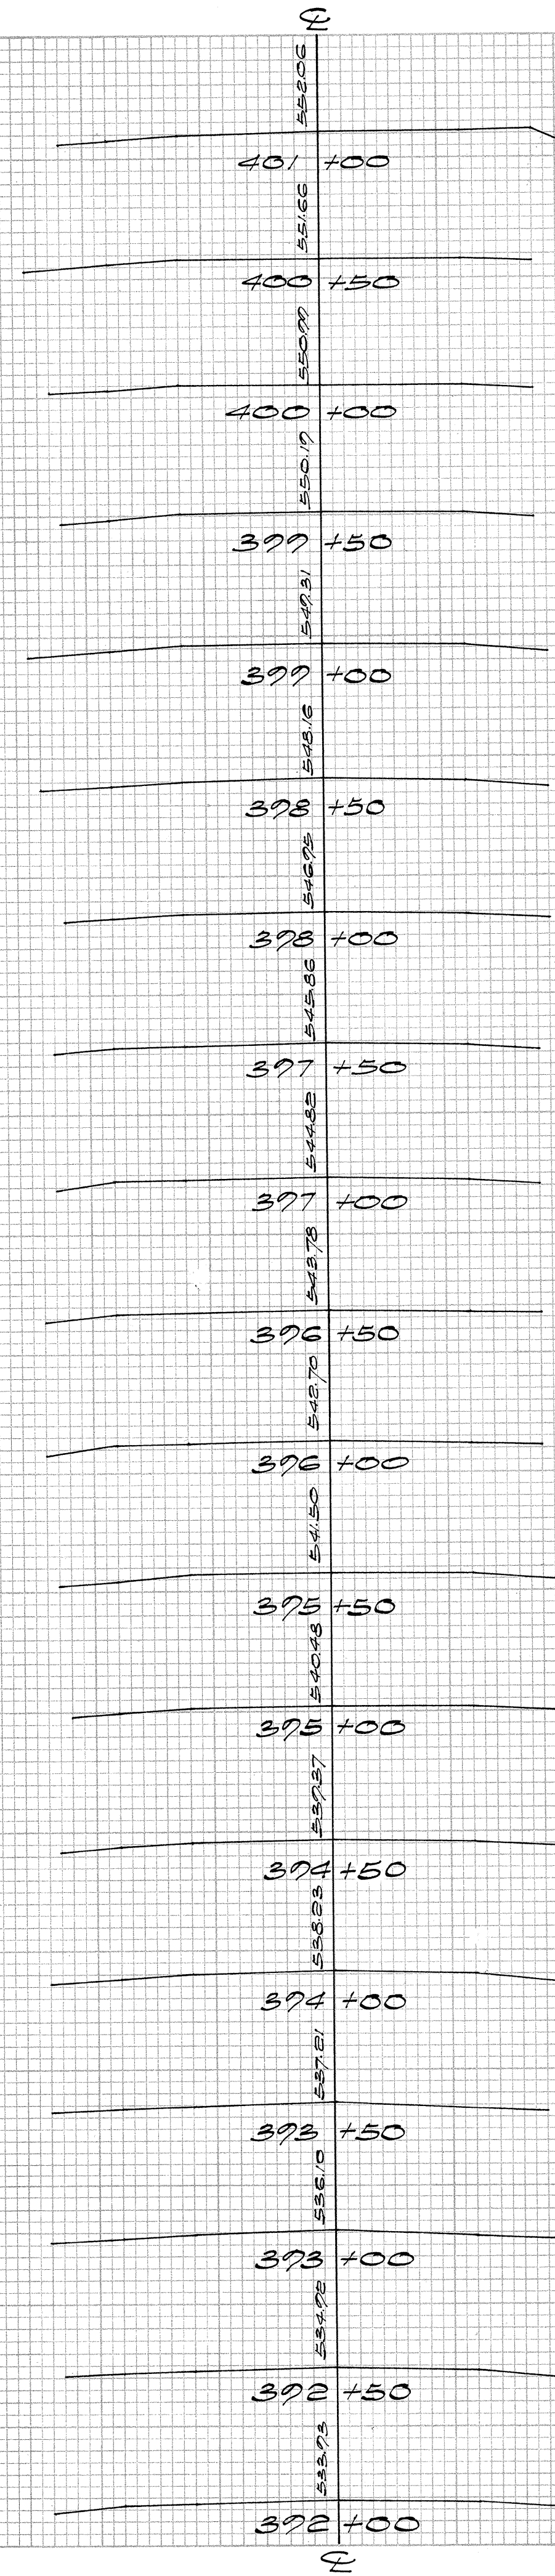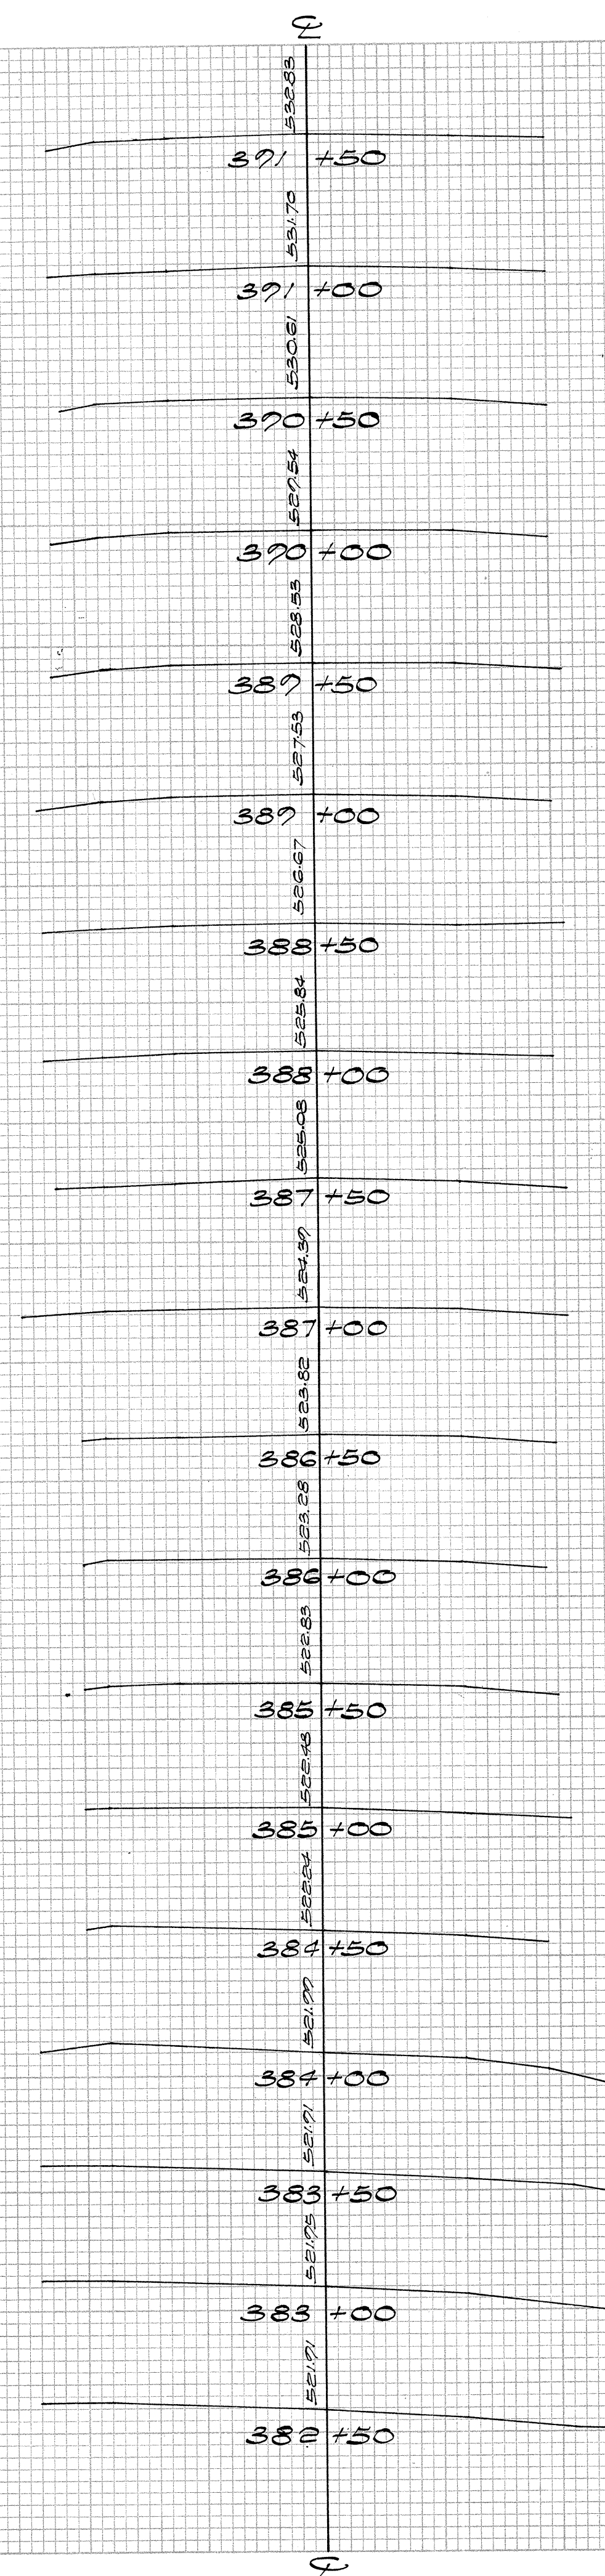

FED. ROAD DIST. NO.	STATE	FED. AID PROJ. NO.	FISCAL YEAR	SHEET NO.	TOTAL SHEETS
Handi	Hand	SP03	05/15	17	


As Built

FINAL SURVEY NOTE BOOK NO.	BY	DATE	SURVEYED	PLOTTED	DATE
			NOTED	DATE	DATE
			AREA CHECKED	DATE	DATE
			DATE	DATE	DATE
			DATE	DATE	DATE

ORIGINAL SURVEY NOTE BOOK NO.	BY	DATE	SURVEYED	PLOTTED	DATE
			NOTED	DATE	DATE
			AREA CHECKED	DATE	DATE
			DATE	DATE	DATE
			DATE	DATE	DATE

FED. ROAD DIST. NO.	STATE	FED. AID PROJ. NO.	FISCAL YEAR	SHEET NO.	TOTAL SHEETS
HAWAII	HI	5202(1051	16	17	

As Built

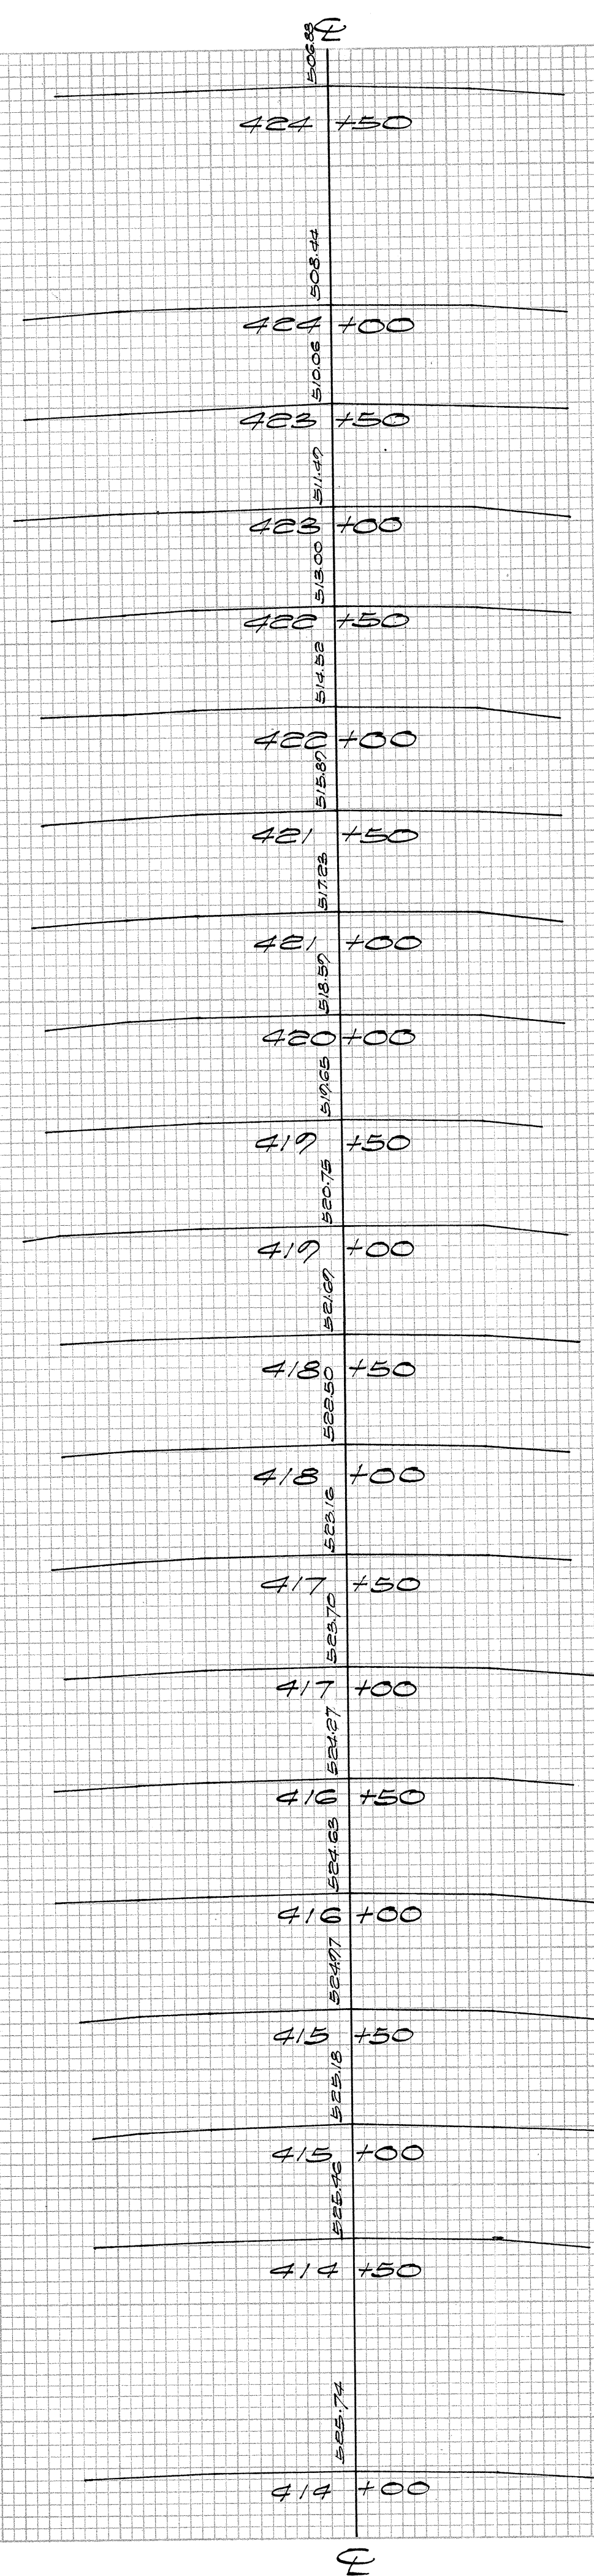

FED. ROAD DIST. NO.	STATE	FED. AID PROJ. NO.	FISCAL YEAR	SHEET NO.	TOTAL SHEETS
HAWAII	HAWAII	32038	1951	17	17

As Built

FINAL SURVEY NOTE BOOK NO.	SURVEYED	BY	DATE
	PLOTTED		
	TEMPLATE		
	AREAS CHECKED		

ORIGINAL SURVEY NOTE BOOK NO.	SURVEYED	BY	DATE
	PLOTTED		
	TEMPLATE		
	AREAS CHECKED		

