
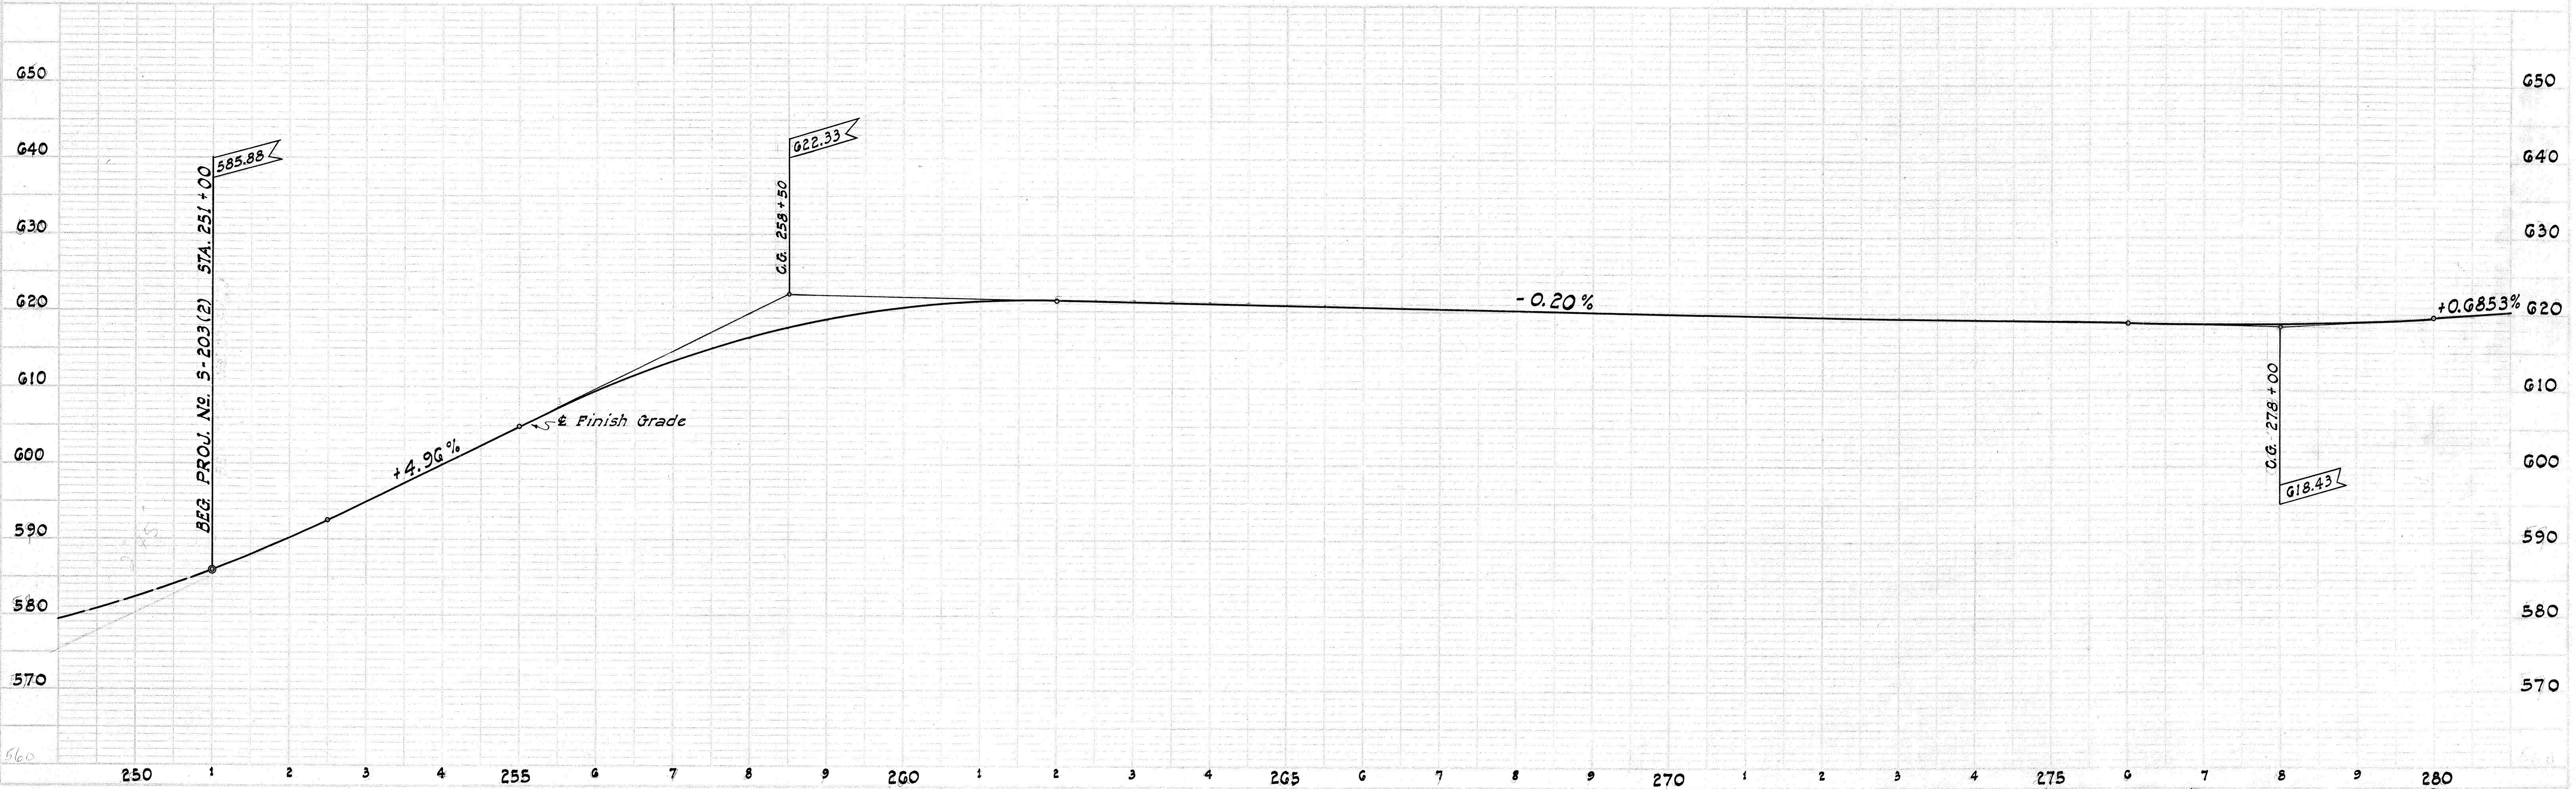


FED. ROAD DIST. NO.	STATE	FED. AID PROJ. NO.	FISCAL YEAR	SHEET NO.	TOTAL SHEETS
HAWAII	HAW.	5203(2)	1951	3A	17
"As Built"					

PLAN	DATE	BY
SURVEYED		
PLOTTED		
NOTE BOOK		
NO.		

PROFILE	DATE	BY
SURVEYED		
NOTE BOOK		
NO.		

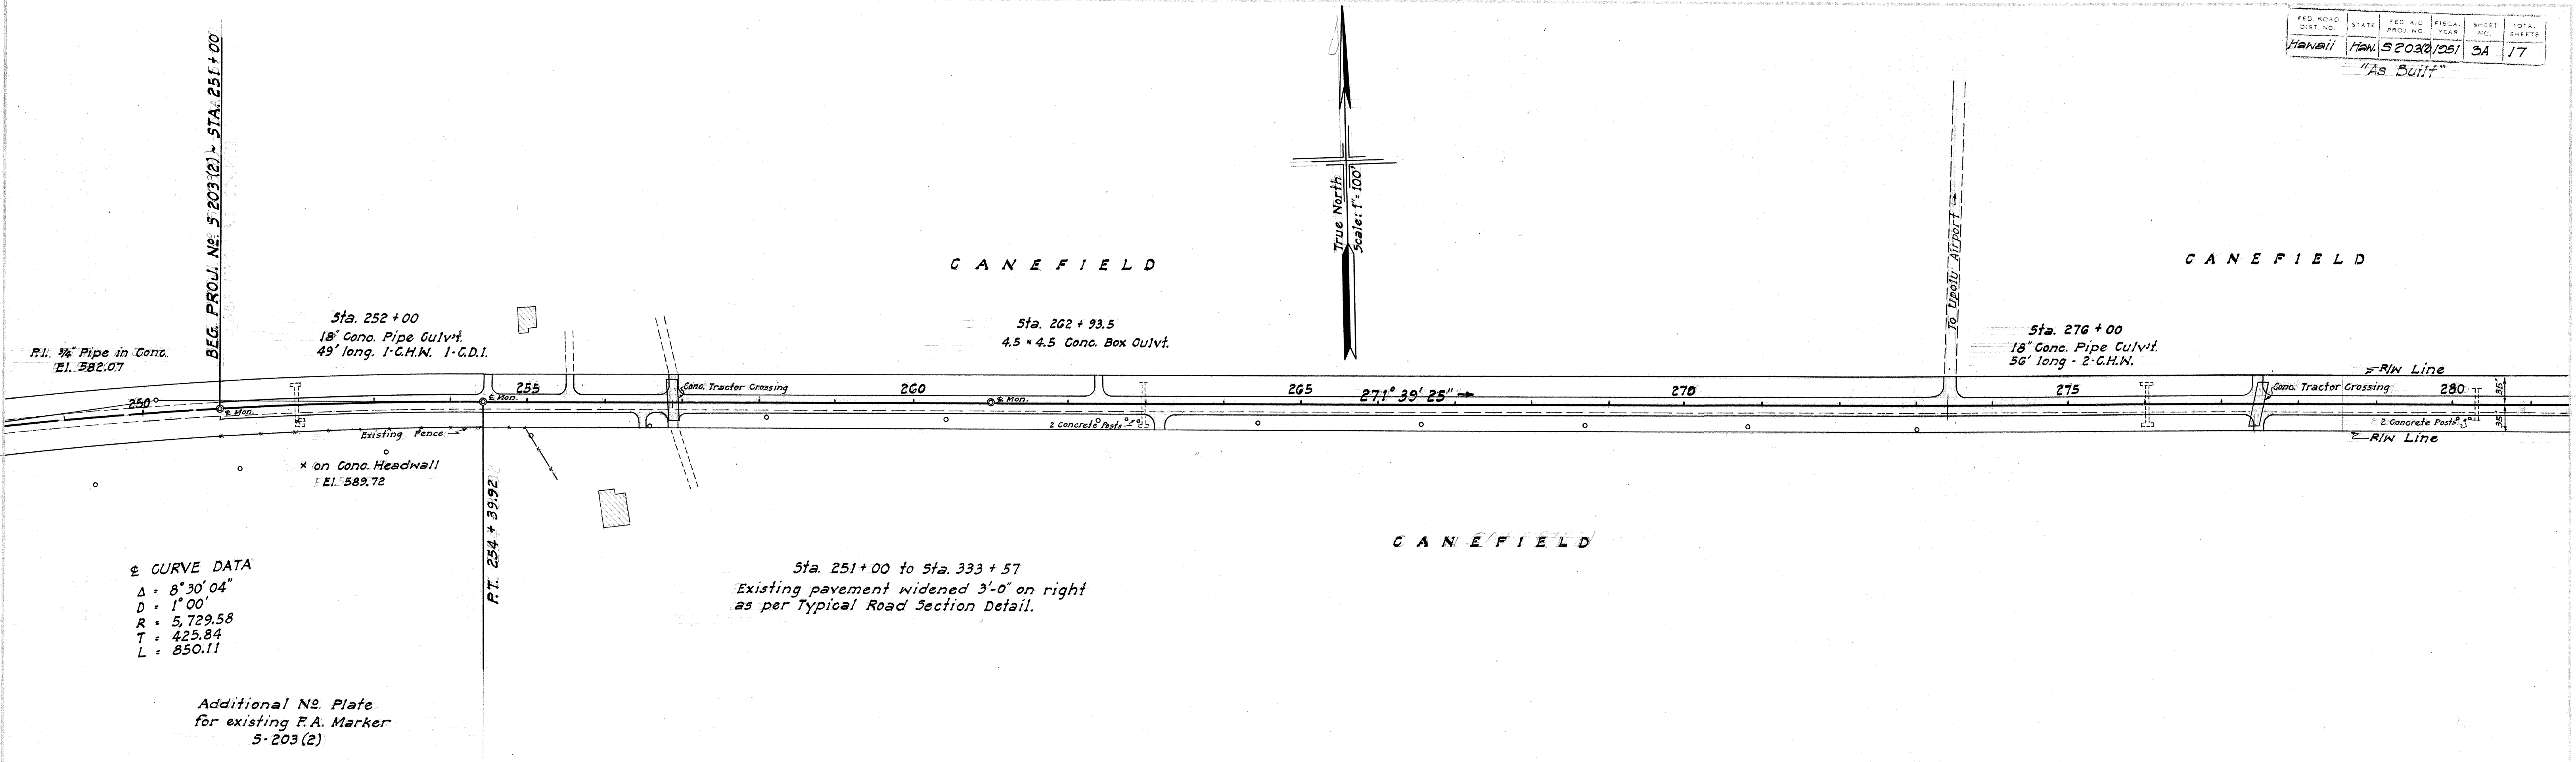


5495.3A

FED. ROAD DIST. NO.	STATE	FED. AID PROJ. NO.	FISCAL YEAR	SHEET NO.	TOTAL SHEETS
Hawaii	Haw.	5203(2)	1951	4A	17


"As Built"

PLAN	DATE
SURVEYED	
PLOTTED	
NOTES CHECKED	
NOTE BOOK NO.	
BY	

PROFILE	DATE
SURVEYED	
PLOTTED	
NOTES CHECKED	
NOTE BOOK NO.	
BY	
STRUCTURE NOTATIONS CHG.	

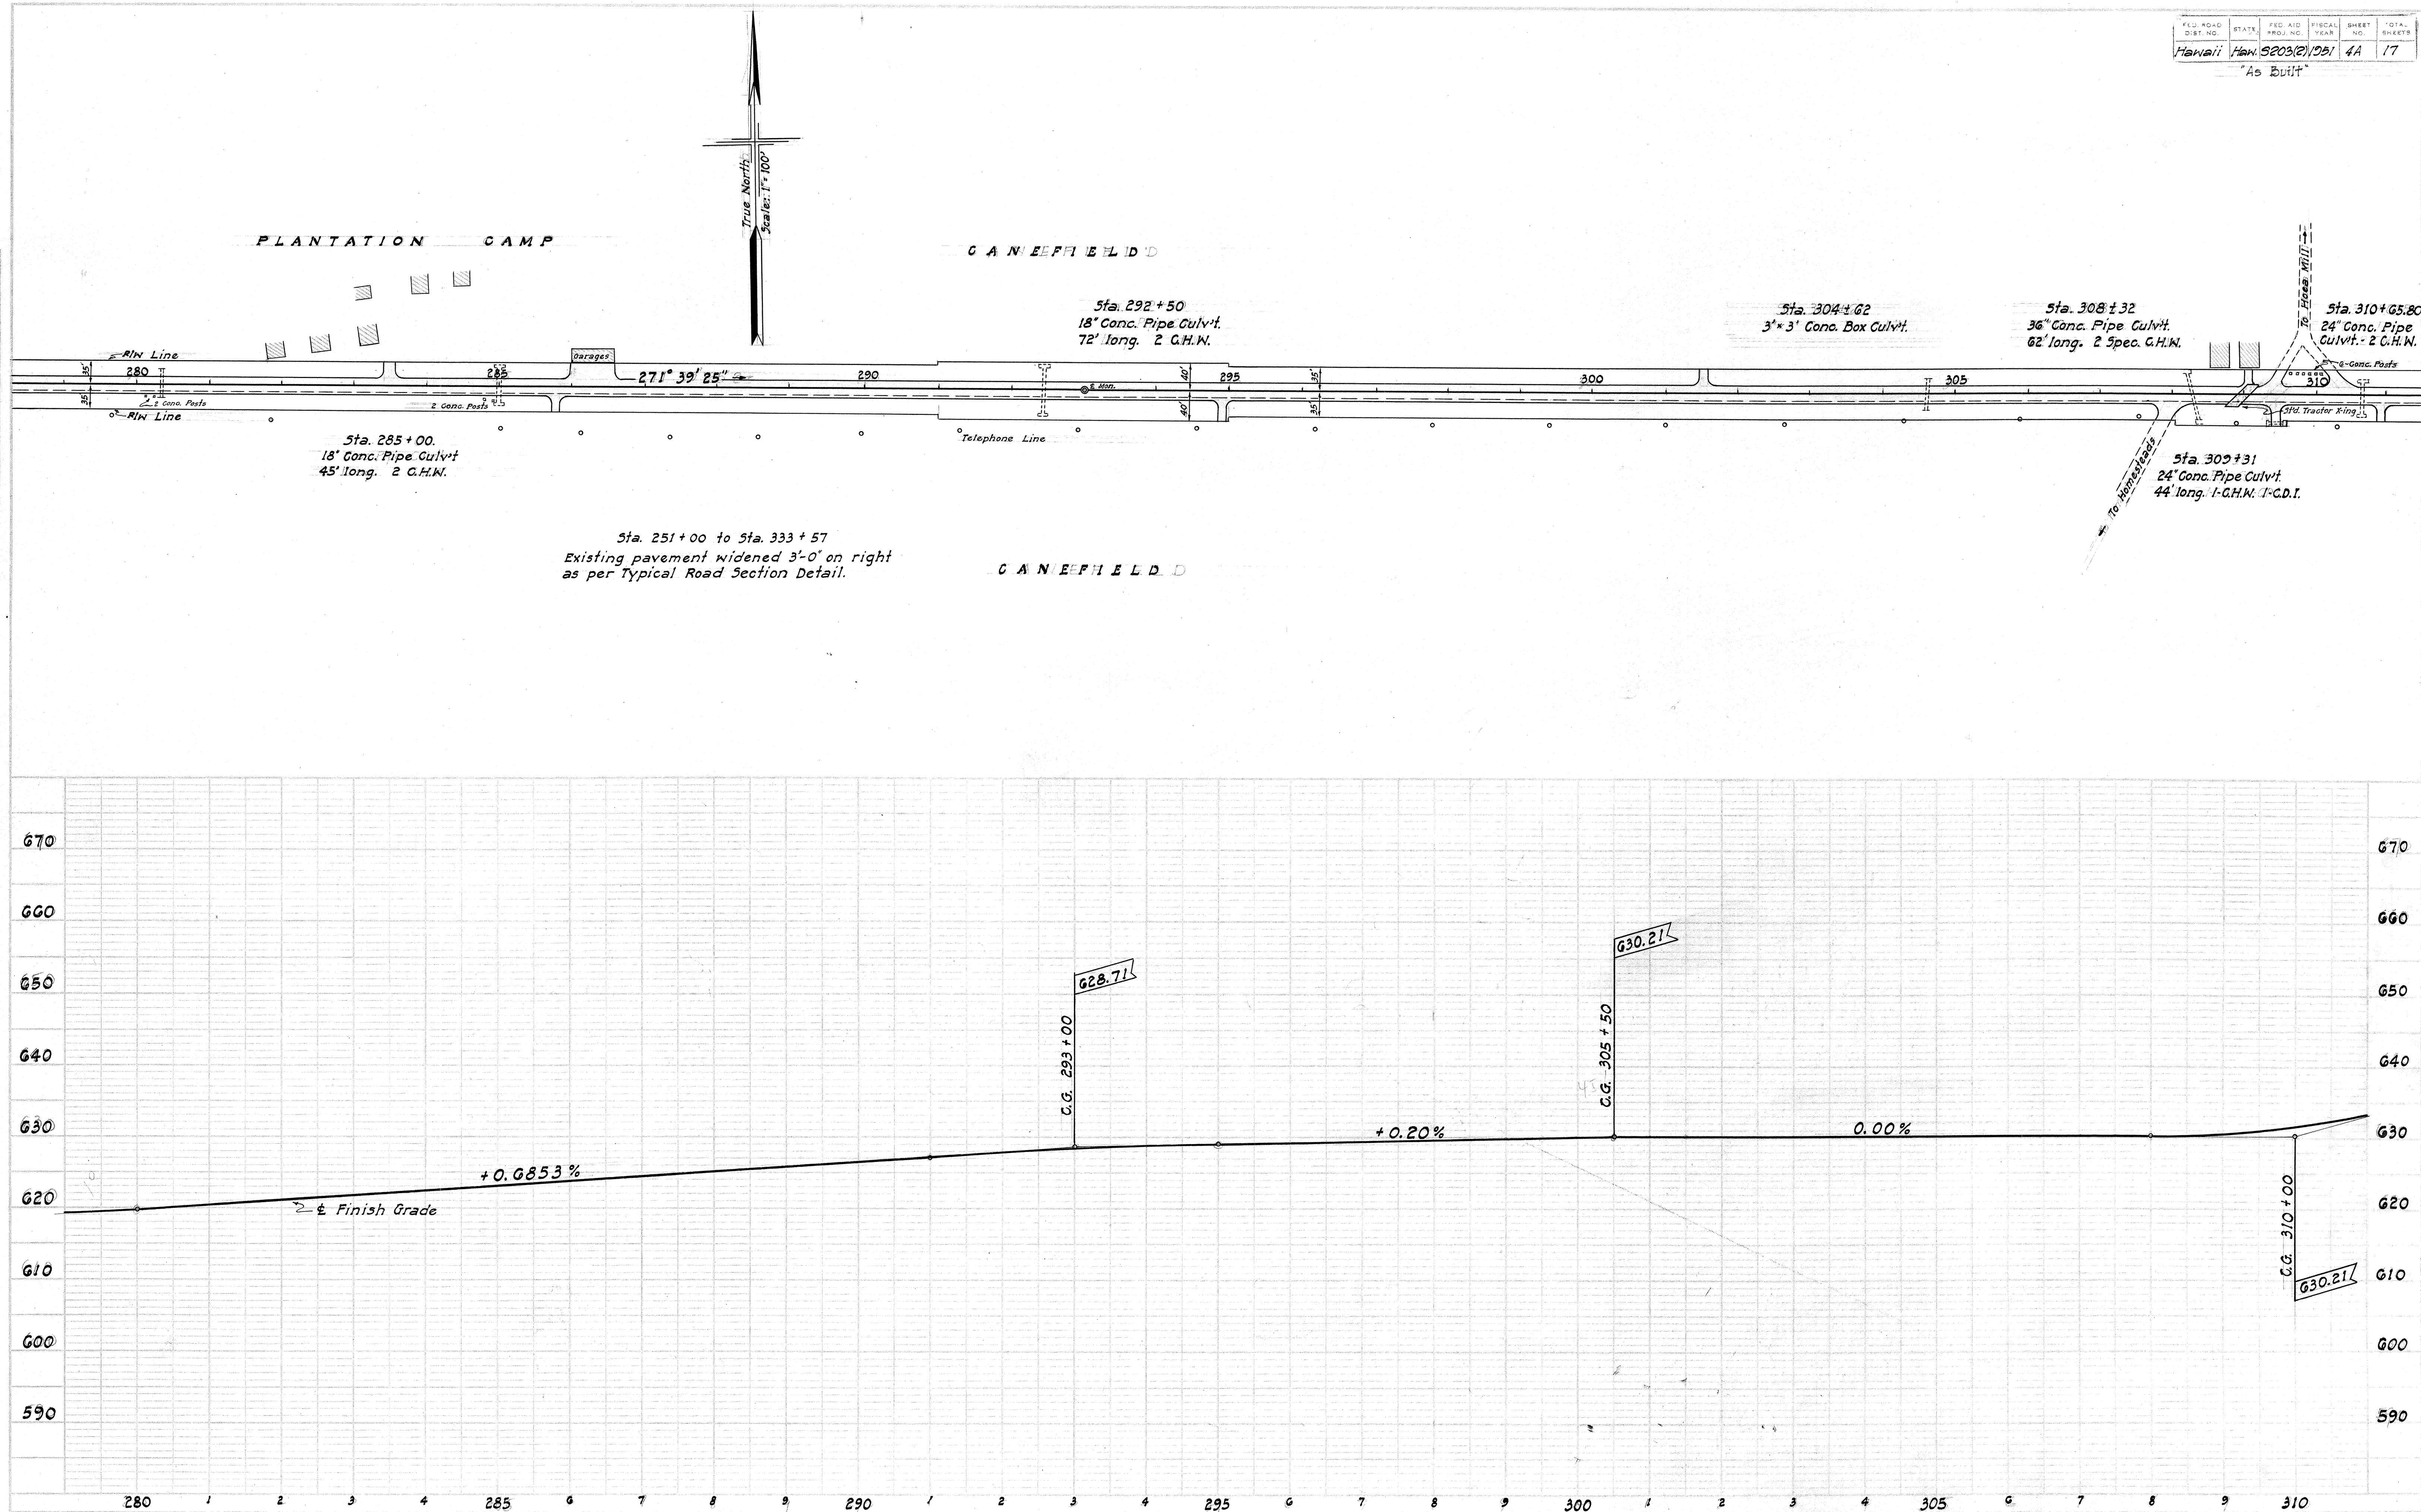

PLAN	SURVEYED	BY	DATE
	PLOTTED		
NOTE BOOK	ALIGNMENT CHECKED		
NO.	RT. OF WAY CHECKED		

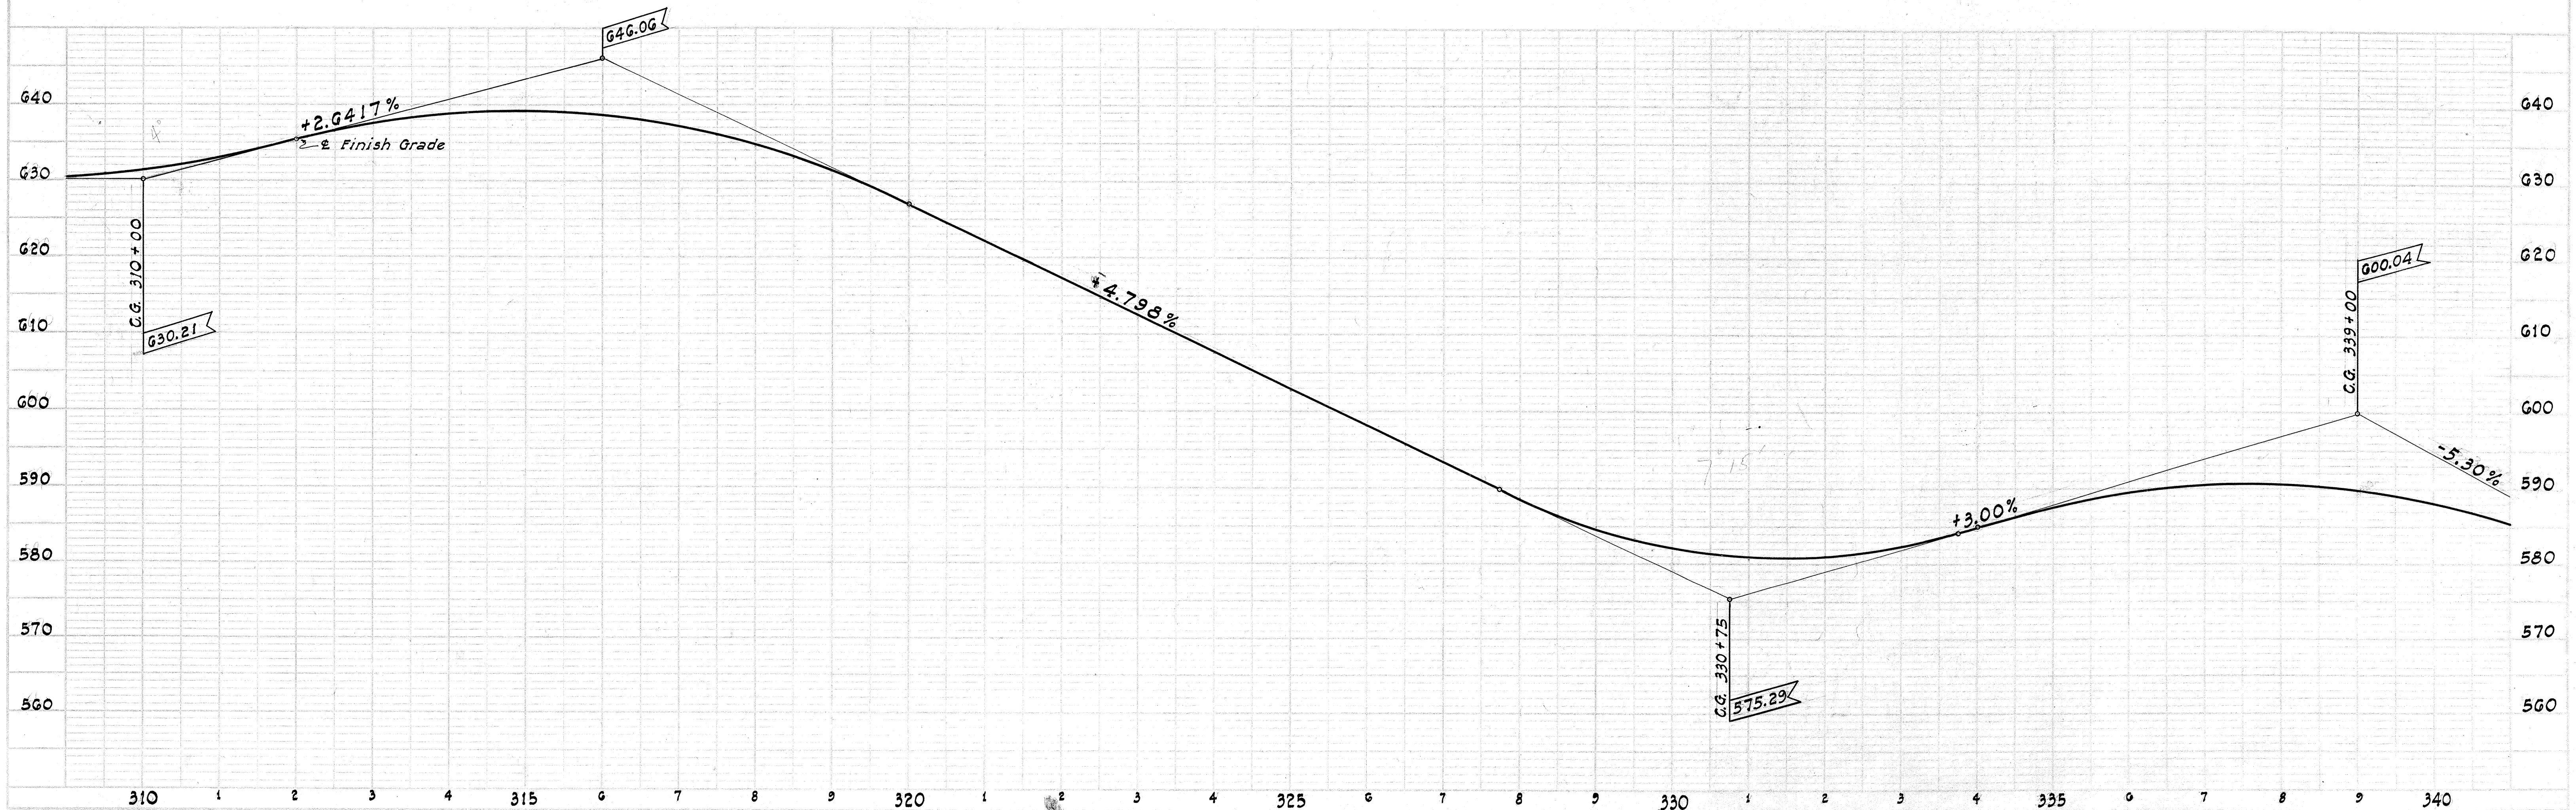

5495.5A

FED. ROAD DIST. NO.	STATE	FED. AID PROJ. NO.	FISCAL YEAR	SHEET NO.	TOTAL SHEETS
HAWAII	HA	5203(2)	1951	GA	17

"As Built"

PLAN	DATE	BY
SURVEYED		
NOTED		
NOTE BOOK ALIGNED CHECKED		
NO.		

Sta. 333+57 to Sta. 343+00
Existing 44'-0" wide pavement resurfaced to full width.

Sta. 343+00 to Sta. 449+00
6'-0" sidewalk constructed on left side as per detail.

PLANTATION COTTAGES

PLANTATION EXPERIMENT GARDEN

Sta. 365+50
24" Conc. Pipe Culvert.
50' long. 2 C.H.W.

Sta. 351+00
30" Circ. Conc. Syphon




Sta. 354+00
24" Conc. Pipe Culvert.
50' long. 2 C.H.W.

Sta. 343+00 to Sta. 354+14.67
Existing pavement widened 1'-6" on both sides as per Typical Road Section Detail.

2 CURVE DATA

$\Delta = 15^\circ 53' 50''$
 $D = 2^\circ 00'$
 $R = 2864.79$
 $T = 400.00$
 $L = 794.86$

Sta. 354+14.67 to Sta. 449+00
Existing pavement widened 3'-0" on right side as per Typical Road Section Detail.

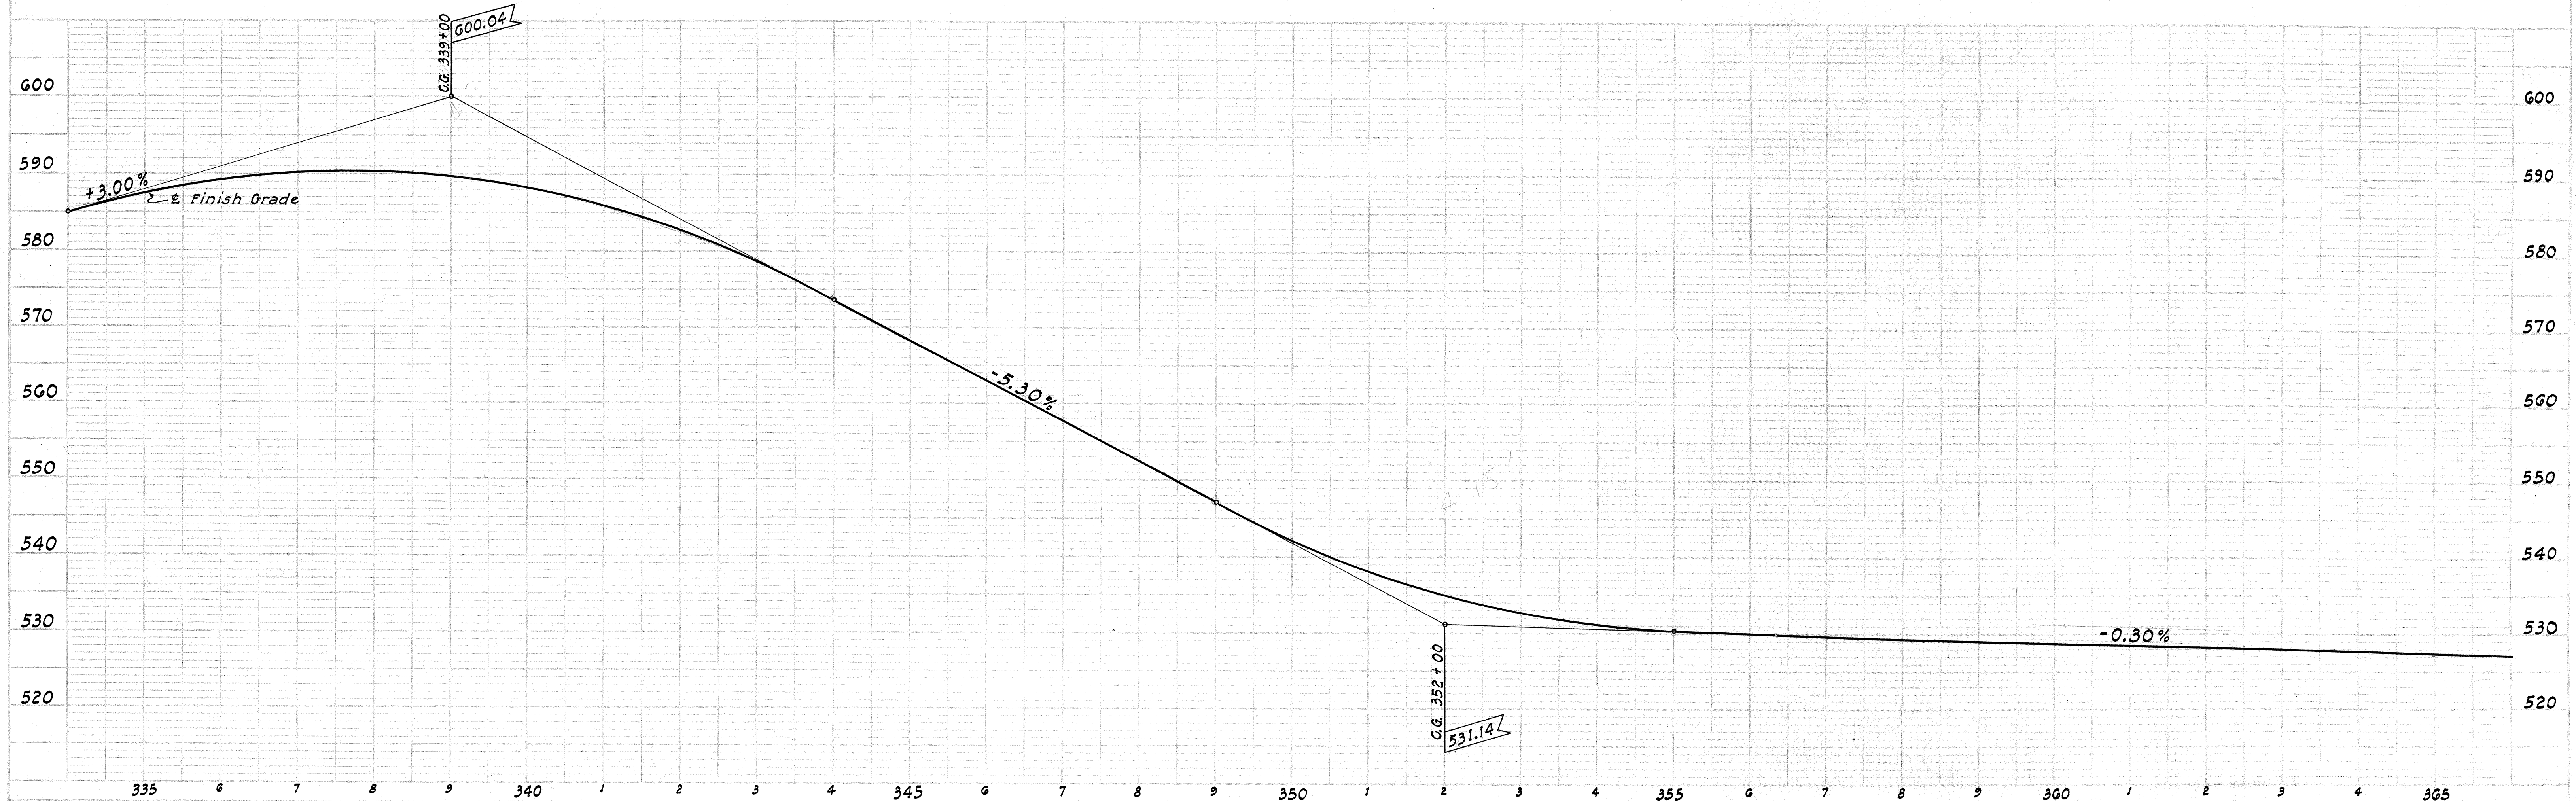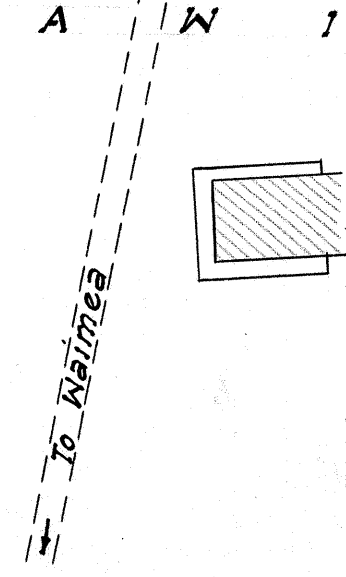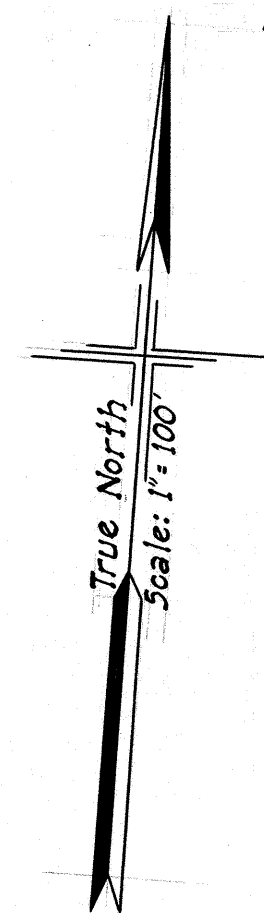

PROFILE	DATE	BY
SURVEYED		
NOTED		
NOTE BOOK GRADES CHECKED		
NO.		

PLATE 1 - PLAN-PROFILE 3. A. B. & C. STANDARD
HUNTER & BROWN CO., NEW YORK

K. N. E. CO. INC. 245-1115



5495.6A

PLAN	DATE	BY
SURVEYED		
PLOTTED		
NOTE BOOK GRADES CHECKED		
NO. OF WAY CHECKED		

PROFILE	DATE	BY
SURVEYED		
NOTE BOOK GRADES CHECKED		
NO. OF WAY CHECKED		

STATE	FED. AID	FISCAL	SHEET	TOTAL
HAWAII	PLAN	8203/01/05/	6A	17
"As Built"				

± CURVE DATA
 $\Delta = 4^{\circ} 56' 21''$
 $D = 1^{\circ} 00'$
 $R = 5,729.58'$
 $T = 247.11'$
 $L = 493.92'$

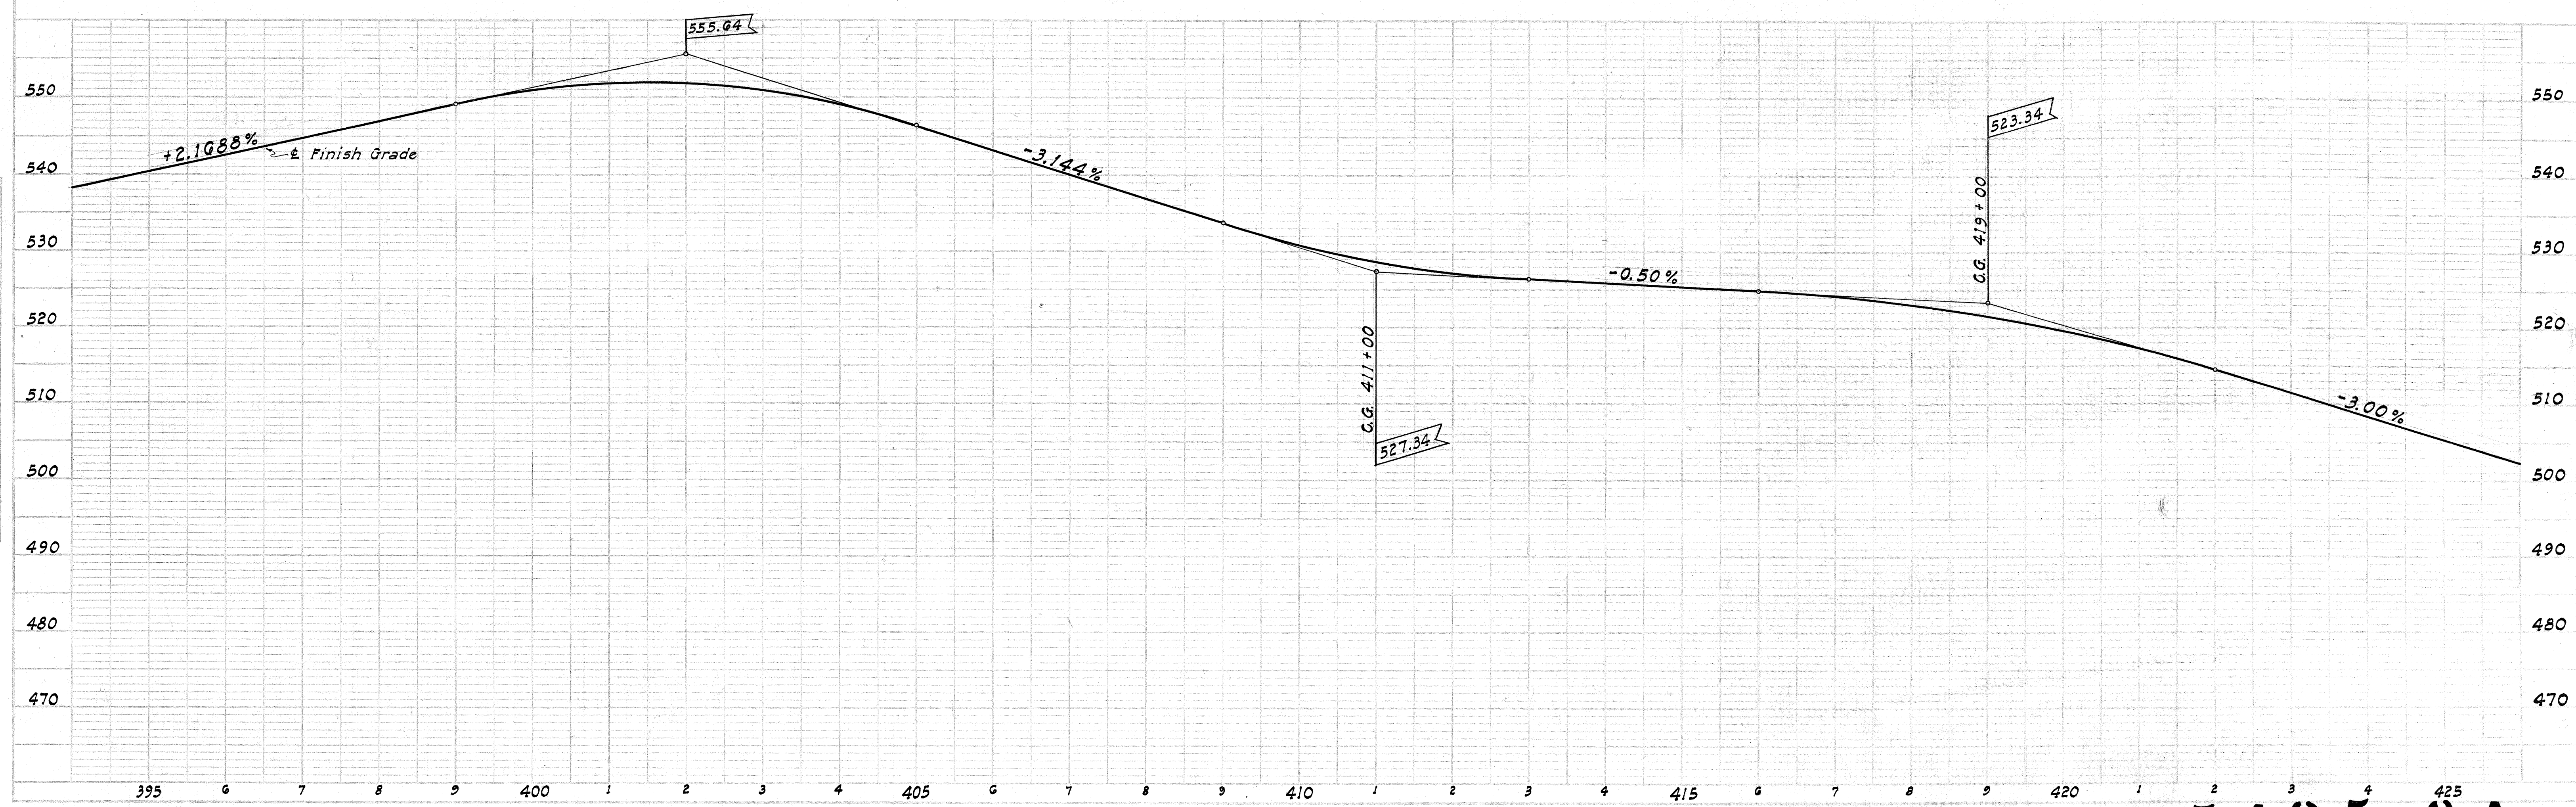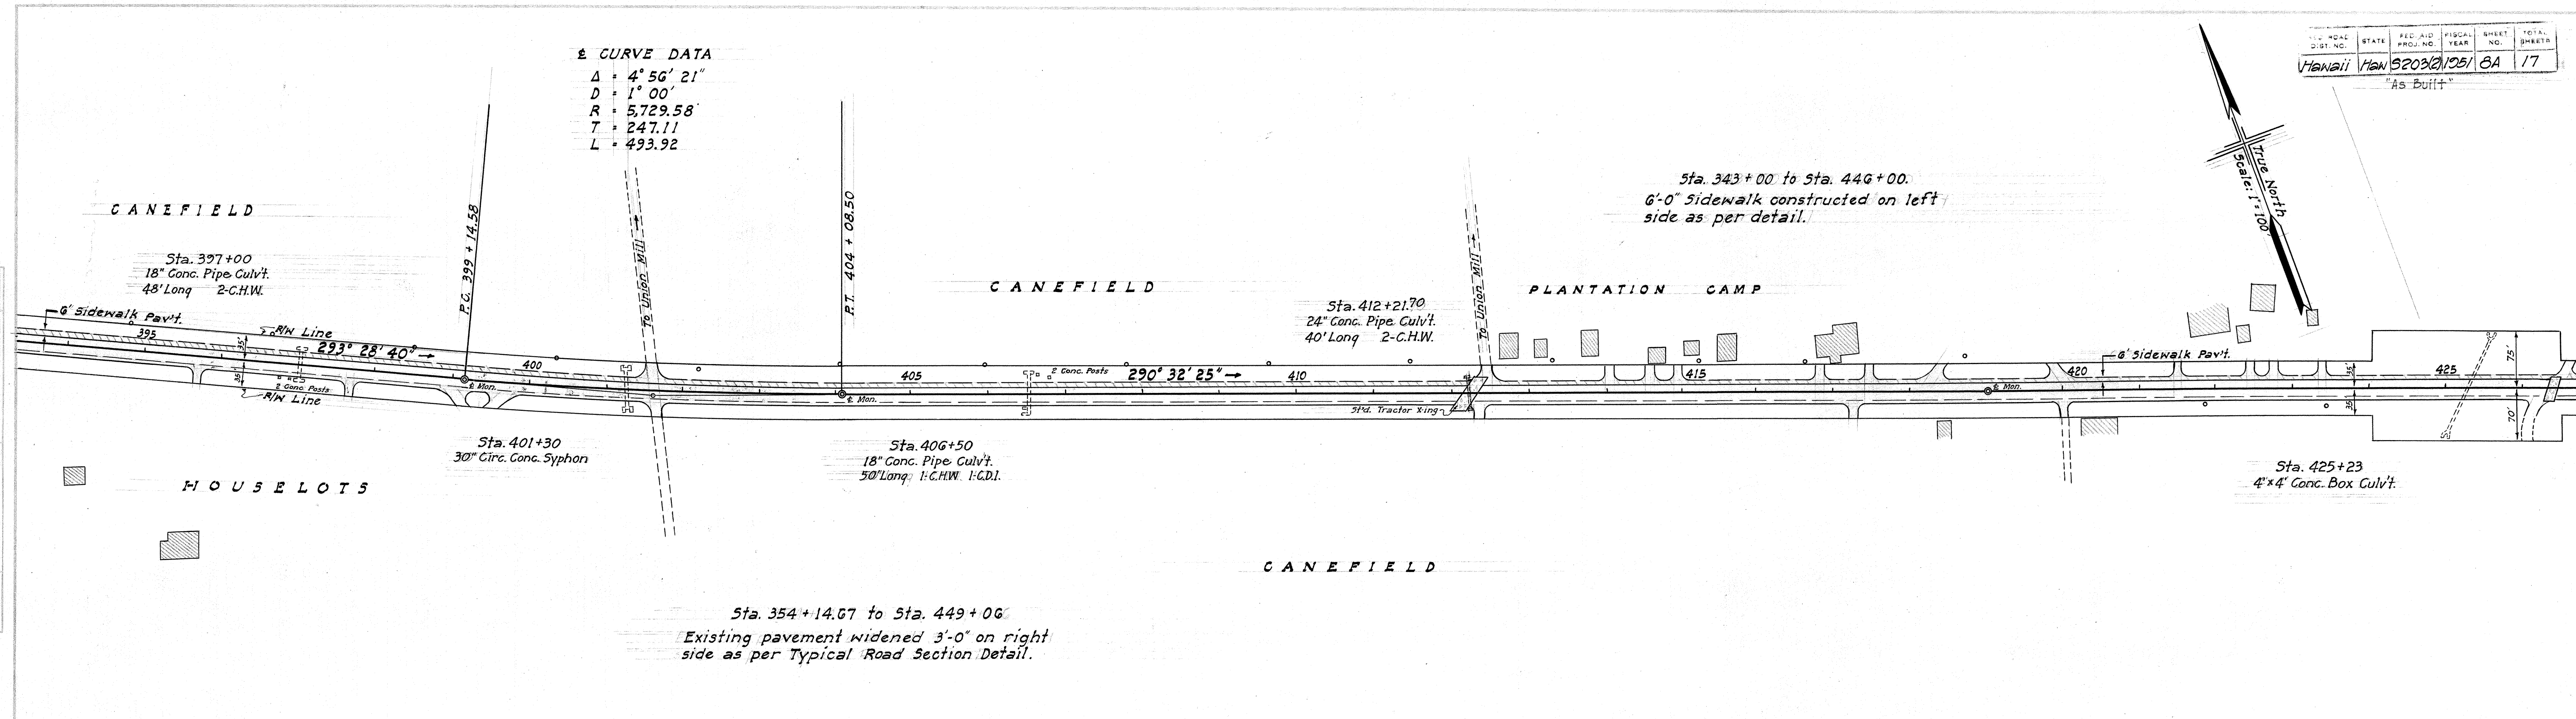

5495.SA

PLAN	DATE	BY
SURVEYED		
NOTE BOOK		
ALIGNED		
NO. OF WAY CHECKED		

PROFILE	DATE	BY
SURVEYED		
NOTE BOOK		
GRADES CHECKED		
NO. OF WAY CHECKED		

FILE NO.	STATE	FED. AID	FISCAL	SHEET	TOTAL
11111	11111	520321061	0A	17	

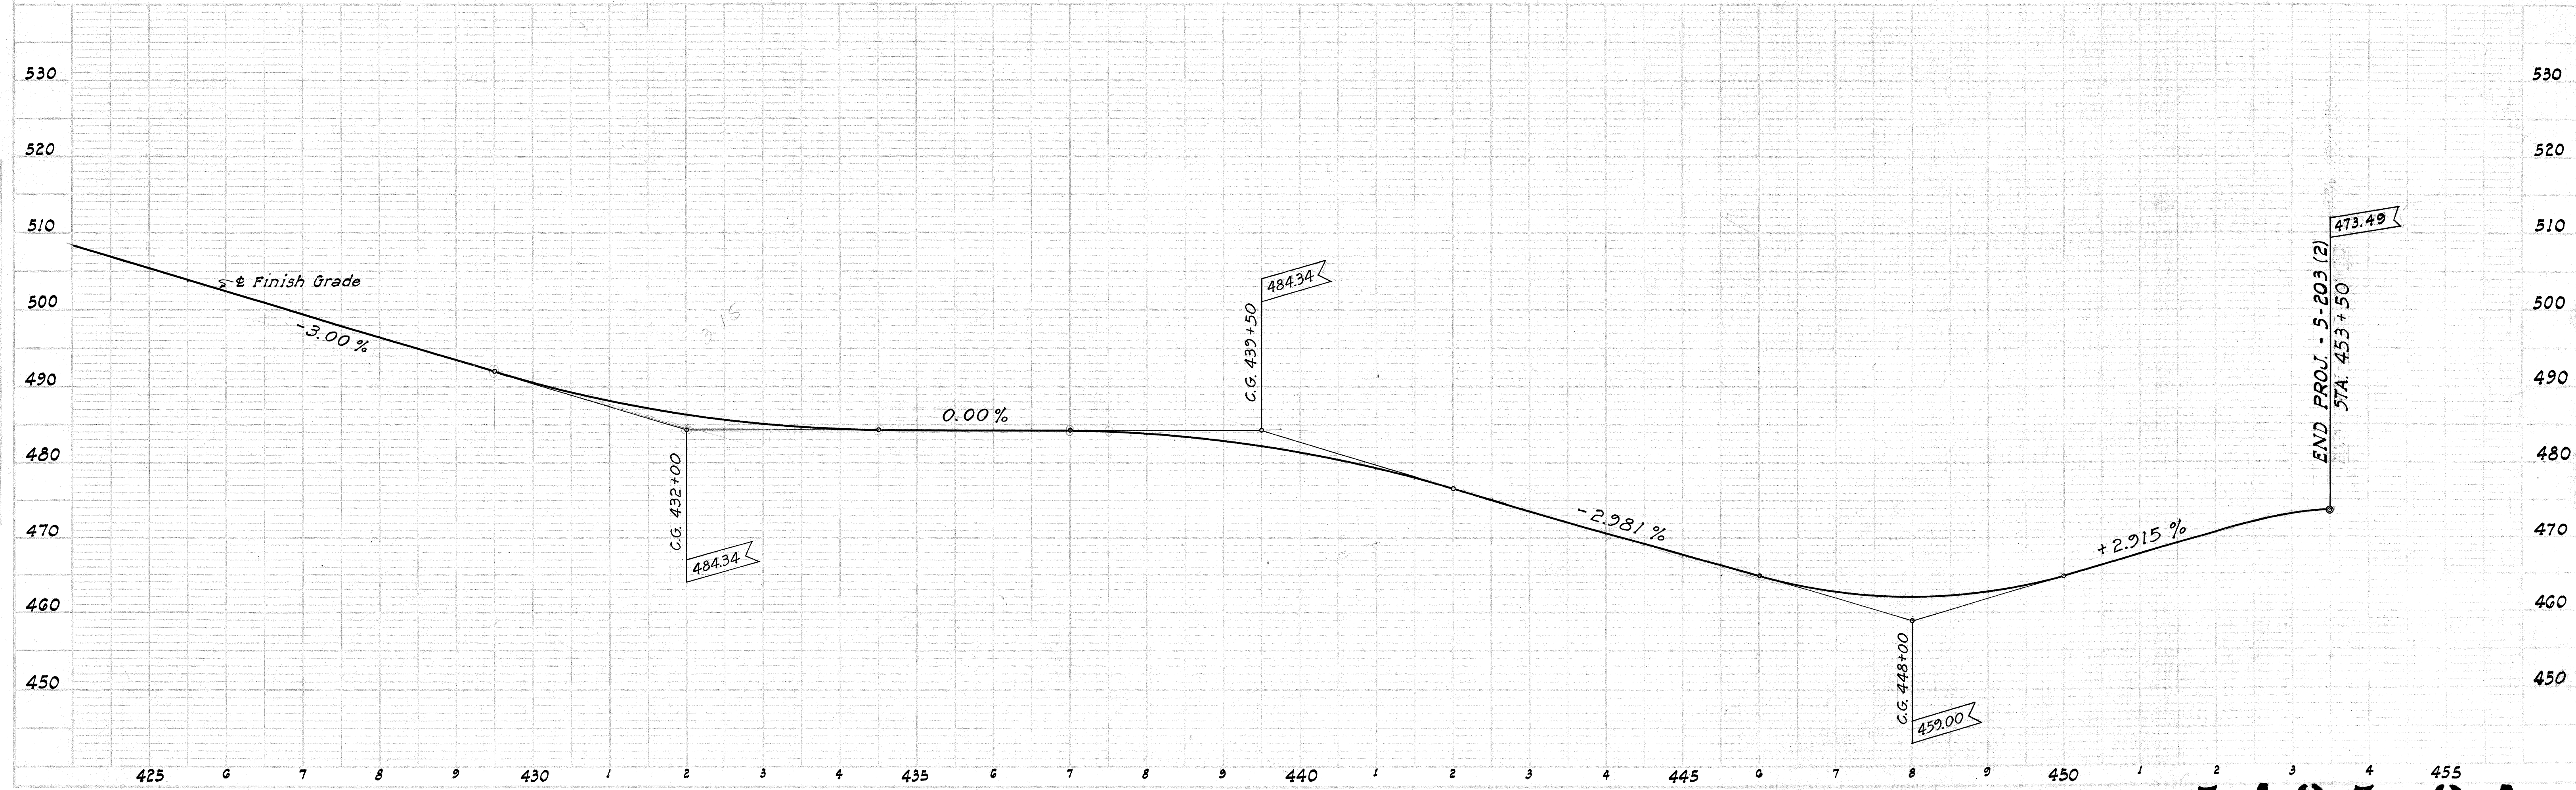
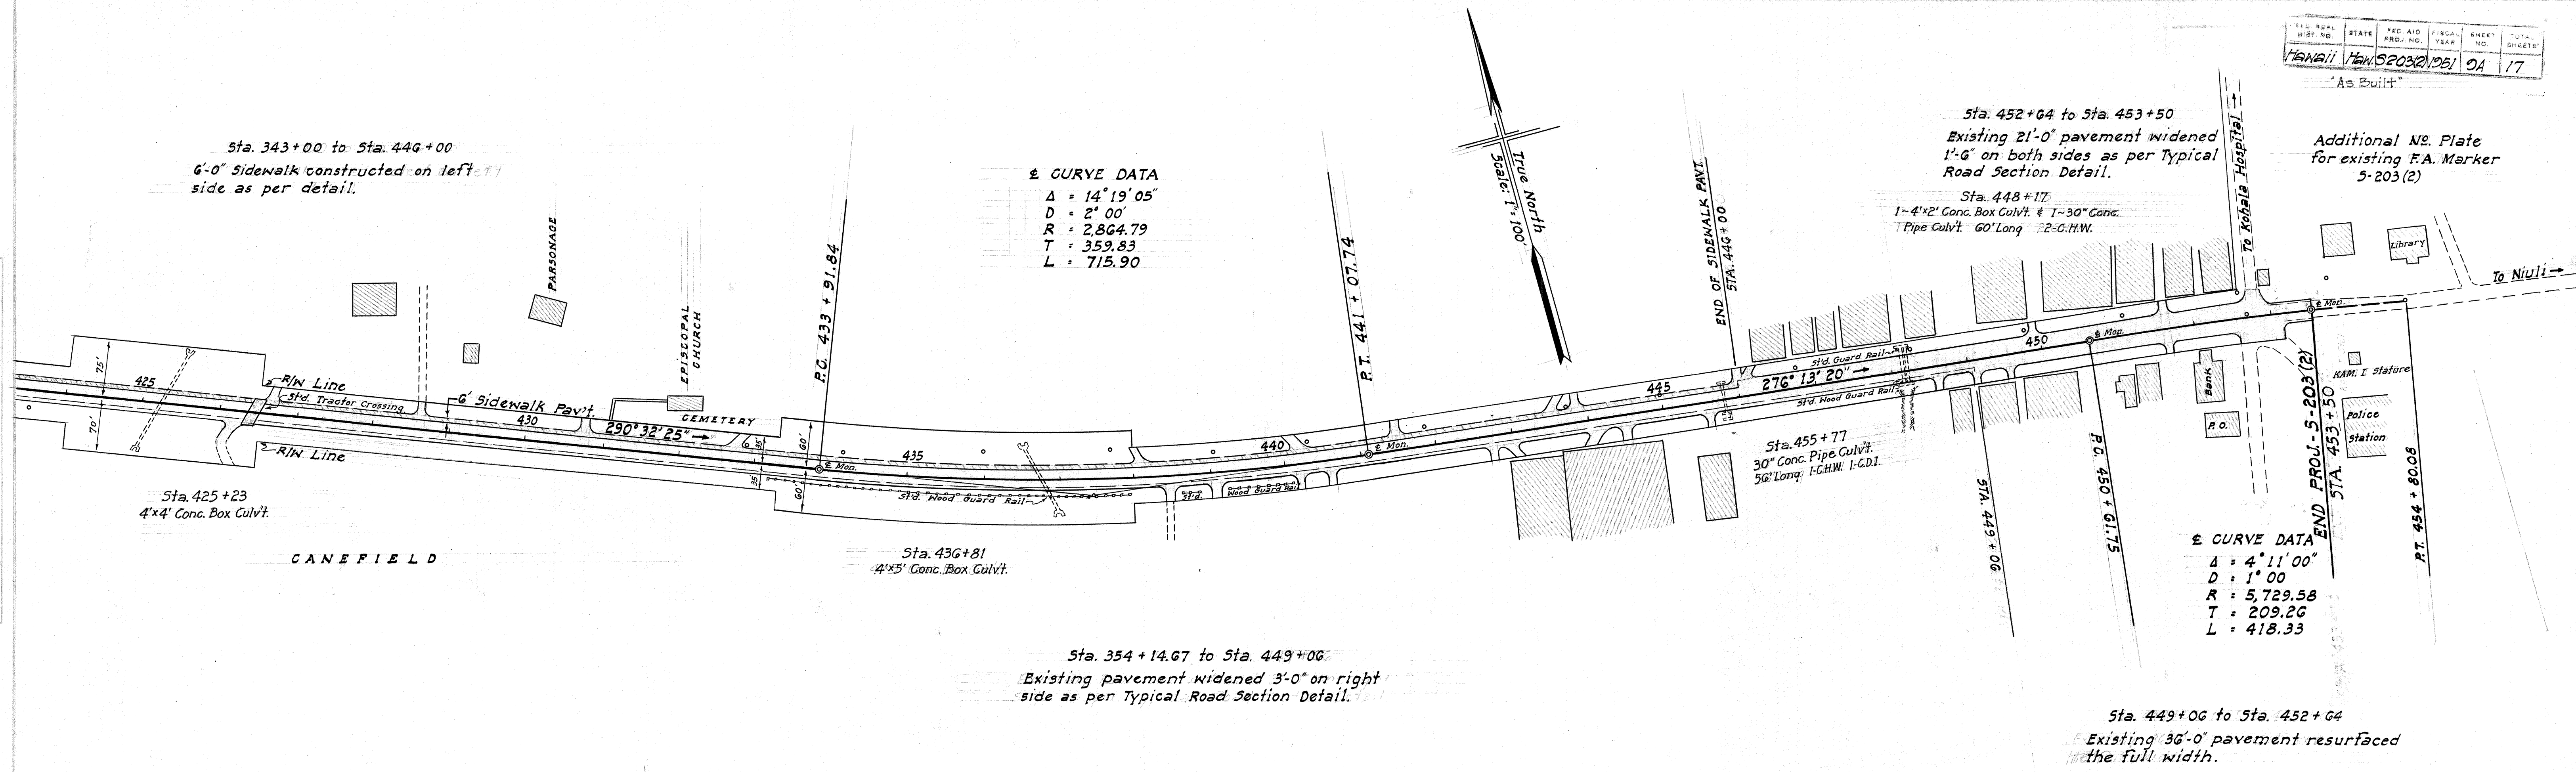


PLATE 1 - PLAN - PROFILE O. P. & F. E. STANDARD
KEUPPEL & SASSER CO. NEW YORK

5495.9A