

INDEX TO DRAWINGS		
SHEET	DESCRIPTION	SHEET
1	TITLE SHEET	1
2	TYPICAL SECTION	2B
3-2	PLAN AND PROFILE	3A-2A
10	MISCELLANEOUS DETAILS	10A
11-17	Cross Sections	11-17

CONVENTIONAL SIGNS	
Centerline	155
Boundary Lines	or,
Fences (Noted)	or,
Existing Roadway	
Culvert	
Bridge	
Railroad	or,
Telephone Pole	o T.P.
Electric Pole	o E.P.
Warning & Regulatory Signs	
Centerline Monument	o

TERRITORY OF HAWAII

TERRITORIAL HIGHWAY DEPARTMENT

HONOLULU T.H.

PLANS FOR

WIDENING AND RESURFACING OF

PORTION OF


MAHUKONA-NIULII ROAD

FEDERAL AID SECONDARY PROJECT NO. S 203 (2)

DISTRICT OF NORTH KOHALA

ISLAND OF HAWAII

SCALES	
PLAN	1 IN. = 100 FT.
PROFILE	HOR. 1 IN. = 100 FT.
	VERT. 1 IN. = 10 FT.

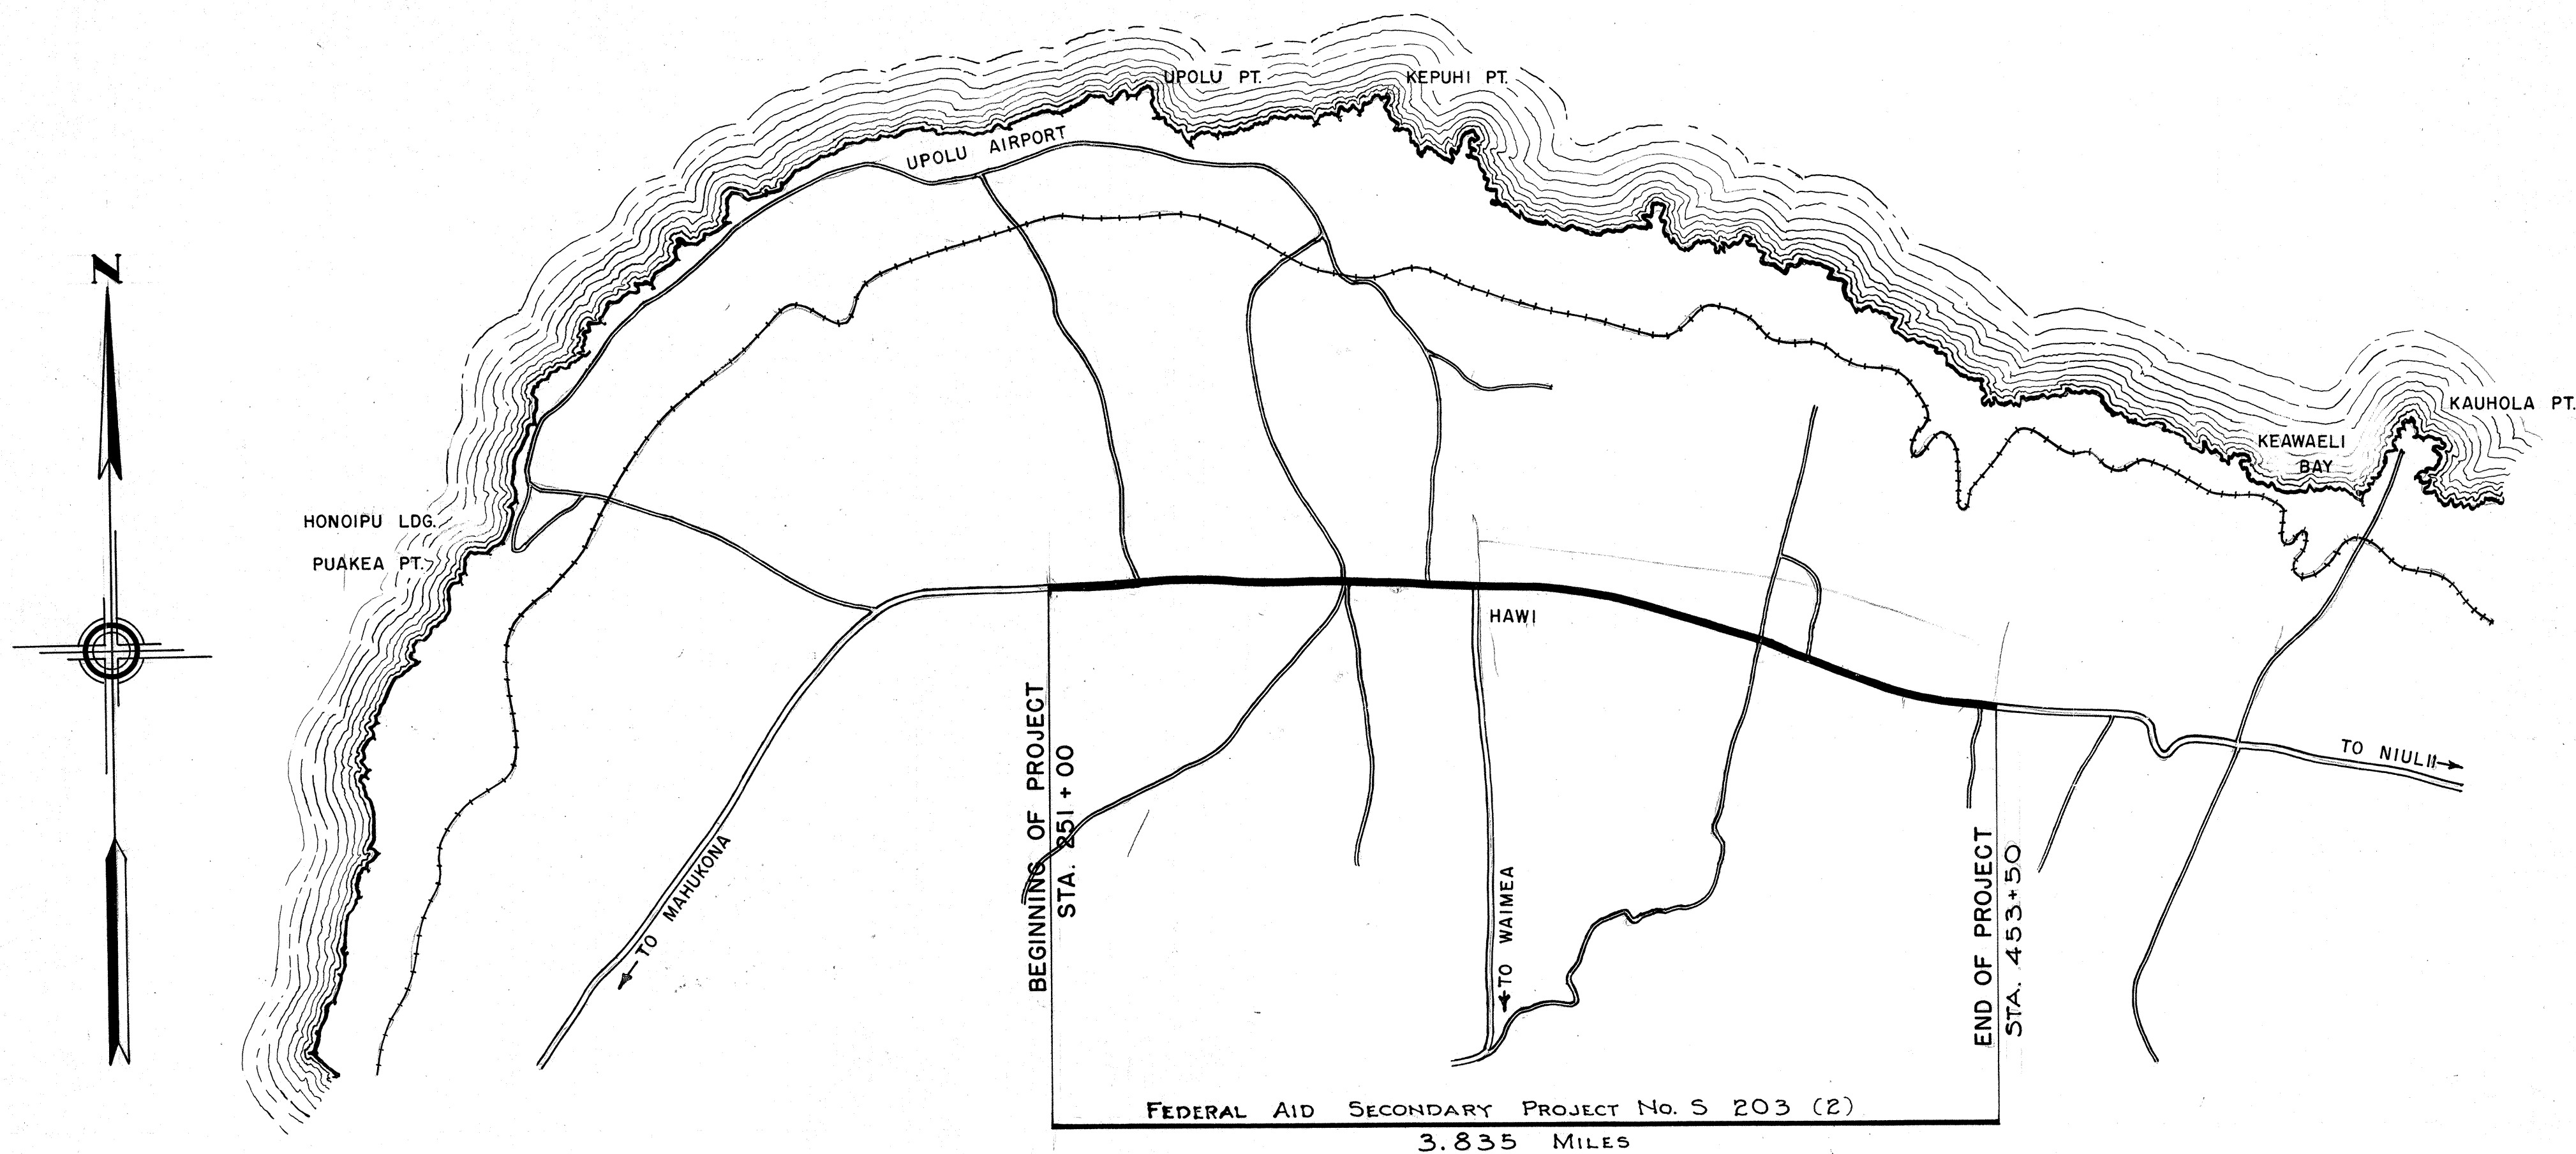


GENERAL LOCATION PLAN

SCALE: 1:31250

GROSS & NET LENGTH OF PROJECT = 3.835 MILES

12-10

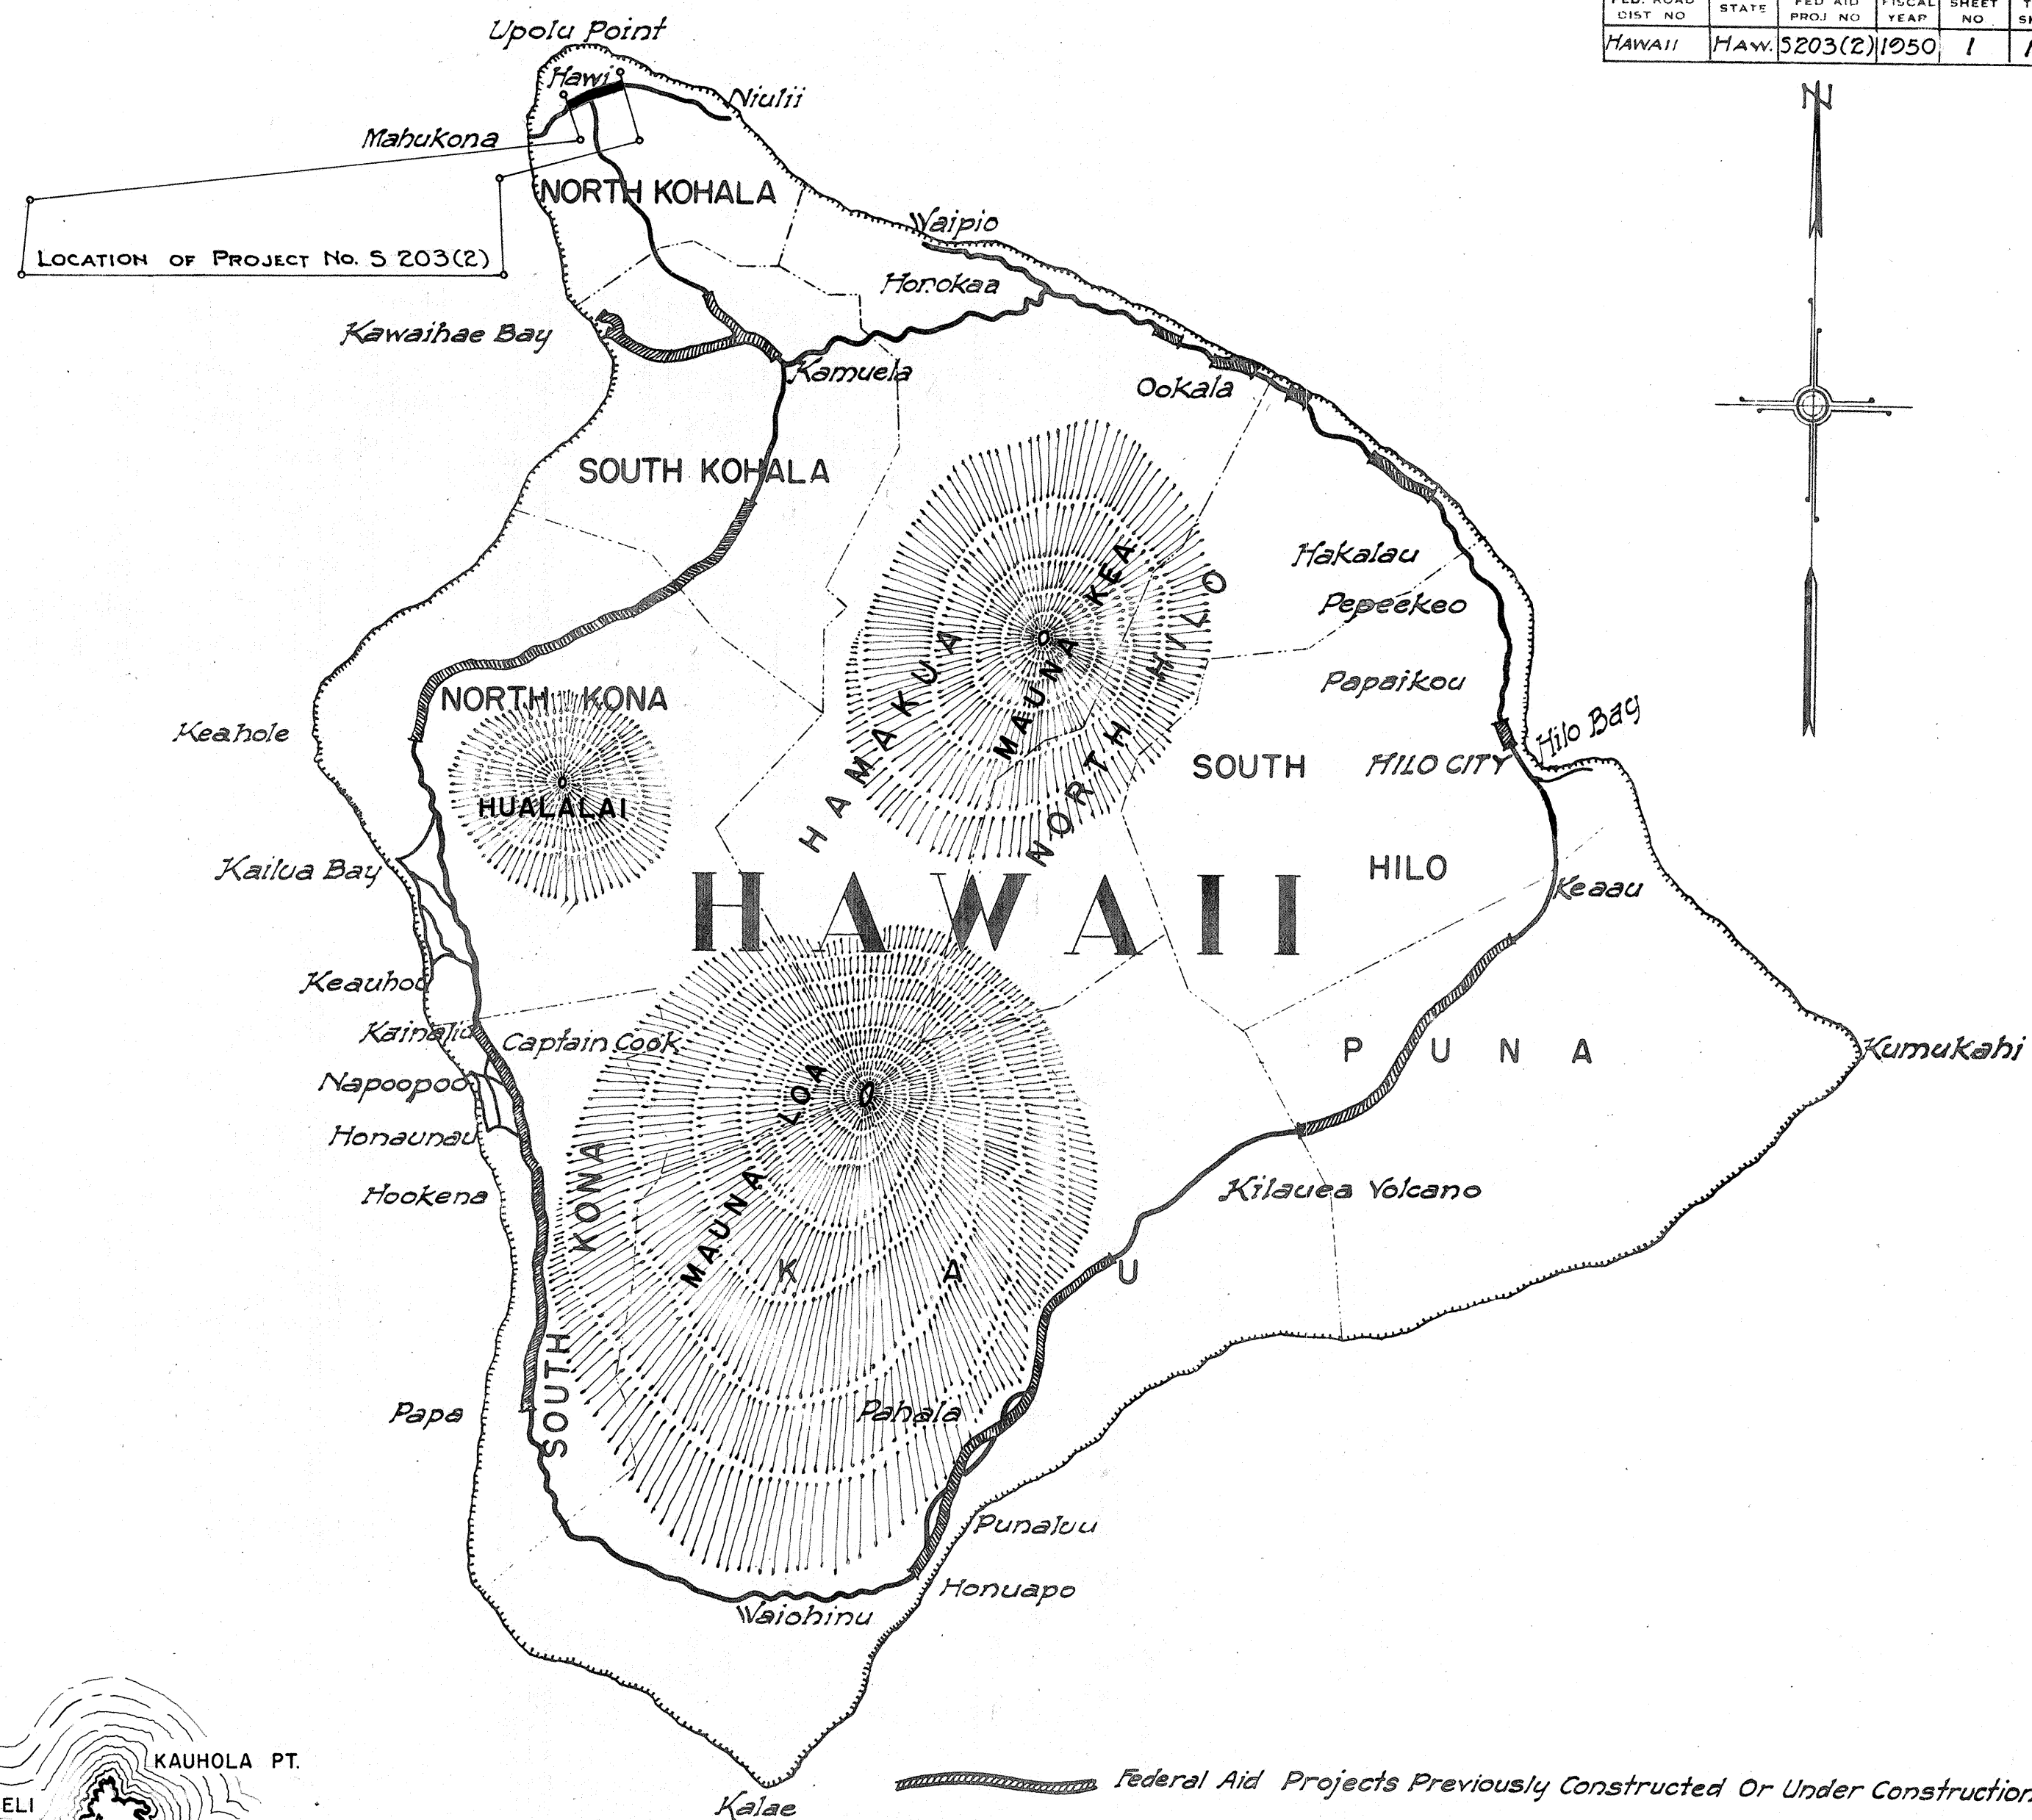

Note:

The completed project is as shown on the revised "As Built" tracings & checked by:

Harry S. Hayakawa

Resident Engineer

Nov. 23, 1951

Date

APPROVED: DATE: 10/13/50

Samuel

TERRITORIAL HIGHWAY ENGINEER

DEPARTMENT OF COMMERCE

BUREAU OF PUBLIC ROADS

RECOMMENDED FOR APPROVAL:

DISTRICT ENGINEER DATE

APPROVED:

DIVISION ENGINEER DATE