
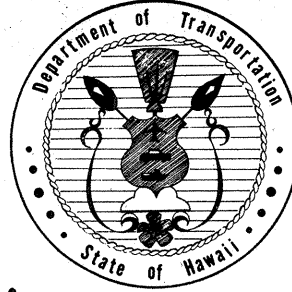


INDEX TO DRAWINGS	
SHEET NO.	DESCRIPTION
1	TITLE SHEET
2	TYPICAL SECTIONS, DETAILS, AND STRIPING PLAN
3	PLAN & PROFILE
4 - 6	PROJECT SITE LABORATORY DETAILS
7 - 8	TRAFFIC SIGN DETAILS
9	PAVEMENT MARKERS DETAILS
10 - 14	METAL GUARDRAIL DETAILS
15 - 23	12' x 10' BOX CULVERT EXTENSION DETAILS
24 - 25	CROSS-SECTIONS

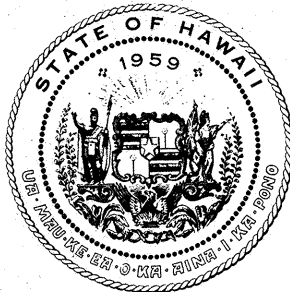

STATE OF HAWAII
DEPARTMENT OF TRANSPORTATION
LAND TRANSPORTATION FACILITIES DIVISION

"AS BUILT"
PLANS FOR
CONSTRUCTION OF



ROUTE 27: KAWAIHAE ROAD
SAFETY IMPROVEMENTS

Vicinity of Spencer Park

FED. AID PROJ. NO. HHS-027-1(I)

DISTRICT OF SOUTH KOHALA
ISLAND OF HAWAII

FED. ROAD DIST. NO.	STATE	FED. AID PROJ. NO.	FISCAL YEAR	SHEET NO.	TOTAL SHEETS
HAWAII	HAW.	HHS-027-1(I)	1978	1	25

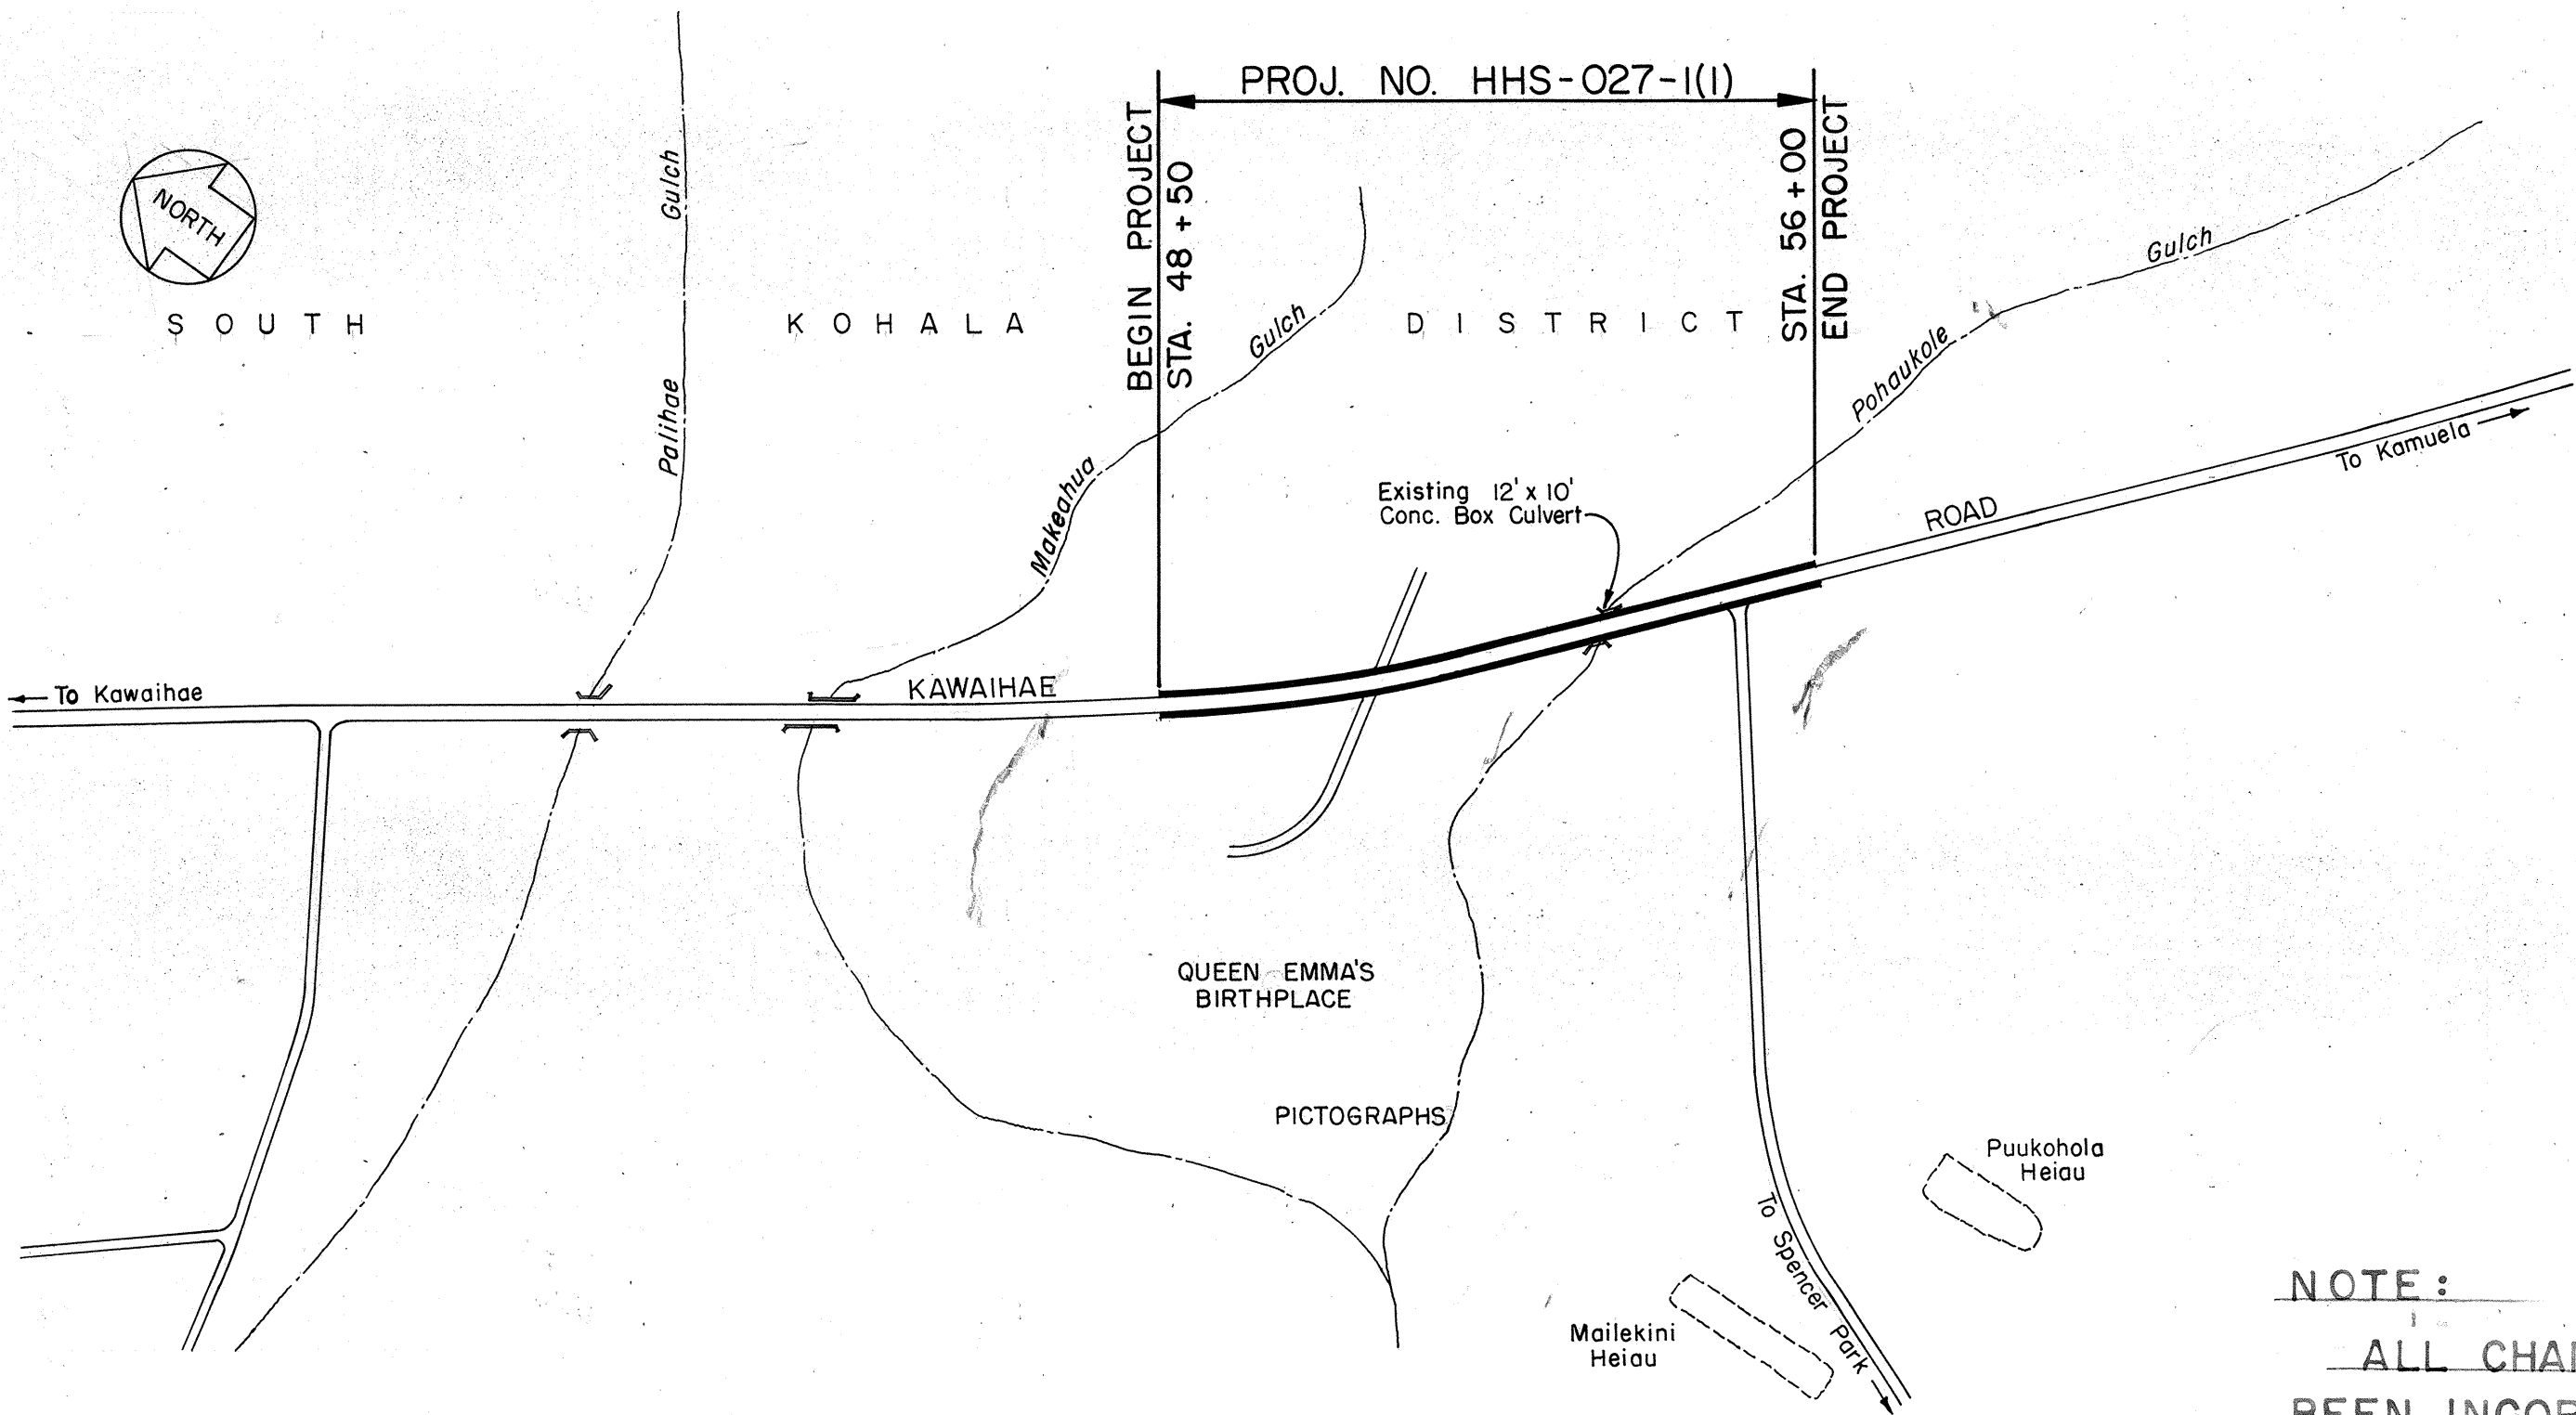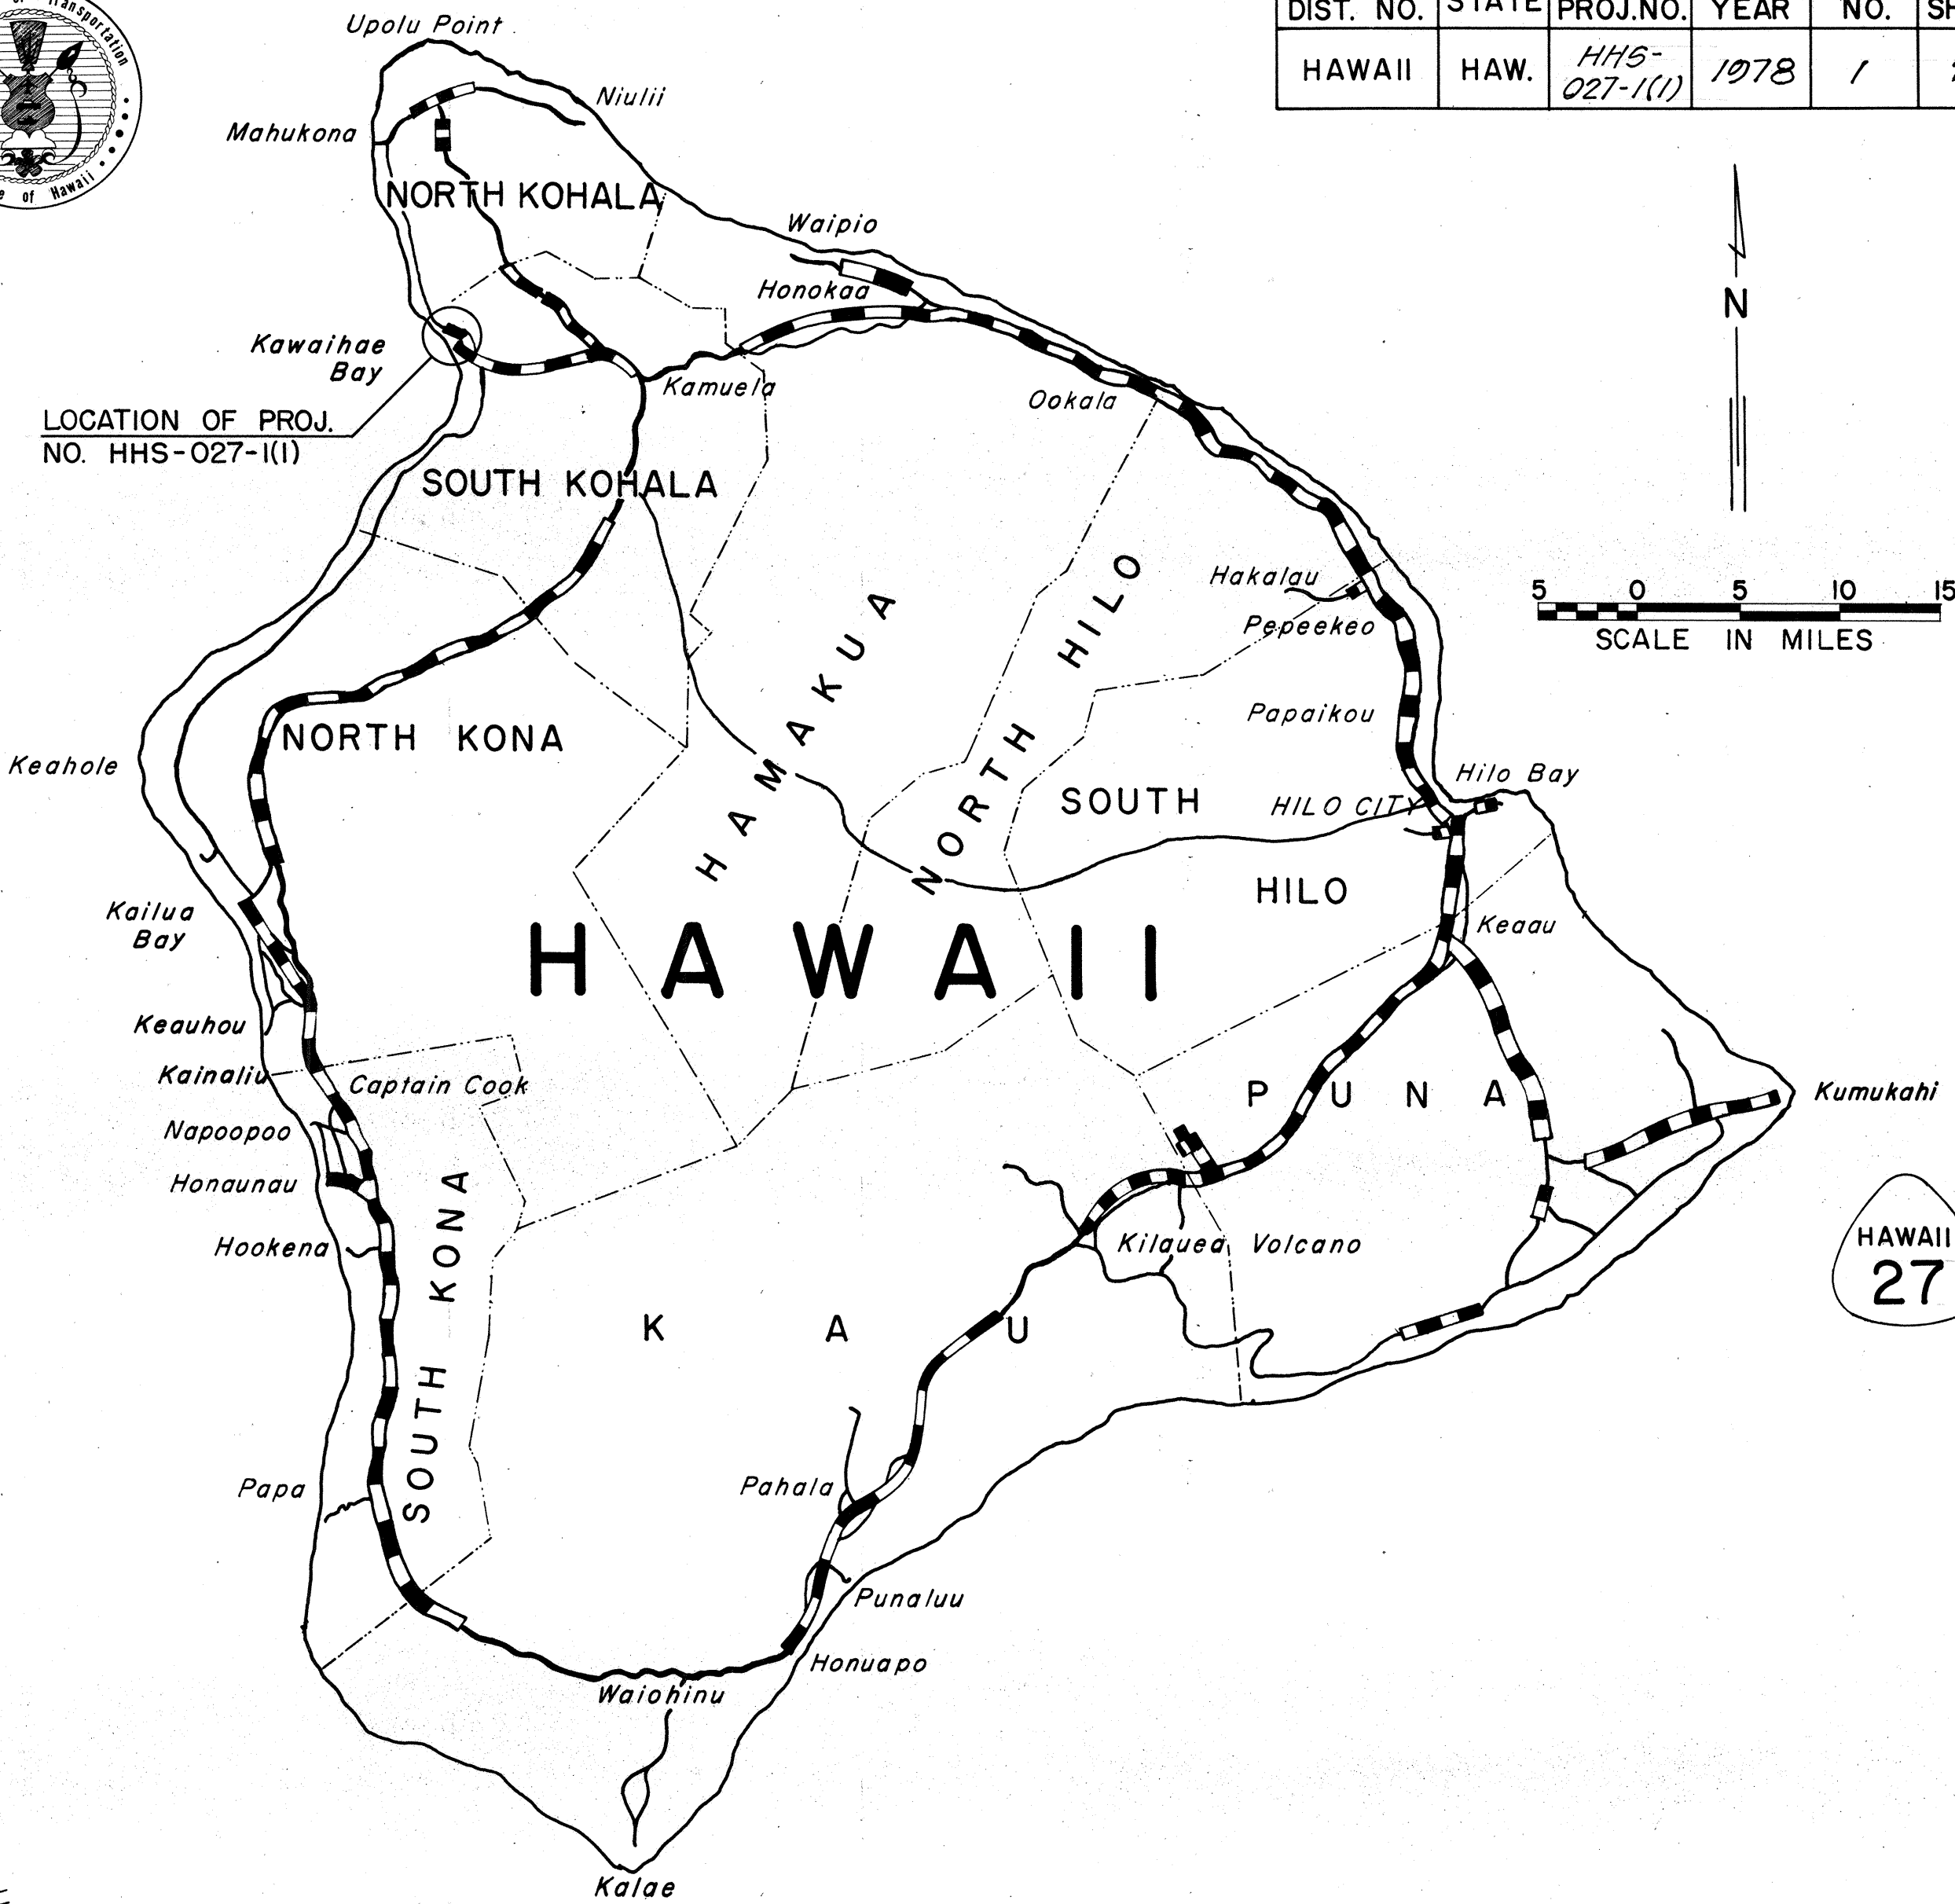

DESIGN CLASSIFICATION

CURRENT ADT (1978)	2,100
DESIGN ADT (1998)	4,300
DHV	440
T24	11%

NOTE:

ALL CHANGES MADE DURING CONSTRUCTION HAVE BEEN INCORPORATED ON THESE PLANS IN RED EXCEPT CHANGES IN THE ORIGINAL THEORETICAL QUANTITIES.

Conrad Watson
PROJECT ENGINEER

1-5-79
DATE

GROSS & NET LENGTH OF PROJECT.....0.142 Mi.

DEPARTMENT OF TRANSPORTATION FEDERAL HIGHWAY ADMINISTRATION	
APPROVED:	5-22-78
<i>[Signature]</i> DIVISION ADMINISTRATOR	DATE

DEPARTMENT OF TRANSPORTATION STATE OF HAWAII	
APPROVED:	2-15-78
<i>R. Higashimura</i> DIR. OF TRANSPORTATION	DATE

HAWAII DISTRICT DESIGNED BY R. MIKAMI P.S.E. BY 548-7534 FEB. 15, 1978 DATE PHONE