

INDEX TO DRAWINGS	
SHEET	DESCRIPTION
1	Title Sheet
2	Typical Sections
3-6	Plan and Profile
7	Location of Coral Stockpile Plan
8-14	Drainage Details

STATE OF HAWAII

DEPARTMENT OF TRANSPORTATION

HIGHWAYS DIVISION

"AS BUILT" PLANS OF

KAWAIHAE—MAHUKONA ROAD

SECTION II-B

HAWAII PROJECT No. A-270-01-62

DISTRICT OF NORTH KOHALA

ISLAND OF HAWAII



PLAN

PROFILE

1 INCH = 100 FT.

1 INCH = 100 FT.

1 INCH = 10 FT.

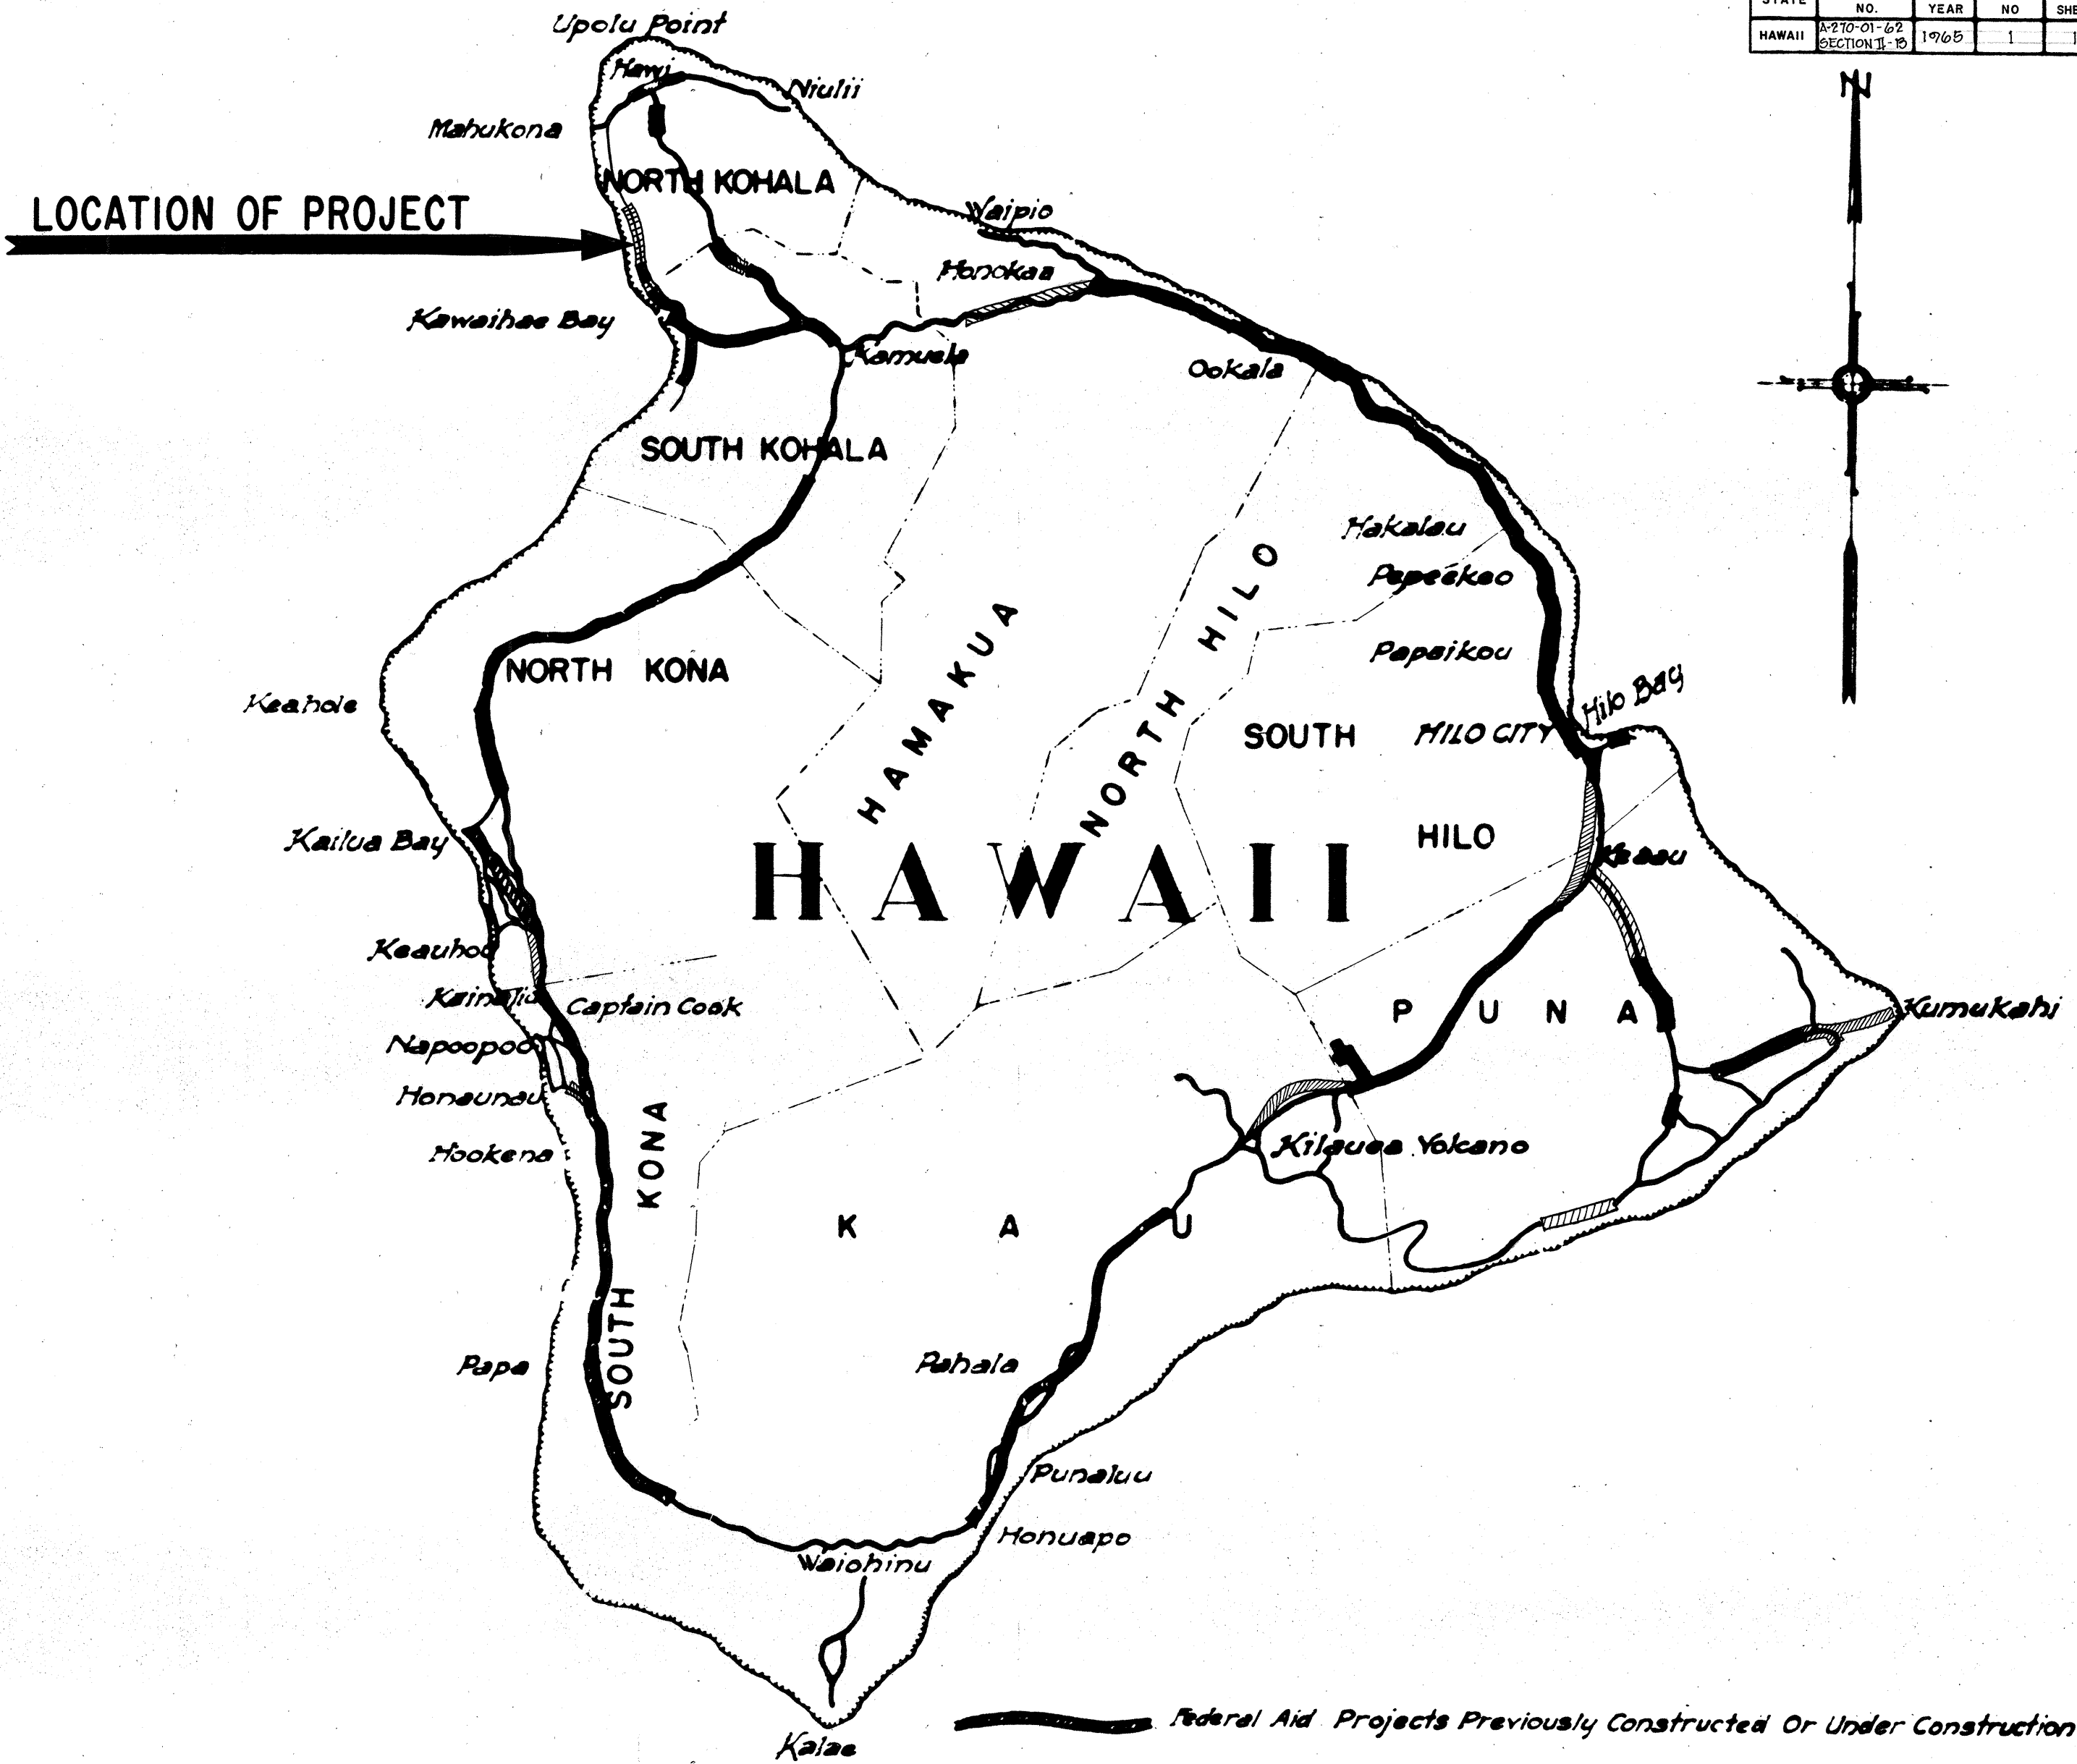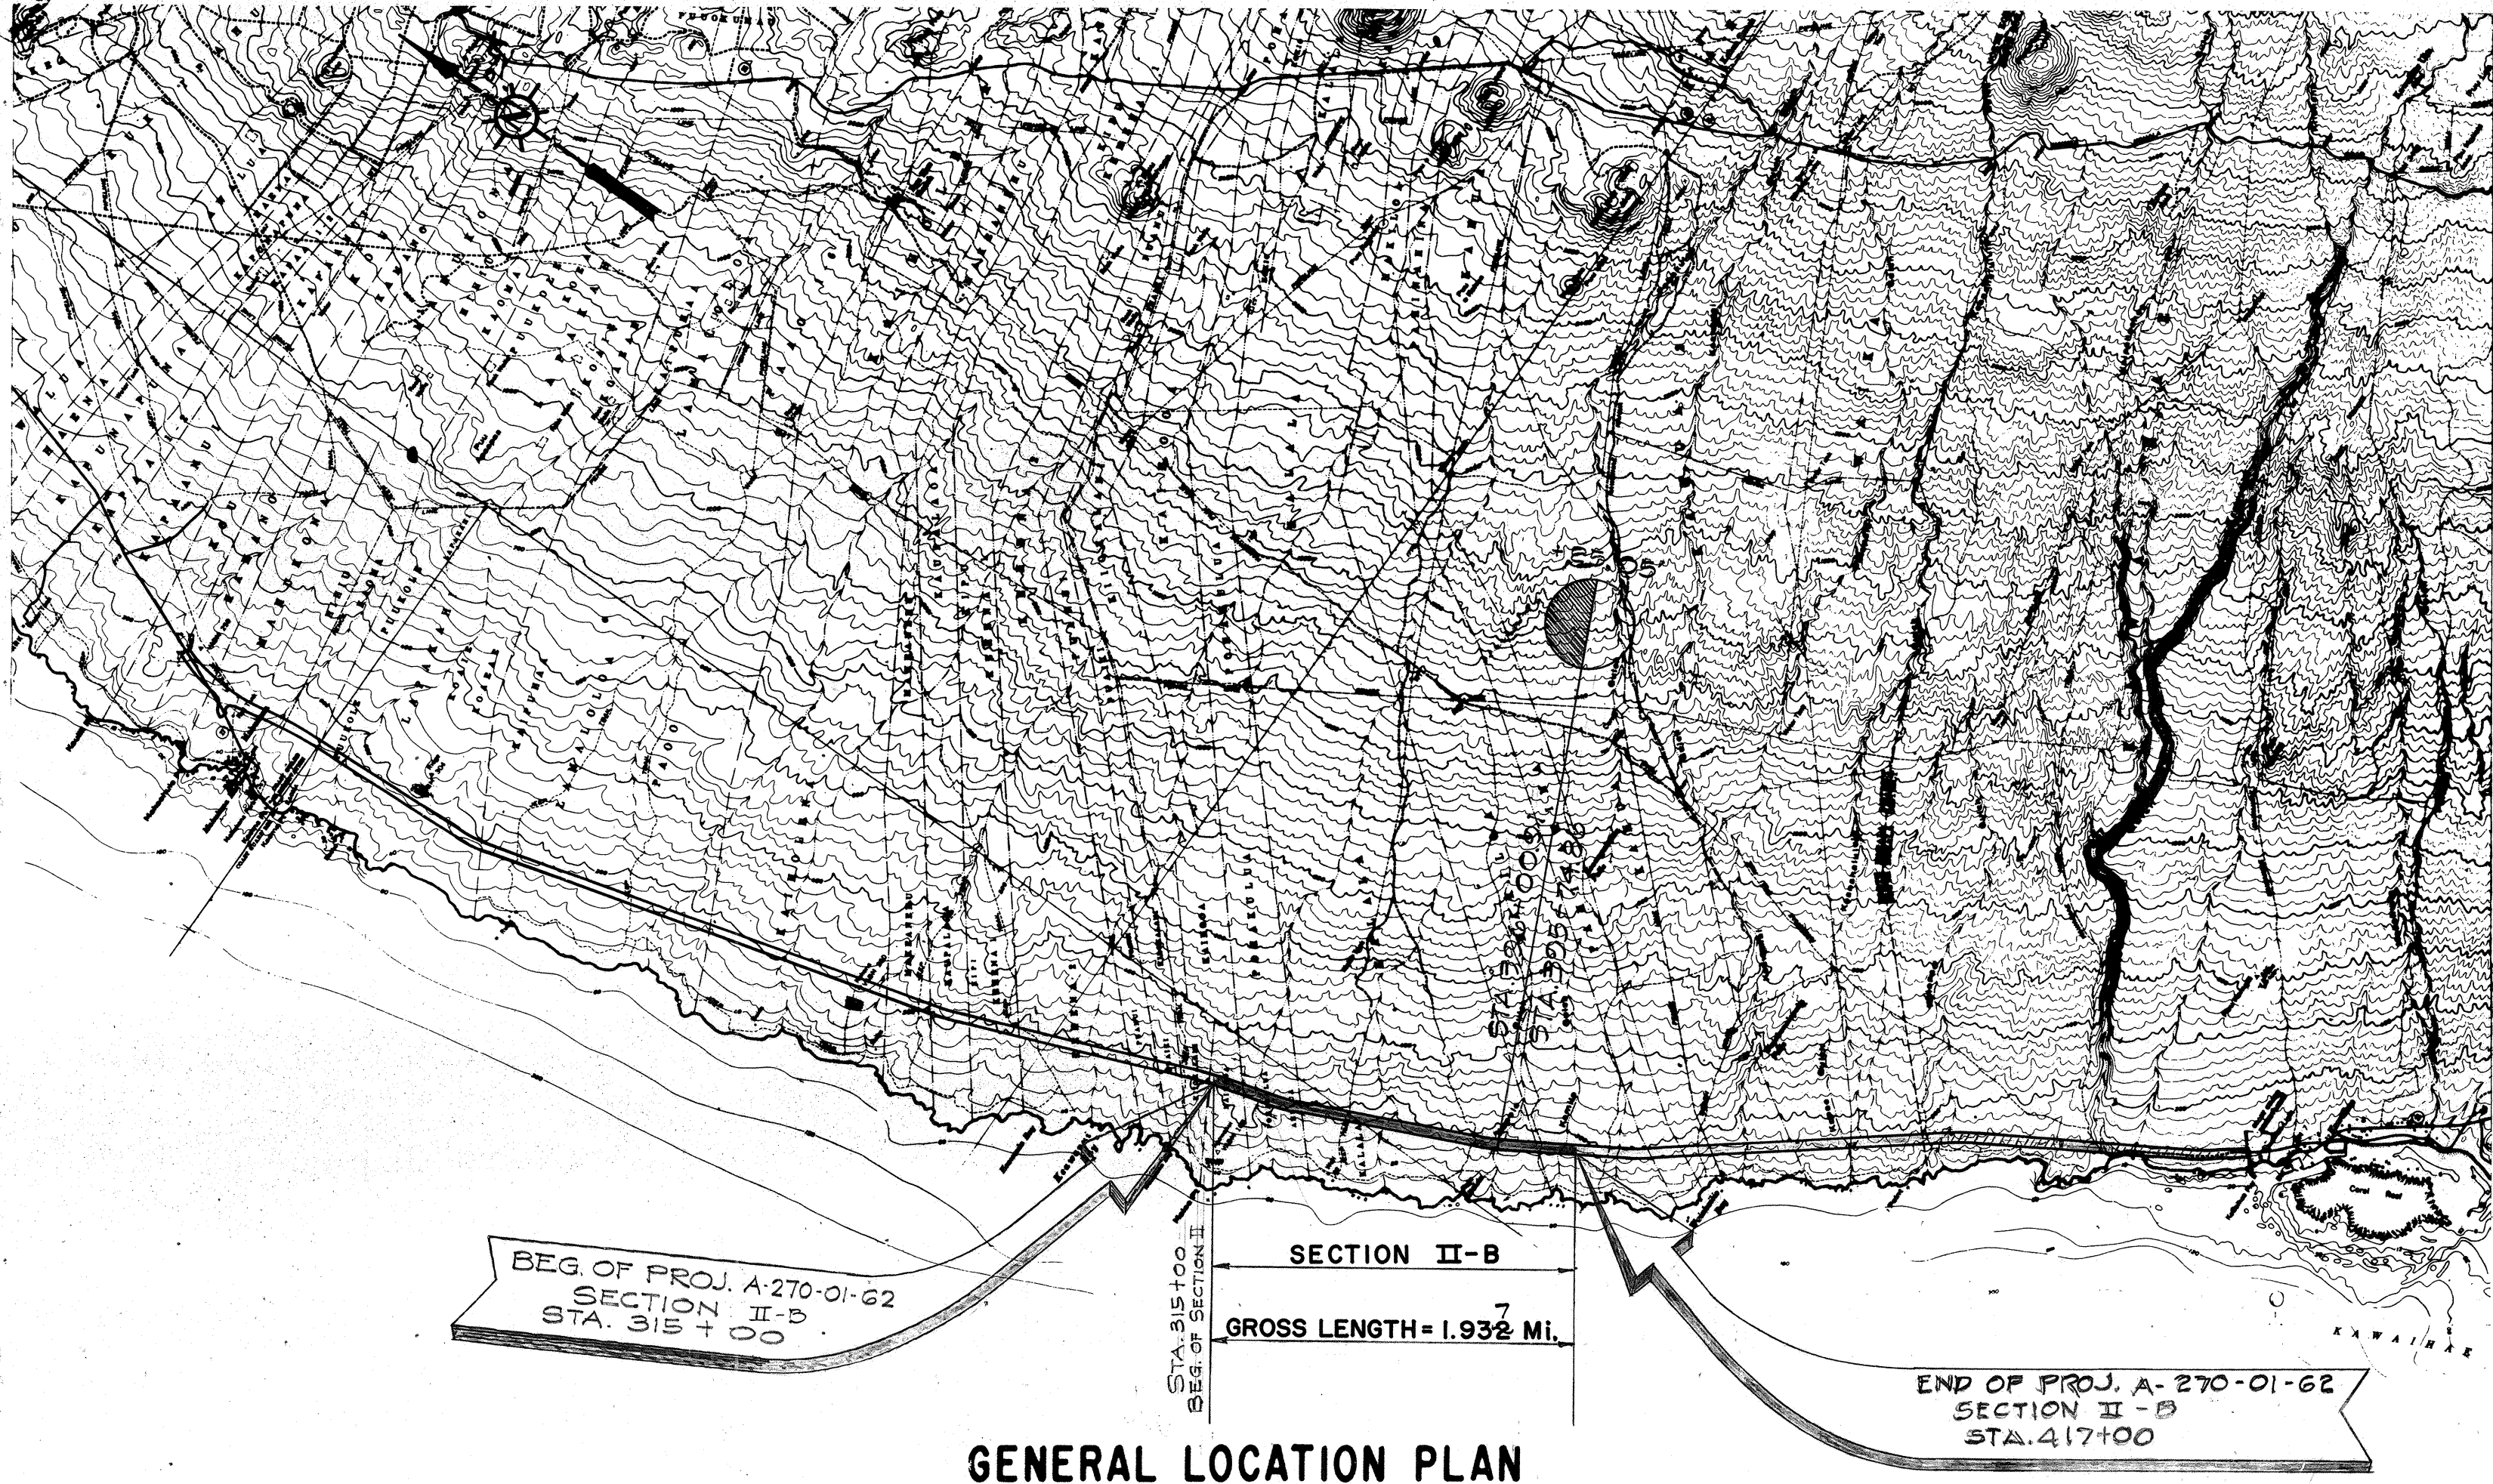

DESIGN CLASSIFICATION	
ADT (1981)	350
DHV	12%
D	60/40
T	10%
V	60 MPH

NOTE:

ALL CHANGES MADE DURING CONSTRUCTION HAVE BEEN NOTED IN RED ON THESE TRACINGS AND CHECKED BY:

Jango Sugimoto

PROJECT ENGINEER

June 7, 1967

DATE

GROSS LENGTH OF PROJECT: 1.932 Miles

APPROVED:

DATE: 10 Aug 65

Jango Sugimoto

DIRECTOR OF TRANSPORTATION