

INDEX TO DRAWINGS	
SHEET	DESCRIPTION
1	TITLE SHEET
2	TYPICAL SECTIONS
3-15	PLAN & PROFILE
16	LOCATION OF CORAL STOCKPILE
17	STANDARD DETAILS
18-35	DRAINAGE DETAILS

STATE OF HAWAII

DEPARTMENT OF TRANSPORTATION

HIGHWAYS DIVISION

"AS BUILT"

PLANS OF

KAWAIHAE—MAHUKONA ROAD

SECTION III & IIIA

HAWAII PROJECT No. A-270-01-62

DISTRICT OF NORTH KOHALA


ISLAND OF HAWAII

SCALES



PLAN-----1 INCH = 100 FT.

PROFILE-----HOR. 1 INCH = 100 FT.

VER. 1 INCH = 10 FT.

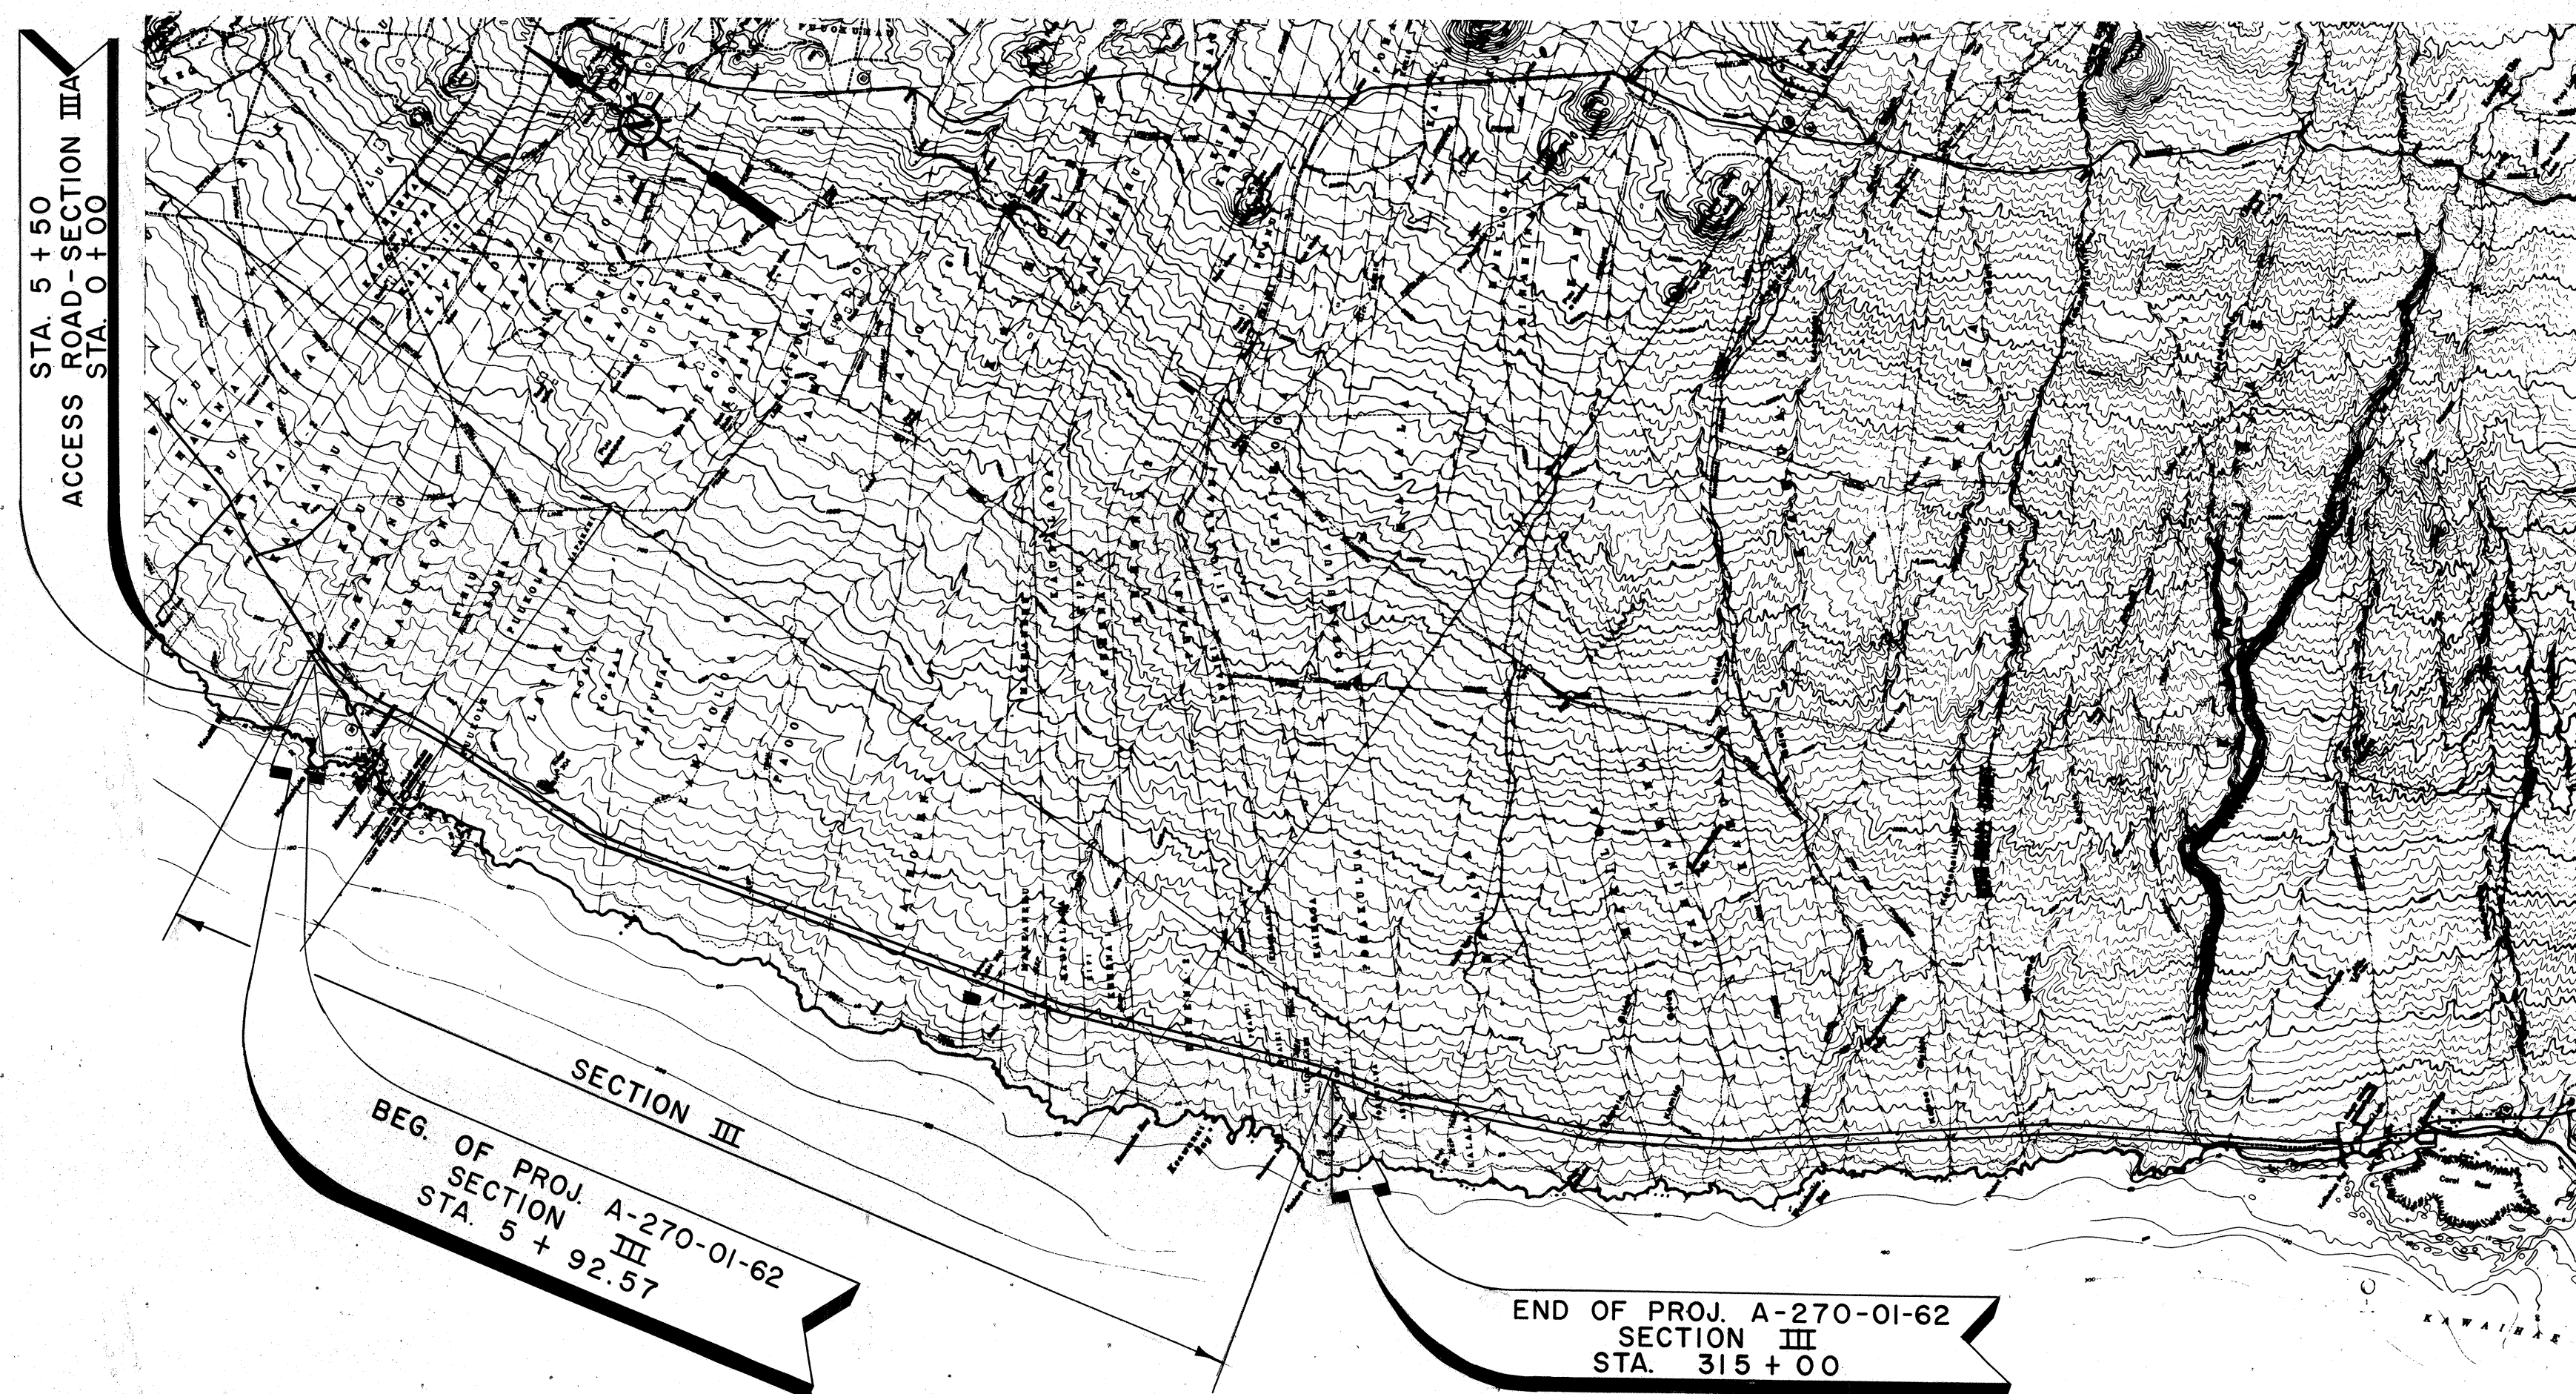

GENERAL LOCATION PLAN

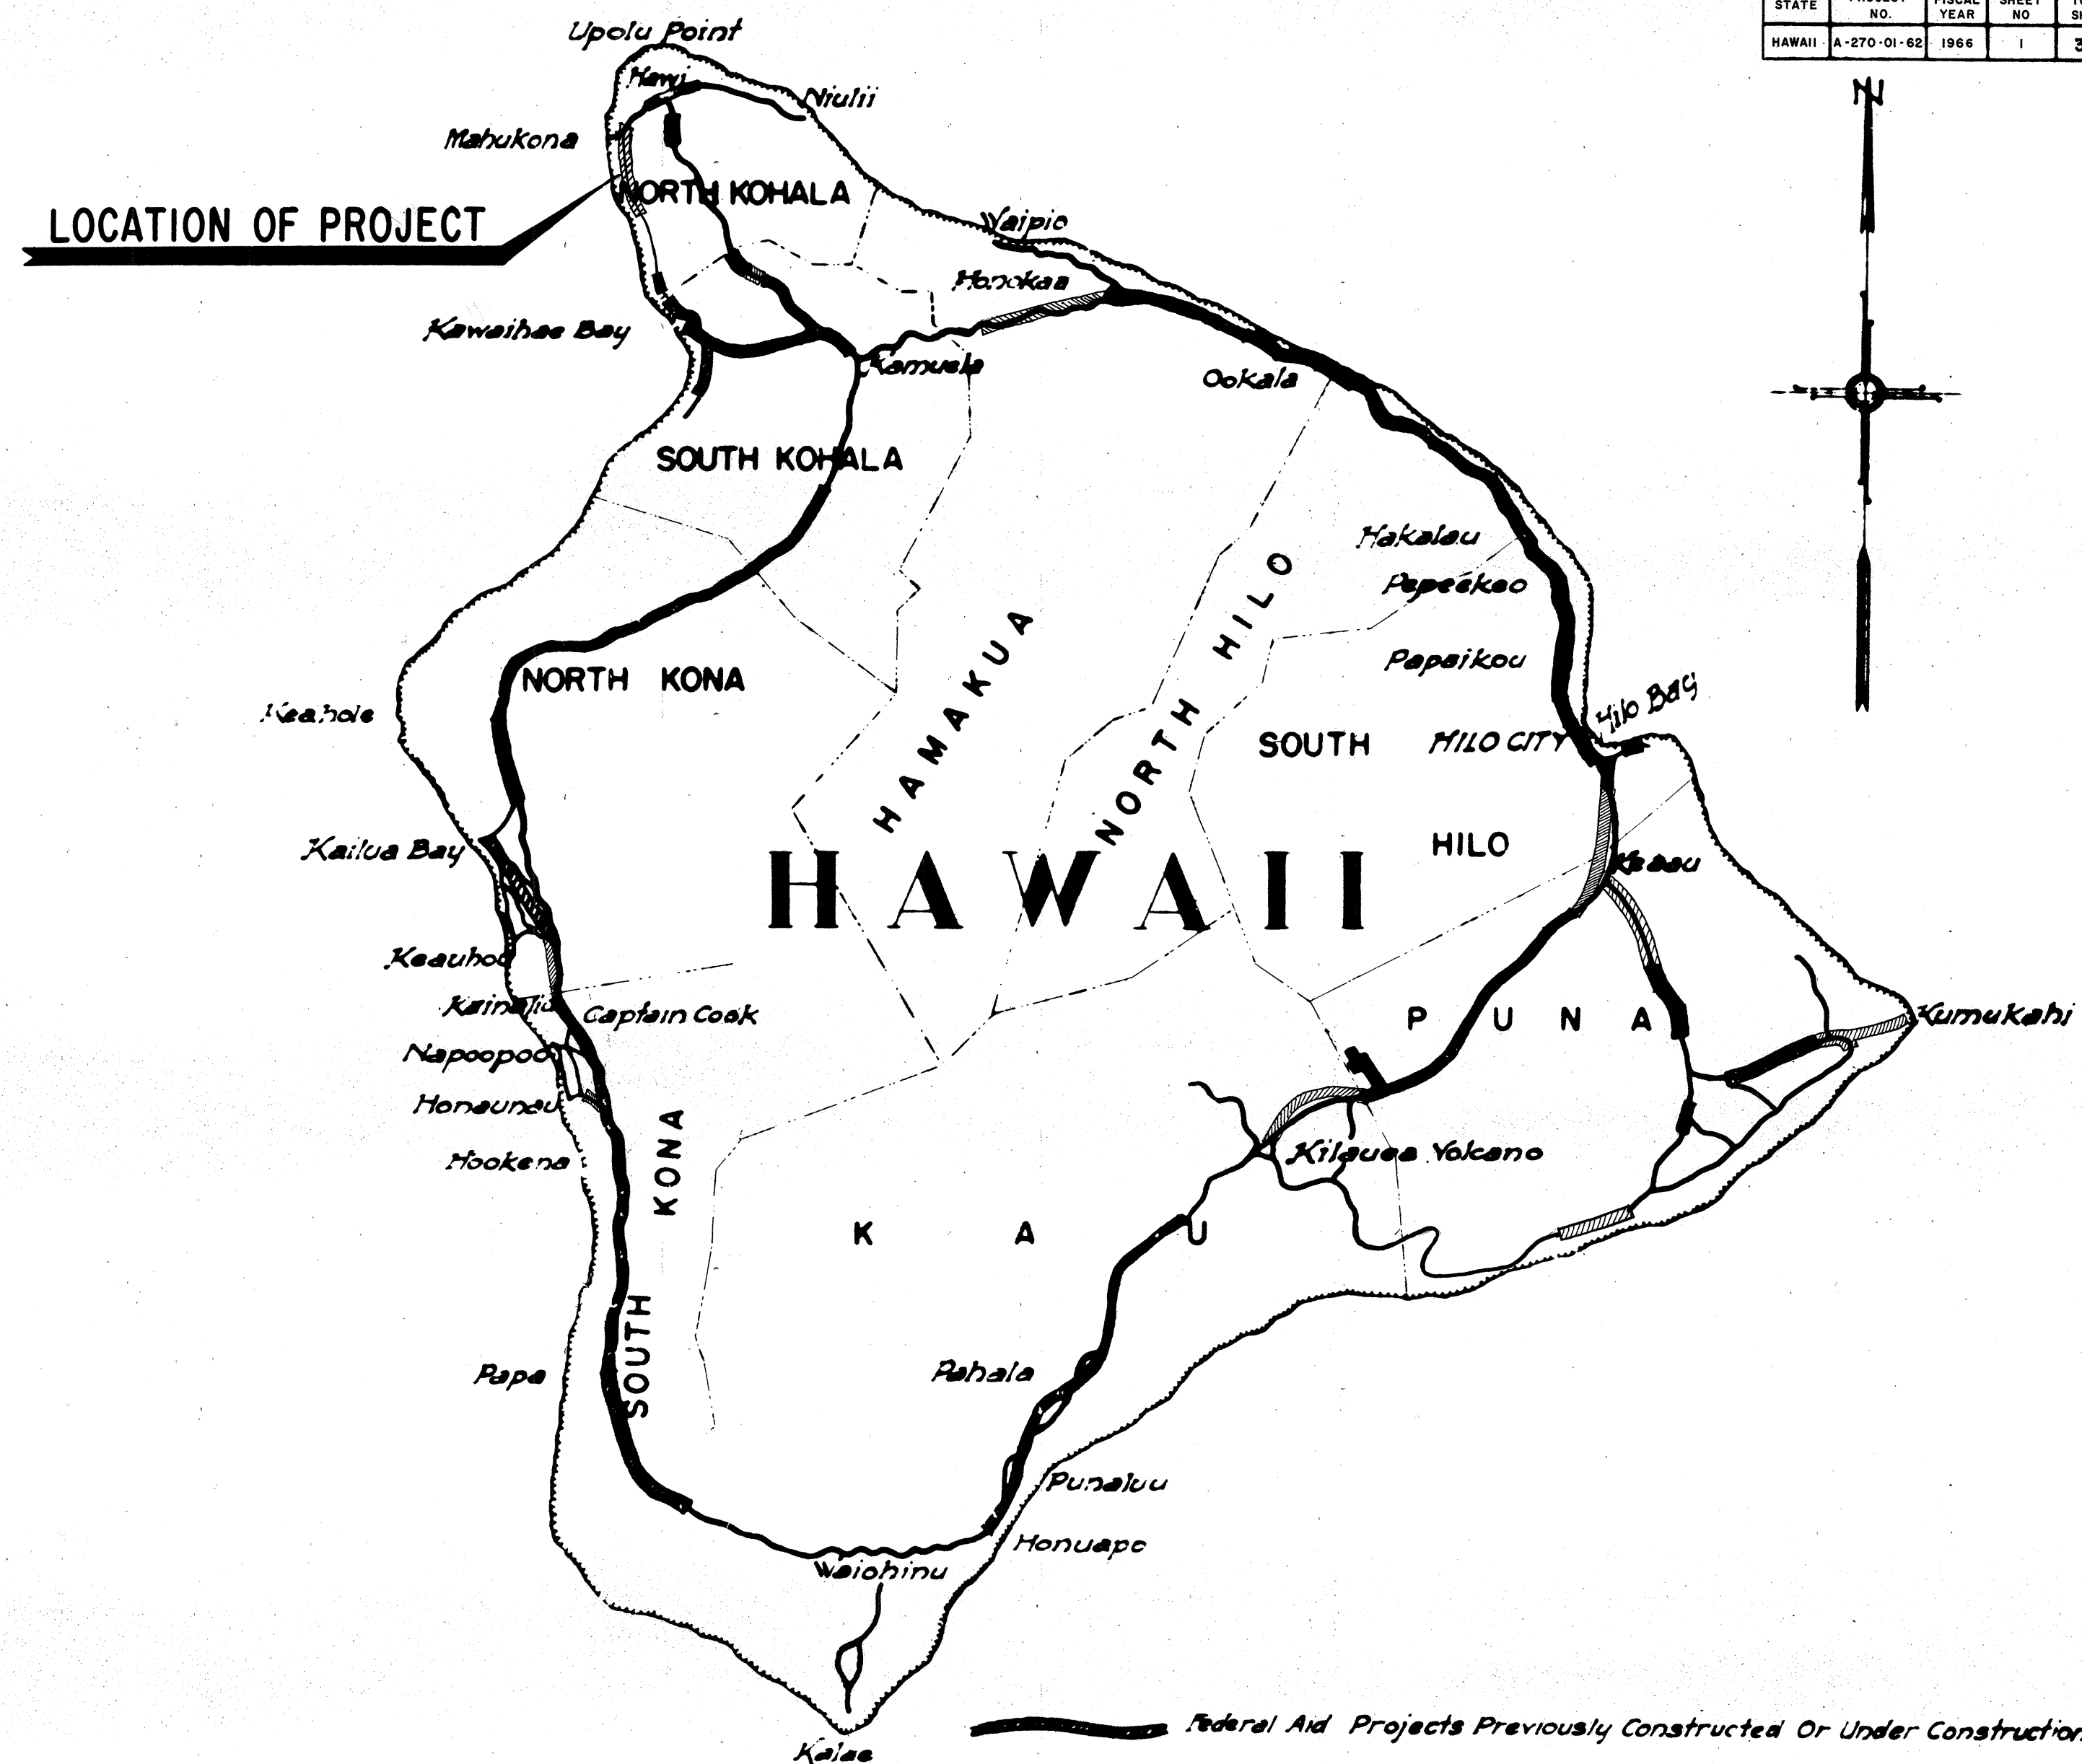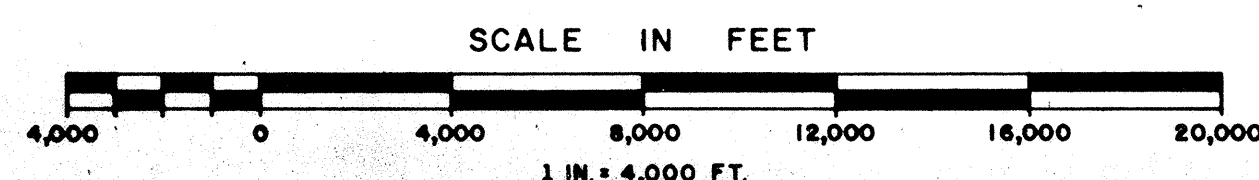

NOTE:

ALL CHANGES MADE DURING CONSTRUCTION HAVE BEEN NOTED IN RED ON THESE SHEETS AND CHECKED BY:

DESIGN CLASSIFICATION

ADT (1981)	350
DHV	12%
D	60/40
T	10%
V	60 MPH

Torgo Fujimoto

PROJECT ENGINEER

12/9-17-80

DATE

GROSS AND NET LENGTH OF PROJECT:

SECTION III 5.854 Miles

SECTION IIIA 0.102 Mile

APPROVED: DATE: 7-22-66

for DIRECTOR OF TRANSPORTATION