


NOTE: Guard Rail, or Reflector Markers will not be installed under this Contract. However, where guard rail or reflector markers are required, as shown on the plans, embankment shall be widened two feet.

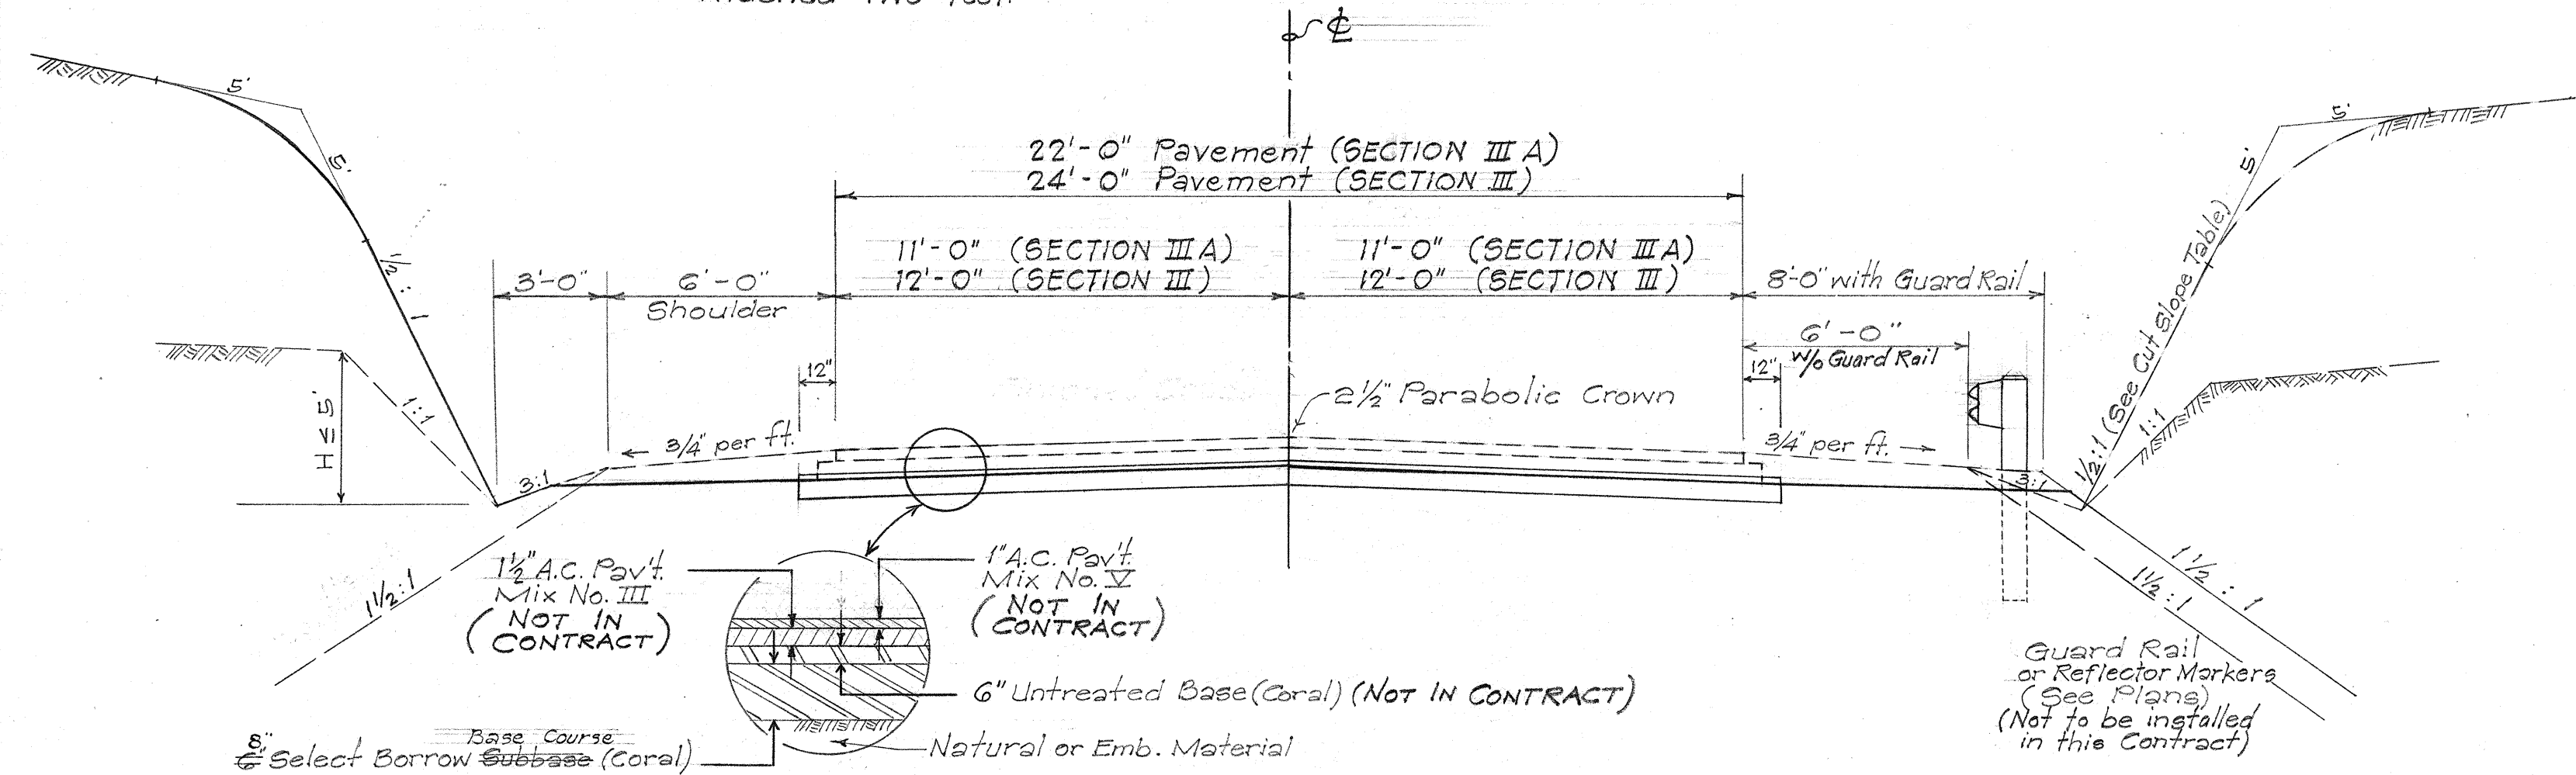


TYPICAL ROAD SECTION ON TANGENT

Scale: 1/4" = 1'-0"

HEIGHT OF CUT	SLOPE
0'-5'	1:1
5'-Over	1/2:1

NOTE:
Top of cut slope shall be rounded where ordered by the Engineer.
Rounding the top of the cut slope will be paid for as Roadway Excavation for the quantities involved and no additional compensation will be allowed for such work.

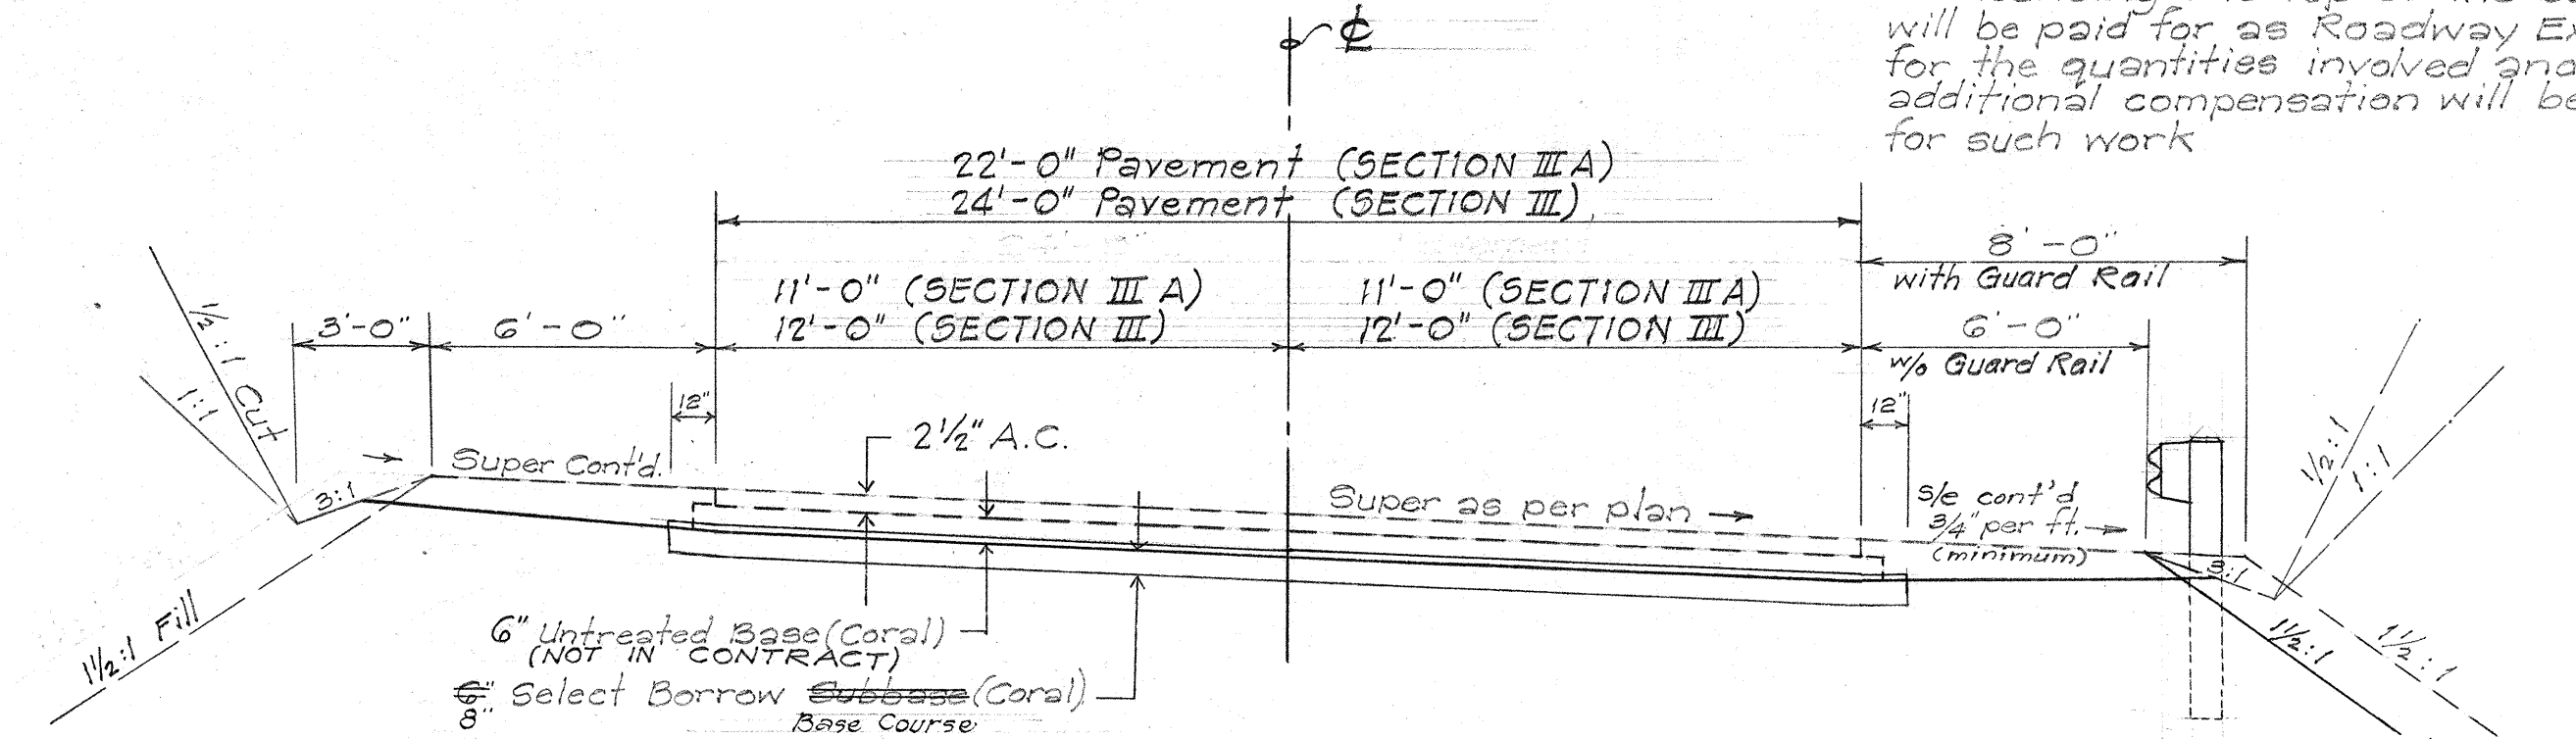

TYPICAL ROAD SECTION ON CURVE

Scale: 1/4" = 1'-0"

SCHEDULE FOR 8-FT. SHOULDER SECTIONS

STATION	LEFT	RIGHT
32+00		Begin
to		
36+00		End
152+00		Begin
to		
153+00		End
156+00		Begin
to		
157+50		End
168+50		Begin
to		
169+50		End
191+50		Begin
to		
192+50	Begin	
to		
193+00	End	End
233+50		Begin
to		
236+50		End
247+50		Begin
to		
249+50		End
261+00	Begin	Begin
to		
262+00	End	End
285+50		Begin
to		
287+50		End
294+50		Begin
to		
295+50		End
312+50		Begin
to		
313+00	Begin	
to		
314+00	End	
315+00		End

DATE	
DESIGNED BY	
CHECKED BY	
NO.	

STATE OF HAWAII
DEPARTMENT OF TRANSPORTATION
HIGHWAYS DIVISION

TYPICAL SECTIONS

SCHEDULE FOR 8-FT. SHOULDER SECTIONS

KAWAIIHAE - MAHUKONA ROAD
PROJ. A-270-01-62
SECTION III

Scale: As noted

SHEET No. 1 OF 1 SHEETS