

INDEX TO DRAWINGS	
SHEET	DESCRIPTION
1	TITLE SHEET
2	TYPICAL SECTIONS
3-24	PLAN & PROFILE
25-31	DESTINATION SIGNS & STANDARD DETAILS
32	LOCATION OF CORAL STOCKPILE PLAN

STATE OF HAWAII

DEPARTMENT OF TRANSPORTATION

HIGHWAYS DIVISION

AS BUILT

PLANS FOR PAVING OF

KAWAIHAE – MAHUKONA ROAD

HAWAII PROJECT No. A-270-01-62



DISTRICTS OF NORTH KOHALA & SOUTH KOHALA

ISLAND OF HAWAII

PLAN-----1 INCH = 100 FT.

PROFILE-----HOR. 1 INCH = 100 FT.

VER. 1 INCH = 10 FT.

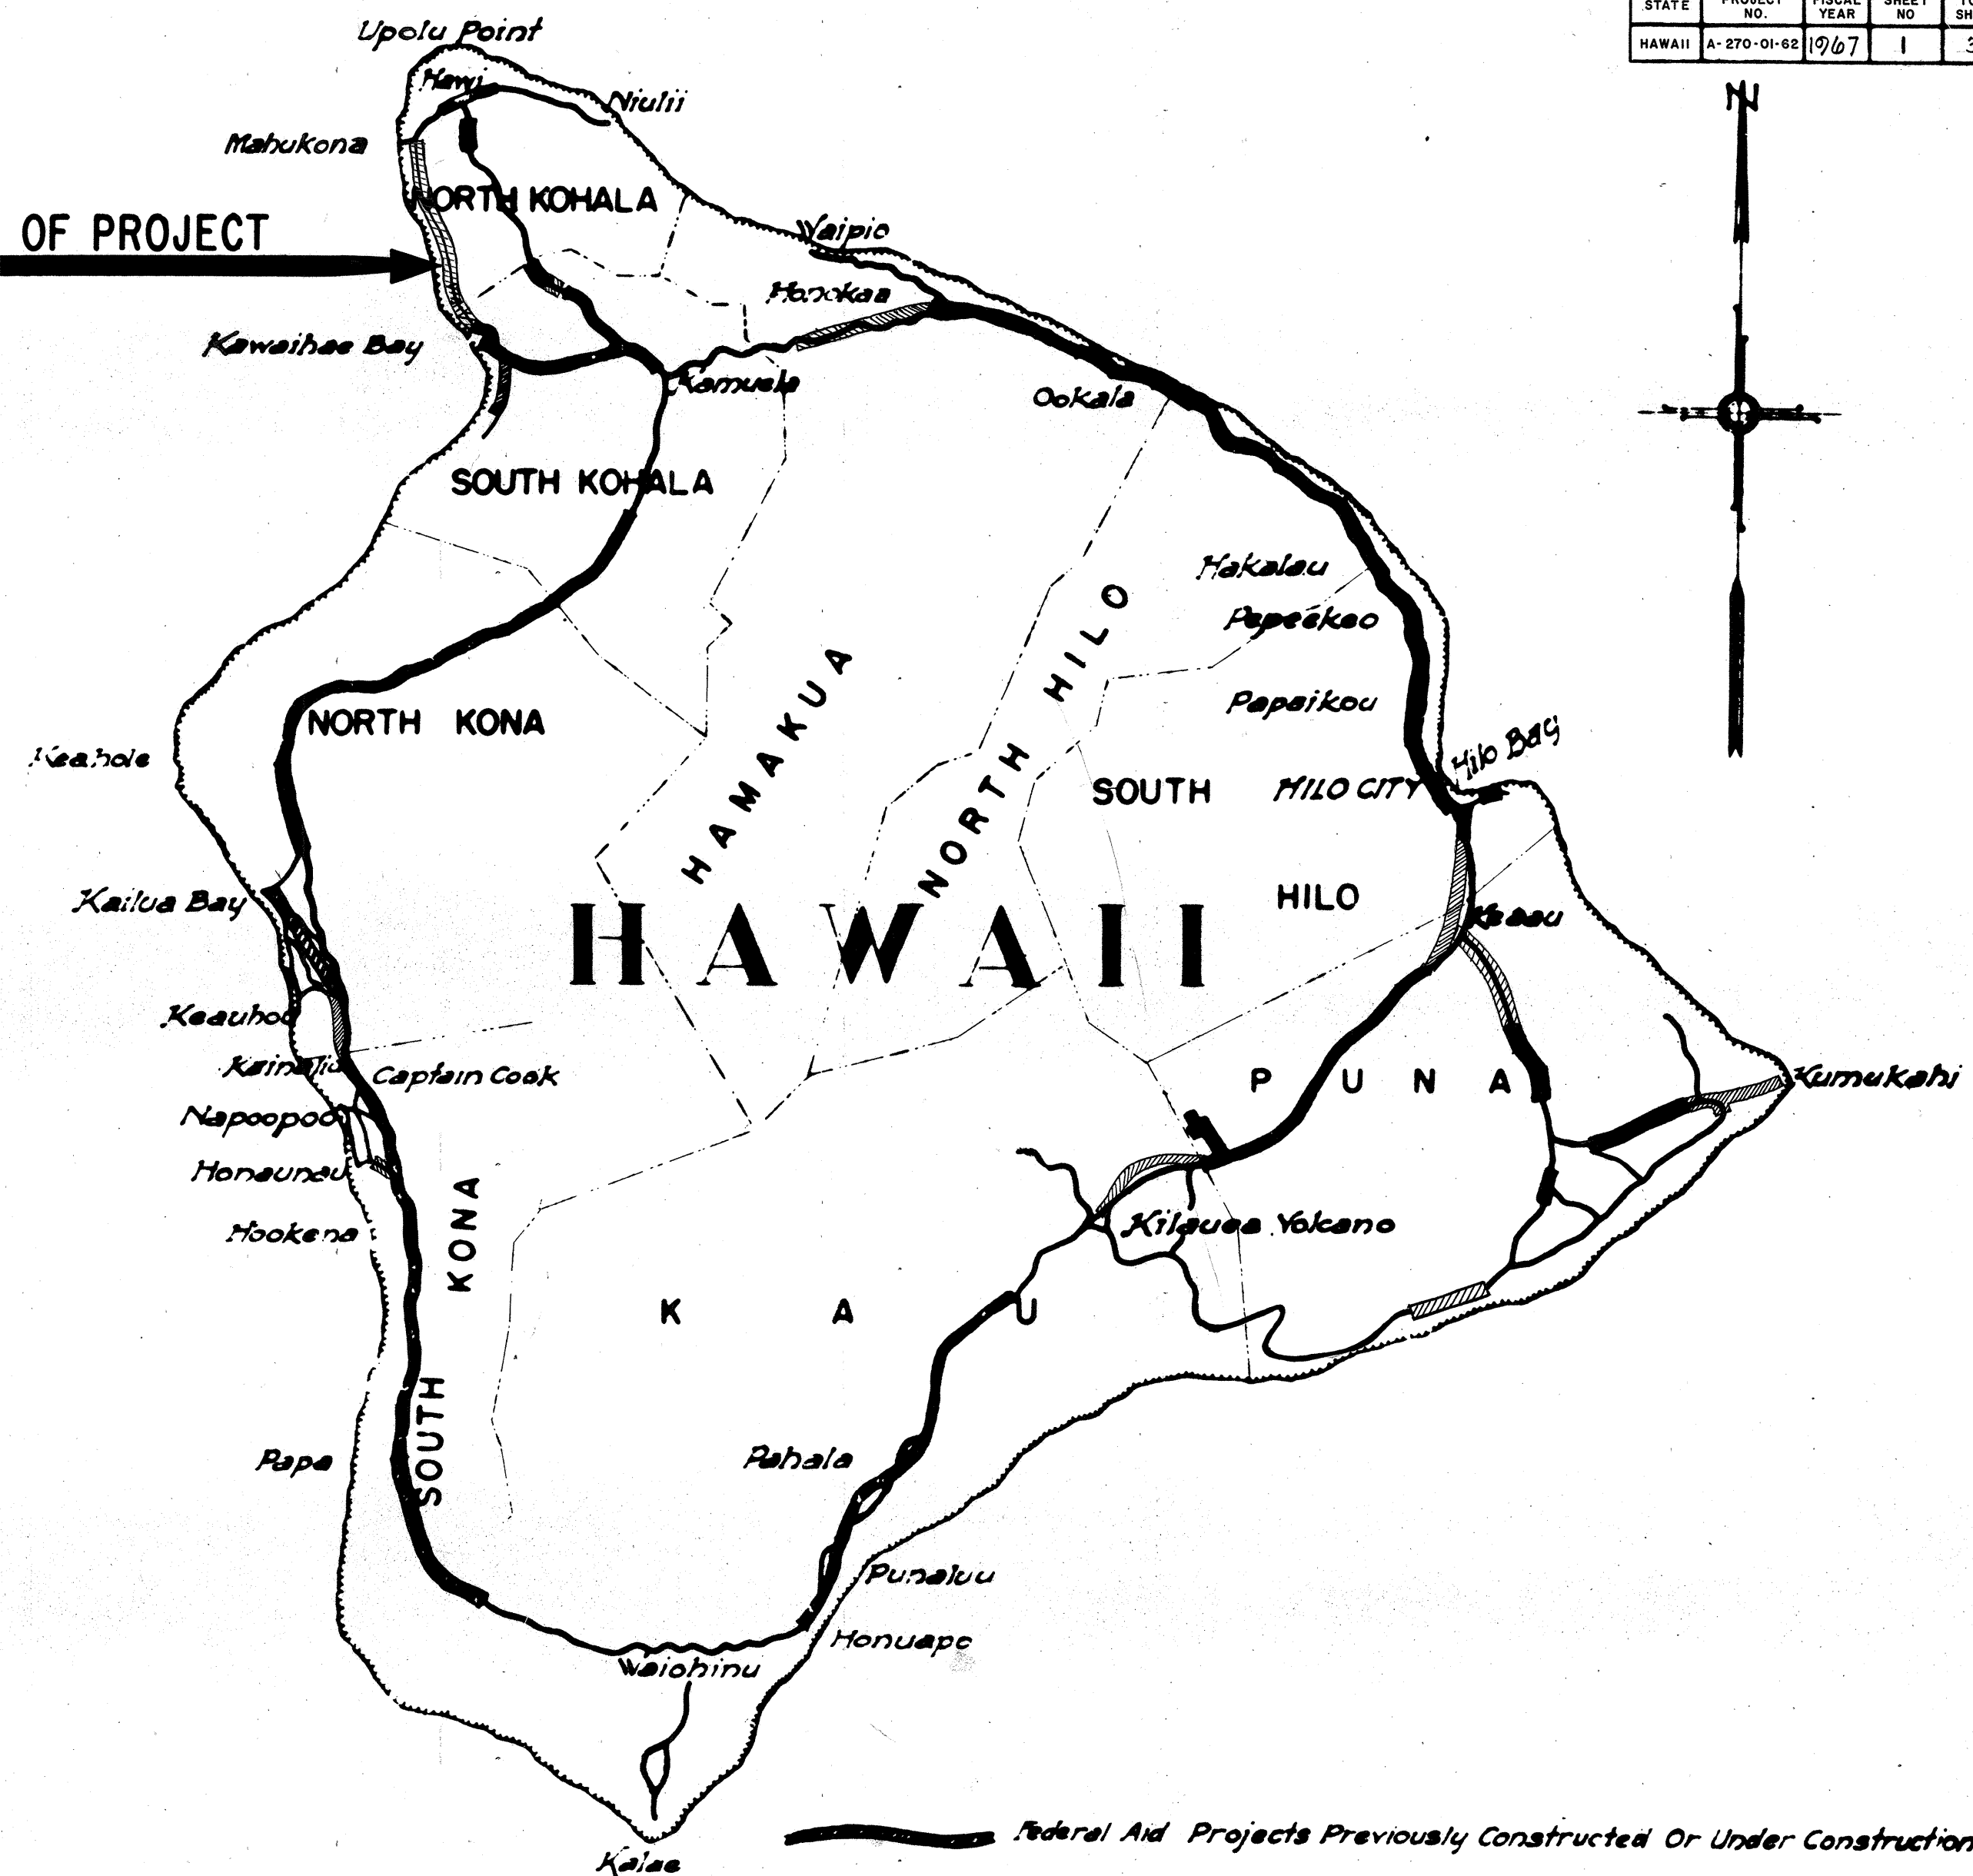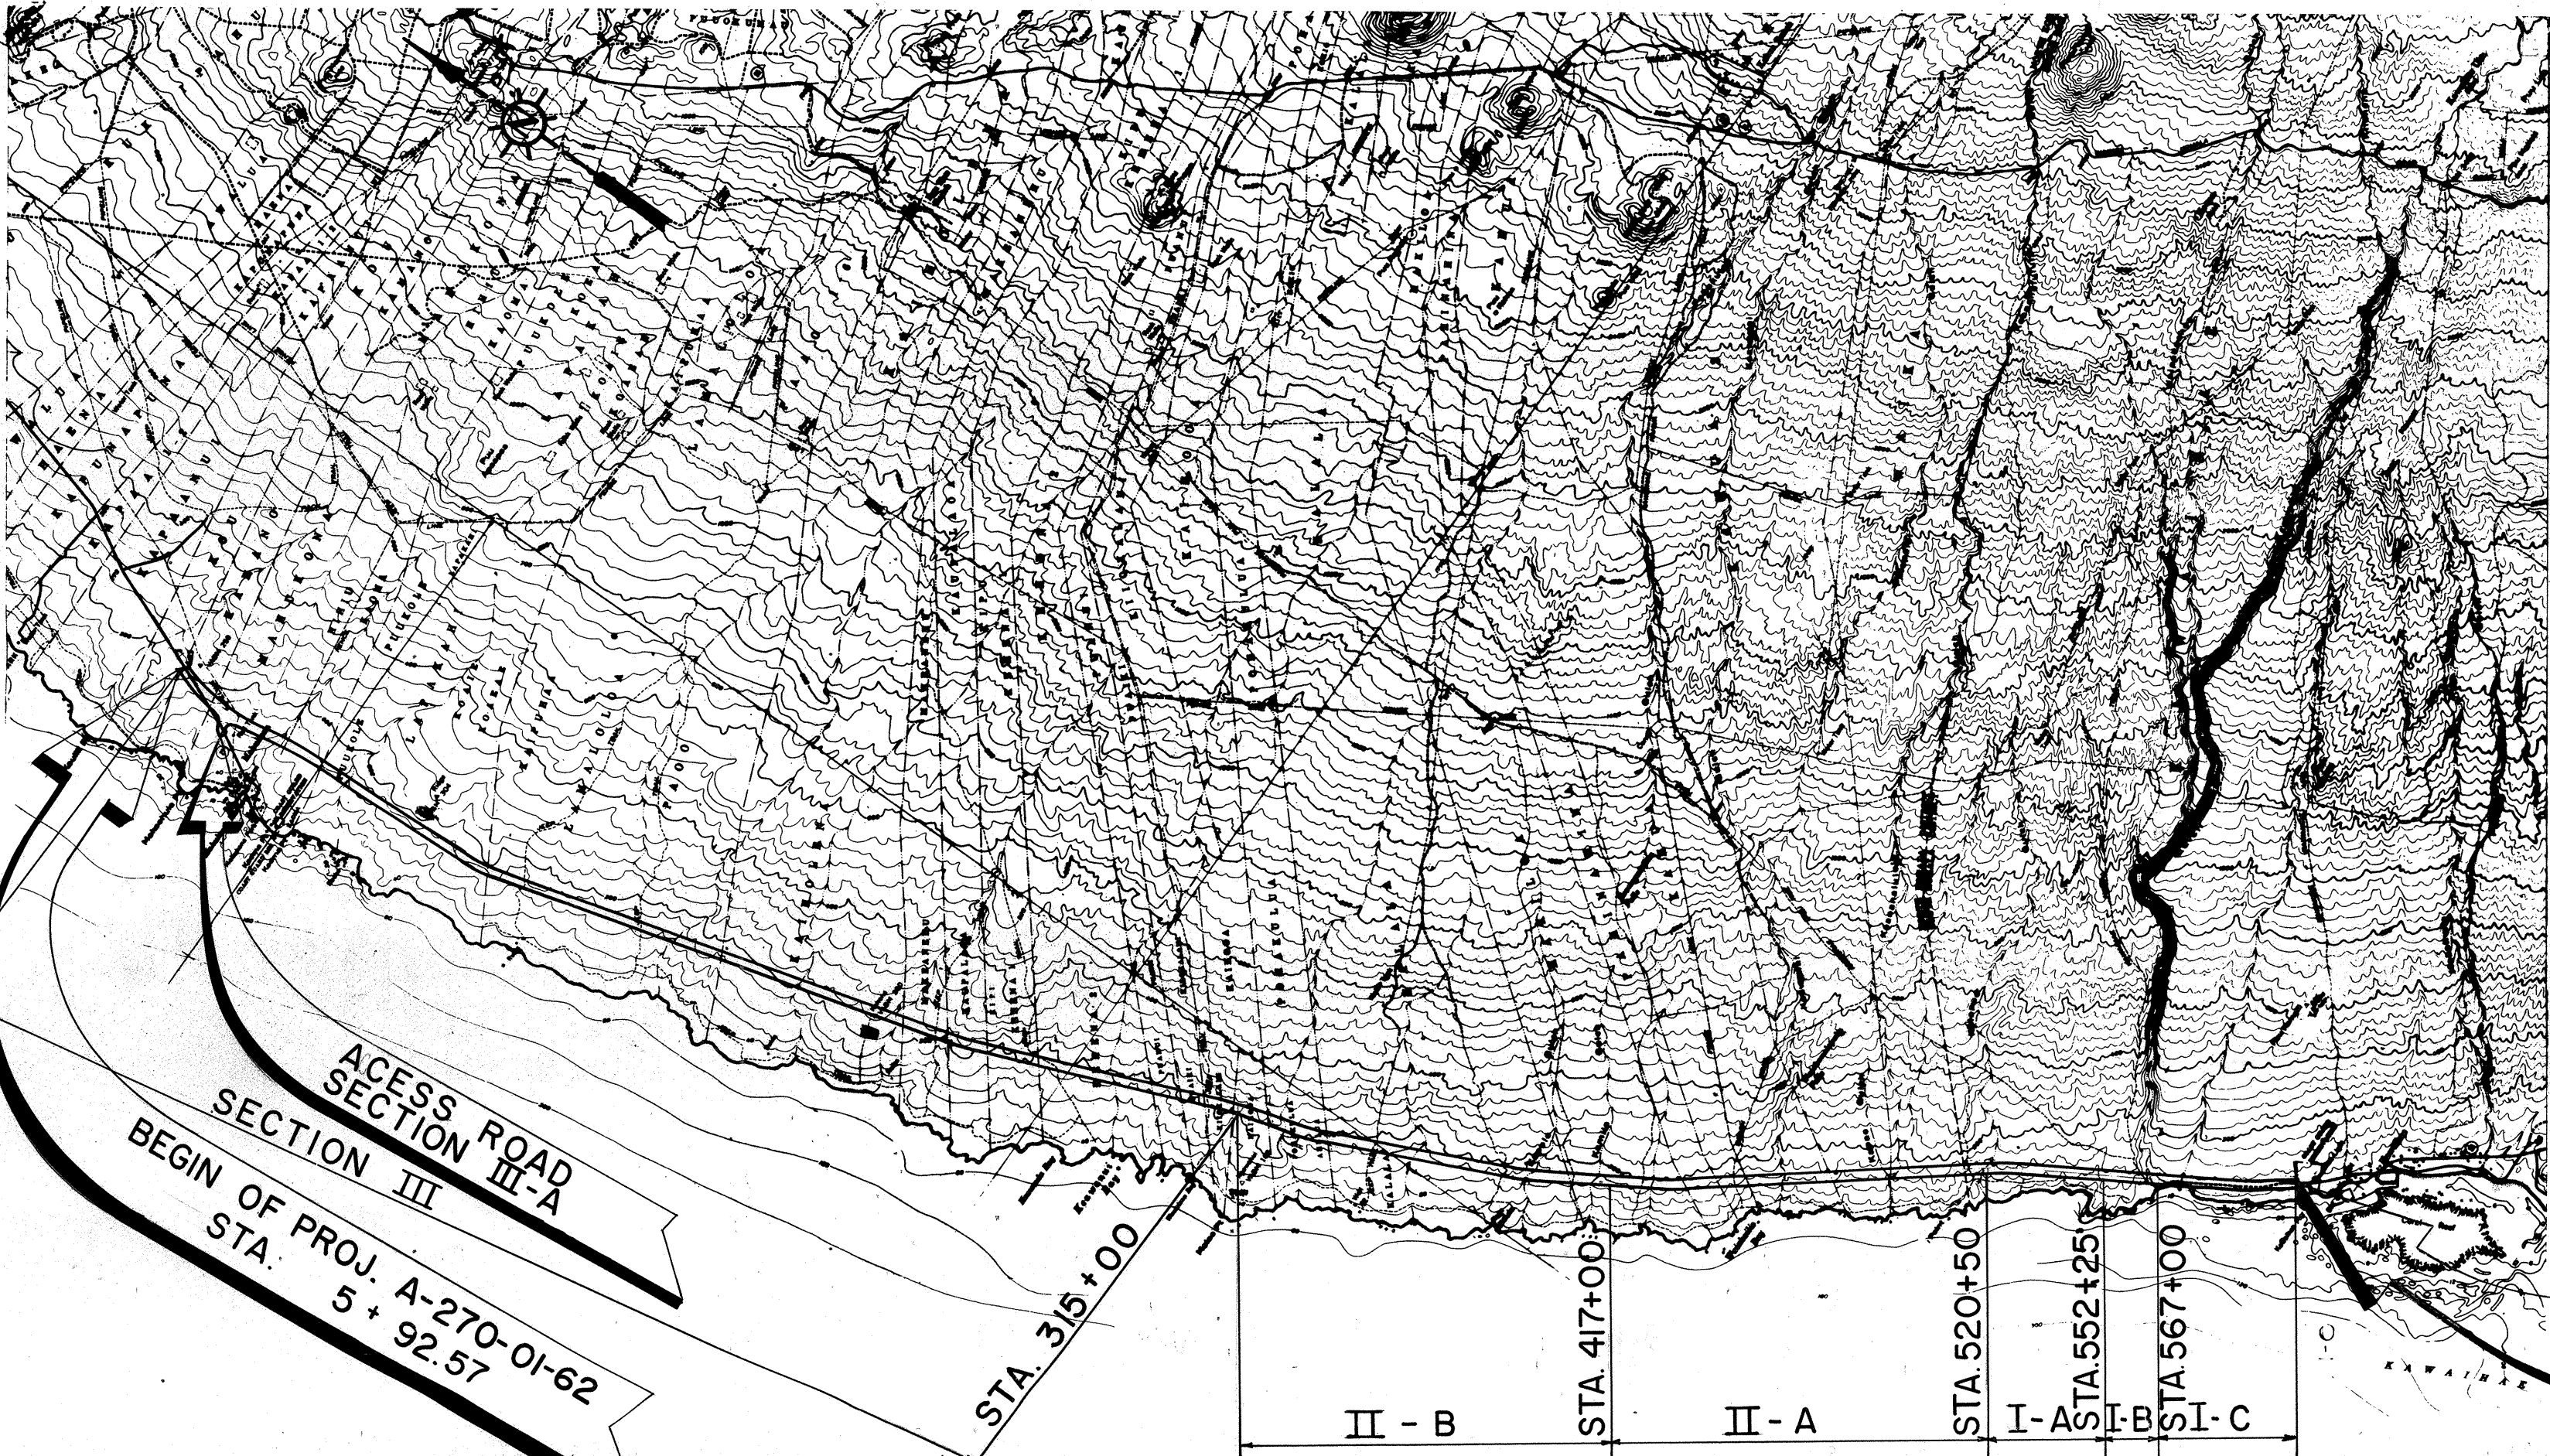

NOTE:

ALL CHANGES MADE DURING CONSTRUCTION

HAVE BEEN NOTED IN RED ON THESE TRACINGS

AND CHECKED BY:

DESIGN CLASSIFICATION

ADT (1981)	350
DHV	12%
D	60/40
T	10%
V	60 MPH

Karen Higashi

PROJECT ENGINEER

5/4/69

DATE

GROSS LENGTH OF PROJECT: 11.423 Miles

EXCEPTION 0.031 Miles

NET LENGTH OF PROJECT: 11.392 Miles

APPROVED: *John M. Sun*

DATE: 5-12-67

DIRECTOR OF TRANSPORTATION