
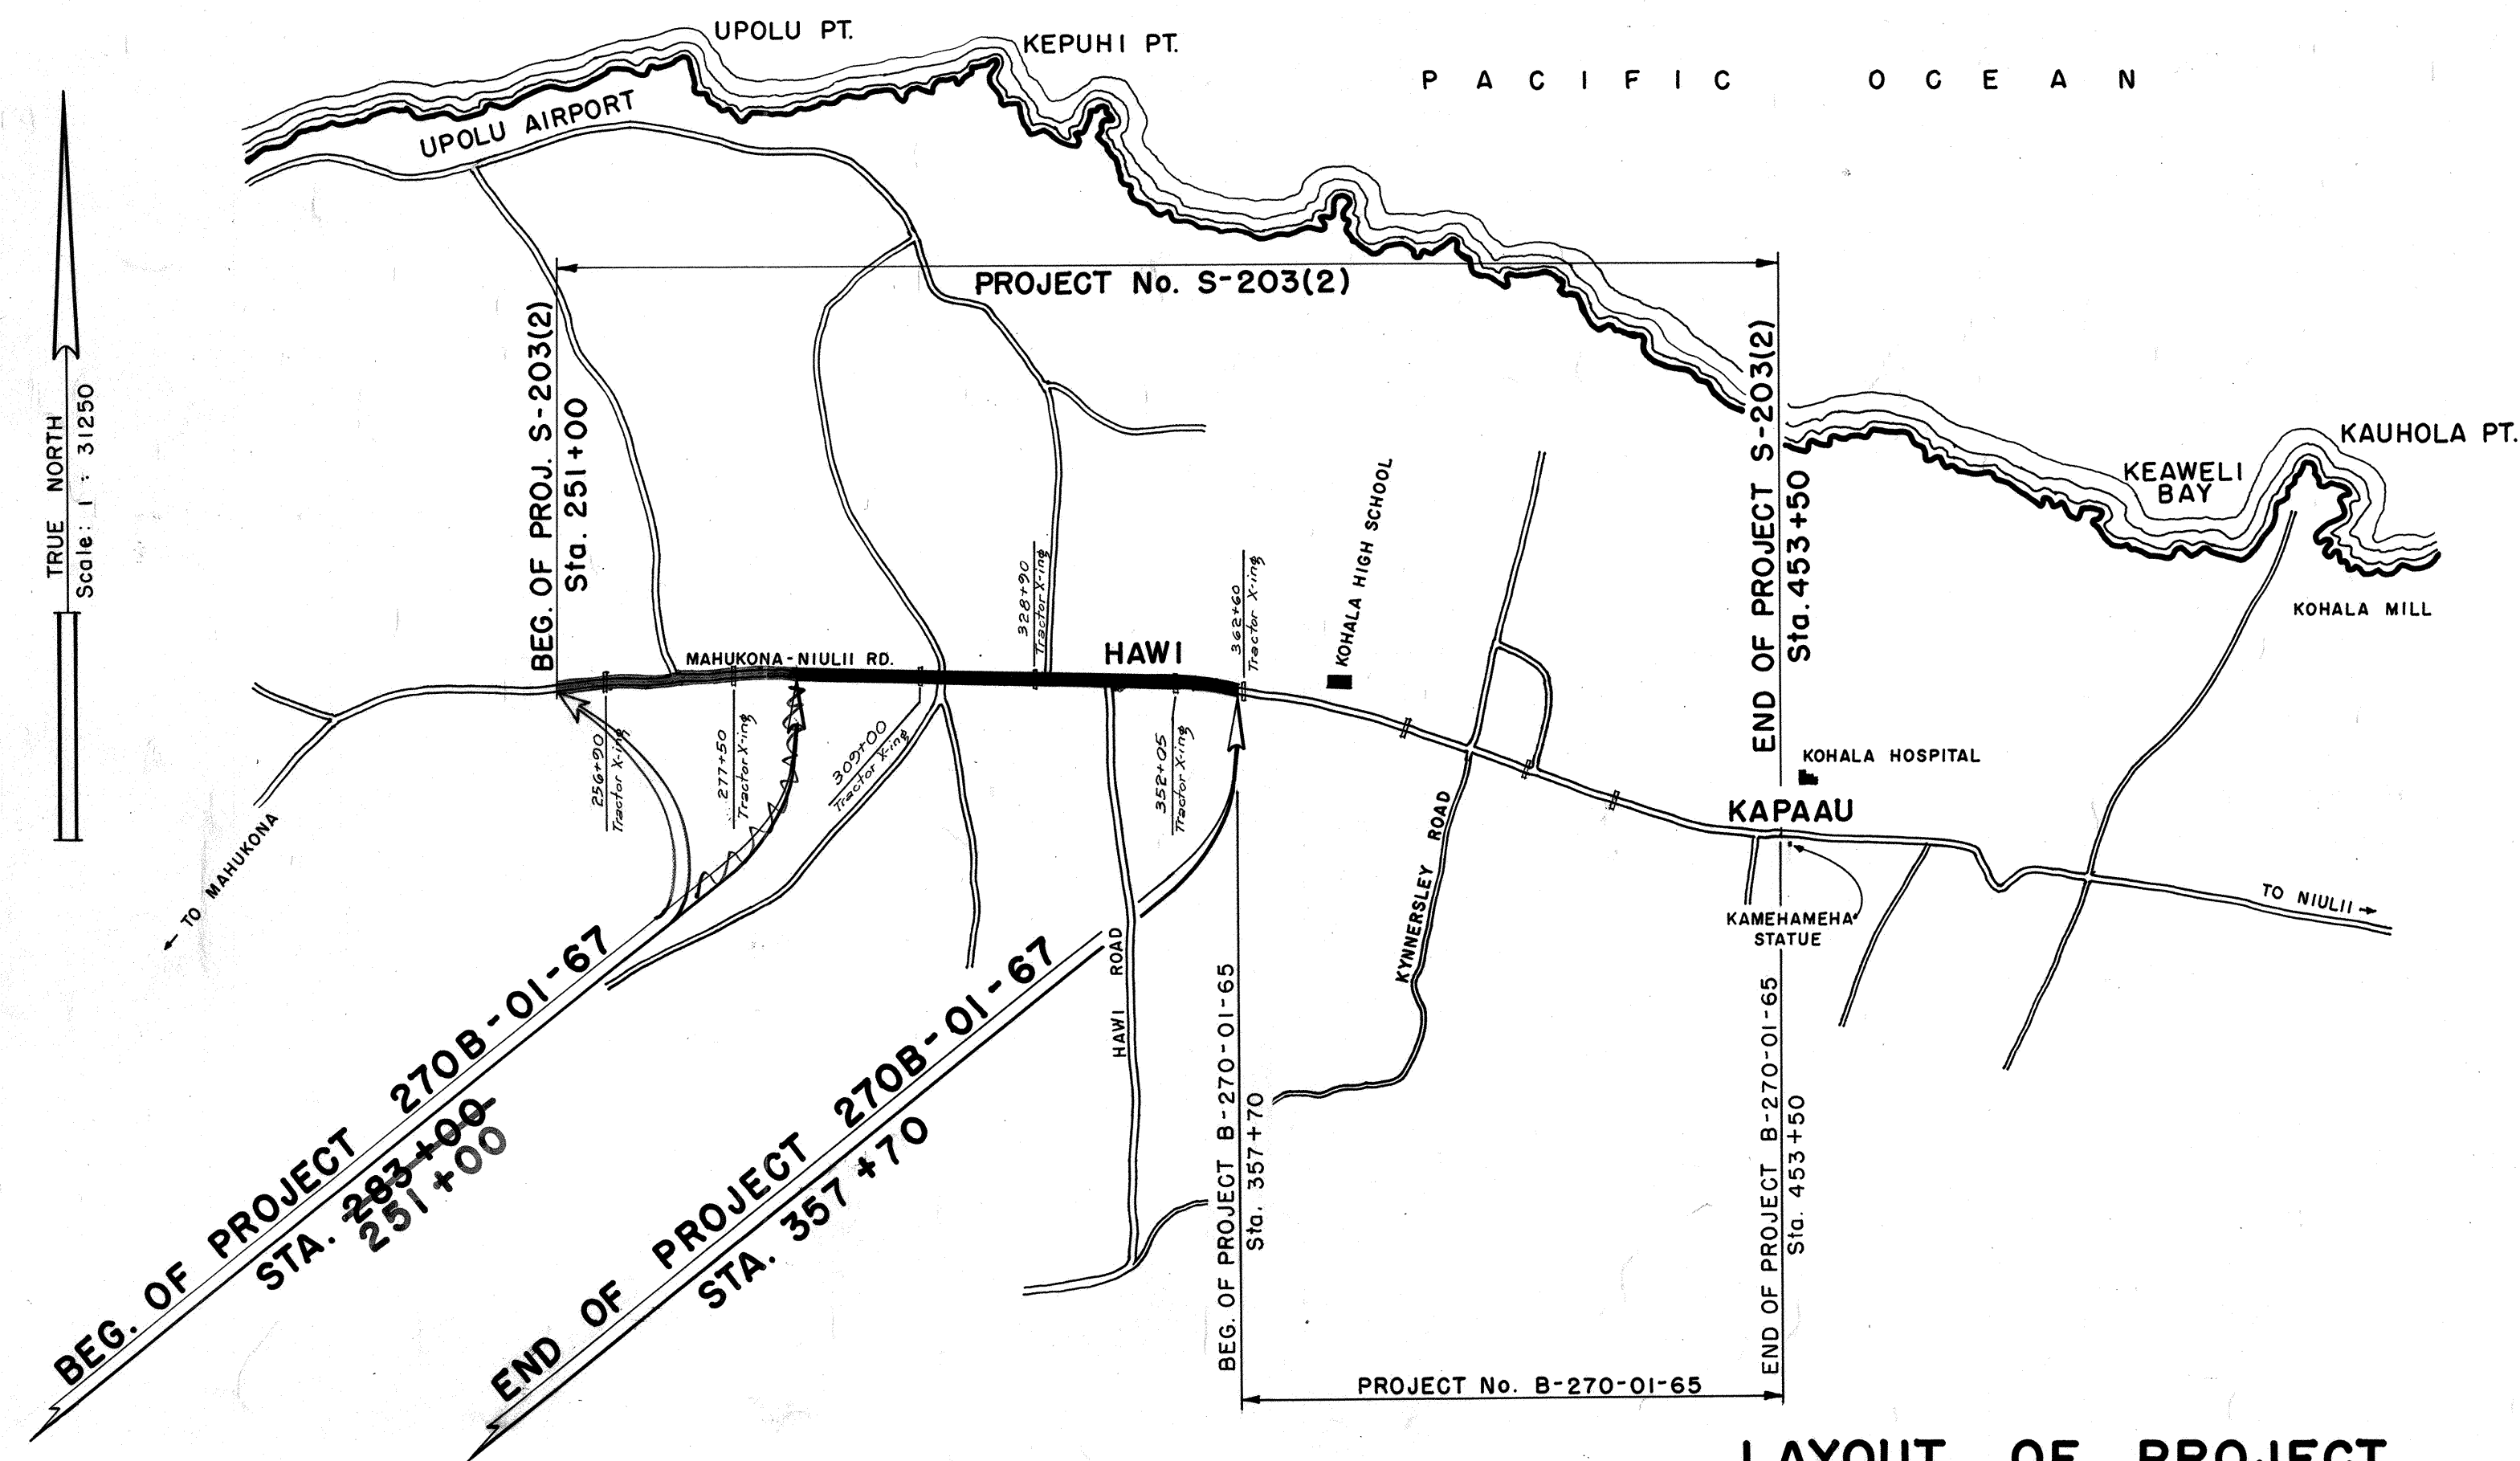


INDEX TO DRAWINGS	
SHEET	DESCRIPTION
1	TITLE SHEET AND LAYOUT PLAN
2	TYPICAL SECTIONS

STATE OF HAWAII
DEPARTMENT OF TRANSPORTATION
HIGHWAYS DIVISION
AS BUILT
PLANS OF
RESURFACE & REHABILITATE
MAHUKONA - NIULII ROAD
(HAWI TOWARDS MAHUKONA)
HAWAII PROJECT NO. 270B-01-67
DISTRICT OF NORTH KOHALA
ISLAND OF HAWAII

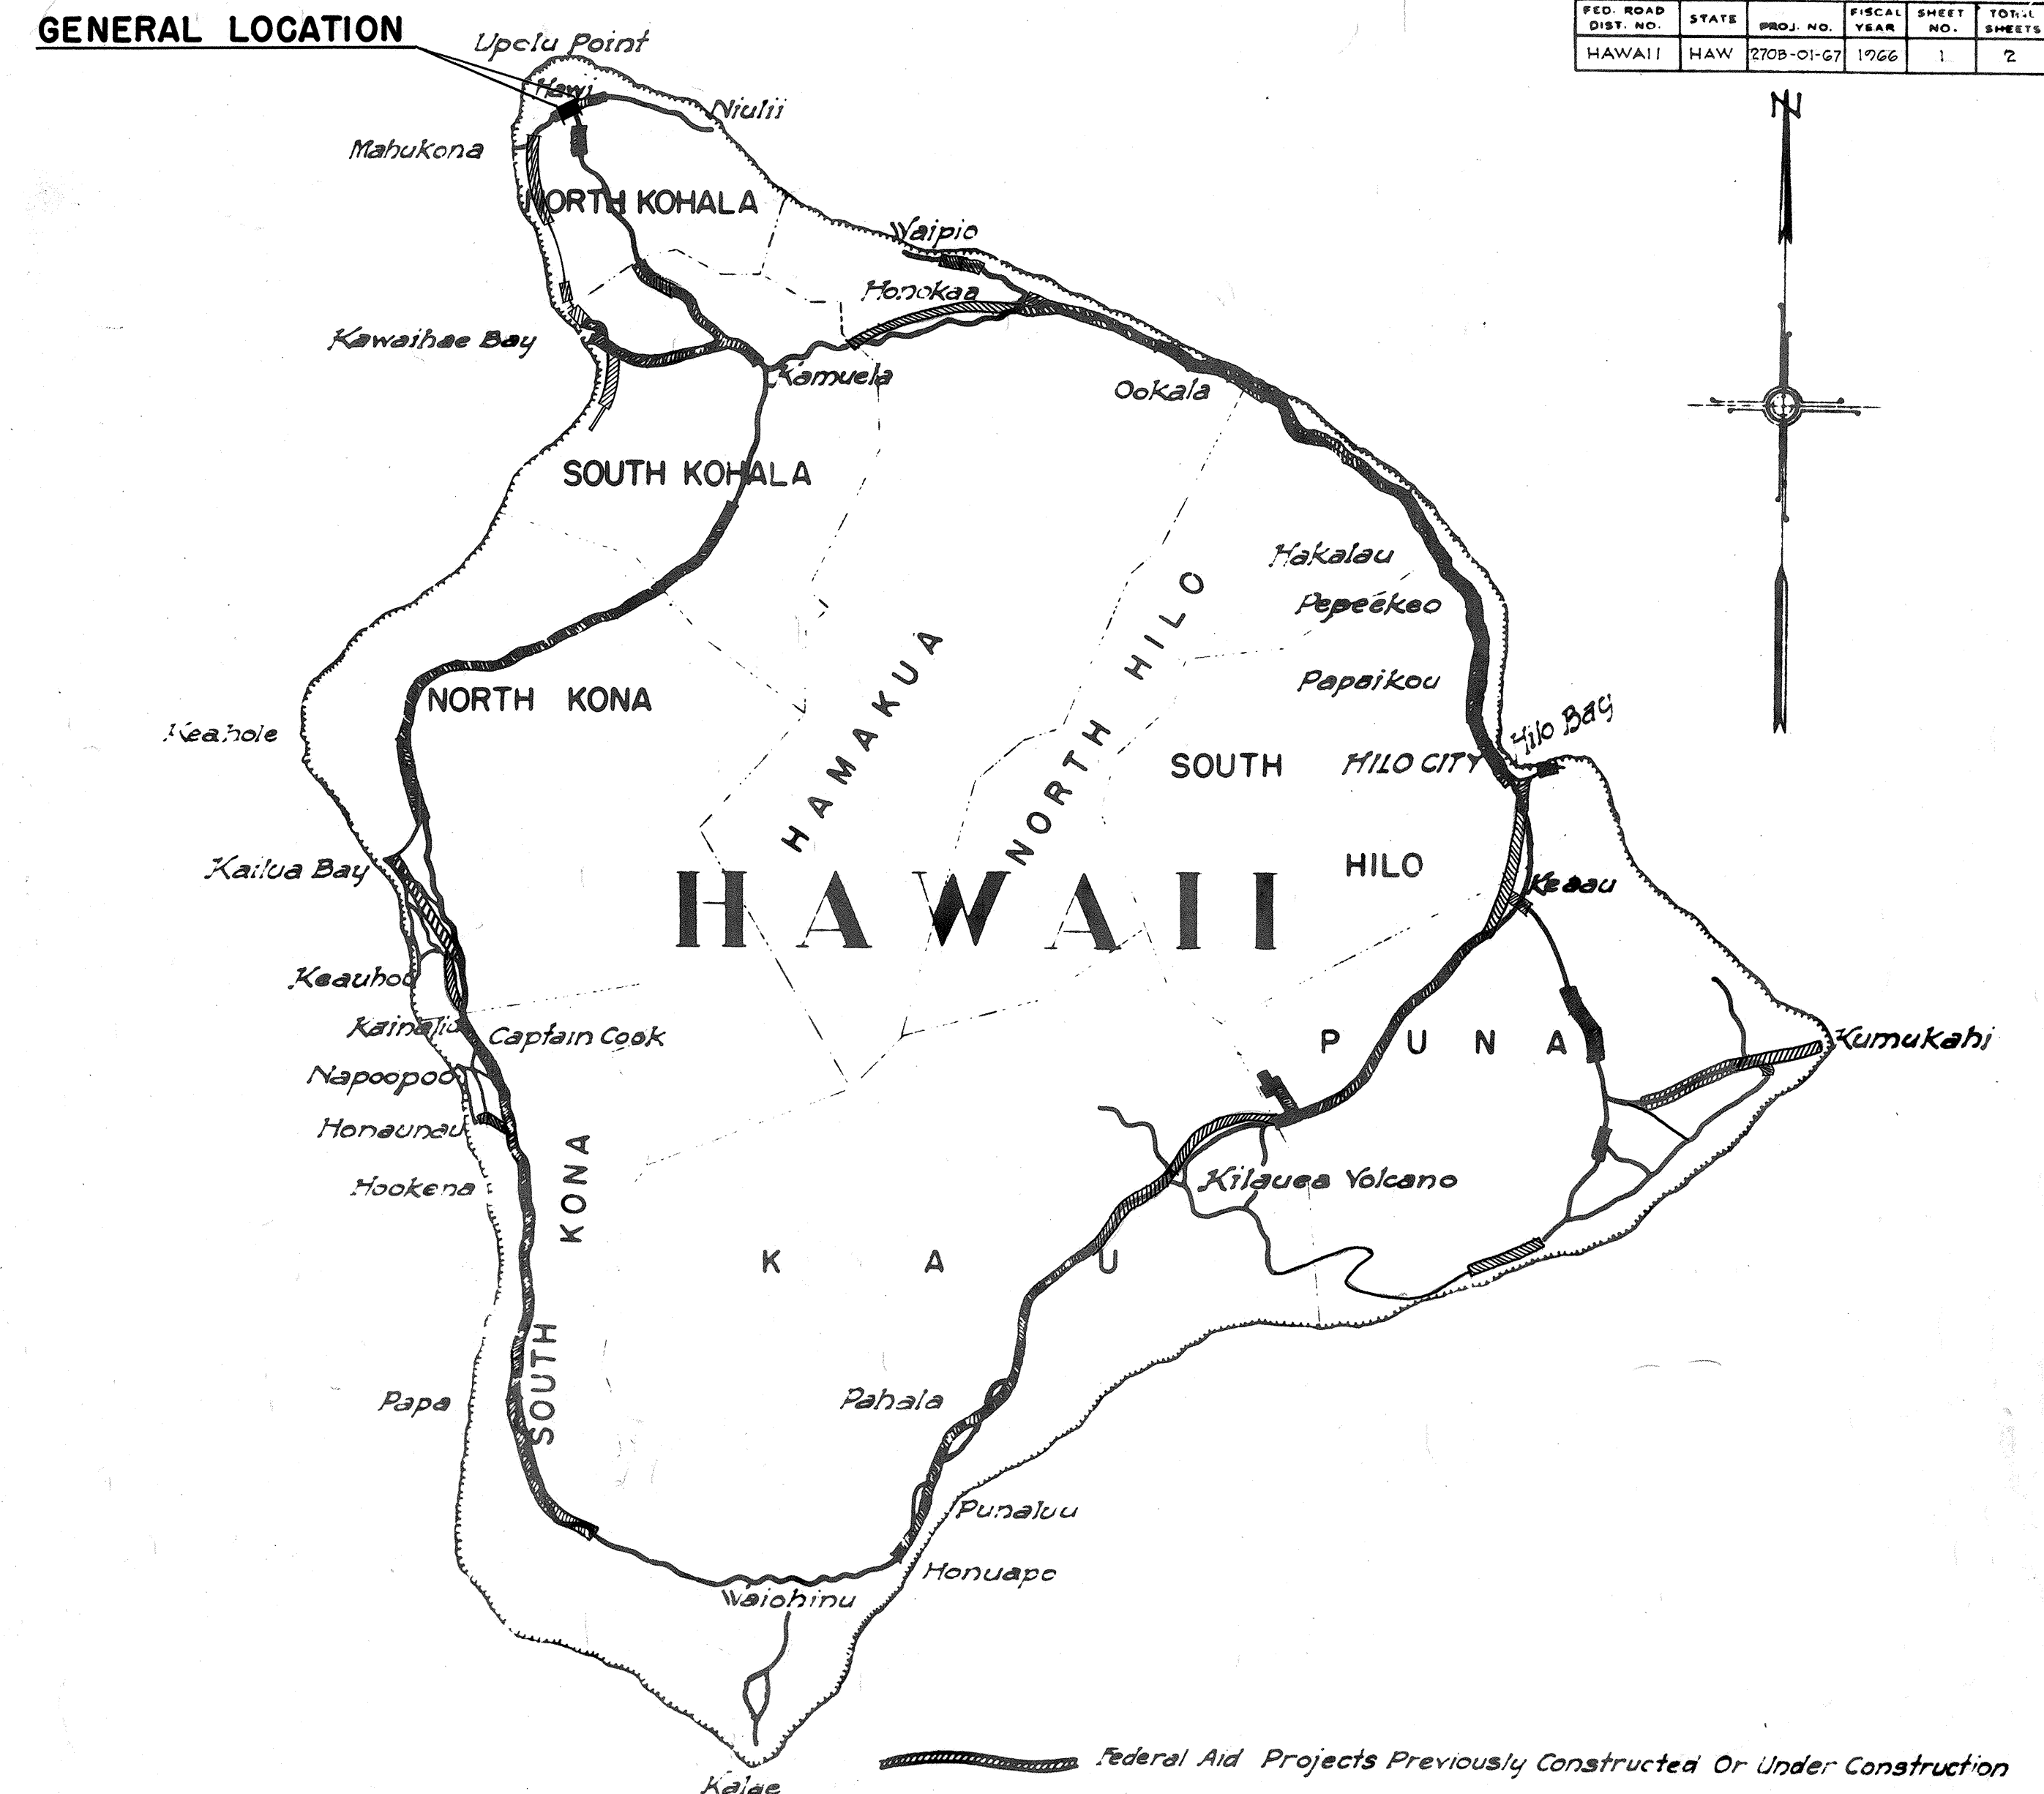

LAYOUT OF PROJECT

GROSS & NET LENGTH OF PROJECT..... 1.415 Mi.

NOTE:

ALL CHANGES MADE DURING CONSTRUCTION HAVE BEEN NOTED IN RED ON THESE SHEETS AND CHECKED BY:

PROJECT ENGINEER

DATE

APPROVED:

DATE 7-28-66

for DIRECTOR OF TRANSPORTATION