
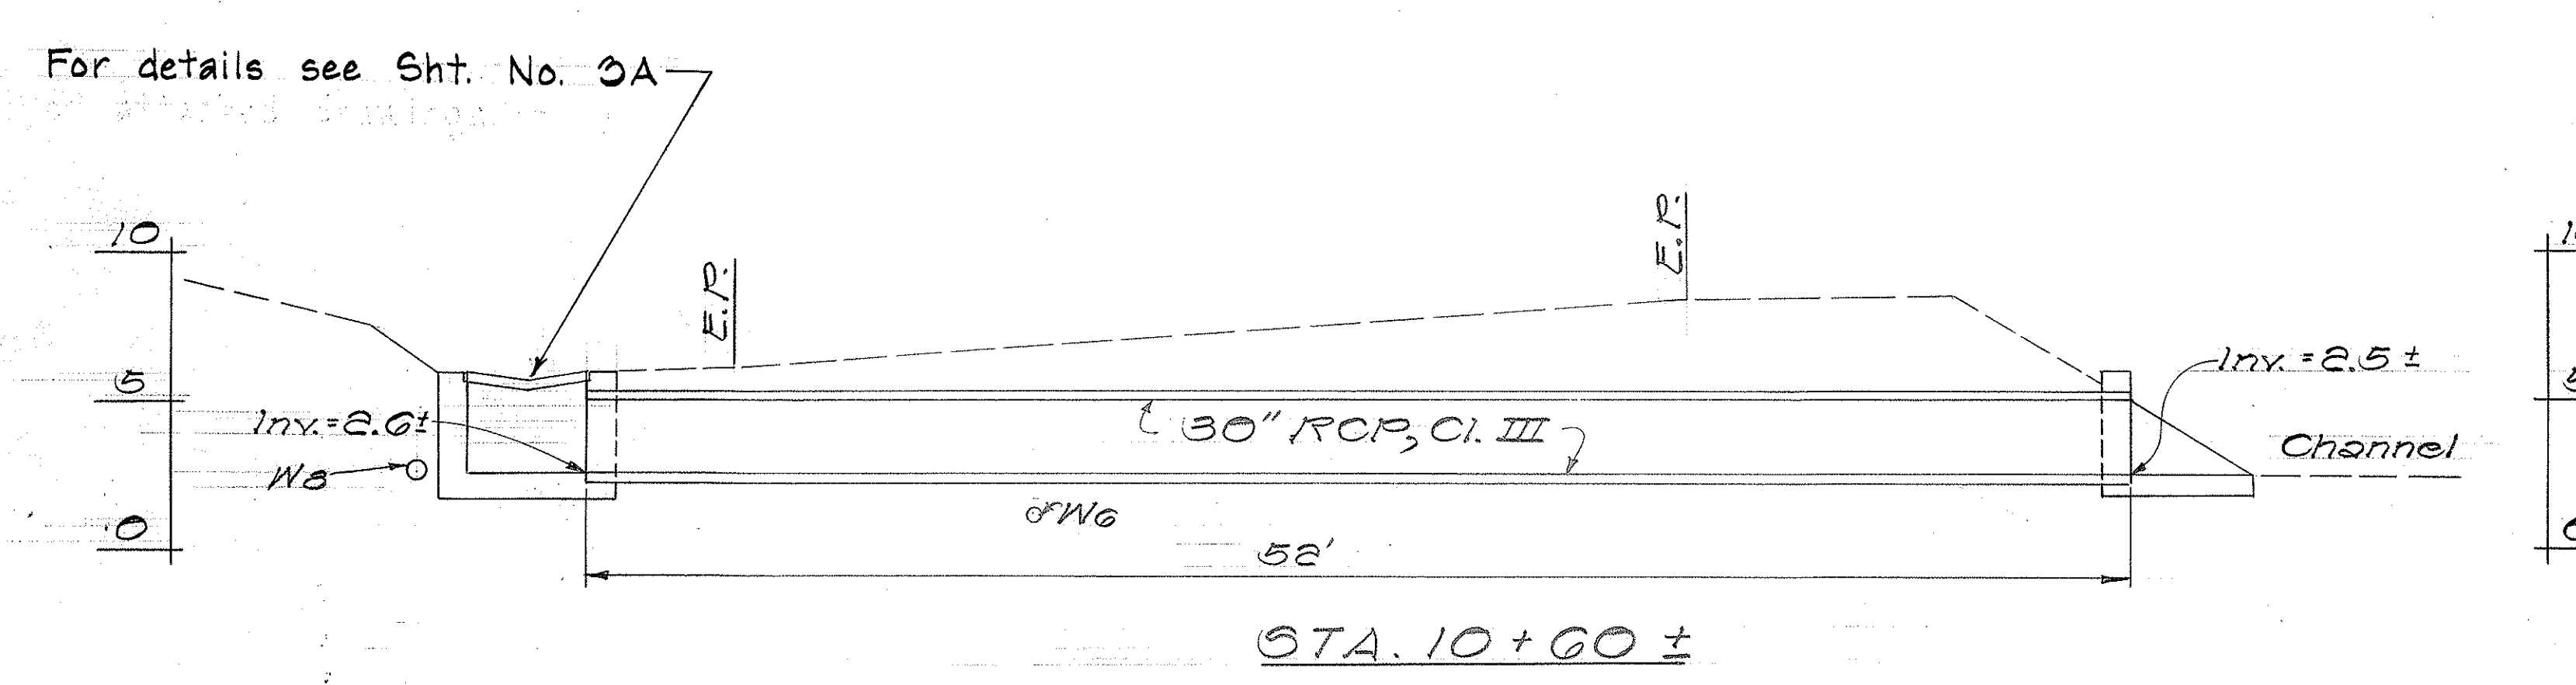
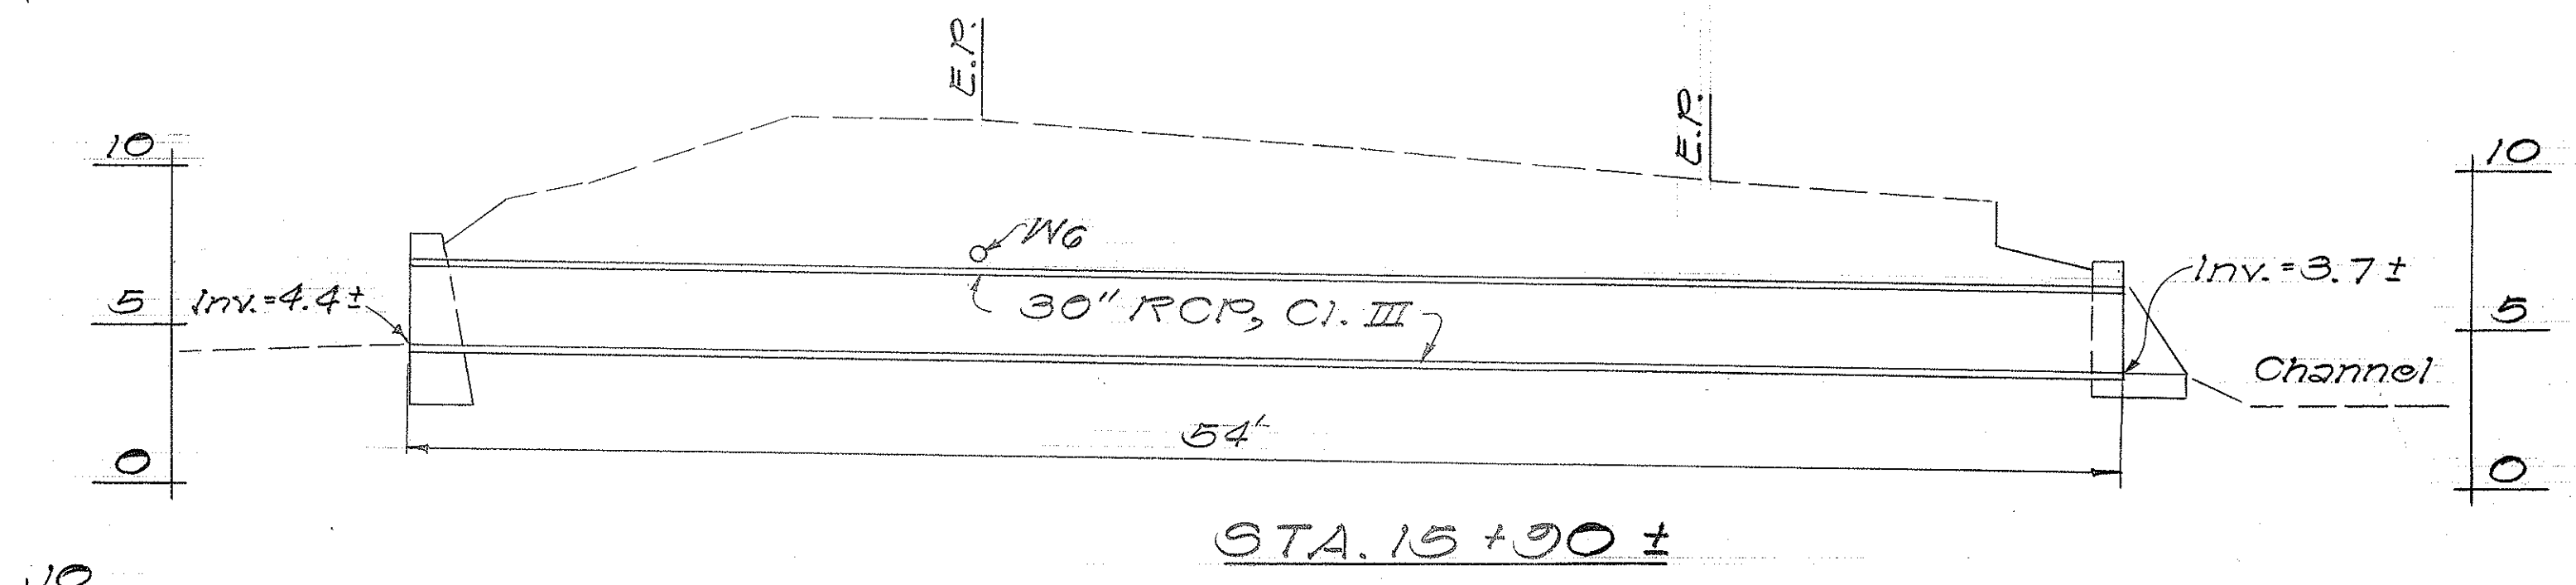
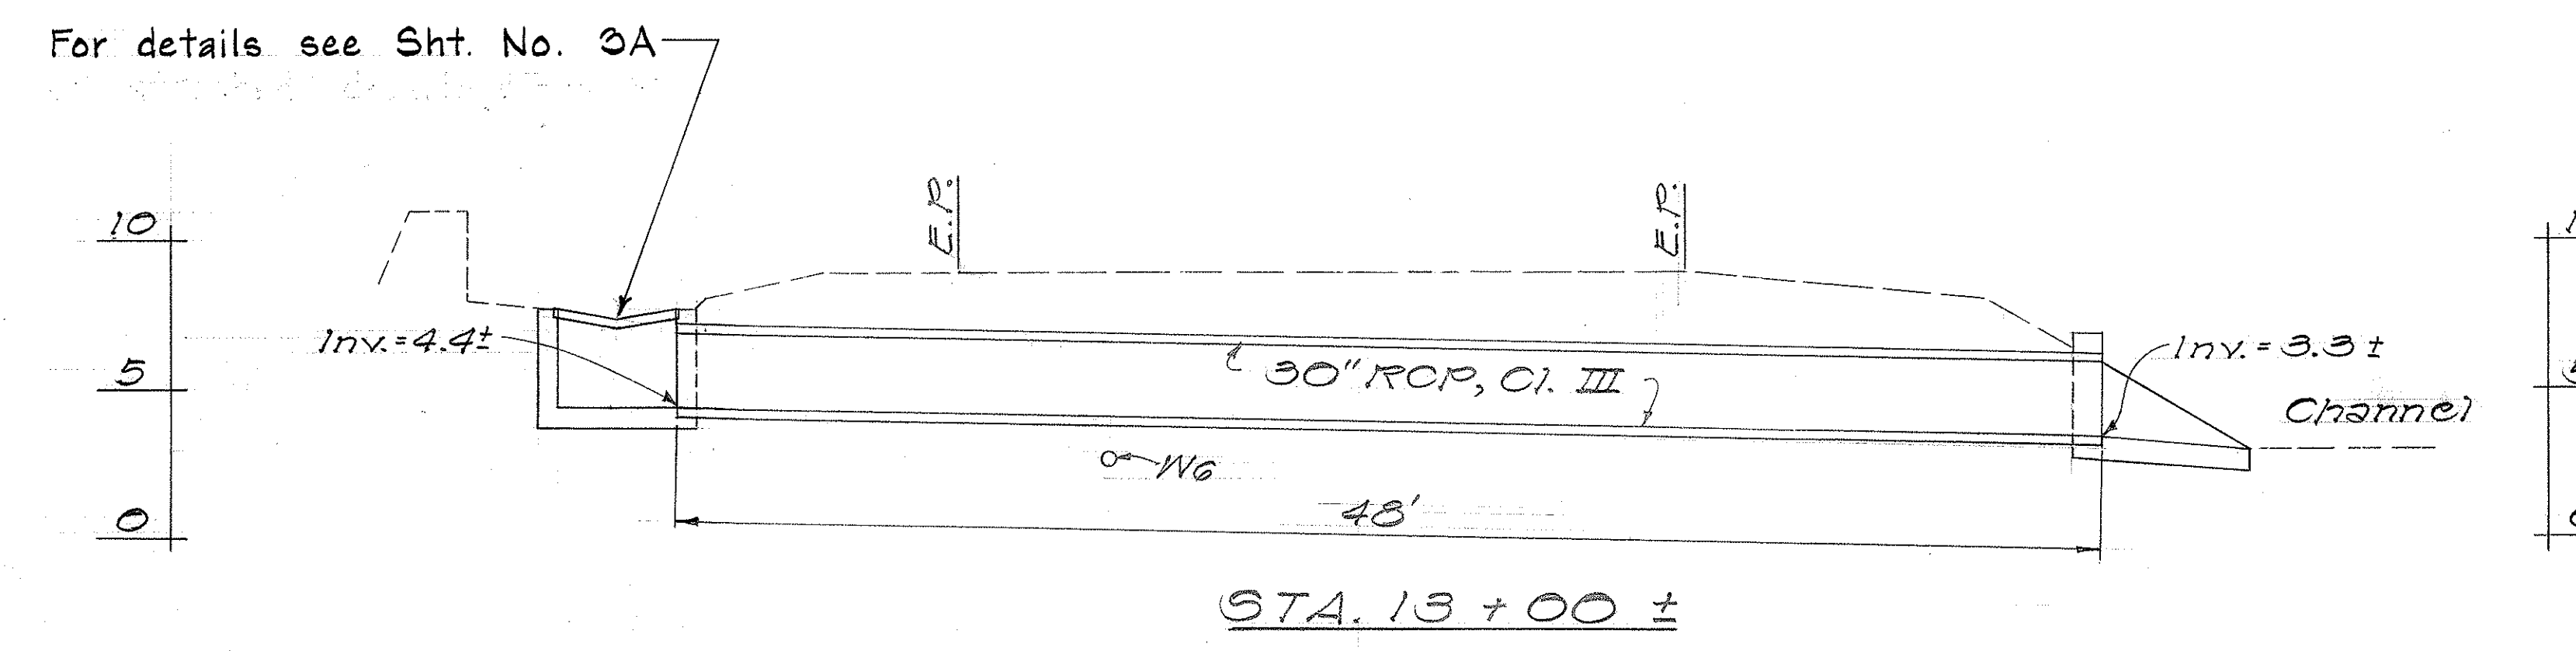
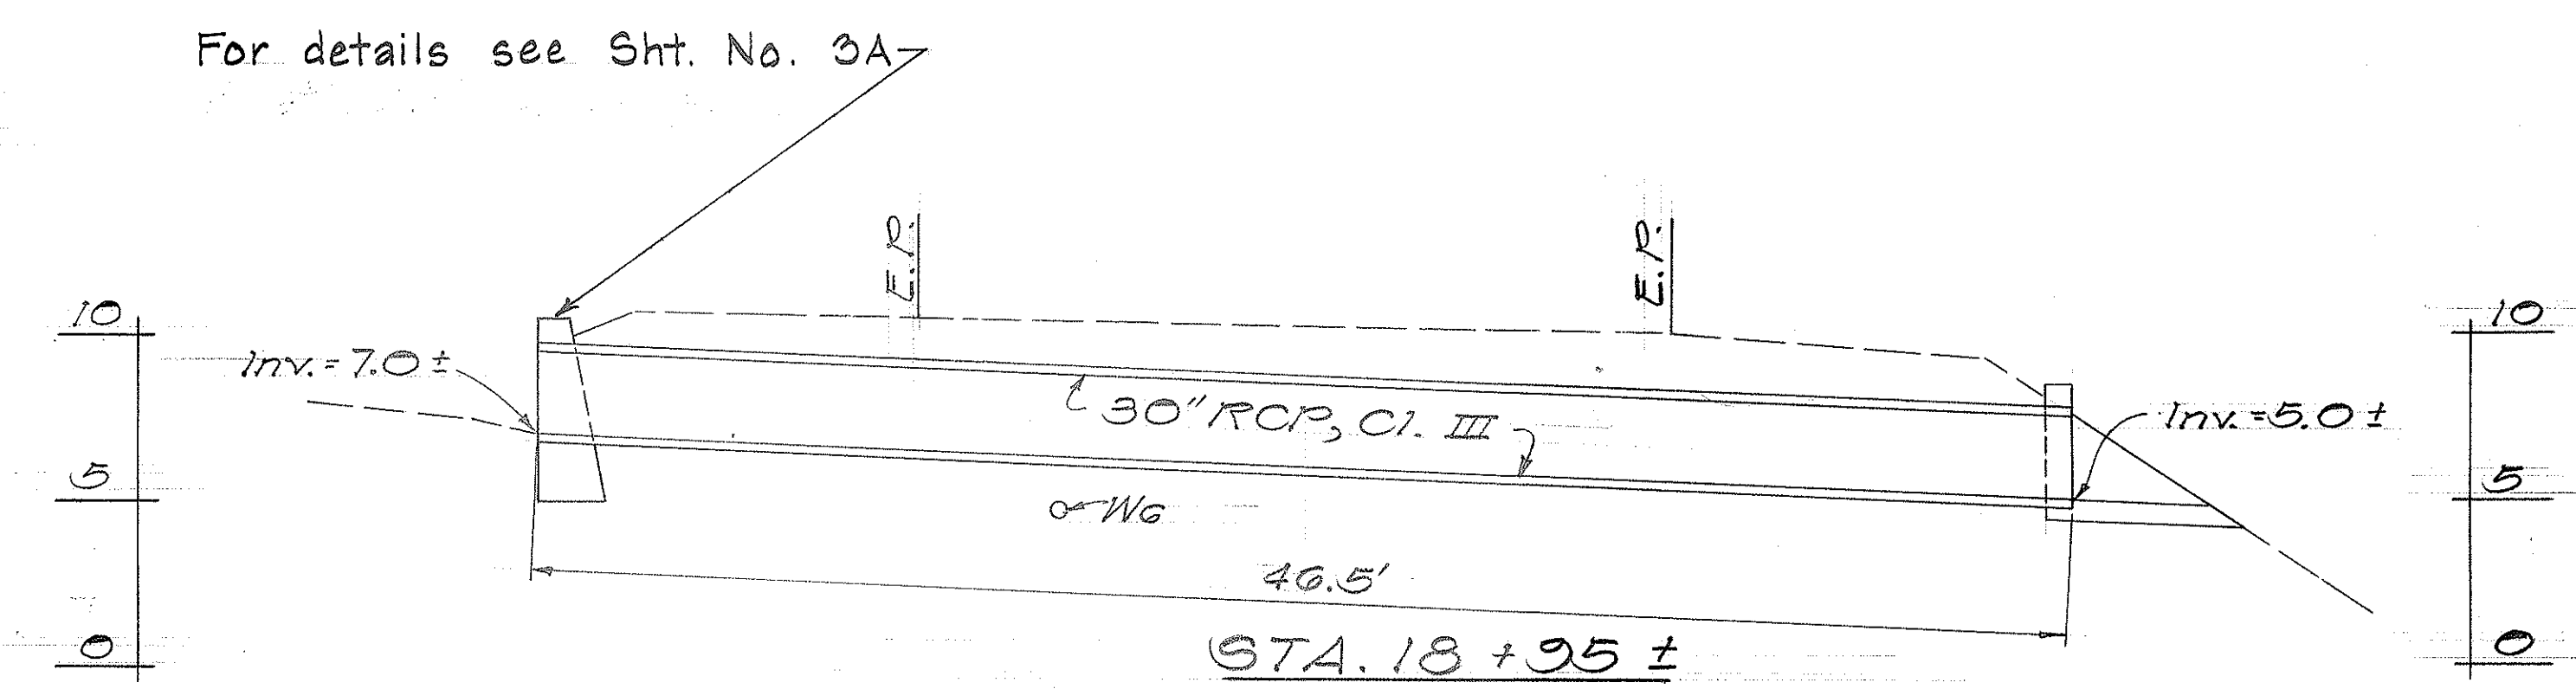


FED. ROAD DIST. NO.	STATE	PROJ. NO.	FISCAL YEAR	SHEET NO.	TOTAL SHEETS
HAWAII	HAW.	270A-01-76	1976	3	5

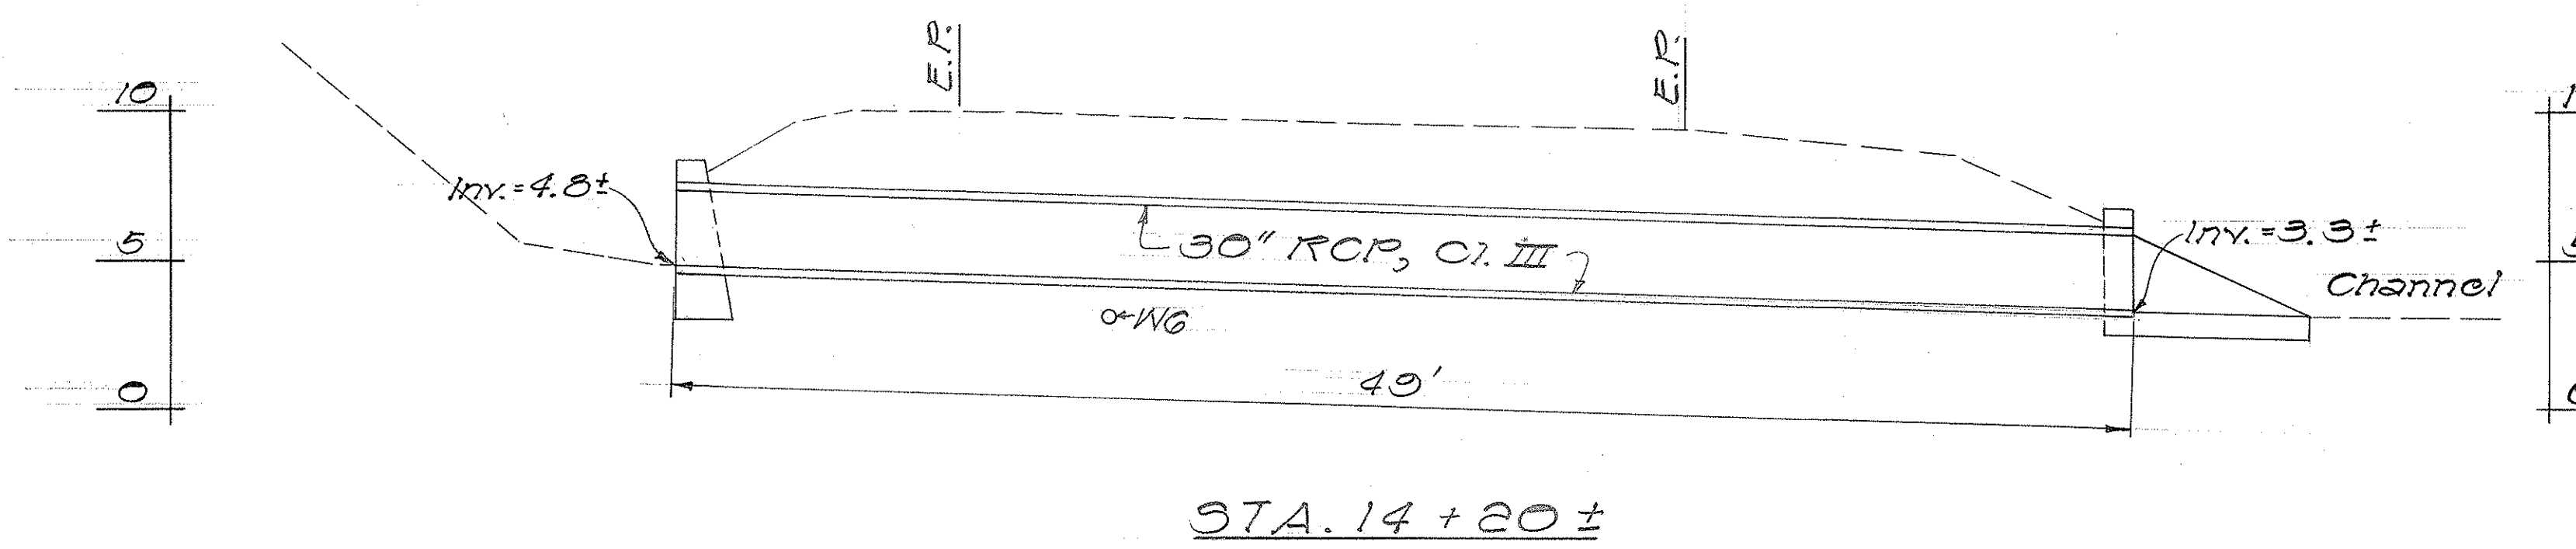

PROFILES Scale: Vert. : 1" = 5' Hor. : 1" = 5'

STATE OF HAWAII
DEPARTMENT OF TRANSPORTATION
HIGHWAYS DIVISION
PROFILES
DRAINAGE IMPROVEMENTS
ON
KAWAIHAE ROAD
(Vicinity of Kawaihae Harbor)
Proj. No. 270A-01-76
Scale: As Noted Date: Dec. 1975
SHEET No. 1 OF 1 SHEETS

ORIGINAL PLAN	SURVEY PLOTTED BY	DATE
NOTE BOOK	DRAWN BY	
No.	DESIGNED BY	
	QUANTITIES BY	
	CHECKED BY	