
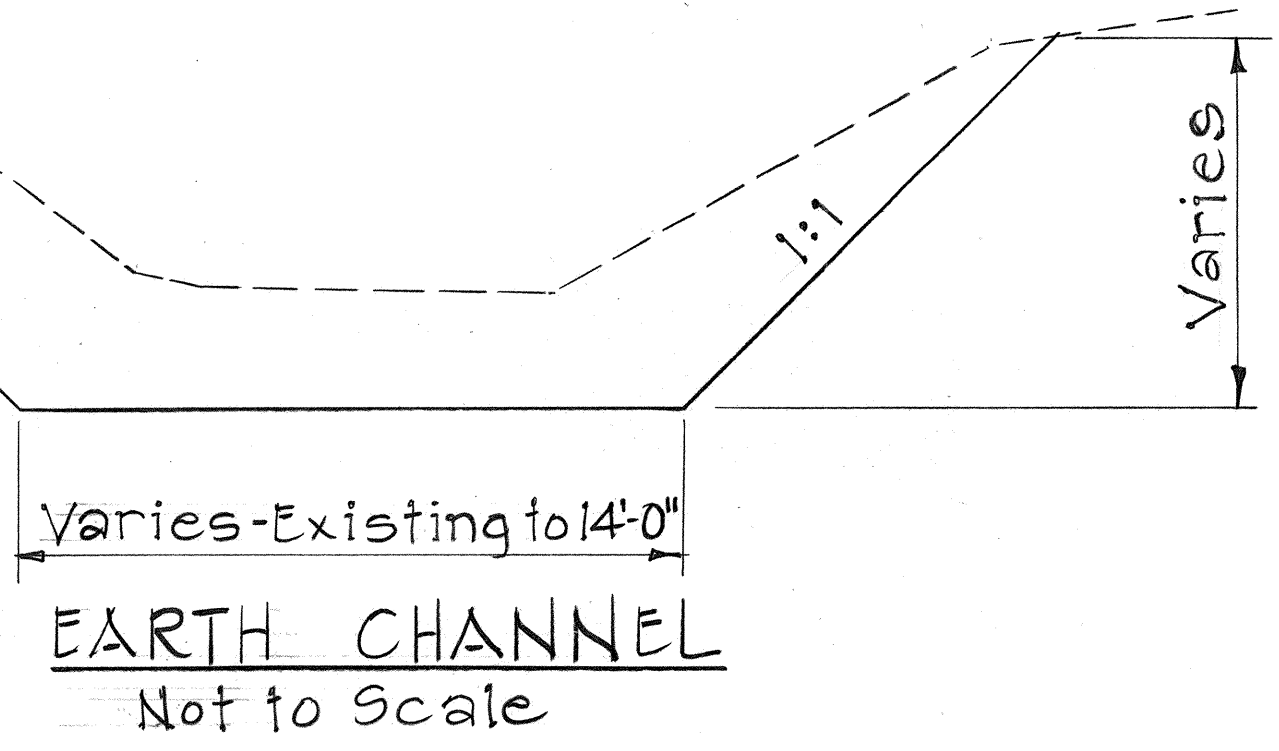
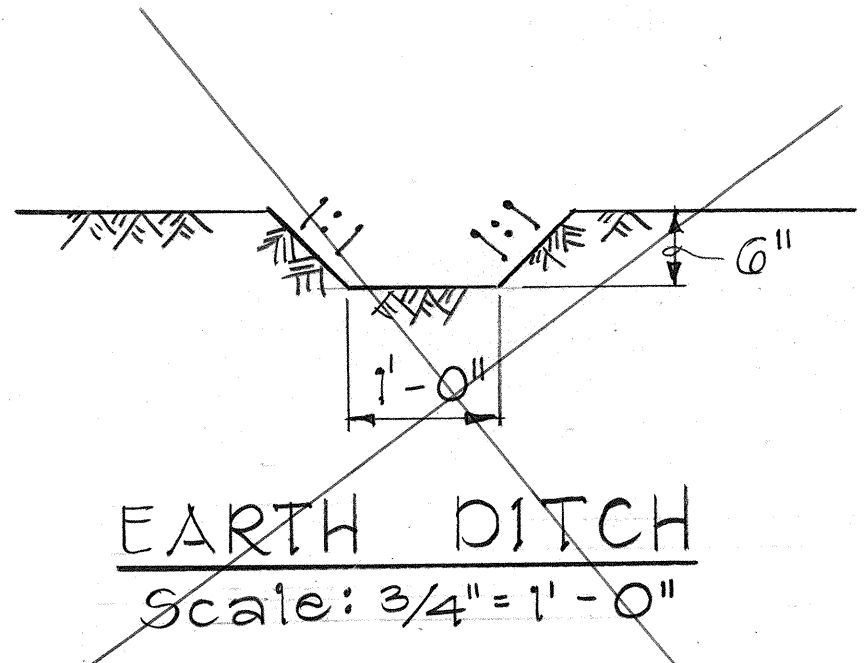
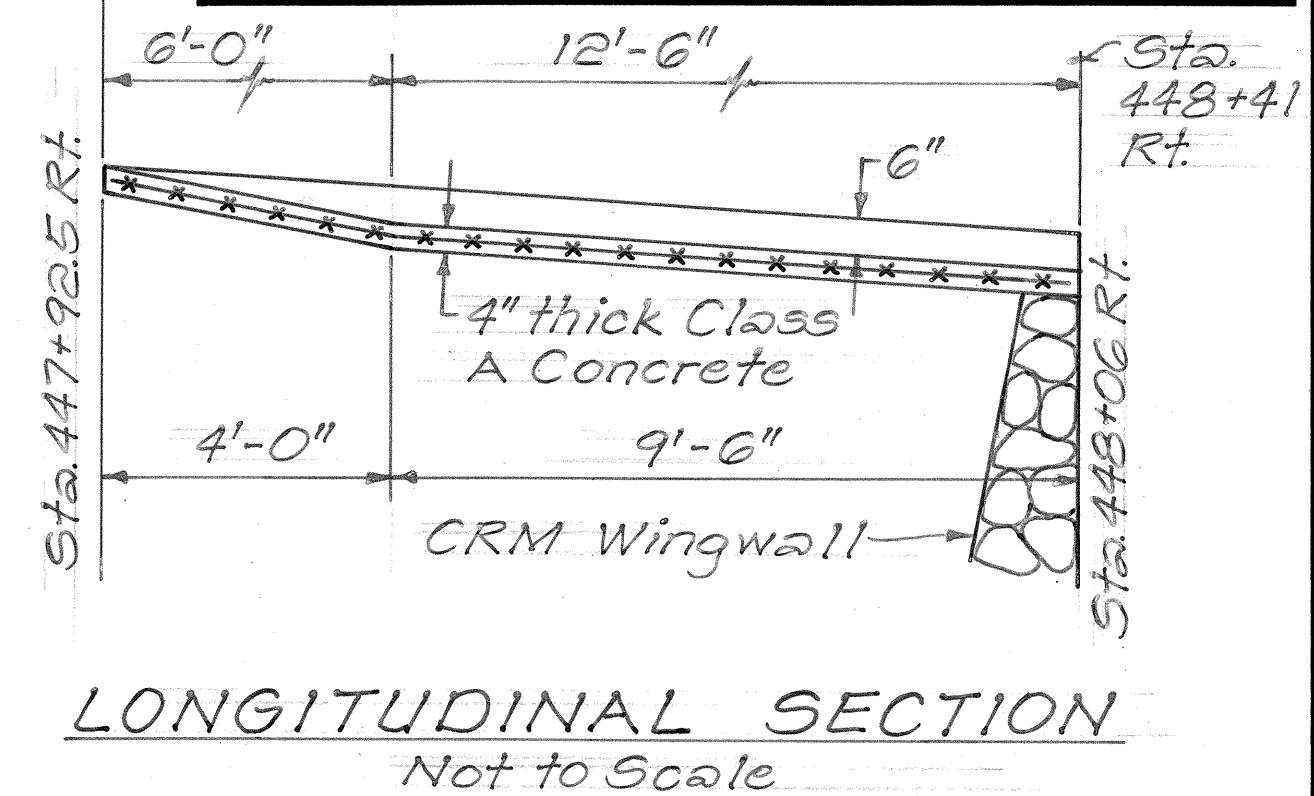
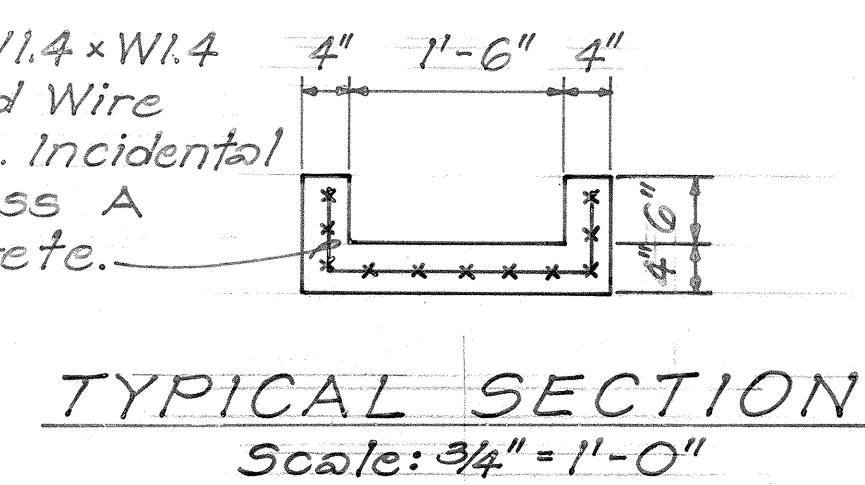


| FED. ROAD DIST. NO. | STATE | FED. AID PROJ. NO. | FISCAL YEAR | SHEET NO. | TOTAL SHEETS |
|---------------------|-------|--------------------|-------------|-----------|--------------|
| HAWAII              | HAW.  | RS-0270(10)        | 1985        | 5         | 28           |

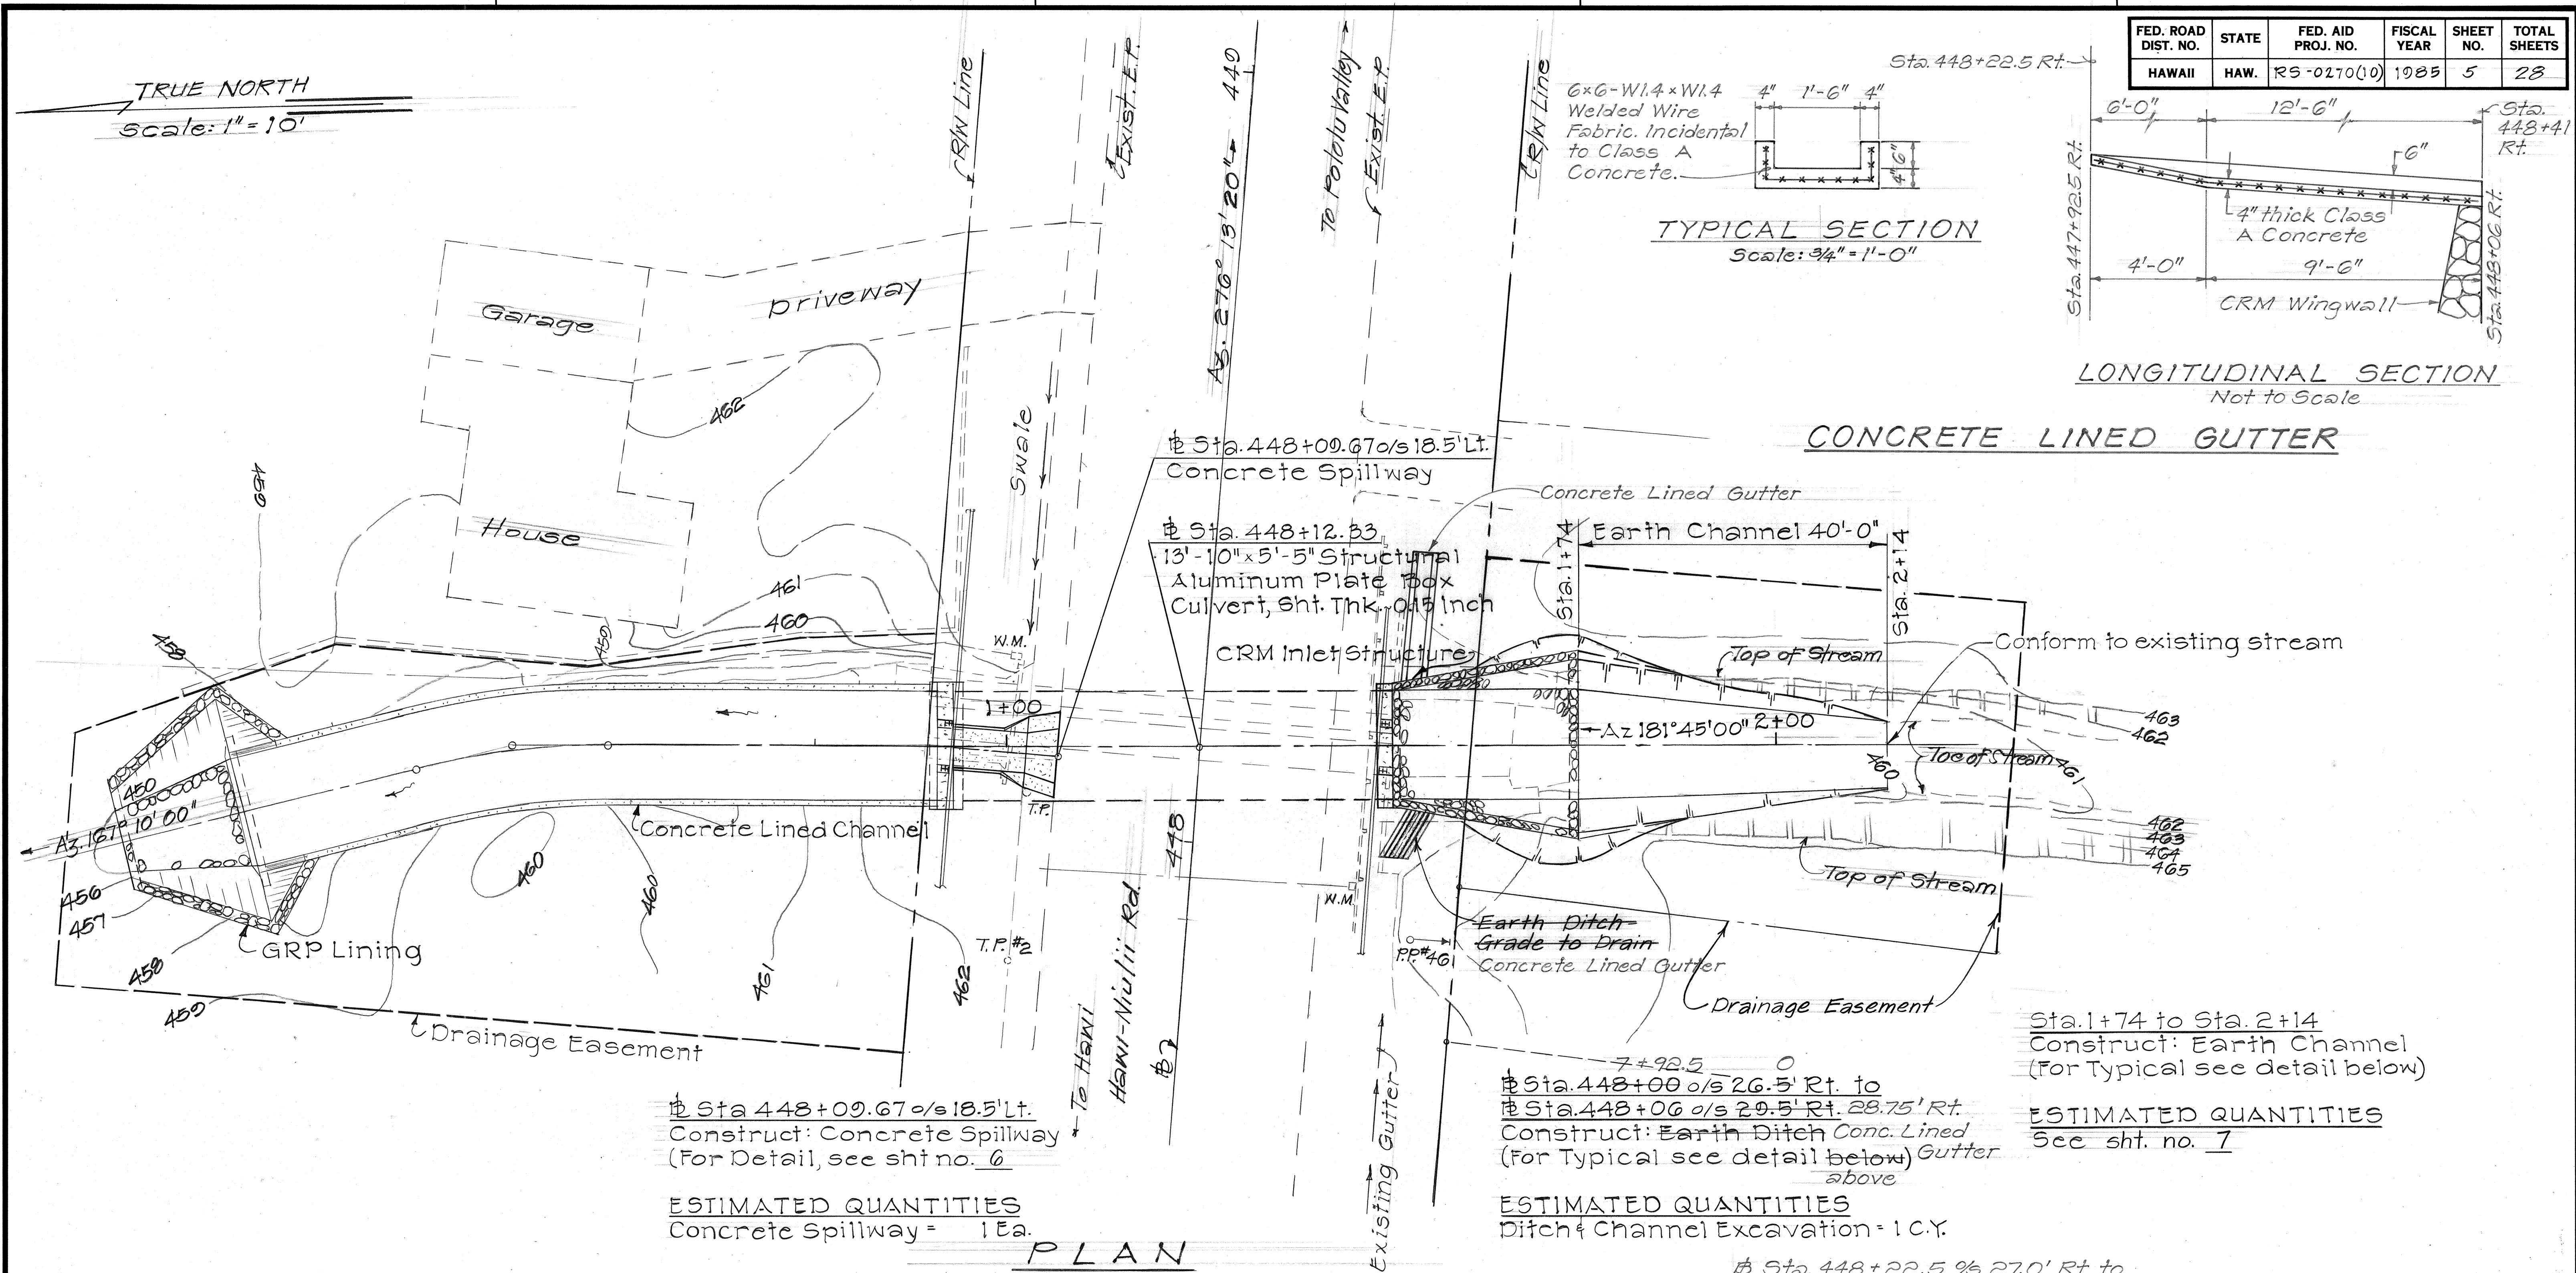

STATE OF HAWAII  
DEPARTMENT OF TRANSPORTATION  
HIGHWAYS DIVISION

**DRAINAGE PLAN**

HAWI-NIULII ROAD  
DRAINAGE IMPROVEMENTS  
VICINITY OF KAPAAU TOWN  
F.A.S. PROJ. NO. RS-0270(10)

SCALE: AS NOTED DATE: JULY, 1984  
SHEET NO. 1 OF 2 SHEETS

|                   |      |
|-------------------|------|
| SURVEY PLOTTED BY | DATE |
| DRAWN BY          |      |
| DESIGNED BY       |      |
| CHECKED BY        |      |
| ORIGINAL PLAN     |      |
| NOTE BOOK         |      |
| NO.               |      |