




FED. ROAD DIST. NO.	STATE	FED. AID PROJ. NO.	FISCAL YEAR	SHEET NO.	TOTAL SHEETS
HAWAII	HAW.	270A-01-87M	1987	3	3

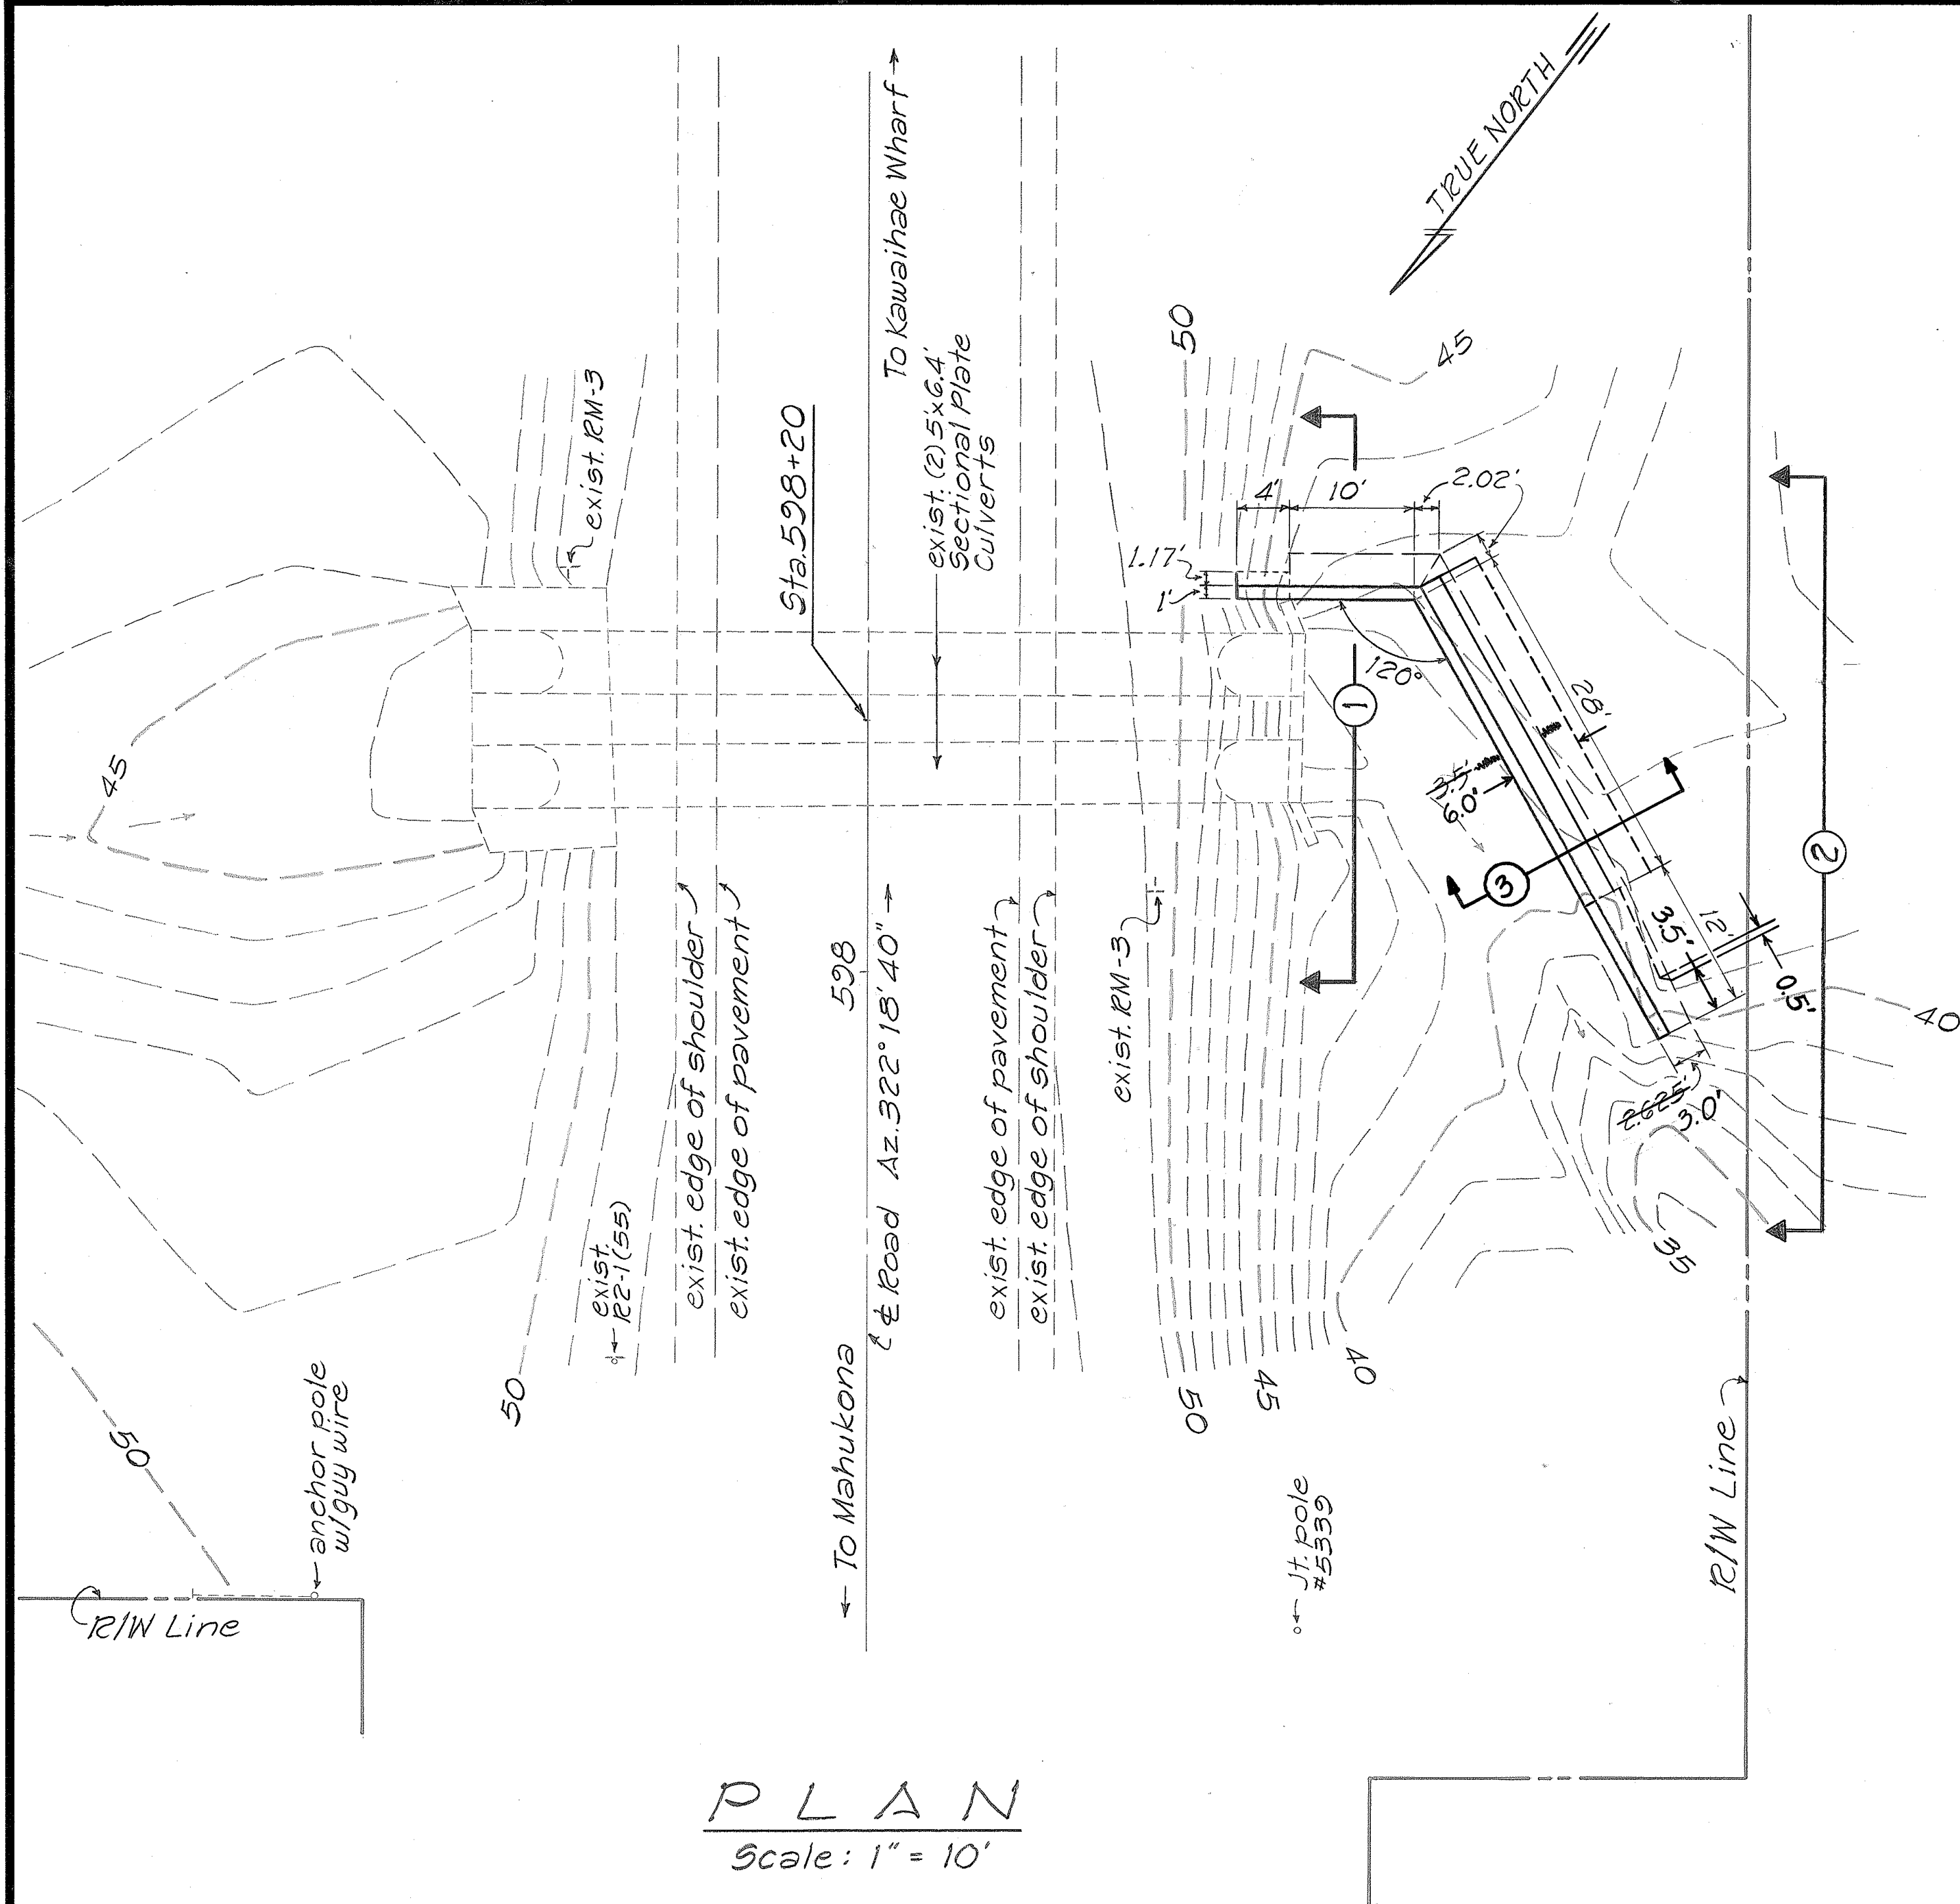


PLAN
Scale: 1" = 10'

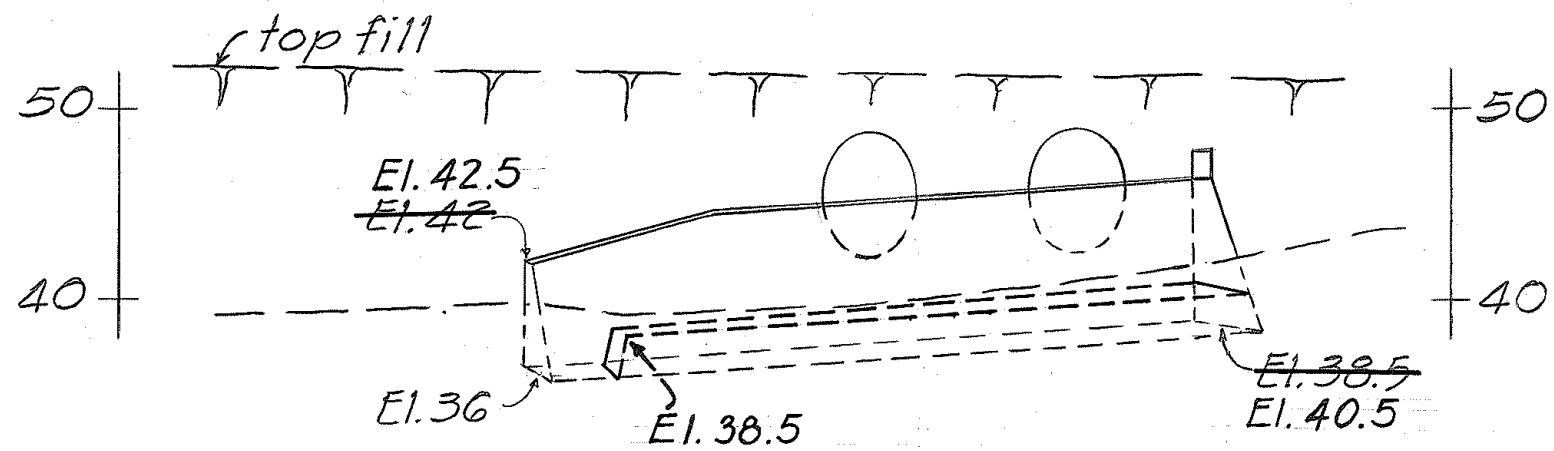

SECTION ②

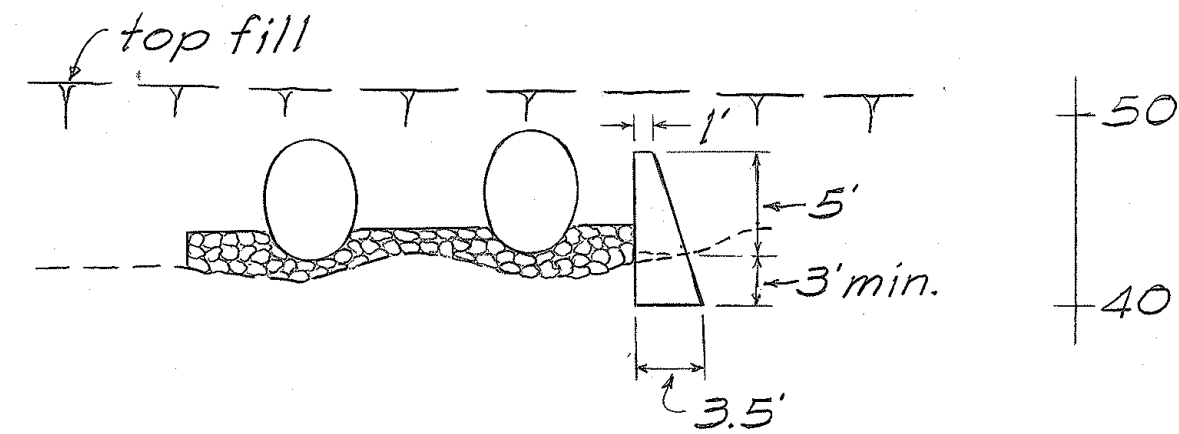


SECTION ①

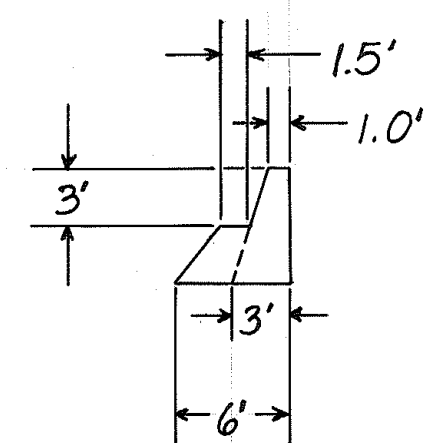

SECTION ③

GENERAL NOTES:

- Improvements consist of construction of CRM Walls.
- All structure and trench backfill shall be considered incidental to Item No. 206.5100 Structure Excavation for CRM Walls.
- All construction signs shall be reflectorized with high intensity reflective sheeting.

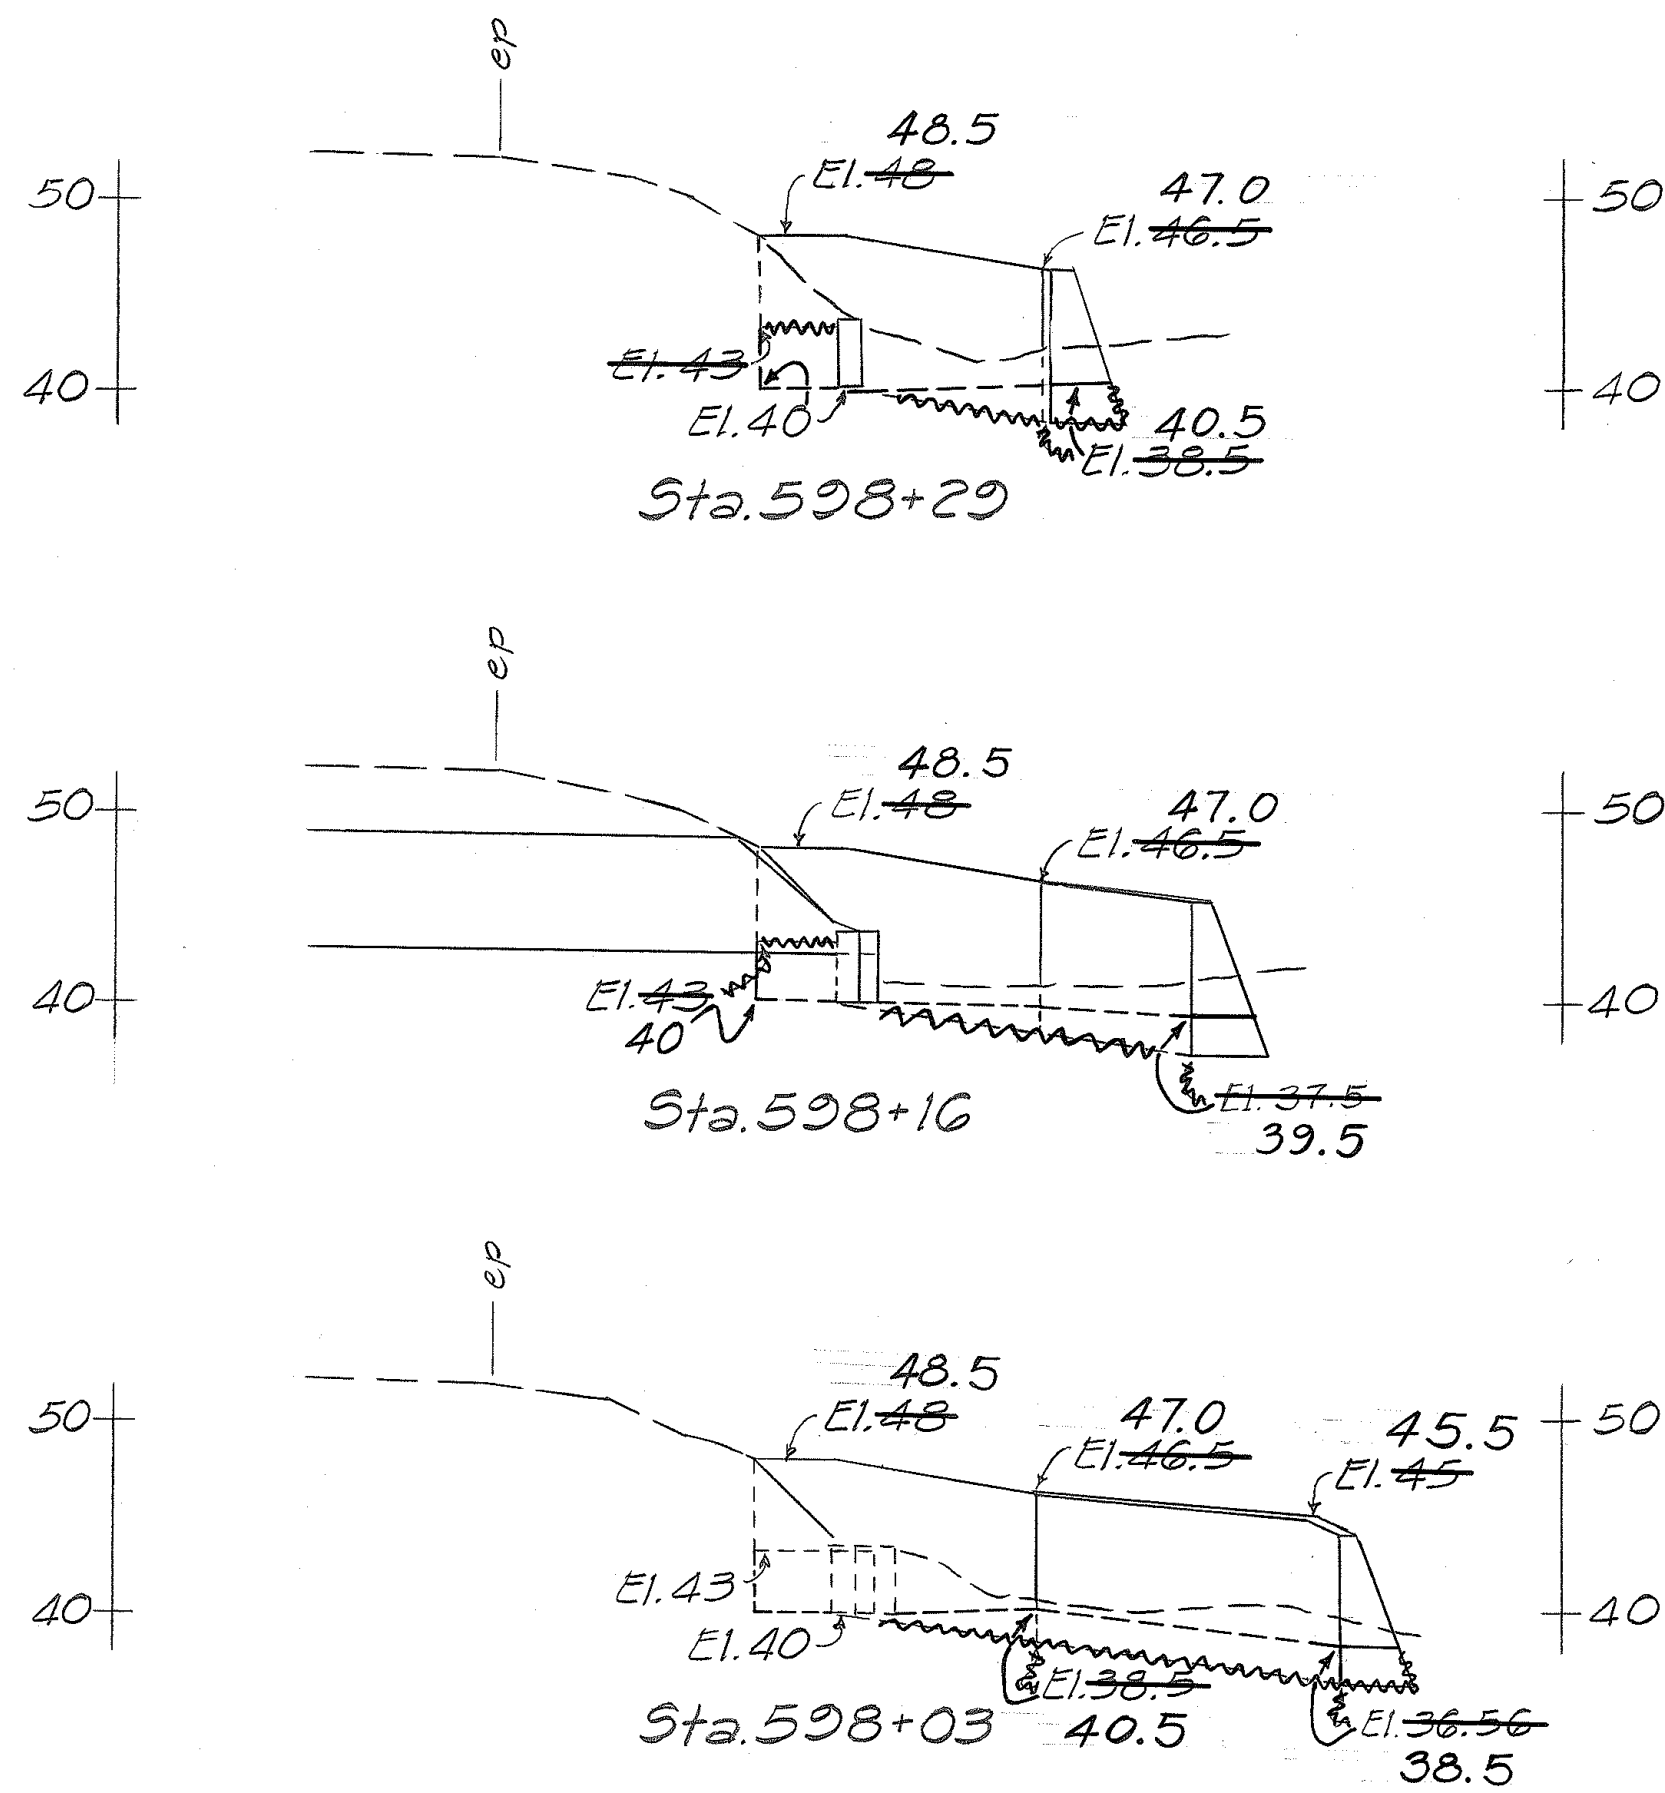

CROSS SECTIONS

CRM ESTIMATED QUANTITIES

Item No.	Quantity
508.0100 CRM Wall	35 C.Y.
206.5100 Structural Exc.	25 C.Y.

STATE OF HAWAII
DEPARTMENT OF TRANSPORTATION
HIGHWAYS DIVISION

**DRAINAGE PLAN &
SECTION DETAILS**

AT STA. 598+20

PROJ. No. 270A-01-87M

Scale: As Noted Date: May 1987

SHEET NO. 1 OF 1 SHEETS