Manager 1 - 2000 p 200 p	
	INDEX TO DRAWINGS
SHEET NO.	DESCRIPTION
	TITLE SHEET
2	STANDARD PLANS SUMMARY
3	PLAN & SECTION DETAILS
`	

MAY, 1987 DATE

548-7537 PHONE

P. S. & E. BY

HAWAII DISTRICT DESIGNED BY STATE OF HAWAII

DEPARTMENT OF TRANSPORTATION

HIGHWAYS DIVISION
"AS-BUILT"
PLANS FOR

CONSTRUCTION OF


AKONI PULE HIGHWAY

DRAINAGE IMPROVEMENT

PROJECT NO. 270A-01-87 M

DISTRICT OF SOUTH KOHALA

ISLAND OF HAWAII

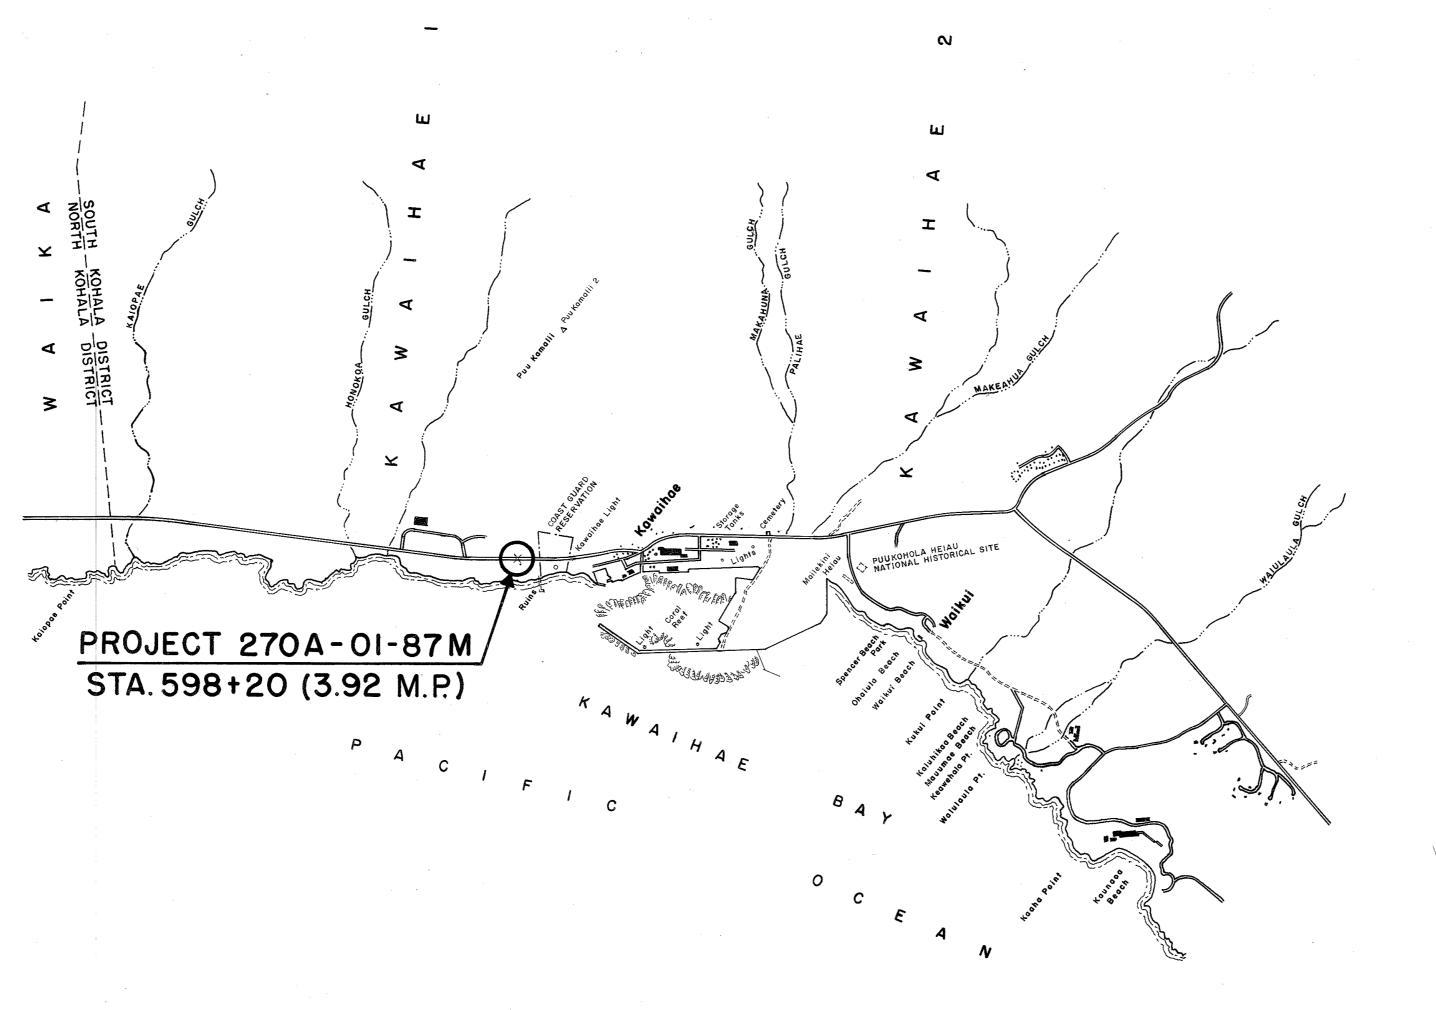

LOCATION OF PROJECT

TOA-OI-87 M

Keenole

NORTH KOHALA

Majorine

Mondator

FED. ROAD DIST. NO.

STATE

PROJ. NO.

270A-01-87M 1987

FISCAL SHEET TOTAL YEAR NO. SHEETS

CHANGES MADE DURING CONSTRUCTION HAVE BEEN INCORPORATED ON THESE PLANS EXCEPT CHANGES IN THE ORIGINAL THEORETICAL QUANTITIES. FOR ACTUAL QUANTITIES, REFER TO PROJECT LEDGER AND/OR COMPUTATION BOOK.

Howard Haymore 9-27-88
RESIDENT ENGINEER DATE

DEPARTMENT OF TRANSPORTATION
STATE OF HAWAII

APPROVED:

JANA DIR. OF TRANSPORTATION
DATE

SCALE: 1"= 2000'