


FED. ROAD DIST. NO.	STATE	FED. AID PROJ. NO.	FISCAL YEAR	SHEET NO.	TOTAL SHEETS
HAWAII	HAW.	RS-STP-0270(III)	1994	11	30

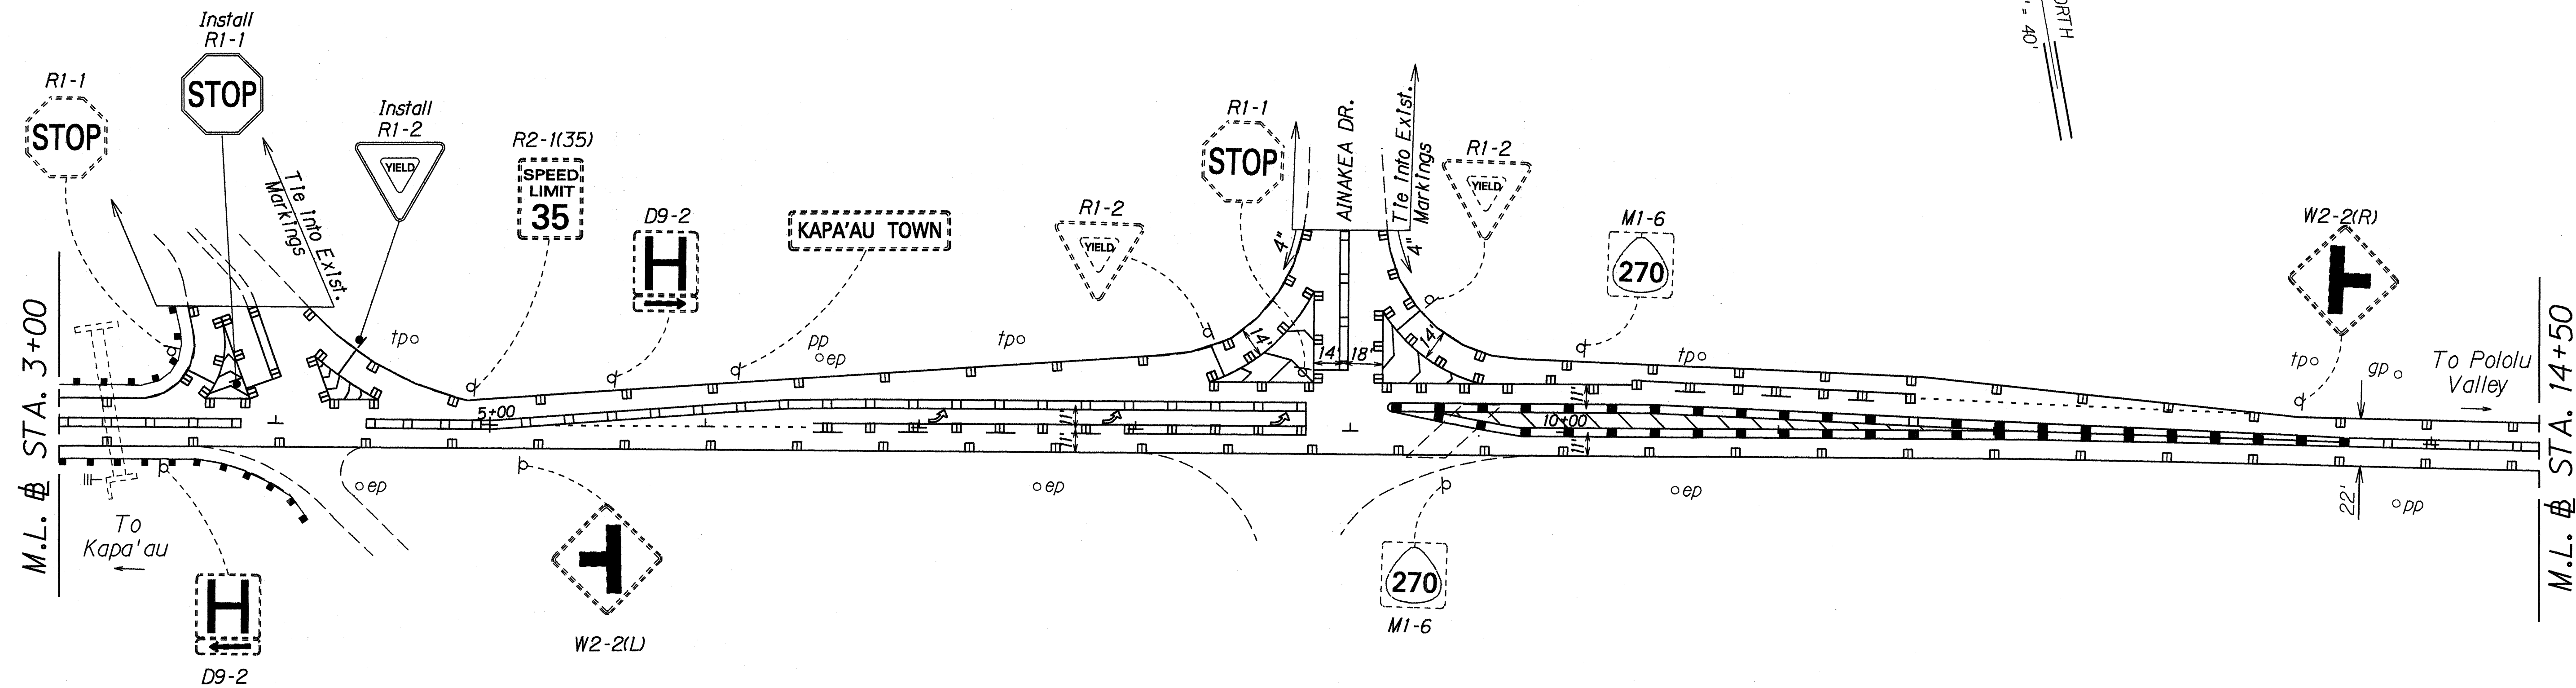

INTERSECTION DETAIL
Scale: 1"=40'

NOTES

1. All signs shown on this sheet to remain, unless otherwise noted .
2. See Legend (Ainakea Dr. Intersection), sheet 12 .

DESIGNED BY	DATE
DRAWN BY	
CHECKED BY	
NOTED BY	
DATE	

STATE OF HAWAII
DEPARTMENT OF TRANSPORTATION
HIGHWAYS DIVISION

AINAKEA DR. INTERSECTION
AKONI PULE HIGHWAY RESURFACING
KOKOIKE TO AINAKEA SUBDIVISION
F.A. PROJECT NO. RS-STP-0270(III)
Scale: 1"=40' Date: August, 1994

SHEET No. 1 OF 1 SHEETS