

INDEX TO DRAWINGS	
SHEET NO.	DESCRIPTION
1	TITLE SHEET
2	STANDARD PLAN SUMMARY
3	GENERAL NOTES AND ABBREVIATIONS
4	TYPICAL SECTIONS AND DETAILS
5-20	ROADWAY, STRIPING AND SIGN PLANS
21	PAV'T MARKING LEGEND, DTL & NOTES
22	CONSTRUCTION SIGN PLAN & SCHEDULE
23, 24	SIGN SCHEDULE, PAVEMENT MARKING SUMMARY
25-27	REFLECTOR AND OBJECT MARKER SCHEDULE
28	MILE POST, MARKER, VALVE BOX AND C.L. REF. MONUMENT SCHEDULES

STATE OF HAWAII

DEPARTMENT OF TRANSPORTATION

HIGHWAYS DIVISION

HONOLULU, HAWAII

"AS-BUILT"

PLANS FOR


AKONI PULE HIGHWAY RESURFACING

MILE POST 6.90 TO MILE POST 3.43

PROJECT NO. 270A-01-96M


DISTRICTS OF NORTH KOHALA/SOUTH KOHALA

ISLAND OF HAWAII

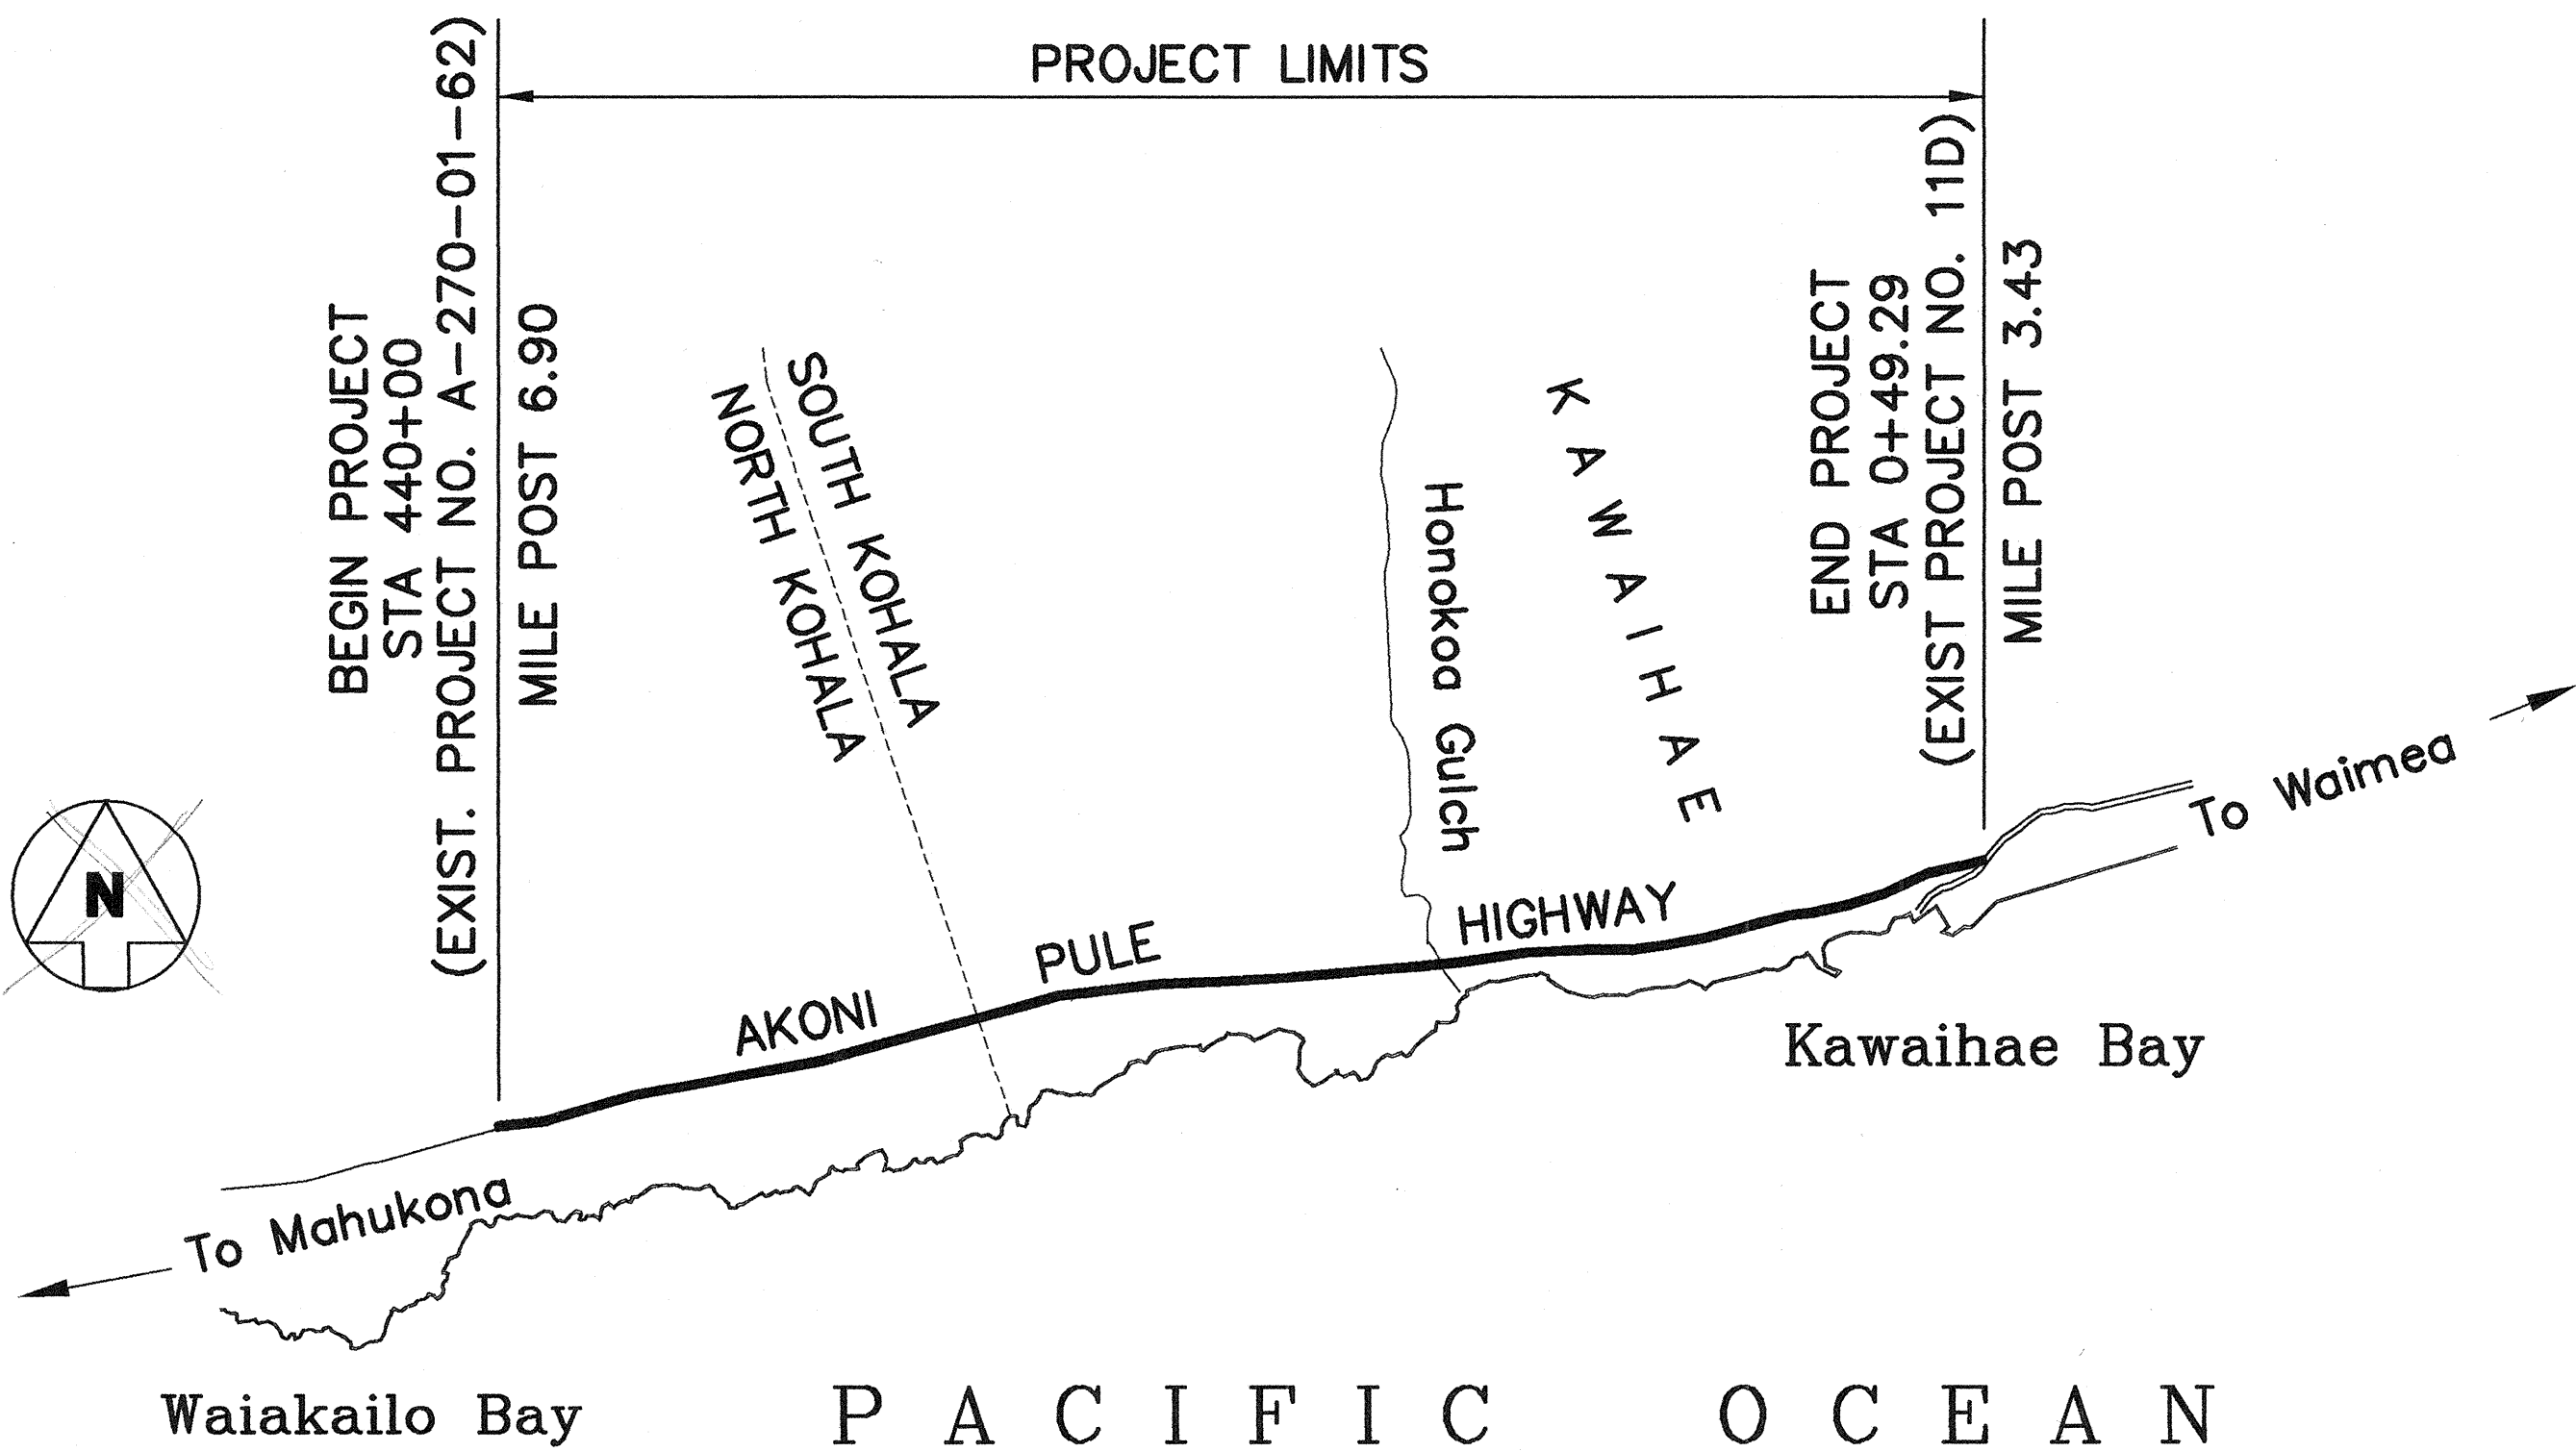


LOCATION PLAN


SCALE: 1"=2000'

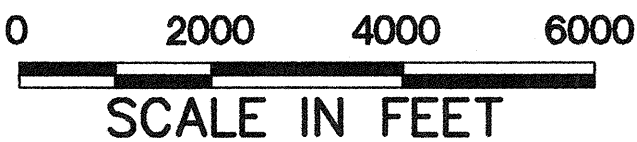

FED. ROAD DIST. NO.	STATE	PROJ. NO.	FISCAL YEAR	SHEET NO.	TOTAL SHEETS
HAWAII	HAW.	270A-01-96M	1996	1	28

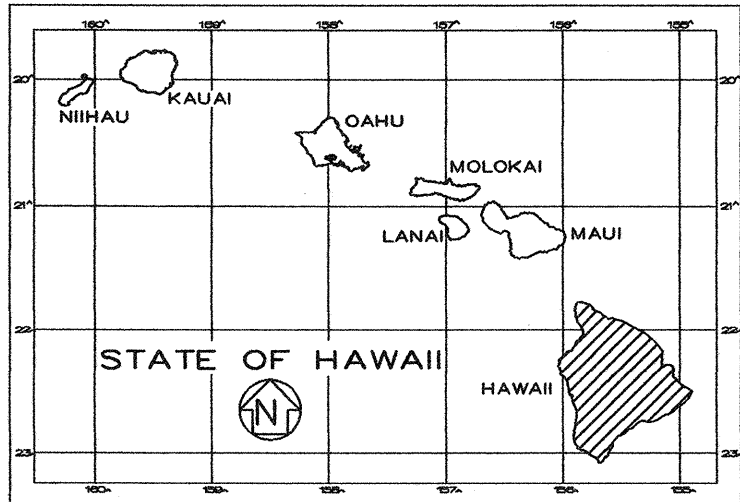

LOCATION OF PROJECT

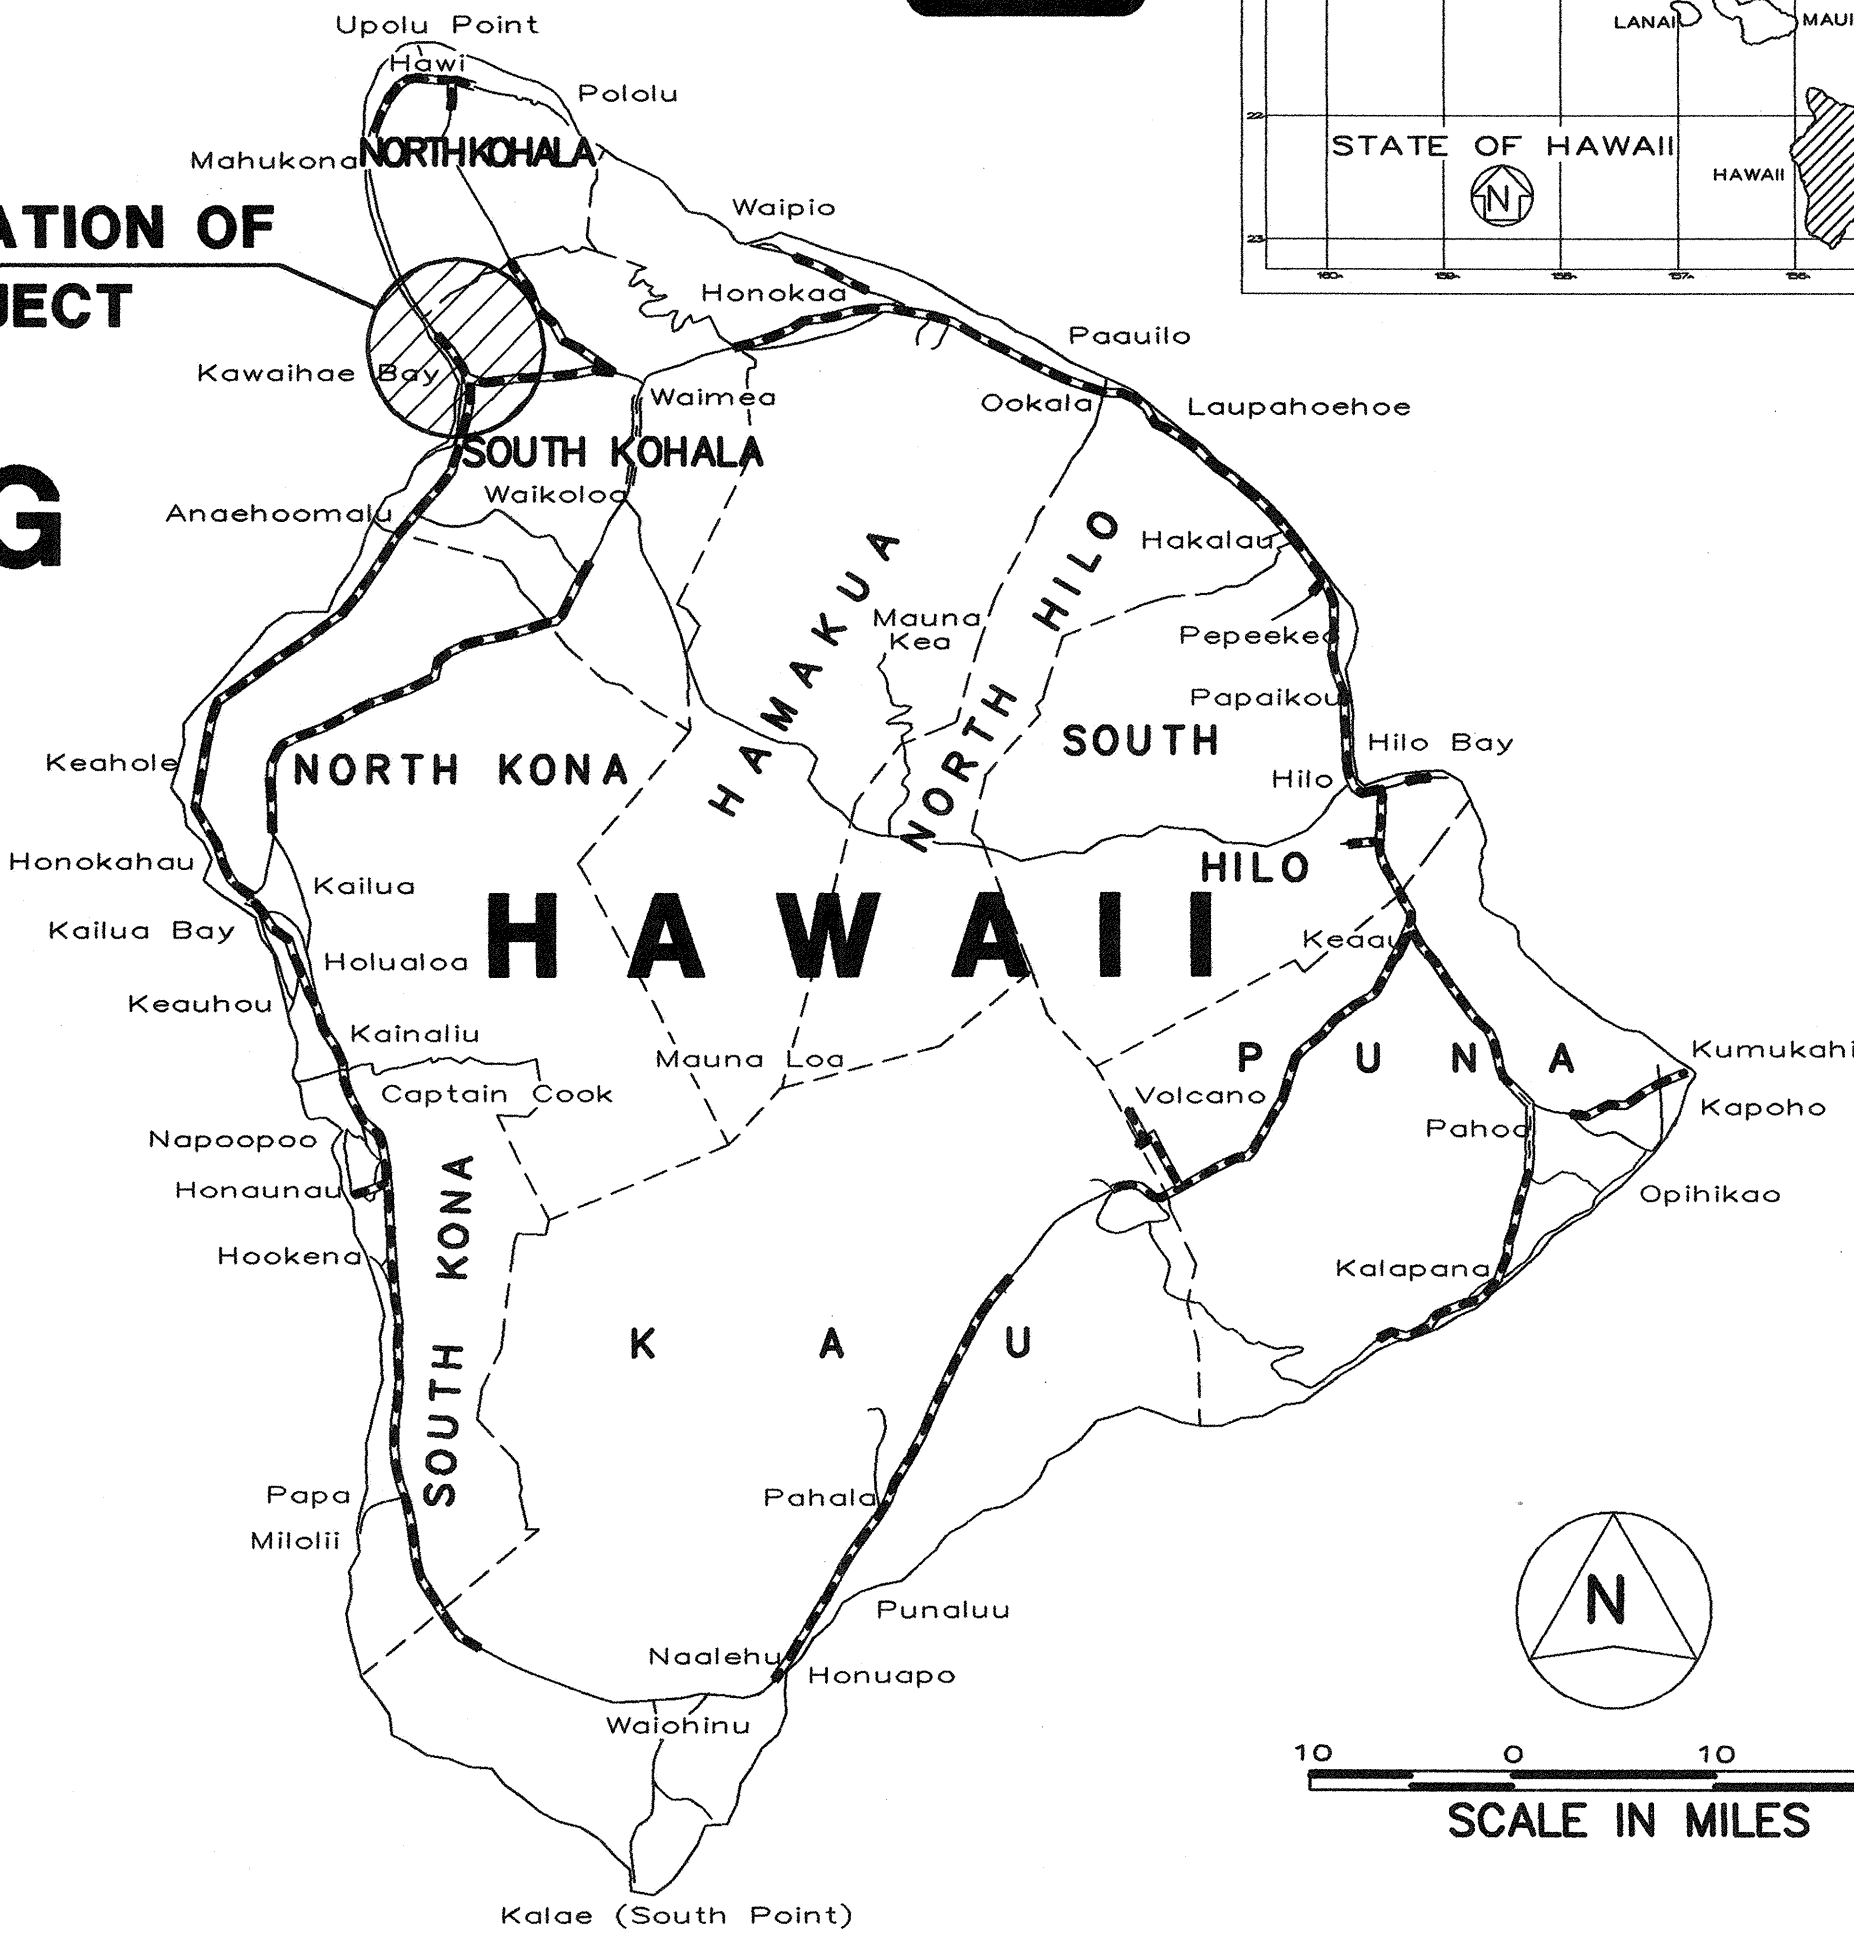

FEDERAL AID PROJECTS PREVIOUSLY CONSTRUCTED OR UNDER CONSTRUCTION

MILE POST 6.90 TO MILE POST 3.43

CHANGES MADE DURING CONSTRUCTION HAVE BEEN INCORPORATED ON THESE PLANS EXCEPT CHANGES TO THE GENERAL TECHNICAL SPECIFICATIONS FOR ROAD CONSTRUCTION WHICH TO PREVENT CLASHES

6/20/96

DEPARTMENT OF TRANSPORTATION STATE OF HAWAII	
APPROVED: <i>[Signature]</i>	5/28/96
DIR. OF TRANSPORTATION	DATE

BARRETT CONSULTING

DESIGNED BY

R. TAIRA

P. S. & E. BY

933-4640

PHONE

MAY 1996

DATE