


STRIPING AND PAVEMENT MARKING SCHEDULE

STATION	TRAFFIC REGIME		THERMOPLASTIC OR TAPE TYPE () (LINEAR FEET)															PAVEMENT MARKERS (Each)				
			629J020		629J011			629J012	629J013					629J017					6292010 A	6292030 C	6292040 D	6292050 H
	4" DOUBLE YELLOW (I)	4" DBL. YELLOW GUIDELINES (I)	4" YELLOW C.L. (I)	12" YELLOW DIAGONAL (II)	4" WHITE STRIPE (I)	4" WHITE E.P. (II)	8" WHITE STRIPE (I)	8" WHITE STRIPE (II)	12" WHITE DIAGONAL (II)	4" WHITE EDGE LINE EXTENSION (III)	4" WHITE GUIDE LINES (III)	12" STOP BAR (III)	SOLID WHITE ARROW			SOLID WHITE WORDS (III)						
													RT. (III)	ST. (III)	LT. (III)							
7+10	P	NP			290			580											14	7	7	28
10+00																						
OPEN																						
10+70																						
15+62	NP	P			492			984											24	12	12	48
36+54	P	P						4,184											104	52		208
41+40	P	P							972										24	12		48
51+00	P	NP			960				1,920										48	24	24	96
52+38	NP	NP	138						276										7	7		
54+90	NP	NP	252					504											13	13		
OPEN																						
55+36																						
62+15	NP	NP	679					1,358											34	34		
80+65																						
82+56	NP	NP	191					382											10	10		
88+45	P	NP			589			1,178											30	15	15	60
89+35	NP	NP	90					180											5	5		
INTERSECTIONS			154											174					7	10		
TOTALS			1,504		2,331			9,350	3,168					174					320	201	58	488

DESIGNED BY	DATE
DRAWN BY	
NOTED BY	
CHECKED BY	
ORIGINAL PLAN	
NOTE BOOK	
QUANTITIES BY	
CHECKED BY	

1\kawasch3.dgn

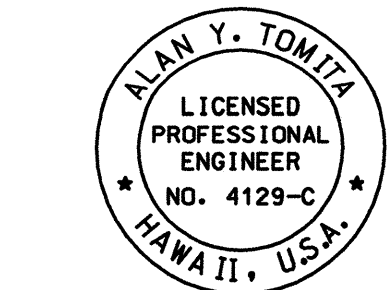

THIS WORK WAS PREPARED BY ME OR UNDER MY SUPERVISION.

Alan Y. Tomita

STATE OF HAWAII
DEPARTMENT OF TRANSPORTATION
HIGHWAYS DIVISION
STRIPING AND PAVEMENT MARKING SCHEDULE
KAWAIHAE ROAD RESURFACING
Vicinity of Kawaihae Harbor to Queen Kaahumanu Hwy.
Project No. 270A-01-99M
Scale: None Date: September, 1999
SHEET No. 1 OF 1 SHEETS