

Date Saved: Thu, 11 May 2006 - 10:18am
File Location: S:\020222-00\STRUCT\final\WAY 6-ADDITION S-01.dwg

| | | |
|------------------------|-------------------------|-------------------|
| ORIGINAL PLAN | SURVEY PLOTTED BY _____ | DATE _____ |
| NOTE BOOK No. _____ | DRAWN BY _____ | DESIGNED BY _____ |
| | DESIGNED BY _____ | CHECKED BY _____ |
| | QUANTITIES BY _____ | CHECKED BY _____ |

GENERAL:

- FOR WALAOHIA BRIDGE, THE EXISTING INFORMATION SHOWN IN THESE DRAWINGS WERE OBTAINED FROM THE ORIGINAL BRIDGE DRAWINGS DATED NOVEMBER 1918 AND ARE PRESENTED FOR REFERENCE PURPOSES ONLY. NO RESPONSIBILITY IS ASSUMED FOR THE ACCURACY OF THE EXISTING INFORMATION PRESENTED. IT IS THE CONTRACTOR'S RESPONSIBILITY TO VERIFY INDEPENDENTLY ALL OF THE AS-BUILT INFORMATION.
- FOR AAMAKOA BRIDGE, NO DRAWING OF ORIGINAL CONSTRUCTION IS AVAILABLE. INFORMATION FOR REINFORCING IN SUPERSTRUCTURE WAS OBTAINED FROM WALAOHIA BRIDGE ORIGINAL DRAWINGS. INFORMATION FOR REINFORCING IN FRONT FACE OF ABUTMENTS WERE OBTAINED BY SOUNDING AND PROBING. NO RESPONSIBILITY IS ASSUMED FOR THE ACCURACY OF THE EXISTING INFORMATION PRESENTED. IT IS THE CONTRACTOR'S RESPONSIBILITY TO VERIFY INDEPENDENTLY ALL OF THE AS-BUILT INFORMATION.
- THE CONTRACTOR SHALL VISIT THE CONSTRUCTION SITE AND SHALL VERIFY ALL DIMENSIONS AND CONDITIONS PRIOR TO STARTING ANY WORK AND SHALL BE RESPONSIBLE FOR COORDINATION OF ALL WORK AND MATERIALS INCLUDING THOSE FURNISHED BY SUB-CONTRACTORS. THE HAWAII DEPARTMENT OF TRANSPORTATION (D.O.T.) REPRESENTATIVE SHALL BE NOTIFIED IMMEDIATELY OF ANY DISCREPANCIES FOUND.
- THE CONTRACT STRUCTURAL DRAWINGS AND SPECIFICATIONS REPRESENT THE FINISHED STRUCTURE. THEY DO NOT INDICATE THE METHOD OF CONSTRUCTION. THE CONTRACTOR SHALL PROVIDE ALL MEASURES NECESSARY TO PROTECT THE STRUCTURE DURING CONSTRUCTION.
- THE CONTRACTOR SHALL PROVIDE ADEQUATE BRACING FOR EXCAVATIONS AND SHORING FOR ALL EXISTING ADJACENT STRUCTURES AND ROADWAYS. BRACING FOR EXCAVATIONS AND SHORING FOR CONSTRUCTION LOADS SHALL BE DESIGNED BY A HAWAII LICENSED CIVIL OR STRUCTURAL ENGINEER EXPERIENCED IN THIS KIND OF WORK.

BASIS FOR SEISMIC RETROFIT:

- THE INTENT OF THE PROJECT IS TO RETROFIT THE STRUCTURES TO PREVENT COLLAPSE DUE TO A SEISMIC EVENT WITH A MAXIMUM BEDROCK ACCELERATION COEFFICIENT OF 0.35g
- WALAOHIA BRIDGE
 - TWO 5'-0" DIAMETER DRILLED SHAFTS ARE PROVIDED BEHIND EACH ABUTMENT FOR CONSIDERATIONS OF SLOPE STABILITY OF THE SOIL AND TO PROVIDE REQUIRED LONGITUDINAL AND TRANSVERSE RESISTANCE DURING AN EARTHQUAKE.
 - THE DRILLED SHAFTS ARE ALSO USED FOR CONNECTING CONCRETE ARMS TO JACK UP AND UNDERPIN THE ABUTMENTS TO RELIEVE SOIL BEARING PRESSURE UNDER ABUTMENTS.
 - STAINLESS STEEL PLATES WITH STAINLESS STEEL EPOXY ANCHORS ARE PROVIDED ON THE OUTSIDE FACES OF THE EXTERIOR GIRDERS AT THE EXISTING EXPANSION JOINT OVER BENT 'B'. A PORTION OF THE EXISTING EXPANSION JOINT IS GROUT PACKED. THE PURPOSED IS TO PROVIDE CONTINUITY OF THE SUPERSTRUCTURE DURING AN EARTHQUAKE AND TO RESIST FLEXURAL BENDING DUE TO LATERAL SEISMIC MOVEMENT.
 - THE THREE TRANSVERSE LINK BEAMS AT BENTS 'A', 'B', AND 'C' ARE WRAPPED WITH FIBER REINFORCED COMPOSITE (FRC)- SYSTEM TO INCREASE THEIR SHEAR CAPACITIES. SIMILARLY, THE TOP OF COLUMNS AT BENTS 'A' AND 'C' ARE WRAPPED WITH FRC SYSTEMS TO INCREASE THEIR DISPLACEMENT CAPACITIES.
- AAMAKAO BRIDGE
 - THE THRUST BEAM AT THE FRONT FACE OF EACH ABUTMENT IS PROVIDED TO TRANSFER COMPRESSIVE LONGITUDINAL LOADS FROM THE SUPERSTRUCTURE TO THE EARTH BEHIND THE ABUTMENT.
 - THE DOWELS AND CREEP BLOCKS AT THE PIER ARE PROVIDED TO ANCHOR THE PIER TOP TO PREVENT PIER COLLAPSE.

DRILLED SHAFT CONSTRUCTION:


- THE DRILLED SHAFT CONTRACTOR SHALL HAVE THE APPROPRIATE EQUIPMENT AND TOOLS TO DRILL THROUGH BOULDERS AND MEDIUM HARD TO HARD BASALT ROCK. APPROPRIATE MEASURES SHALL BE TAKEN TO AVOID DISLODGING BOULDERS INTO THE DRILLED SHAFT HOLE DURING THE DRILLING AND DRILLED SHAFT INSTALLATION PROCESS.
- THE CONTRACTOR SHALL SUBMIT INSTALLATION PLAN TO THE ENGINEER FOR REVIEW AT LEAST ONE MONTH PRIOR TO CONSTRUCTION.
- TEMPORARY CASING MAY BE NEEDED TO REDUCE THE POTENTIAL FOR CAVING IN OF THE SOIL MATERIAL IN THE HOLES DURING THE DRILLING OPERATION DUE TO POSSIBLE PERCHED GROUND WATER ZONES.
- A REPRESENTATIVE OF THE SOILS ENGINEER CONSULTANT SHALL BE PRESENT AT THE SITE TO OBSERVE THE DRILLING AND INSTALLATION OF DRILLED SHAFTS OPERATION DURING CONSTRUCTION.
- CONCRETE PLACEMENT BY TREMIE METHODS SHALL BE USED DURING CONSTRUCTION OF THE DRILLED SHAFTS WHENEVER GROUND WATER IS PRESENT IN THE DRILLED HOLES. THE CONCRETE SHALL BE PLACED PROMPTLY AFTER THE COMPLETION OF DRILLING (WITHIN 18 HOURS) TO REDUCE THE POTENTIAL FOR CAVING IN OF THE SIDE WALLS.
- THE CONCRETE SHALL BE PLACED IN A SUITABLE MANNER TO REDUCE SEGREGATION OF THE AGGREGATES.

GENERAL NOTES:


- GENERAL SPECIFICATIONS: HAWAII DEPARTMENT OF TRANSPORTATION STANDARD SPECIFICATION FOR ROAD, BRIDGE AND PUBLIC CONSTRUCTION, 1994, TOGETHER WITH SPECIAL PROVISIONS PREPARED FOR THIS CONTRACT.
- DESIGN SPECIFICATIONS: AASHTO LRFD BRIDGE DESIGN SPECIFICATIONS, 3RD EDITION WITH APPROPRIATE INTERIMS.
- CALTRANS MEMO TO DESIGNERS 20-4, OCTOBER 1995.
- GEOTECHNICAL ENGINEERING EXPLORATION, SEISMIC RETROFIT OF AKONI PULE HIGHWAY, WALAOHIA BRIDGE AND AAMAKOA BRIDGE, OCTOBER 16, 2003 BY GEOLABS, INC.
- SEISMIC LOADING:
 - SEISMIC PERFORMANCE CATEGORY D
 - ACCELERATION COEFFICIENT 0.35g
- CONCRETE CLASSES:
 - EXISTING
 - COLUMN, BENT CAP BEAMS (ASSUMED) $f'_c = 3,300$ PSI
 - FOOTING (ASSUMED) $f'_c = 3,300$ PSI
 - NEW
 - CONCRETE DRILLED SHAFTS $f'_c = 4,000$ PSI
 - CONCRETE ARMS AND BEAMS $f'_c = 4,000$ PSI
 - CONCRETE GIRDER EXTENSION..... $f'_c = 4,000$ PSI
 - CONCRETE THRUST BEAMS $f'_c = 4,000$ PSI
 - CONCRETE CREEP BLOCKS $f'_c = 4,000$ PSI
- DESIGN SLUMP OF CONCRETE SHALL BE AS FOLLOWS:
 - DRILLED SHAFTS- AS CALLED FOR IN SHT. S-7 "DRILLED SHAFT NOTES."
 - ARMS, BEAMS, GIRDER EXTENSION - WALAOHIA BRIDGE - 7"± 1"
 - THRUST BEAMS, CREEP BLOCKS - AAMAKAO BRIDGE - 8"± 1"
- REINFORCING STEEL:
 - EXISTING
 - COLUMN, MAIN REINF. AND DOWELS (ASSUMED)..... $f_y = 33,000$ PSI
 - ALL OTHER (ASSUMED) $f_y = 33,000$ PSI
 - NEW
 - ALL BARS, DOWELS AND STIRRUPS $f_y = 60,000$ PSI
 - WELDED BARS (ASTM A706)..... $f_y = 60,000$ PSI
- STRUCTURAL STEEL:
 - STAINLESS STEEL PLATES TYPE 316 $F_y = 36,000$ PSI
 - GALVANIZED STEEL PLATE ASTM A36 $F_y = 36,000$ PSI
- EPOXY ANCHOR - STAINLESS STEEL AISI 316 S.S.
- DRILLING OF ANCHORS, BARS AND BOLTS: LOCATE EXISTING REINFORCING AND AVOID THEM. HOLES IN STRAPS AND PLATES SHALL BE DRILLED AFTER EXISTING REINFORCEMENT ARE LOCATED. WHEN EXISTING BARS ARE ENCOUNTERED WHILE DRILLING, RELOCATE HOLES. DO NOT DAMAGE EXISTING BARS. FILL ABANDONED HOLES WITH DRY PACK POLYMER MODIFIED MORTAR. PAYMENT FOR LOCATING, RELOCATING AND REPAIRING SHALL BE INCIDENTAL TO THE WORK.
- CRANE LOADS:

BASED ON AVAILABLE DRAWINGS OF ORIGINAL CONSTRUCTION, THE WALAOHIA BRIDGE SHOULD BE CAPABLE OF SUPPORTING THE FOLLOWING LOADS, PROVIDED THEY TRAVEL SLOWLY ON THE BRIDGE.

 - HS 20 TRUCK.
 - 85,000 Lbs. WEIGHT DRILL RIG ON CRAWLERS, SPACED AS SHOWN.

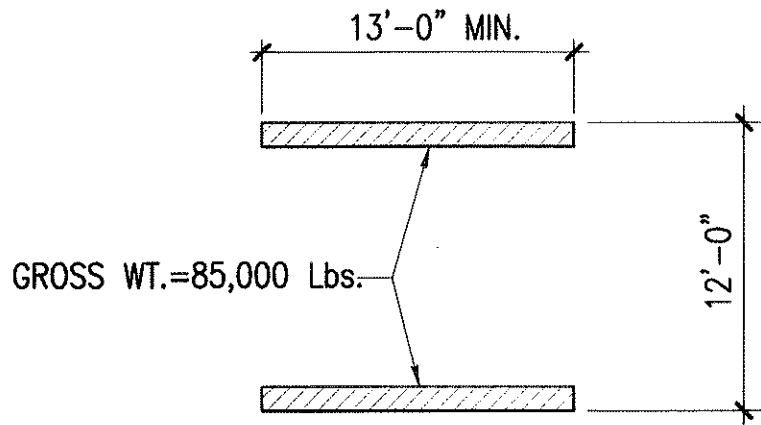

THE CONTRACTOR SHALL OBTAIN PRIOR PERMIT FROM STATE DOT IN CASE THE CRANE LOAD EXCEEDS THE LEGAL LOAD CAPACITY OF THE BRIDGES ON WAY TO WALAOHIA BRIDGE.

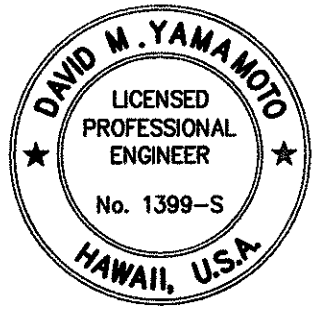

David M. Yamamoto
THIS WORK WAS PREPARED BY
ME OR UNDER MY SUPERVISION
APRIL 30, 2008
EXPIRATION DATE OF LICENSE

| FED. ROAD DIST. NO. | STATE | FED. AID PROJ. NO. | FISCAL YEAR | SHEET NO. | TOTAL SHEETS |
|------------------------|-------|-----------------------|----------------|--------------|-----------------|
| HAWAII | HAW. | BR-0270(18) | 2006 | 20 | 31 |

STATE OF HAWAII
DEPARTMENT OF TRANSPORTATION
HIGHWAYS DIVISION


GENERAL BRIDGE RETROFIT NOTES
DRILLED SHAFT CONSTRUCTION NOTES

AKONI PULE HIGHWAY, SEISMIC RETROFIT
OF WALAOHIA AND AAMAKAO BRIDGES;
FAIP NO. BR-0270(18)

SCALE: AS NOTED DATE: May 2006


SHEET No. **S - 1** OF 12 SHEETS

| FED. ROAD DIST. NO. | STATE | FED. AID PROJ. NO. | FISCAL YEAR | SHEET NO. | TOTAL SHEETS |
|---------------------|-------|--------------------|-------------|-----------|--------------|
| HAWAII | HAW. | BR-0270(18) | 2006 | 21 | 31 |

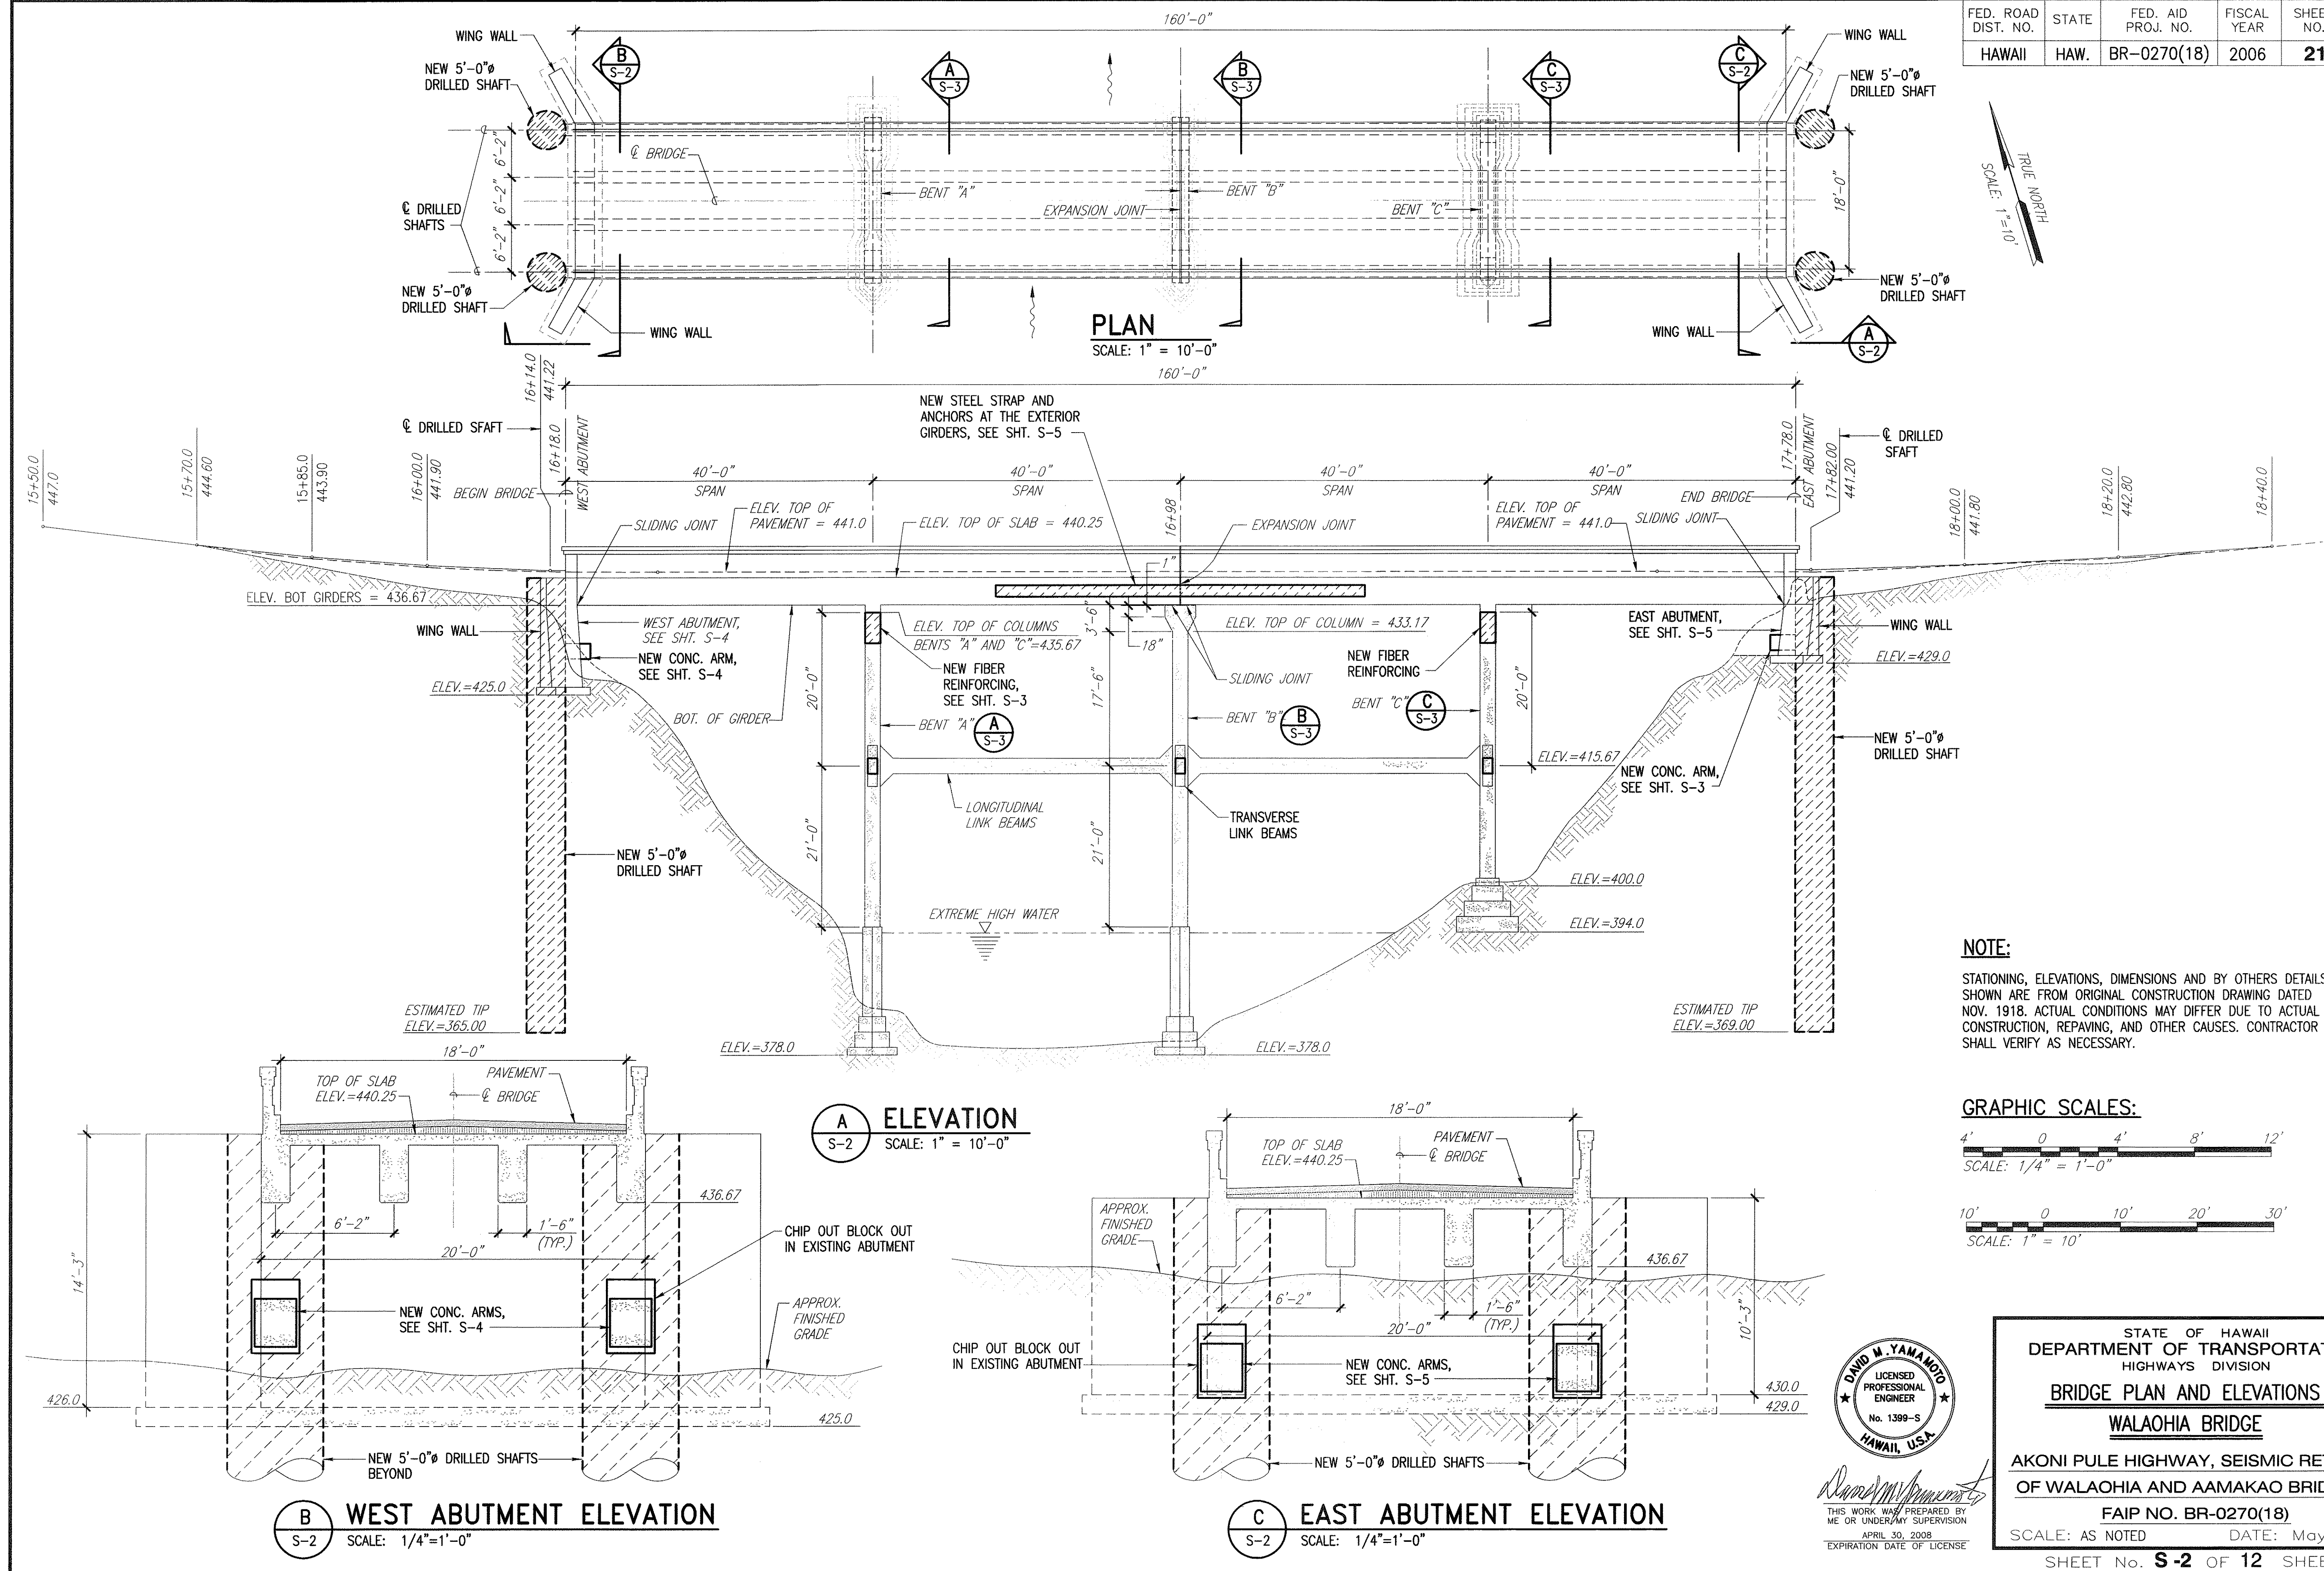


| | |
|--|--|
| DATE: Thu, 11 May 2006 - 9:57am File Location: S:\02022-00\STRUCT\final\MAY 6-ADDITION\S-02.dwg | SURVEY PLOTTED BY: _____ DATE: _____ |
| DESIGNED BY: _____ CHECKED BY: _____ | DESIGNED BY: _____ CHECKED BY: _____ |
| NOTE BOOK QUANTITIES BY: _____ No. _____ | NOTE BOOK QUANTITIES BY: _____ No. _____ |


| FED. ROAD DIST. NO. | STATE | FED. AID PROJ. NO. | FISCAL YEAR | SHEET NO. | TOTAL SHEETS |
|---------------------|-------|--------------------|-------------|-----------|--------------|
| HAWAII | HAW. | BR-0270(18) | 2006 | 22 | 31 |

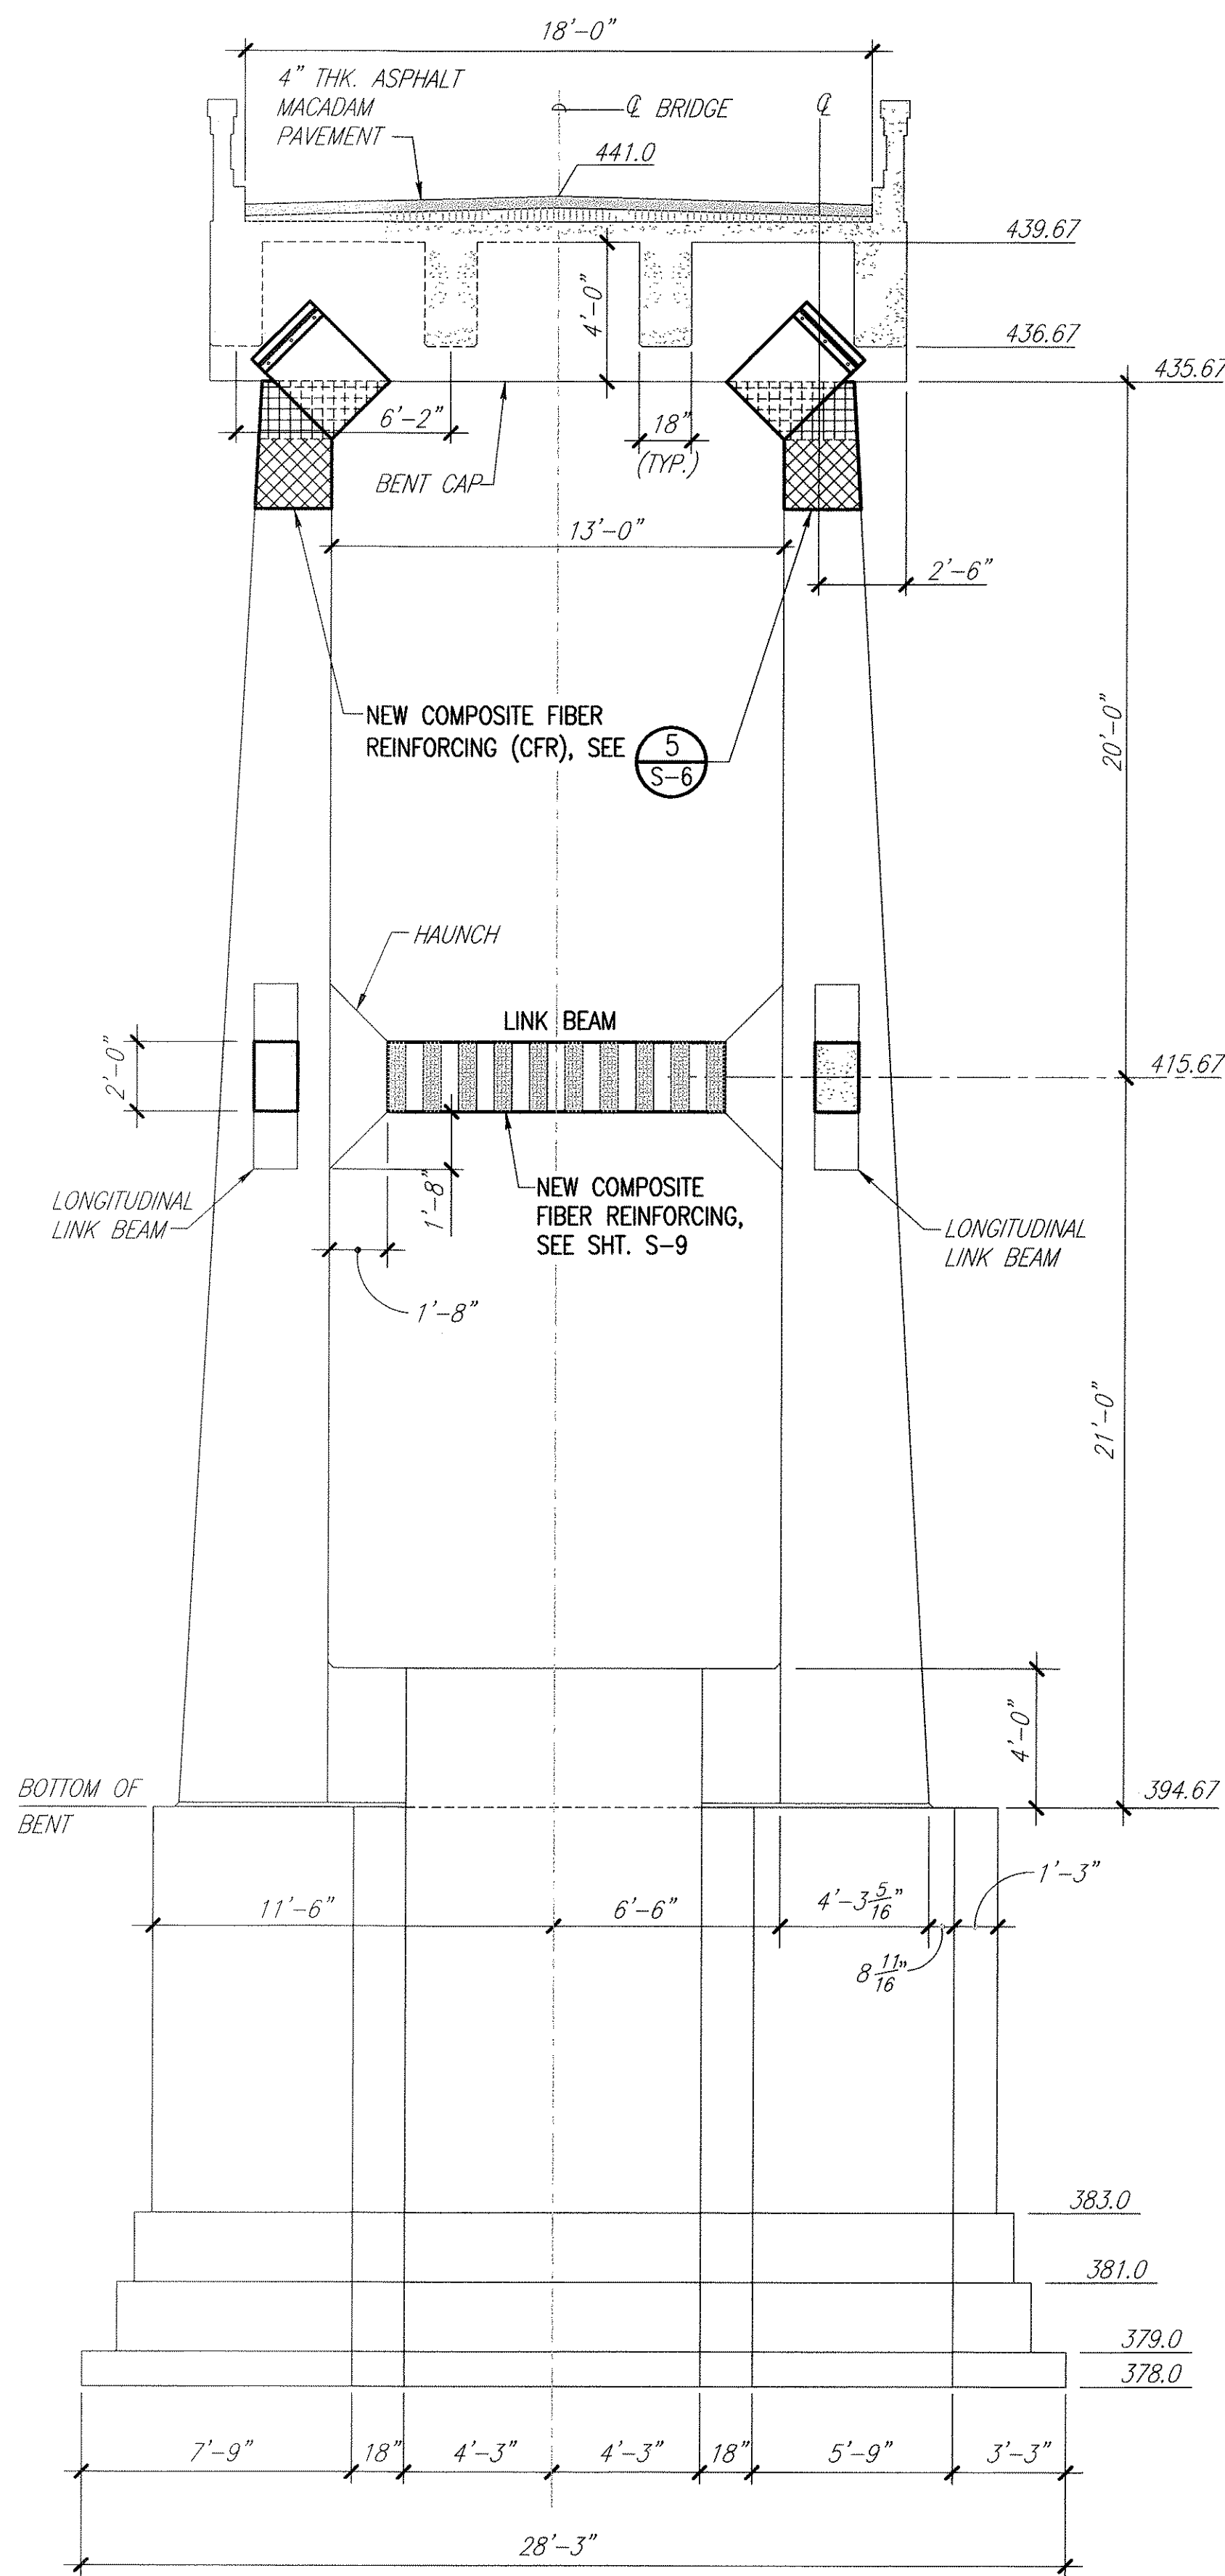

A BENT "A" ELEVATION
S-3 SCALE: 1/4"=1'-0"


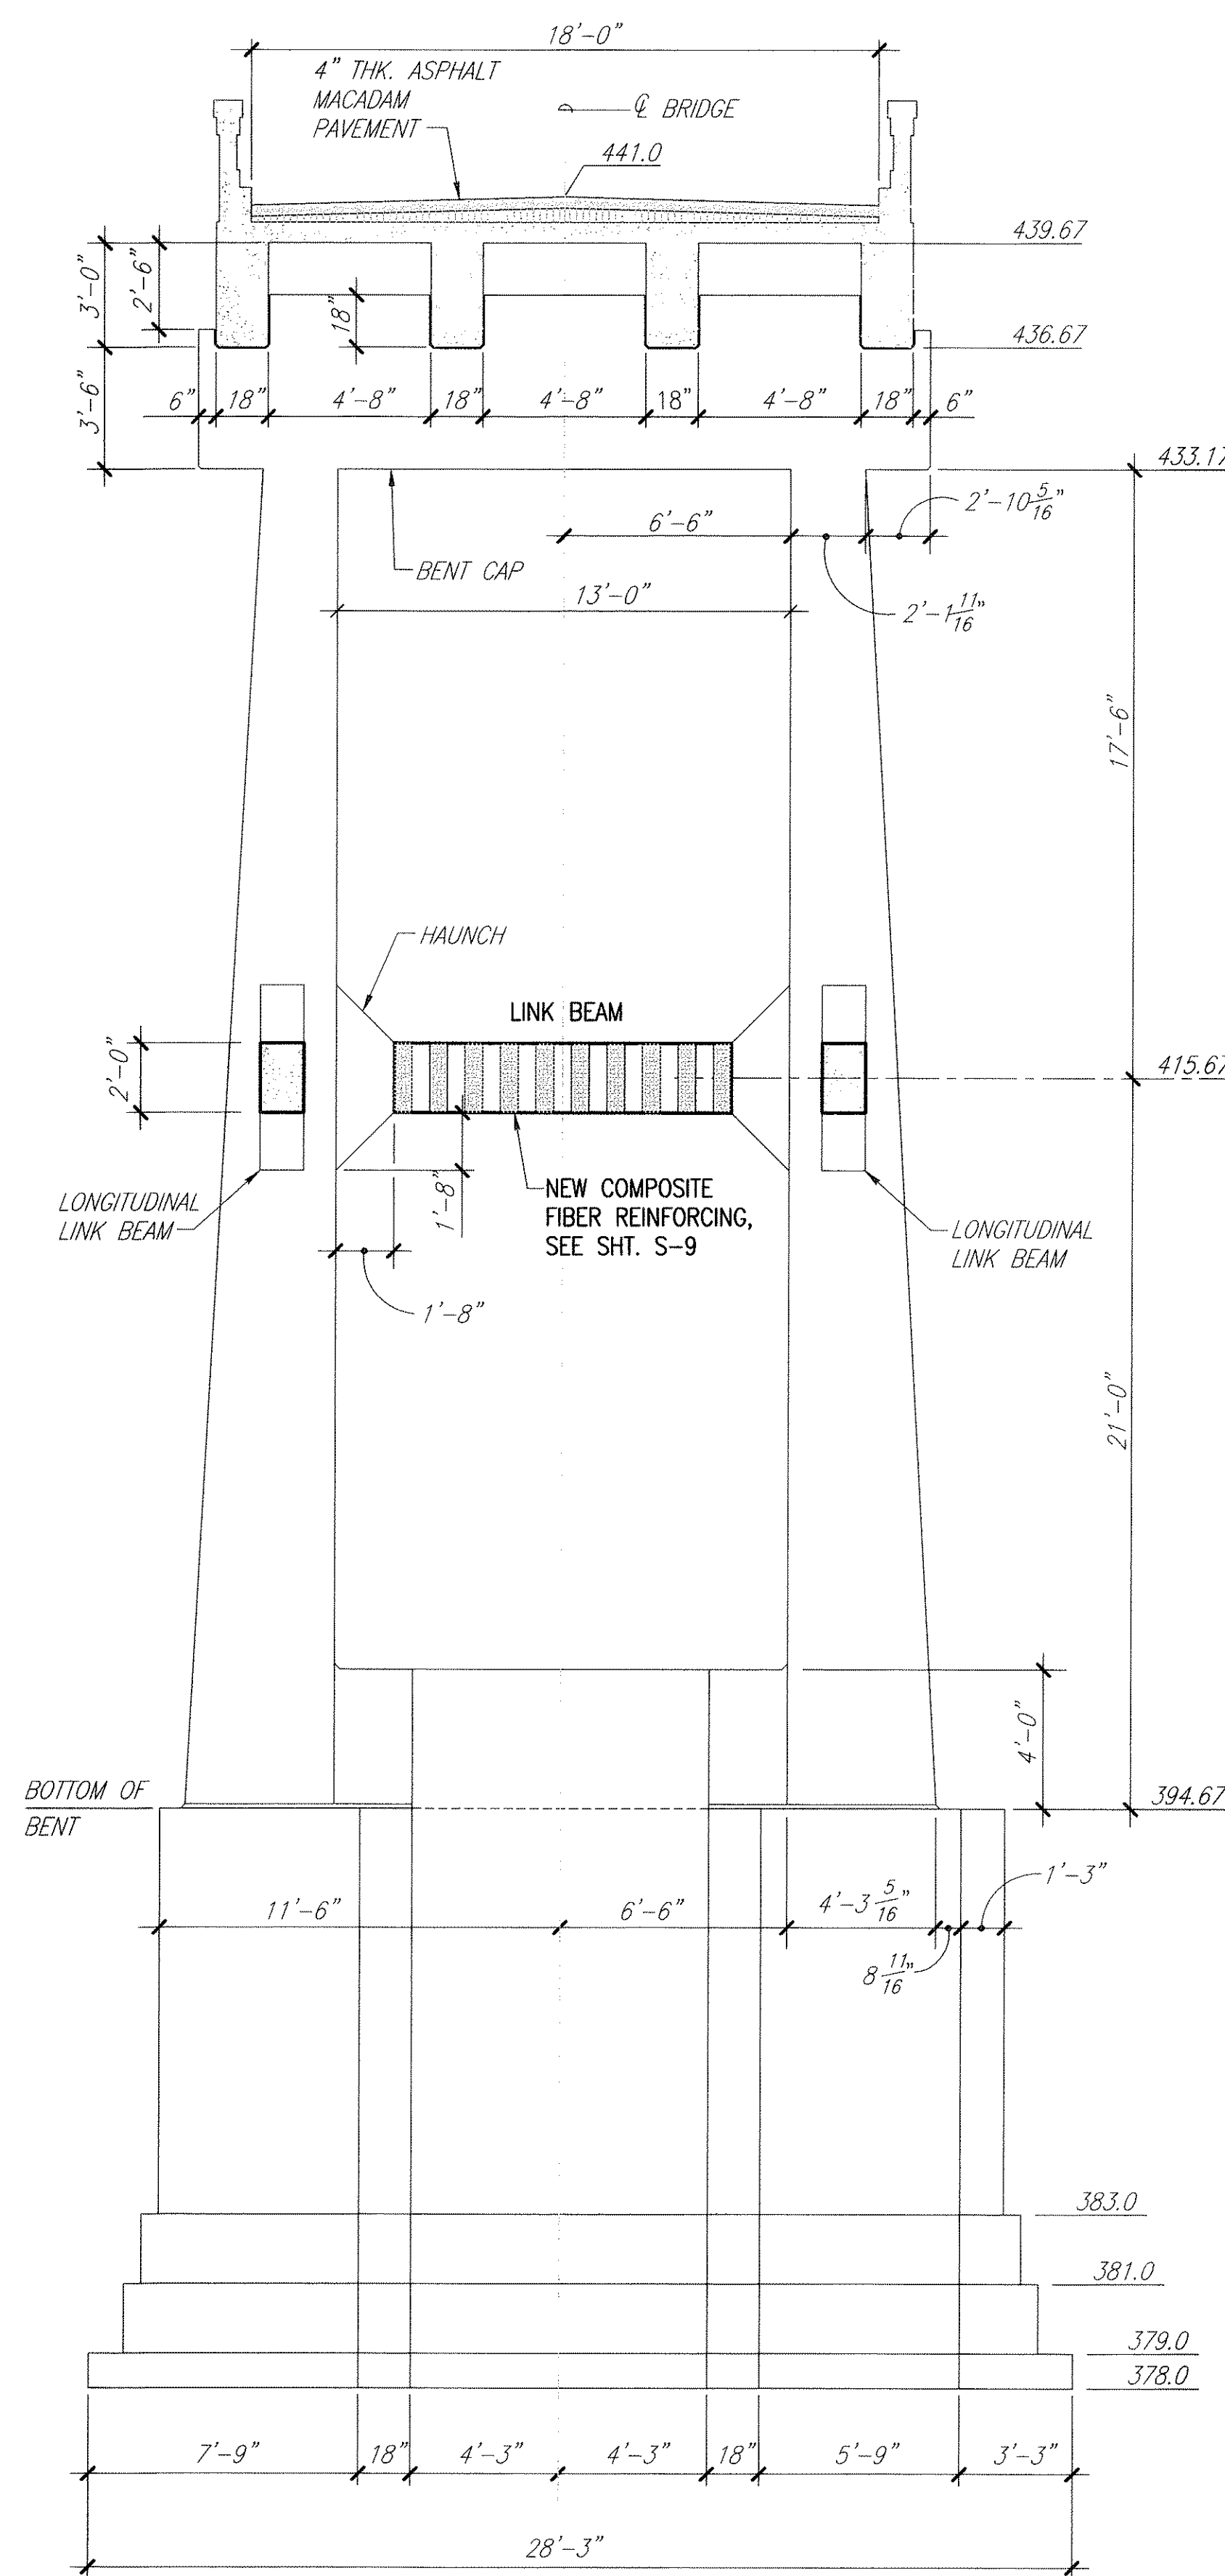


B BENT "B" ELEVATION
S-3 SCALE: 1/4"=1'-0"

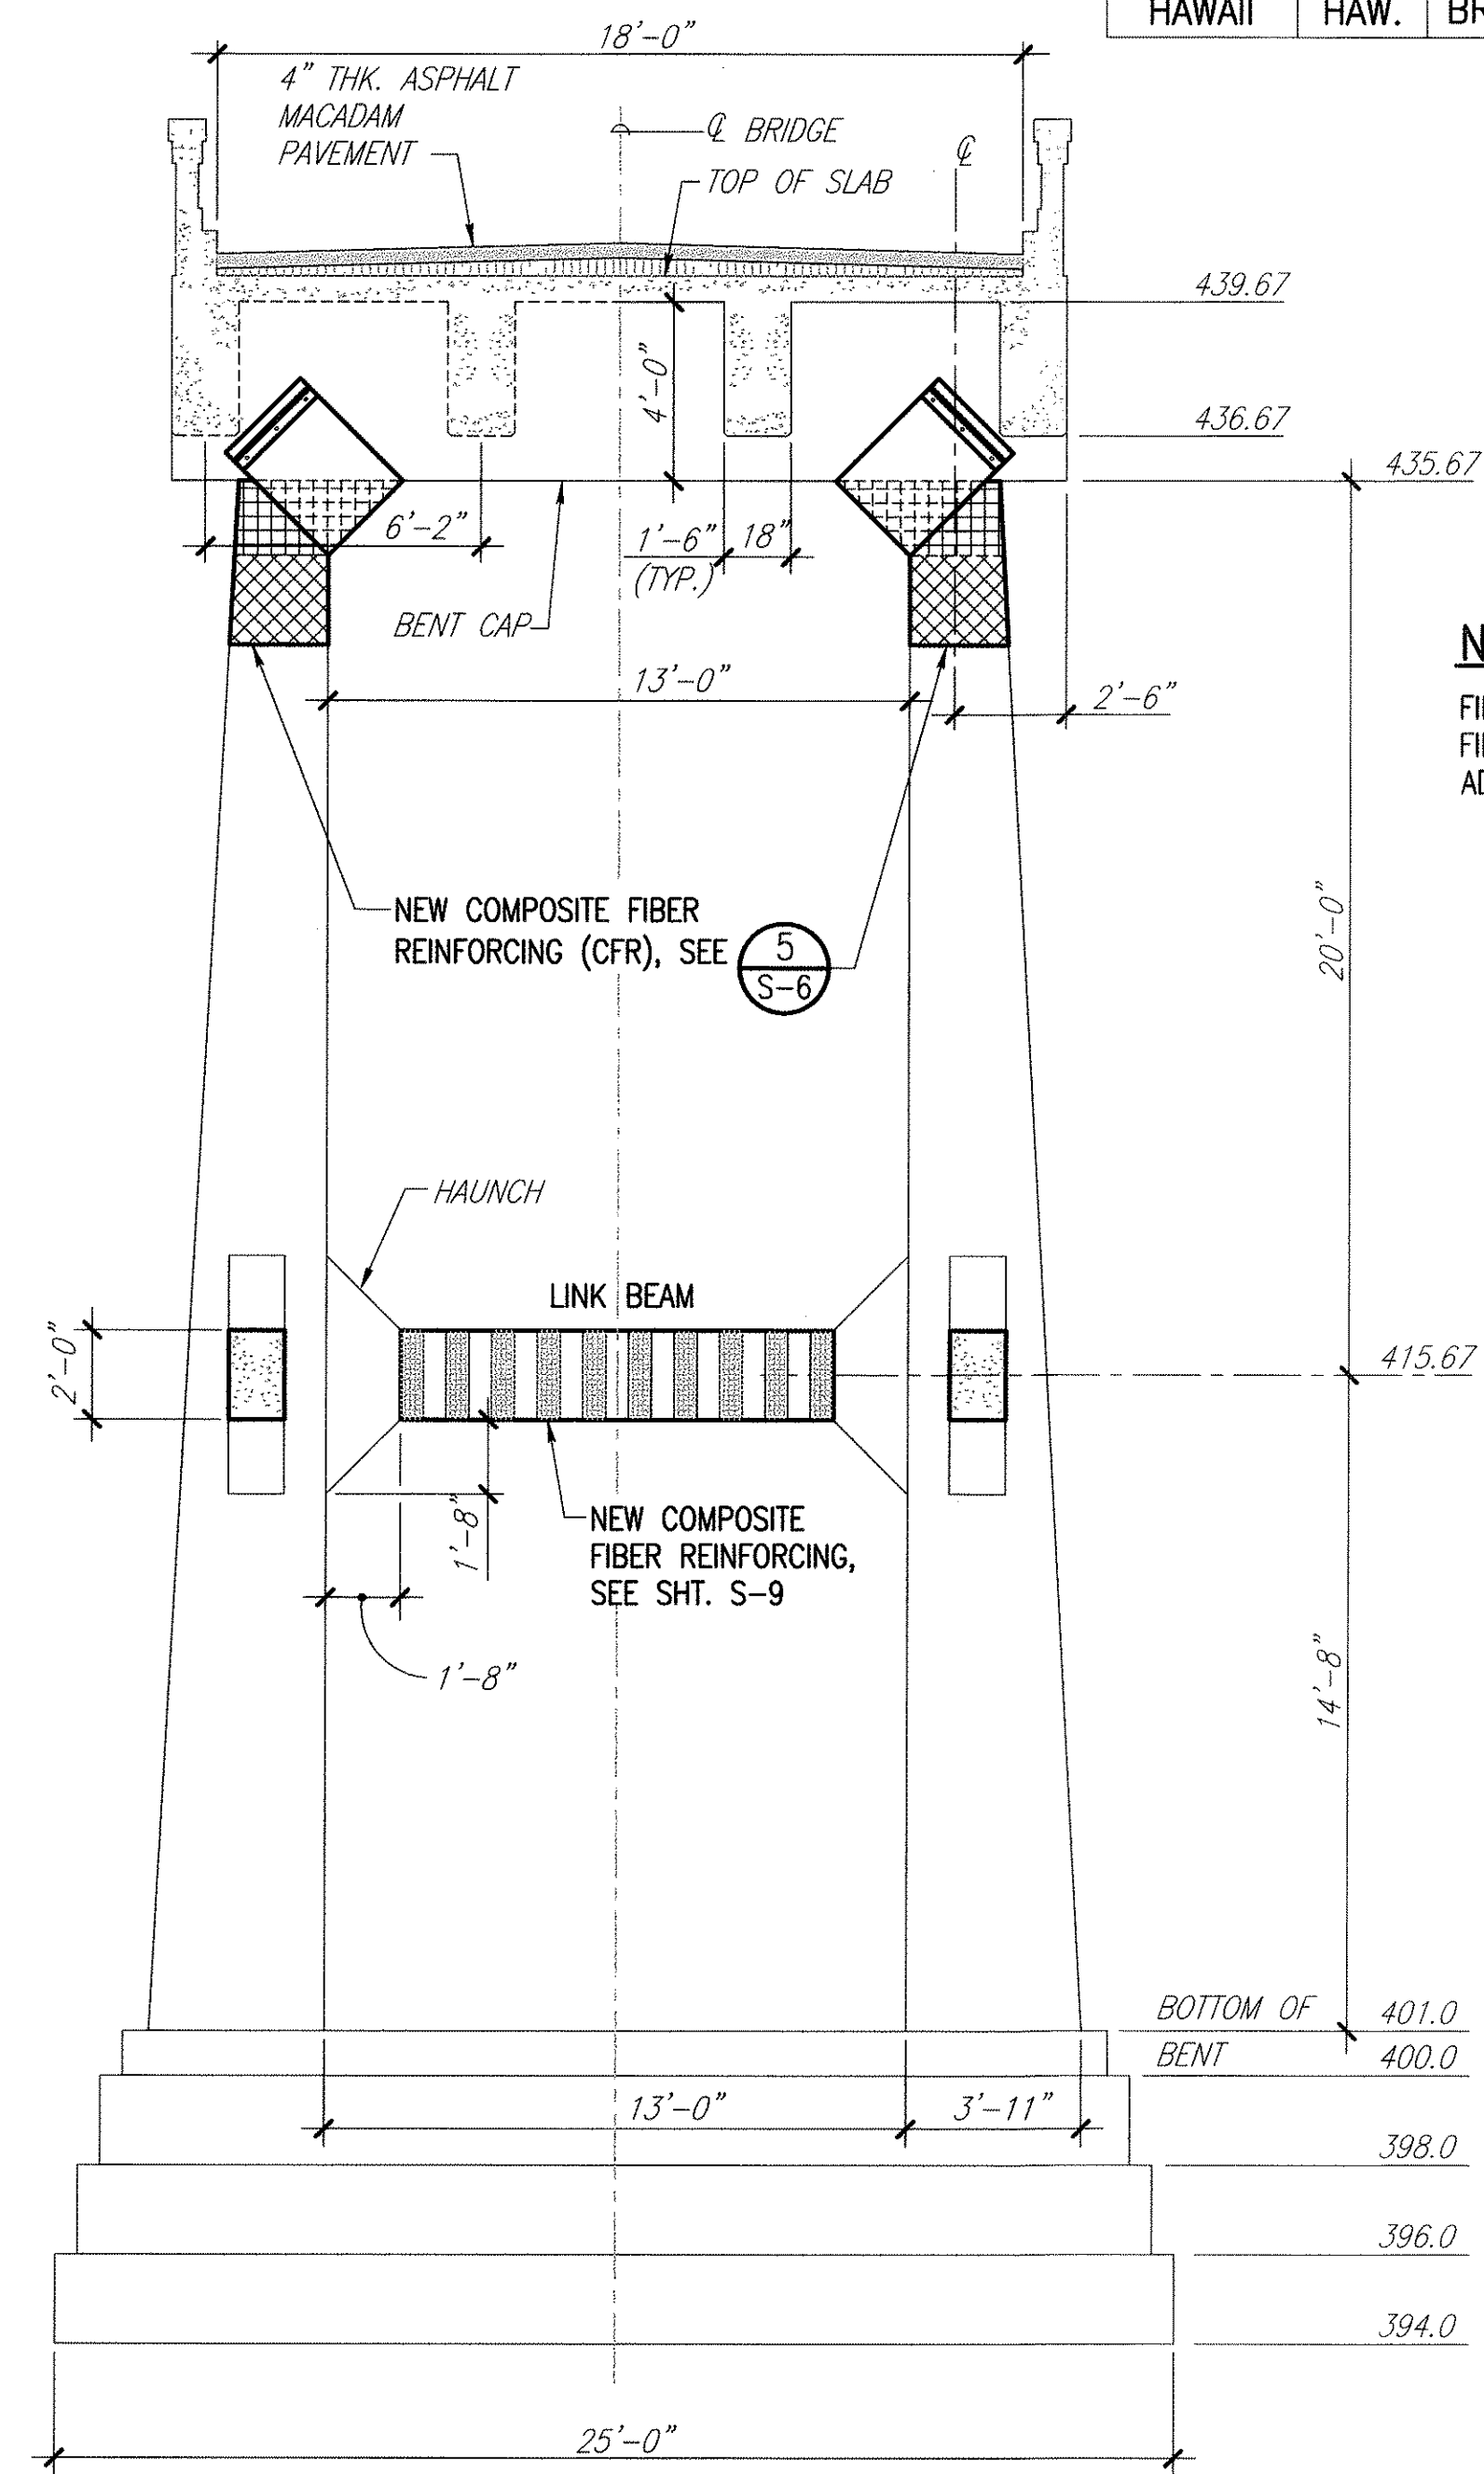

C BENT "C" ELEVATION
S-3 SCALE: 1/4"=1'-0"

GRAPHIC SCALE

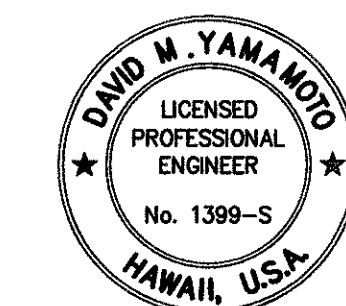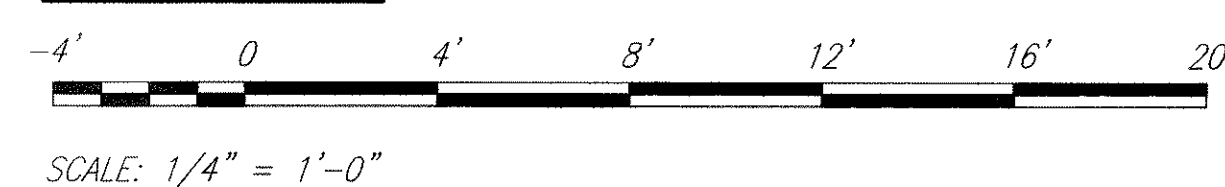


THIS WORK WAS PREPARED BY ME OR UNDER MY SUPERVISION
APRIL 30, 2008
EXPIRATION DATE OF LICENSE

STATE OF HAWAII
DEPARTMENT OF TRANSPORTATION
HIGHWAYS DIVISION
BRIDGE BENT ELEVATIONS
WALAOHIA BRIDGE
AKONI PULE HIGHWAY, SEISMIC RETROFIT
OF WALAOHIA AND AAMAKAO BRIDGES;
FAIP NO. BR-0270(18)
SCALE: AS NOTED DATE: May 2006
SHEET No. **S - 3** OF 12 SHEETS

Date Saved: Thu, 11 May 2006 - 9:59am
File Location: S:\02022-00\STRUCT\final\MAY 6-ADDITIONS\S-03.dwg

| | |
|-------------------|---------------|
| SURVEY PLOTTED BY | DATE |
| DRAWN BY | DESIGNED BY |
| NOTE BOOK | QUANTITIES BY |
| CHECKED BY | |
| No. | |


| FED. ROAD DIST. NO. | STATE | FED. AID PROJ. NO. | FISCAL YEAR | SHEET NO. | TOTAL SHEETS |
|---------------------|-------|--------------------|-------------|-----------|--------------|
| HAWAII | HAW. | BR-0270(18) | 2006 | 23 | 31 |

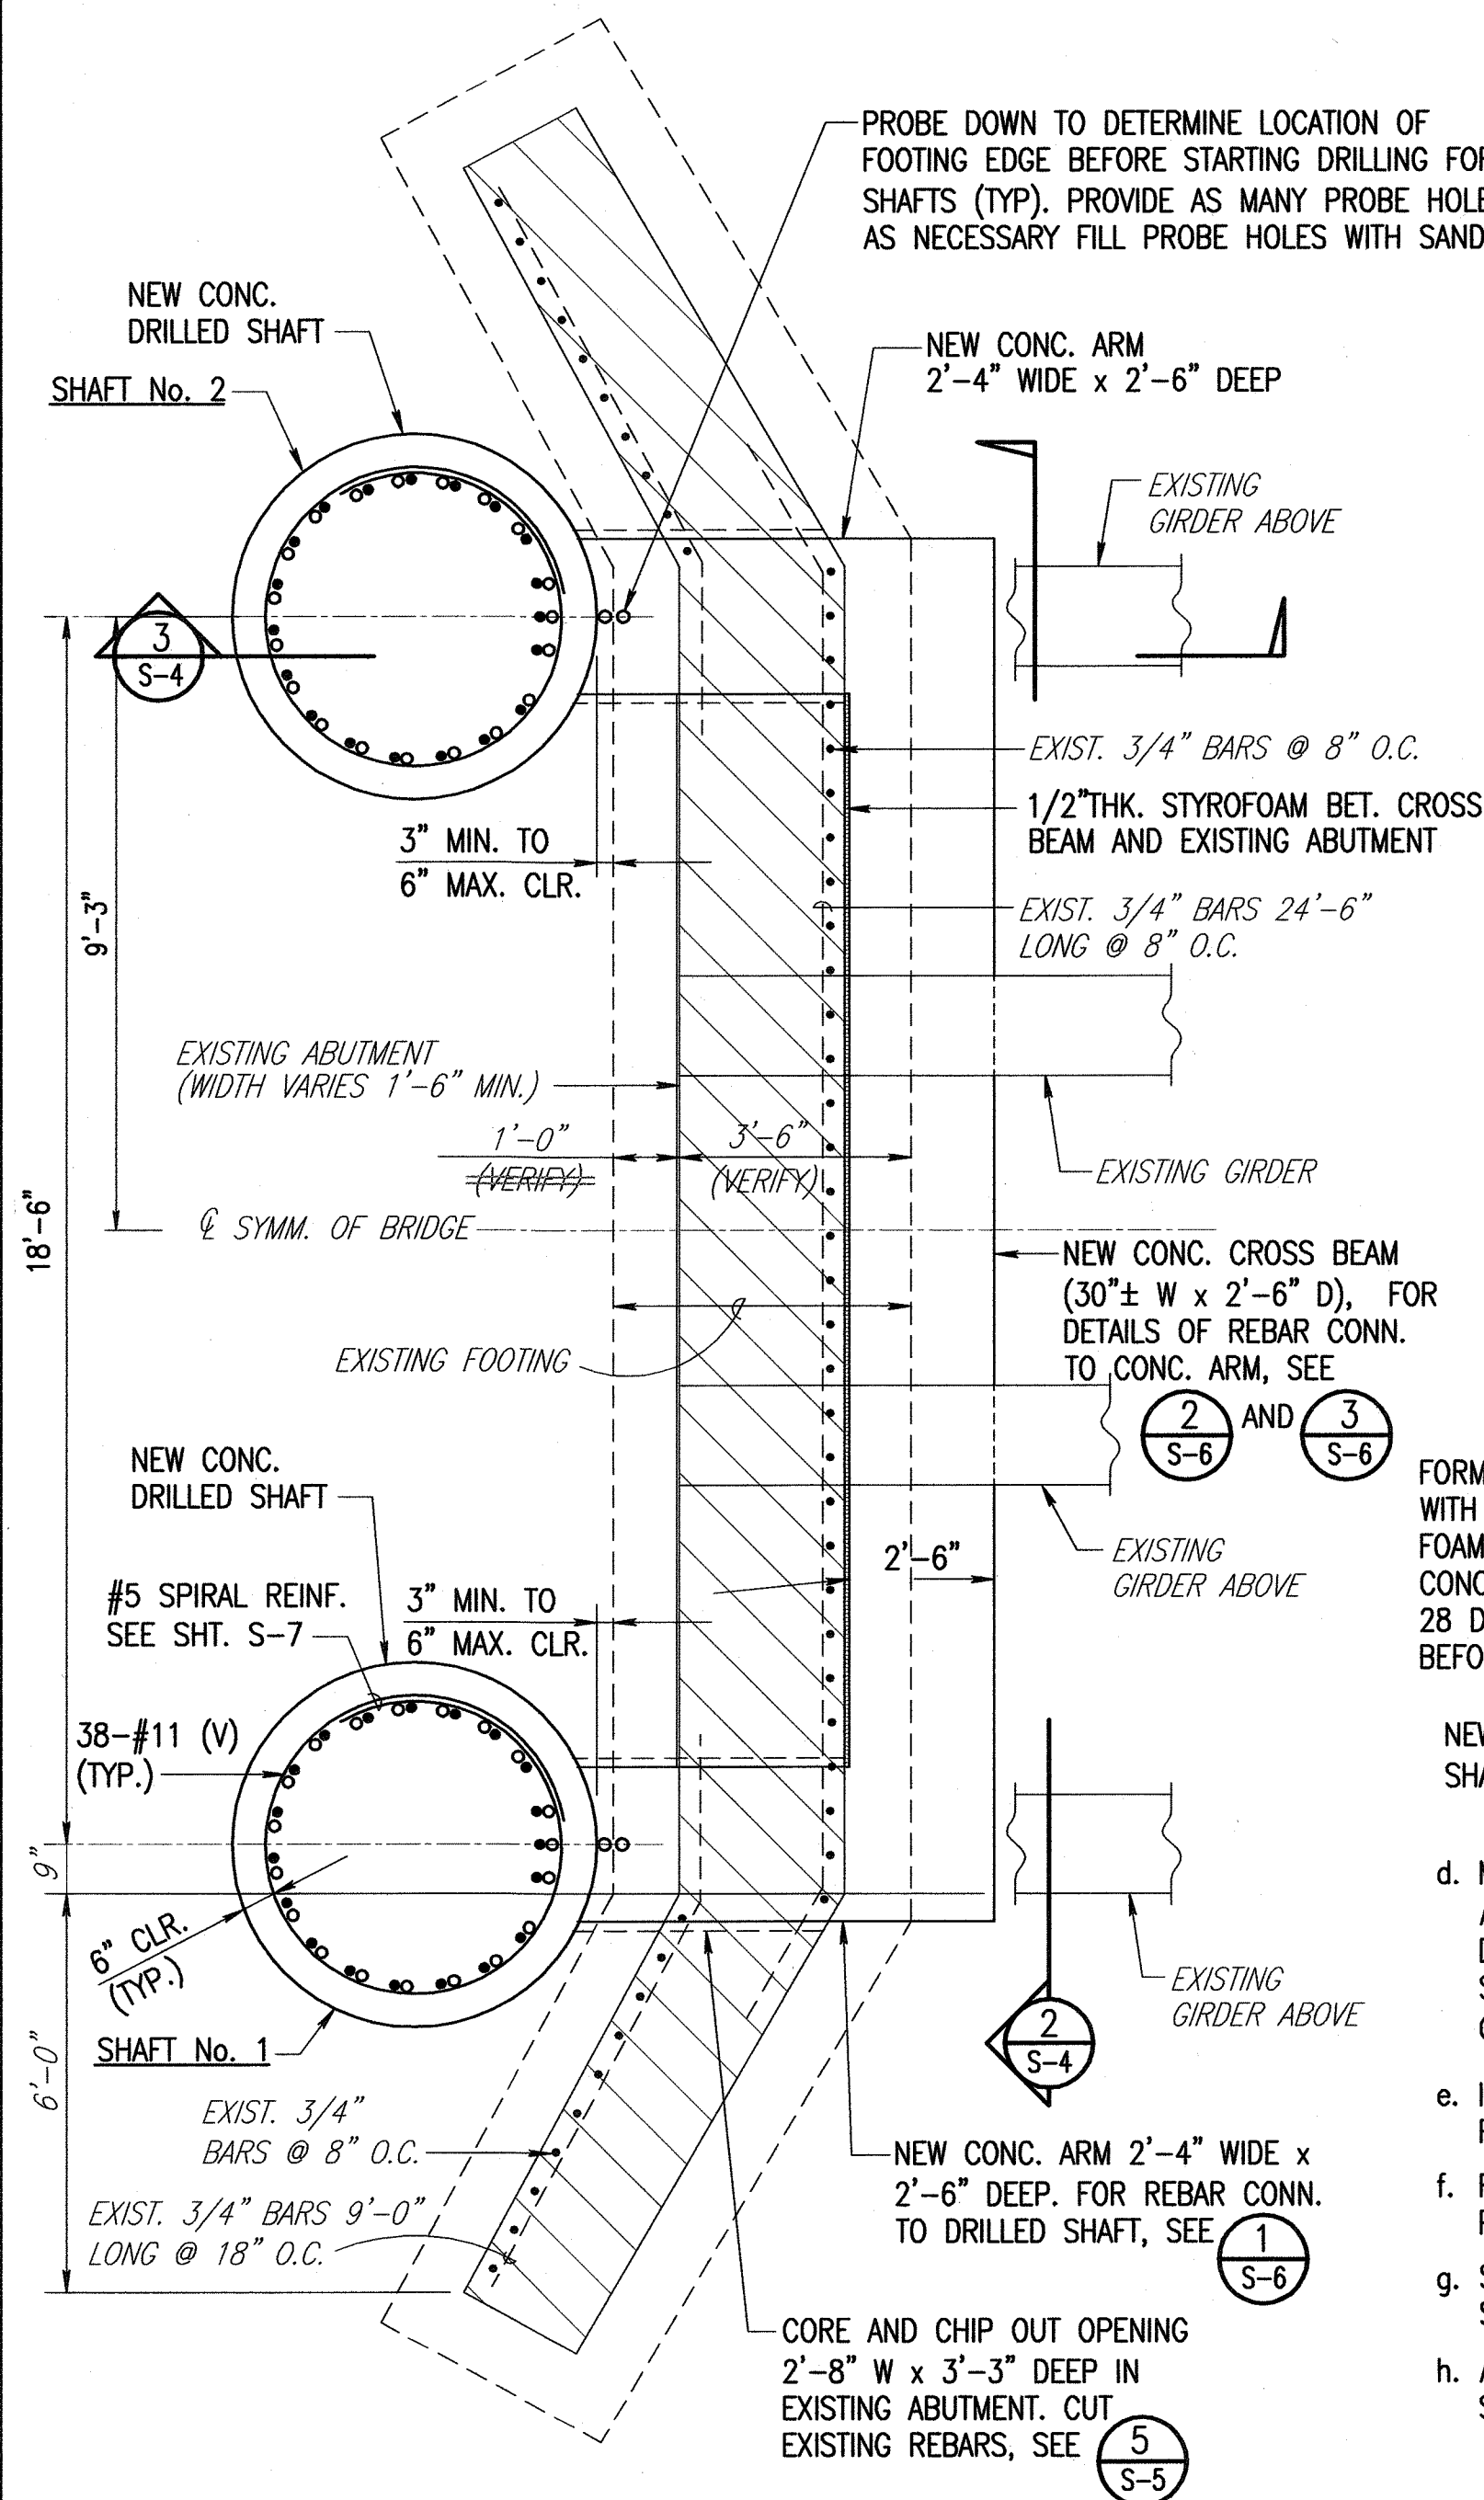

1 PLAN-SECTION OF WEST ABUTMENT
SCALE: 3/8" = 1'-0"

A. NOTES FOR ABUTMENT RETROFITS:

- CONTRACTOR SHALL BE RESPONSIBLE FOR THE INTEGRITY OF THE STRUCTURE AT ALL TIMES.
- DO NOT DAMAGE EXISTING REBARS WHILE DRILLING FOR DOWELS IN EXISTING CONCRETE GIRDERS AND SLAB.
- JACKING:
 - GENERAL:
 - USE ALL NECESSARY PRECAUTIONS TO PREVENT CONCRETE, MORTAR, ROCKS, HARD SOIL AND OTHER OBJECTS FROM PREVENTING TRANSFER OF ABUTMENT WEIGHT TO THE ALREADY POURED DRILLED SHAFT.
 - JACKS SHALL BE CALIBRATED. JACKING OF ABUTMENT AT BOTH DRILLED SHAFTS SHALL BE DONE SYNCHRONIZING TO ONE PUMP AFTER POUR No. 2 HAS ATTAINED 3,000 PSI STRENGTH AND BEFORE POUR No. 3 IS MADE. USE SAME TYPE JACK AND SAME CALIBRATION AT BOTH DRILLED SHAFTS. EACH ABUTMENT SHALL BE JACKED SEPARATELY.
 - JACKING LOAD SHALL BE AS SHOWN IN SCHEDULE AT EACH DRILLED SHAFT. APPLY JACKING LOADS AS CALLED FOR IN 3B-PROCEDURE.

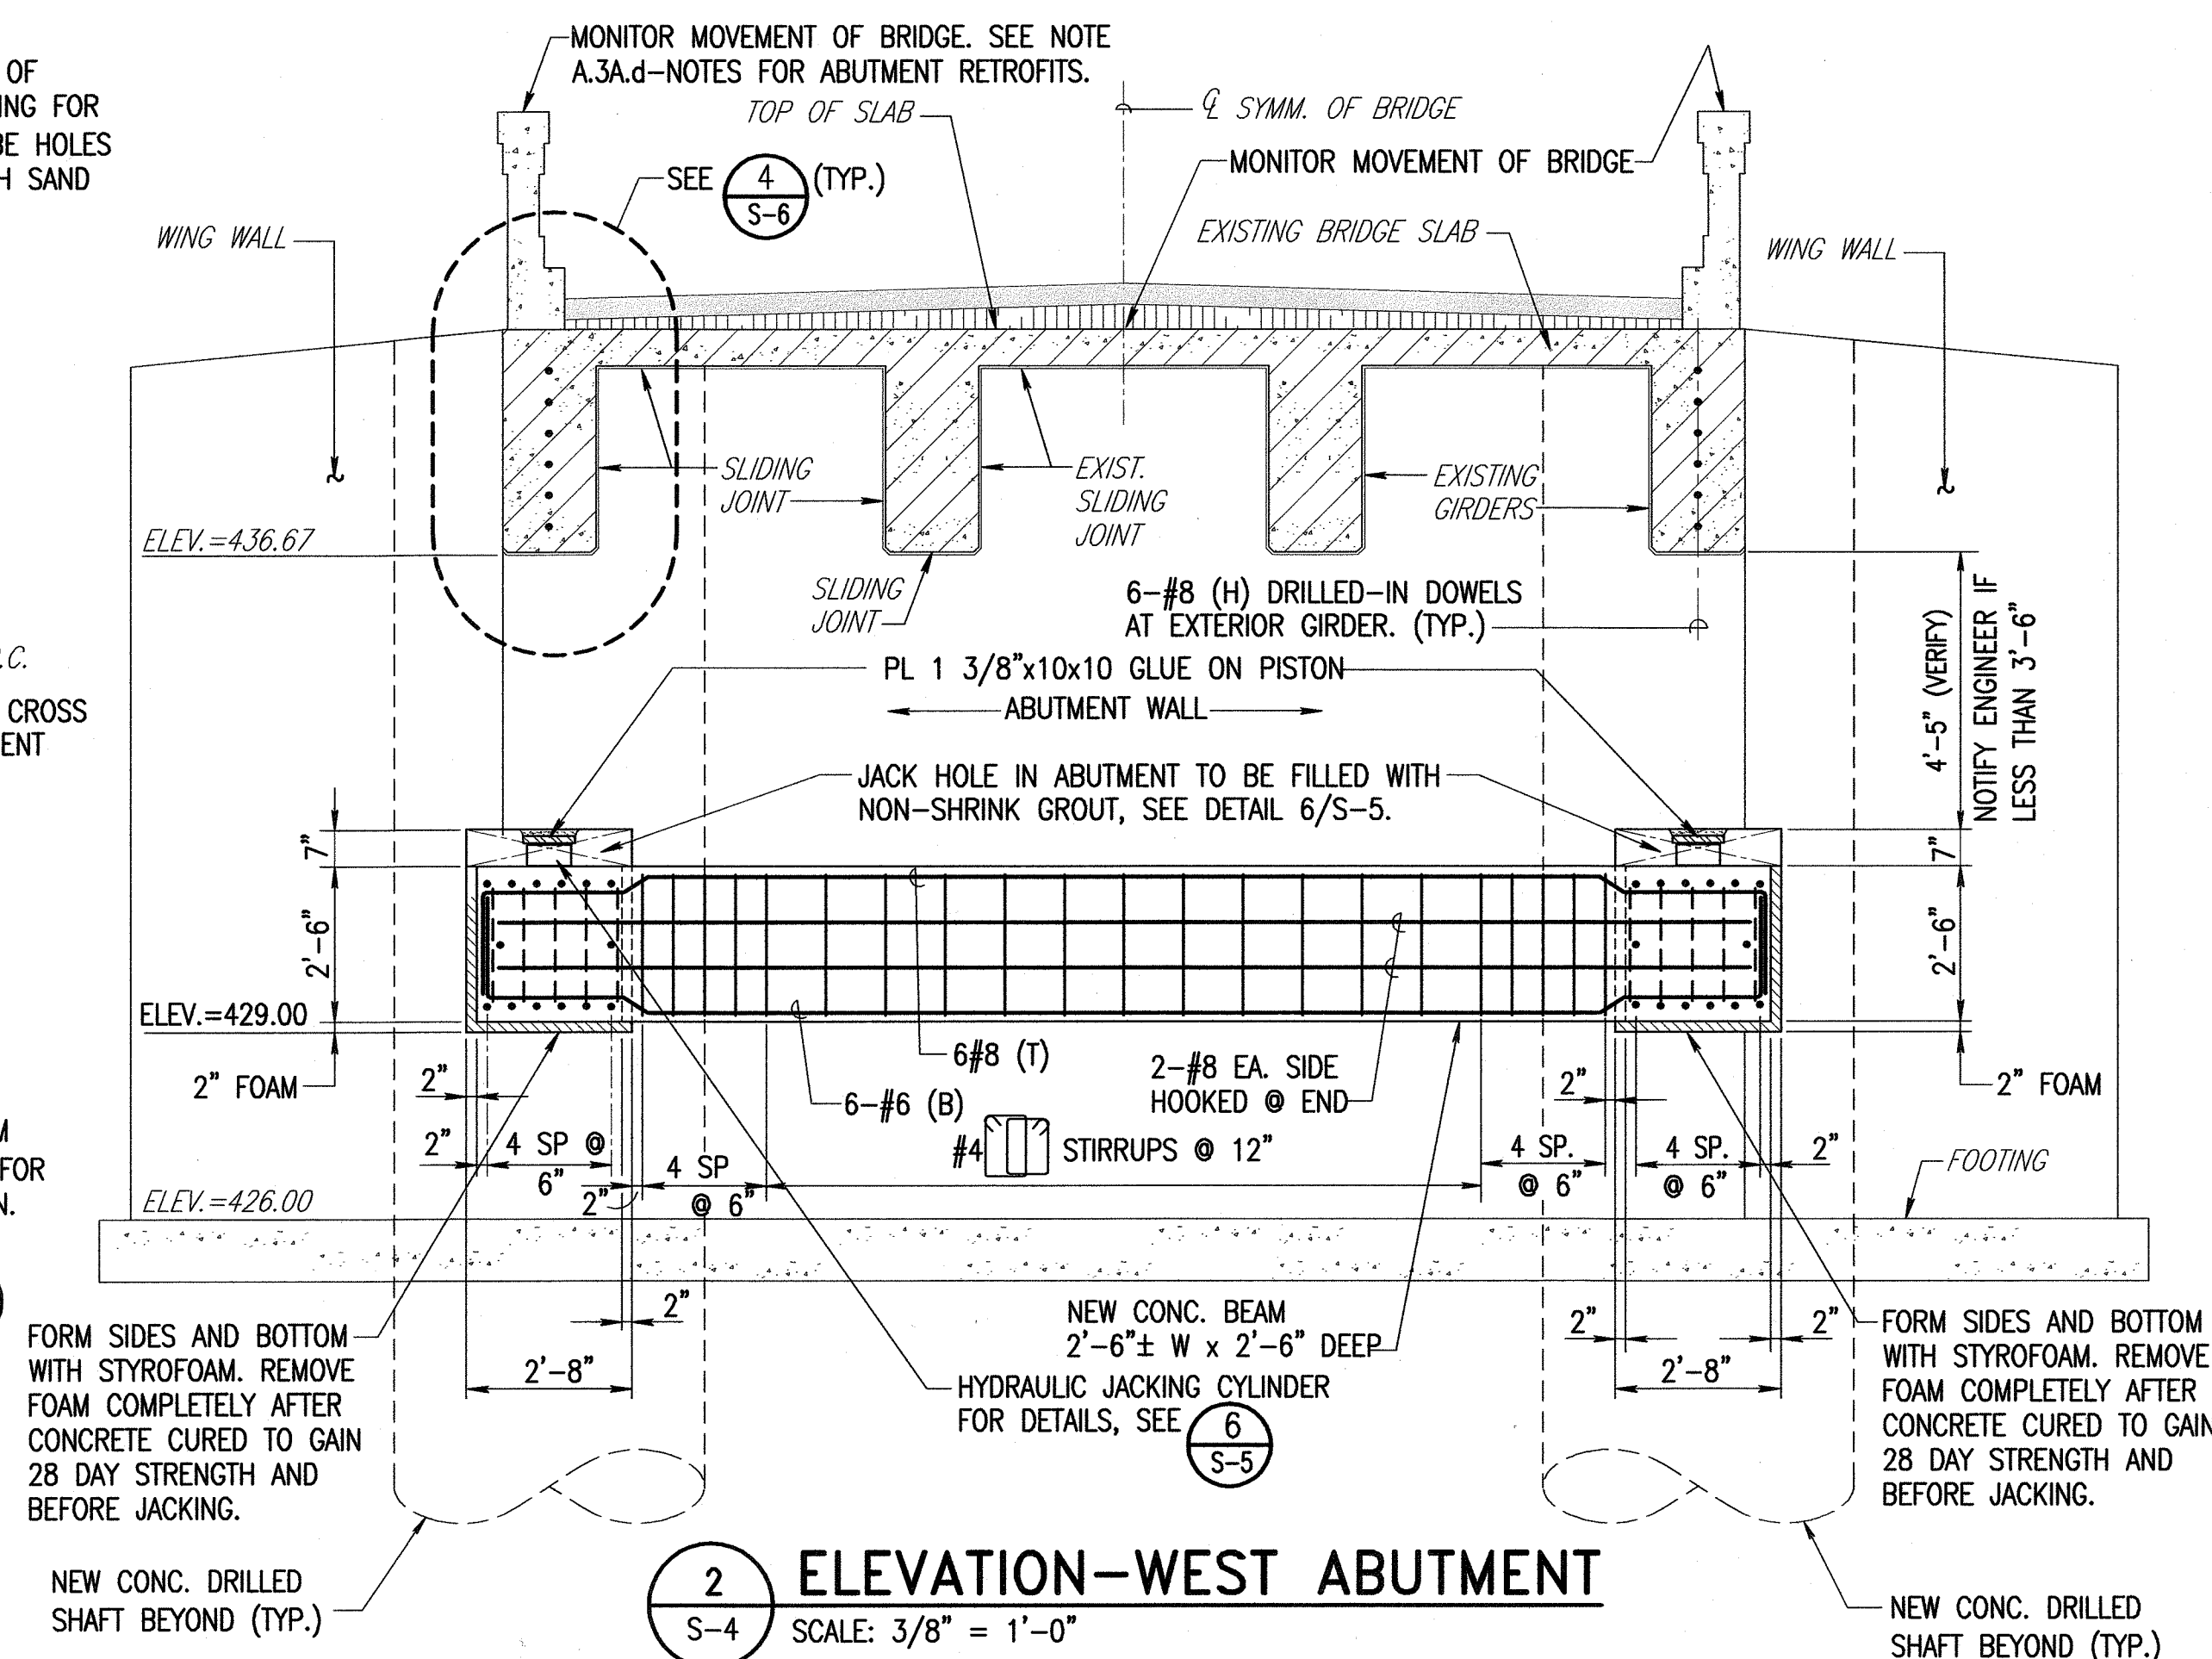

2 ELEVATION-WEST ABUTMENT
SCALE: 3/8" = 1'-0"

- MONITOR AND REPORT MOVEMENT OF ABUTMENT AND SHAFTS. DO NOT RAISE ABUTMENT MORE THAN 1/8 INCH RELATIVE TO SOLID GROUND 20 FEET BEHIND DRILLED SHAFT. IF THE REQUIRED JACKING LOAD CANNOT BE REACHED AFTER THE STROKE, RELEASE LOAD, PLACE SHIM PLATES AND REPEAT THE OPERATION. FIX CRACKS IN A.C. PAVING DUE TO RAISING OF ABUTMENT, SEE DETAIL 3/S-7 SIMILAR.
- INFORM GEOTECHNICAL ENGINEER SUFFICIENTLY BEFORE STARTING JACKING PROCEDURES.
- RECORD JACKING LOADS, TIME AND LOCATION AND ELEVATION OF MONITORING POINTS AT EVERY STEP OF THE PROCEDURE OUTLINED IN 3B.
- SUBMIT SKETCHES, EQUIPMENT INFORMATION, RECORD KEEPING FORMS, AND STEP BY STEP JACKING PROCEDURE FOR APPROVAL PRIOR TO JACKING.
- AT EACH STEP OF JACKING PROCEDURE DESCRIBED HEREINAFTER, THE TRAFFIC CONTROL SEQUENCE SHALL BE AS FOLLOWS:
 - NO VEHICLE SHALL BE ALLOWED ON THE BRIDGE FOR 5 MINUTES MAX. DURING APPLICATION OF JACKING LOAD AND STABILIZATION OF THE READING GAUGES.
 - TRAFFIC SHALL BE ALLOWED TO PASS DURING A MIN. OF 10 MINUTES WAITING PERIOD.
 - NO TRAFFIC SHALL BE ALLOWED ON THE BRIDGE FOR 5 MINUTES MAX. DURING MONITORING AND MEASURING MOVEMENT OF THE BRIDGE.

B. PROCEDURE:

- STEP 1:
AFTER 20% OF JACKING LOAD HAS BEEN REACHED AT SHAFT 1 AND 2 INSPECT ABUTMENT AND WING WALL FOR CONDITION OF DISTRESS. TAKE ELEVATION OF TOP OF THE SHAFTS AT CENTER AND TOP OF CONCRETE RAILINGS NEAR THE ABUTMENTS. MARK SPOTS SO ALL MEASUREMENTS ARE TAKEN AT SAME POINTS. LEVEL INSTRUMENT SHALL BE PLACED AT LEAST 20'-0" BEHIND ABUTMENT. WAIT 10 MINUTES MIN. BEFORE CHECKING JACKING FORCES, ELEVATIONS AND INSPECT ABUTMENTS BEFORE INCREASING JACKING LOAD.
- STEP 2:
INCREASE TO 40% OF JACKING LOAD. REPEAT PROCEDURES IN STEP 1.
- STEP 3 THROUGH 8:
INCREASE TO 60%, 70%, 80%, 85%, 90% AND 95% OF JACKING LOAD IN 6-STEPS. REPEAT PROCEDURES IN STEP 1 AT EACH STEP.
- STEP 9:
INCREASE TO 100% OF JACKING LOAD. REPEAT PROCEDURES IN STEP 1. MAX. 75% OF MAX. PUMP PRESSURE SHALL BE REACHED AT 100% LOADS. WAIT 12 HOURS. CHECK FORCES AND ELEVATIONS. IF FORCE IS LOST, JACK TO 100%. REPORT WHEN JACKING FORCE CAN BE SUSTAINED WITH LESS THAN 3% LOSS IN 8 HOURS, LOCK JACK AND SEAL.
- STEP 10:
WHEN APPROVED BY ENGINEER, GROUT JACK HOLES. AS SHOWN IN DETAIL 6/S-5. DO NOT RELEASE JACK LOAD UNTIL GROUT IS CURED TO GAIN 7,000 PSI COMPRESSIVE STRENGTH.

RECORD DRAWING
The details, locations and other information shown are based on information provided by others. The design consultant cannot assure the accuracy and completeness of the information. The user of this drawing shall be responsible to verify its accuracy and completeness.

LEGEND FOR AS-BUILT POSTINGS

- Squiggly line for as-built deletion
- Double line for as-built deletion
- "X" for as-built deletion
- Roadway Text for as-built posting

EXCAVATE FRONT OF DRILLED SHAFT UP TO UNDERSIDE OF CONCRETE ARM AND PROVIDE TEMP. WOOD FORM AT TOP AND SIDES OF OPN'G. TO KEEP AWAY EARTH AND CONC. SPILL.

1 1/8" Ø DRILL-IN AND EPOXY FILL HOLES IN EXISTING SLAB AND GIRDERS FOR 6-#8 REBAR DOWELS

FILL ANNULAR SPACE BETWEEN CASING AND EXCAVATION SIDES WITH GROUT AFTER JACKING

REMOVAL OF CASING OPTIONAL POUR No. 3

CLEAN AND REMOVE ALL SOFT AND LOOSE MATERIALS

STIRR. #4

STYROFOAM BLOCKOUT INSIDE CASING TO BE REMOVED BEFORE POURING CONC. ARM, SEE DETAIL 1 S-6

5'-6" O.D. CASING

6-#8 (B) DOWEL BAR SPLICERS

38-#11 (V) #5 SPIRAL

LOOSEN MATERIAL, REMOVE HARD MATERIAL

OVER-POUR CONC. REMOVE ALL SOFT AND LOOSE MATERIALS BY SUCKING OUT CONC. WHEN WET. CLEAN REBARS.

NOTE:

1. * REMOVE STYROFOAM COMPLETELY AFTER POURING CONCRETE. AND BEFORE JACKING. DRY PACK MORTAR AFTER JACKING IS COMPLETED.

2. JACK ABUTMENT TO TRANSFER WEIGHT ONTO DRILLED SHAFTS. SEE NOTES A.3 ON THIS SHEET. KEEP VEHICLES OFF STRUCTURE DURING LAST MOVEMENT OF LOAD TRANSFER AT STEP 9.

3. AT SHAFT No. 2 PROVIDE DRILL-IN DOWELS FROM EXTERIOR GIRDERS. FORM AND POUR NEW GIRDER EXTENSION AND POUR No. 3 OF DRILLED SHAFT.

4. REPEAT STEP 7 FOR SHAFT No. 1.

5. REPEAT STEP 3 FOR SHAFT No. 2

6. REPEAT STEP 1 AND 2 FOR SHAFT No. 2. POUR CONCRETE CROSS-BEAM BETWEEN CANTILEVER ARMS.

7. REPEAT STEP 1 AND 2 FOR SHAFT No. 1. UP TO POUR No. 1 AND REMOVE TEMPORARY CASING, IF PROVIDED. TAKE CONCRETE CYLINDERS TO VERIFY CONCRETE STRENGTH AT 3, 7, AND 28 DAYS. TAKE 3 CORE SAMPLES AT TOP OF POUR No. 1 FOR TESTING.

8. POUR DRILLED SHAFT No. 1 UP TO POUR No. 2, PERMANENT CASING TO REMAIN. CORE AND CHIP/OUT OPENINGS IN EXISTING ABUTMENTS. CUTOUT CASING AT INTERFACE WITH CONCRETE ARM AND REMOVE STYROFOAM BLOCKOUT INSIDE CASING FORM AND POUR CONCRETE CANTILEVER ARM. TAKE CONCRETE CYLINDERS TO VERIFY CONCRETE STRENGTH AT 3, 7, AND 28 DAYS. Cantilevered Concrete Arms for Shaft Nos. 1 and 2 and Cross Beam Poured Monolithically With Pour No. 2

9. COVER SHAFT No. 1 EXCAVATION TO PERMIT TRAFFIC OVER IT.

10. REPEAT STEP 1 AND 2 FOR SHAFT No. 2. POUR CONCRETE CROSS-BEAM BETWEEN CANTILEVER ARMS.

11. REPEAT STEP 3 FOR SHAFT No. 2

12. JACK ABUTMENT TO TRANSFER WEIGHT ONTO DRILLED SHAFTS. SEE NOTES A.3 ON THIS SHEET. KEEP VEHICLES OFF STRUCTURE DURING LAST MOVEMENT OF LOAD TRANSFER AT STEP 9.

13. AT SHAFT No. 2 PROVIDE DRILL-IN DOWELS FROM EXTERIOR GIRDERS. FORM AND POUR NEW GIRDER EXTENSION AND POUR No. 3 OF DRILLED SHAFT.

14. REPEAT STEP 7 FOR SHAFT No. 1.

15. REPEAT STEP 3 FOR SHAFT No. 2

16. REPEAT STEP 1 AND 2 FOR SHAFT No. 2. POUR CONCRETE CROSS-BEAM BETWEEN CANTILEVER ARMS.

17. REPEAT STEP 1 AND 2 FOR SHAFT No. 1. UP TO POUR No. 1 AND REMOVE TEMPORARY CASING, IF PROVIDED. TAKE CONCRETE CYLINDERS TO VERIFY CONCRETE STRENGTH AT 3, 7, AND 28 DAYS. TAKE 3 CORE SAMPLES AT TOP OF POUR No. 1 FOR TESTING.

18. POUR DRILLED SHAFT No. 1 UP TO POUR No. 2, PERMANENT CASING TO REMAIN. CORE AND CHIP/OUT OPENINGS IN EXISTING ABUTMENTS. CUTOUT CASING AT INTERFACE WITH CONCRETE ARM AND REMOVE STYROFOAM BLOCKOUT INSIDE CASING FORM AND POUR CONCRETE CANTILEVER ARM. TAKE CONCRETE CYLINDERS TO VERIFY CONCRETE STRENGTH AT 3, 7, AND 28 DAYS. Cantilevered Concrete Arms for Shaft Nos. 1 and 2 and Cross Beam Poured Monolithically With Pour No. 2

SEE DETAIL 2 S-7 FOR PAVEMENT RECONSTRUCTION AT DRILLED SHAFTS TYP.

NEW GIRDER EXTENSION, 1'-6" W x 3'-7"

2'-0" EMBED

"SLIDING" JOINT

EXIST. PAVEMENT

TOP OF SLAB

EXIST. GIRDER

EQ. JACK

6-#10 (T) DOWEL BAR SPLICERS

2-#6

CROSS BEAM

6-#8 (T)

2-#8 HOOKED CONC. ARMS

6-#6 (B)

EXCAVATE

CONC. ARM 2'-4" WIDE

*2" EXPANDED POLYSTYRENE (STYROFOAM) AT BOT. AND SIDES; TAPE JOINTS TO PREVENT LEAKS.

EXISTING ABUTMENT

EXISTING FOOTING

OVER-POUR CONC. REMOVE ALL SOFT AND LOOSE MATERIALS BY SUCKING OUT CONC. WHEN WET. CLEAN REBARS.

NOTE:

1. * REMOVE STYROFOAM COMPLETELY AFTER POURING CONCRETE. AND BEFORE JACKING. DRY PACK MORTAR AFTER JACKING IS COMPLETED.

2. JACK ABUTMENT TO TRANSFER WEIGHT ONTO DRILLED SHAFTS. SEE NOTES A.3 ON THIS SHEET. KEEP VEHICLES OFF STRUCTURE DURING LAST MOVEMENT OF LOAD TRANSFER AT STEP 9.

3. AT SHAFT No. 2 PROVIDE DRILL-IN DOWELS FROM EXTERIOR GIRDERS. FORM AND POUR NEW GIRDER EXTENSION AND POUR No. 3 OF DRILLED SHAFT.

4. REPEAT STEP 7 FOR SHAFT No. 1.

5. REPEAT STEP 3 FOR SHAFT No. 2

6. REPEAT STEP 1 AND 2 FOR SHAFT No. 2. POUR CONCRETE CROSS-BEAM BETWEEN CANTILEVER ARMS.

7. REPEAT STEP 1 AND 2 FOR SHAFT No. 1. UP TO POUR No. 1 AND REMOVE TEMPORARY CASING, IF PROVIDED. TAKE CONCRETE CYLINDERS TO VERIFY CONCRETE STRENGTH AT 3, 7, AND 28 DAYS. TAKE 3 CORE SAMPLES AT TOP OF POUR No. 1 FOR TESTING.

8. POUR DRILLED SHAFT No. 1 UP TO POUR No. 2, PERMANENT CASING TO REMAIN. CORE AND CHIP/OUT OPENINGS IN EXISTING ABUTMENTS. CUTOUT CASING AT INTERFACE WITH CONCRETE ARM AND REMOVE STYROFOAM BLOCKOUT INSIDE CASING FORM AND POUR CONCRETE CANTILEVER ARM. TAKE CONCRETE CYLINDERS TO VERIFY CONCRETE STRENGTH AT 3, 7, AND 28 DAYS. Cantilevered Concrete Arms for Shaft Nos. 1 and 2 and Cross Beam Poured Monolithically With Pour No. 2

9. COVER SHAFT No. 1 EXCAVATION TO PERMIT TRAFFIC OVER IT.

10. REPEAT STEP 1 AND 2 FOR SHAFT No. 2. POUR CONCRETE CROSS-BEAM BETWEEN CANTILEVER ARMS.

11. REPEAT STEP 3 FOR SHAFT No. 2

12. JACK ABUTMENT TO TRANSFER WEIGHT ONTO DRILLED SHAFTS. SEE NOTES A.3 ON THIS SHEET. KEEP VEHICLES OFF STRUCTURE DURING LAST MOVEMENT OF LOAD TRANSFER AT STEP 9.

13. AT SHAFT No. 2 PROVIDE DRILL-IN DOWELS FROM EXTERIOR GIRDERS. FORM AND POUR NEW GIRDER EXTENSION AND POUR No. 3 OF DRILLED SHAFT.

14. REPEAT STEP 7 FOR SHAFT No. 1.

15. REPEAT STEP 3 FOR SHAFT No. 2

16. REPEAT STEP 1 AND 2 FOR SHAFT No. 2. POUR CONCRETE CROSS-BEAM BETWEEN CANTILEVER ARMS.

17. REPEAT STEP 1 AND 2 FOR SHAFT No. 1. UP TO POUR No. 1 AND REMOVE TEMPORARY CASING, IF PROVIDED. TAKE CONCRETE CYLINDERS TO VERIFY CONCRETE STRENGTH AT 3, 7, AND 28 DAYS. TAKE 3 CORE SAMPLES AT TOP OF POUR No. 1 FOR TESTING.

18. POUR DRILLED SHAFT No. 1 UP TO POUR No. 2, PERMANENT CASING TO REMAIN. CORE AND CHIP/OUT OPENINGS IN EXISTING ABUTMENTS. CUTOUT CASING AT INTERFACE WITH CONCRETE ARM AND REMOVE STYROFOAM BLOCKOUT INSIDE CASING FORM AND POUR CONCRETE CANTILEVER ARM. TAKE CONCRETE CYLINDERS TO VERIFY CONCRETE STRENGTH AT 3, 7, AND 28 DAYS. Cantilevered Concrete Arms for Shaft Nos. 1 and 2 and Cross Beam Poured Monolithically With Pour No. 2

19. COVER SHAFT No. 1 EXCAVATION TO PERMIT TRAFFIC OVER IT.

20. REPEAT STEP 1 AND 2 FOR SHAFT No. 2. POUR CONCRETE CROSS-BEAM BETWEEN CANTILEVER ARMS.

21. REPEAT STEP 3 FOR SHAFT No. 2

22. JACK ABUTMENT TO TRANSFER WEIGHT ONTO DRILLED SHAFTS. SEE NOTES A.3 ON THIS SHEET. KEEP VEHICLES OFF STRUCTURE DURING LAST MOVEMENT OF LOAD TRANSFER AT STEP 9.

23. AT SHAFT No. 2 PROVIDE DRILL-IN DOWELS FROM EXTERIOR GIRDERS. FORM AND POUR NEW GIRDER EXTENSION AND POUR No. 3 OF DRILLED SHAFT.

24. REPEAT STEP 7 FOR SHAFT No. 1.

25. REPEAT STEP 3 FOR SHAFT No. 2

26. REPEAT STEP 1 AND 2 FOR SHAFT No. 2. POUR CONCRETE CROSS-BEAM BETWEEN CANTILEVER ARMS.

27. REPEAT STEP 1 AND 2 FOR SHAFT No. 1. UP TO POUR No. 1 AND REMOVE TEMPORARY CASING, IF PROVIDED. TAKE CONCRETE CYLINDERS TO VERIFY CONCRETE STRENGTH AT 3, 7, AND 28 DAYS. TAKE 3 CORE SAMPLES AT TOP OF POUR No. 1 FOR TESTING.

28. POUR DRILLED SHAFT No. 1 UP TO POUR No. 2, PERMANENT CASING TO REMAIN. CORE AND CHIP/OUT OPENINGS IN EXISTING ABUTMENTS. CUTOUT CASING AT INTERFACE WITH CONCRETE ARM AND REMOVE STYROFOAM BLOCKOUT INSIDE CASING FORM AND POUR CONCRETE CANTILEVER ARM. TAKE CONCRETE CYLINDERS TO VERIFY CONCRETE STRENGTH AT 3, 7, AND 28 DAYS. Cantilevered Concrete Arms for Shaft Nos. 1 and 2 and Cross Beam Poured Monolithically With Pour No. 2

29. COVER SHAFT No. 1 EXCAVATION TO PERMIT TRAFFIC OVER IT.

30. REPEAT STEP 1 AND 2 FOR SHAFT No. 2. POUR CONCRETE CROSS-BEAM BETWEEN CANTILEVER ARMS.

31. REPEAT STEP 3 FOR SHAFT No. 2

32. JACK ABUTMENT TO TRANSFER WEIGHT ONTO DRILLED SHAFTS. SEE NOTES A.3 ON THIS SHEET. KEEP VEHICLES OFF STRUCTURE DURING LAST MOVEMENT OF LOAD TRANSFER AT STEP 9.

33. AT SHAFT No. 2 PROVIDE DRILL-IN DOWELS FROM EXTERIOR GIRDERS. FORM AND POUR NEW GIRDER EXTENSION AND POUR No. 3 OF DRILLED SHAFT.

34. REPEAT STEP 7 FOR SHAFT No. 1.

35. REPEAT STEP 3 FOR SHAFT No. 2

36. REPEAT STEP 1 AND 2 FOR SHAFT No. 2. POUR CONCRETE CROSS-BEAM BETWEEN CANTILEVER ARMS.

37. REPEAT STEP 1 AND 2 FOR SHAFT No. 1. UP TO POUR No. 1 AND REMOVE TEMPORARY CASING, IF PROVIDED. TAKE CONCRETE CYLINDERS TO VERIFY CONCRETE STRENGTH AT 3, 7, AND 28 DAYS. TAKE 3 CORE SAMPLES AT TOP OF POUR No. 1 FOR TESTING.

38. POUR DRILLED SHAFT No. 1 UP TO POUR No. 2, PERMANENT CASING TO REMAIN. CORE AND CHIP/OUT OPENINGS IN EXISTING ABUTMENTS. CUTOUT CASING AT INTERFACE WITH CONCRETE ARM AND REMOVE STYROFOAM BLOCKOUT INSIDE CASING FORM AND POUR CONCRETE CANTILEVER ARM. TAKE CONCRETE CYLINDERS TO VERIFY CONCRETE STRENGTH AT 3, 7, AND 28 DAYS. Cantilevered Concrete Arms for Shaft Nos. 1 and 2 and Cross Beam Poured Monolithically With Pour No. 2

39. COVER SHAFT No. 1 EXCAVATION TO PERMIT TRAFFIC OVER IT.

40. REPEAT STEP 1 AND 2 FOR SHAFT No. 2. POUR CONCRETE CROSS-BEAM BETWEEN CANTILEVER ARMS.

41. REPEAT STEP 3 FOR SHAFT No. 2

42. JACK ABUTMENT TO TRANSFER WEIGHT ONTO DRILLED SHAFTS. SEE NOTES A.3 ON THIS SHEET. KEEP VEHICLES OFF STRUCTURE DURING LAST MOVEMENT OF LOAD TRANSFER AT STEP 9.

43. AT SHAFT No. 2 PROVIDE DRILL-IN DOWELS FROM EXTERIOR GIRDERS. FORM AND POUR NEW GIRDER EXTENSION AND POUR No. 3 OF DRILLED SHAFT.

44. REPEAT STEP 7 FOR SHAFT No. 1.

45. REPEAT STEP 3 FOR SHAFT No. 2

46. REPEAT STEP 1 AND 2 FOR SHAFT No. 2. POUR CONCRETE CROSS-BEAM BETWEEN CANTILEVER ARMS.

47. REPEAT STEP 1 AND 2 FOR SHAFT No. 1. UP TO POUR No. 1 AND REMOVE TEMPORARY CASING, IF PROVIDED. TAKE CONCRETE CYLINDERS TO VERIFY CONCRETE STRENGTH AT 3, 7, AND 28 DAYS. TAKE 3 CORE SAMPLES AT TOP OF POUR No. 1 FOR TESTING.

48. POUR DRILLED SHAFT No. 1 UP TO POUR No. 2, PERMANENT CASING TO REMAIN. CORE AND CHIP/OUT OPENINGS IN EXISTING ABUTMENTS. CUTOUT CASING AT INTERFACE WITH CONCRETE ARM AND REMOVE STYROFOAM BLOCKOUT INSIDE CASING FORM AND POUR CONCRETE CANTILEVER ARM. TAKE CONCRETE CYLINDERS TO VERIFY CONCRETE STRENGTH AT 3, 7, AND 28 DAYS. Cantilevered Concrete Arms for Shaft Nos. 1 and 2 and Cross Beam Poured Monolithically With Pour No. 2

49. COVER SHAFT No. 1 EXCAVATION TO PERMIT TRAFFIC OVER IT.

50. REPEAT STEP 1 AND 2 FOR SHAFT No. 2. POUR CONCRETE CROSS-BEAM BETWEEN CANTILEVER ARMS.

51. REPEAT STEP 3 FOR SHAFT No. 2

52. JACK ABUTMENT TO TRANSFER WEIGHT ONTO DRILLED SHAFTS. SEE NOTES A.3 ON THIS SHEET. KEEP VEHICLES OFF STRUCTURE DURING LAST MOVEMENT OF LOAD TRANSFER AT STEP 9.

53. AT SHAFT No. 2 PROVIDE DRILL-IN DOWELS FROM EXTERIOR GIRDERS. FORM AND POUR NEW GIRDER EXTENSION AND POUR No. 3 OF DRILLED SHAFT.

54. REPEAT STEP 7 FOR SHAFT No. 1.

55. REPEAT STEP 3 FOR SHAFT No. 2

56. REPEAT STEP 1 AND 2 FOR SHAFT No. 2. POUR CONCRETE CROSS-BEAM BETWEEN CANTILEVER ARMS.

57. REPEAT STEP 1 AND 2 FOR SHAFT No. 1. UP TO POUR No. 1 AND REMOVE TEMPORARY CASING, IF PROVIDED. TAKE CONCRETE CYLINDERS TO VERIFY CONCRETE STRENGTH AT 3, 7, AND 28 DAYS. TAKE 3 CORE SAMPLES AT TOP OF POUR No. 1 FOR TESTING.

58. POUR DRILLED SHAFT No. 1 UP TO POUR No. 2, PERMANENT CASING TO REMAIN. CORE AND CHIP/OUT OPENINGS IN EXISTING ABUTMENTS. CUTOUT CASING AT INTERFACE WITH CONCRETE ARM AND REMOVE STYROFOAM BLOCKOUT INSIDE CASING FORM AND POUR CONCRETE CANTILEVER ARM. TAKE CONCRETE CYLINDERS TO VERIFY CONCRETE STRENGTH AT 3, 7, AND 28 DAYS. Cantilevered Concrete Arms for Shaft Nos. 1 and 2 and Cross Beam Poured Monolithically With Pour No. 2

59. COVER SHAFT No. 1 EXCAVATION TO PERMIT TRAFFIC OVER IT.

60. REPEAT STEP 1 AND 2 FOR SHAFT No. 2. POUR CONCRETE CROSS-BEAM BETWEEN CANTILEVER ARMS.

61. REPEAT STEP 3 FOR SHAFT No. 2

62. JACK ABUTMENT TO TRANSFER WEIGHT ONTO DRILLED SHAFTS. SEE NOTES A.3 ON THIS SHEET. KEEP VEHICLES OFF STRUCTURE DURING LAST MOVEMENT OF LOAD TRANSFER AT STEP 9.

63. AT SHAFT No. 2 PROVIDE DRILL-IN DOWELS FROM EXTERIOR GIRDERS. FORM AND POUR NEW GIRDER EXTENSION AND POUR No. 3 OF DRILLED SHAFT.

64. REPEAT STEP 7 FOR SHAFT No. 1.

65. REPEAT STEP 3 FOR SHAFT No. 2

66. REPEAT STEP 1 AND 2 FOR SHAFT No. 2. POUR CONCRETE CROSS-BEAM BETWEEN CANTILEVER ARMS.

67. REPEAT STEP 1 AND 2 FOR SHAFT No. 1. UP TO POUR No. 1 AND REMOVE TEMPORARY CASING, IF PROVIDED. TAKE CONCRETE CYLINDERS TO VERIFY CONCRETE STRENGTH AT 3, 7, AND 28 DAYS. TAKE 3 CORE SAMPLES AT TOP OF POUR No. 1 FOR TESTING.

68. POUR DRILLED SHAFT No. 1 UP TO POUR No. 2, PERMANENT CASING TO REMAIN. CORE AND CHIP/OUT OPENINGS IN EXISTING ABUTMENTS. CUTOUT CASING AT INTERFACE WITH CONCRETE ARM AND REMOVE STYROFOAM BLOCKOUT INSIDE CASING FORM AND POUR CONCRETE CANTILEVER ARM. TAKE CONCRETE CYLINDERS TO VERIFY CONCRETE STRENGTH AT 3, 7, AND 28 DAYS. Cantilevered Concrete Arms for Shaft Nos. 1 and 2 and Cross Beam Poured Monolithically With Pour No. 2

69. COVER SHAFT No. 1 EXCAVATION TO PERMIT TRAFFIC OVER IT.

70. REPEAT STEP 1 AND 2 FOR SHAFT No. 2. POUR CONCRETE CROSS-BEAM BETWEEN CANTILEVER ARMS.

71. REPEAT STEP 3 FOR SHAFT No. 2

72. JACK ABUTMENT TO TRANSFER WEIGHT ONTO DRILLED SHAFTS. SEE NOTES A.3 ON THIS SHEET. KEEP VEHICLES OFF STRUCTURE DURING LAST MOVEMENT OF LOAD TRANSFER AT STEP 9.

73. AT SHAFT No. 2 PROVIDE DRILL-IN DOWELS FROM EXTERIOR GIRDERS. FORM AND POUR NEW GIRDER EXTENSION AND POUR No. 3 OF DRILLED SHAFT.

74. REPEAT STEP 7 FOR SHAFT No. 1.

75. REPEAT STEP 3 FOR SHAFT No. 2

76. REPEAT STEP 1 AND 2 FOR SHAFT No. 2. POUR CONCRETE CROSS-BEAM BETWEEN CANTILEVER ARMS.

77. REPEAT STEP 1 AND 2 FOR SHAFT No. 1. UP TO POUR No. 1 AND REMOVE TEMPORARY CASING, IF PROVIDED. TAKE CONCRETE CYLINDERS TO VERIFY CONCRETE STRENGTH AT 3, 7, AND 28 DAYS. TAKE 3 CORE SAMPLES AT TOP OF POUR No. 1 FOR TESTING.

78. POUR DRILLED SHAFT No. 1 UP TO POUR No. 2, PERMANENT CASING TO REMAIN. CORE AND CHIP/OUT OPENINGS IN EXISTING ABUTMENTS. CUTOUT CASING AT INTERFACE WITH CONCRETE ARM AND REMOVE STYROFOAM BLOCKOUT INSIDE CASING FORM AND POUR CONCRETE CANTILEVER ARM. TAKE CONCRETE CYLINDERS TO VERIFY CONCRETE STRENGTH AT 3, 7, AND 28 DAYS. Cantilevered Concrete Arms for Shaft Nos. 1 and 2 and Cross Beam Poured Monolithically With Pour No. 2

79. COVER SHAFT No. 1 EXCAVATION TO PERMIT TRAFFIC OVER IT.

80. REPEAT STEP 1 AND 2 FOR SHAFT No. 2. POUR CONCRETE CROSS-BEAM BETWEEN CANTILEVER ARMS.

81. REPEAT STEP 3 FOR SHAFT No. 2

82. JACK ABUTMENT TO TRANSFER WEIGHT ONTO DRILLED SHAFTS. SEE NOTES A.3 ON THIS SHEET. KEEP VEHICLES OFF STRUCTURE DURING LAST MOVEMENT OF LOAD TRANSFER AT STEP 9.

83. AT SHAFT No. 2 PROVIDE DRILL-IN DOWELS FROM EXTERIOR GIRDERS. FORM AND POUR NEW GIRDER EXTENSION AND POUR No. 3 OF DRILLED SHAFT.

84. REPEAT STEP 7 FOR SHAFT No. 1.

85. REPEAT STEP 3 FOR SHAFT No. 2


86. REPEAT STEP 1 AND 2 FOR SHAFT No. 2. POUR CONCRETE CROSS-BEAM BETWEEN CANT

PROBE DOWN TO DETERMINE LOCATION OF FOOTING EDGE BEFORE STARTING DRILLING FOR SHAFTS TYP. PROVIDE AS


9. SYMM. OF BRIDGE

OPP.

MONITOR MOVEMENT OF BRIDGE

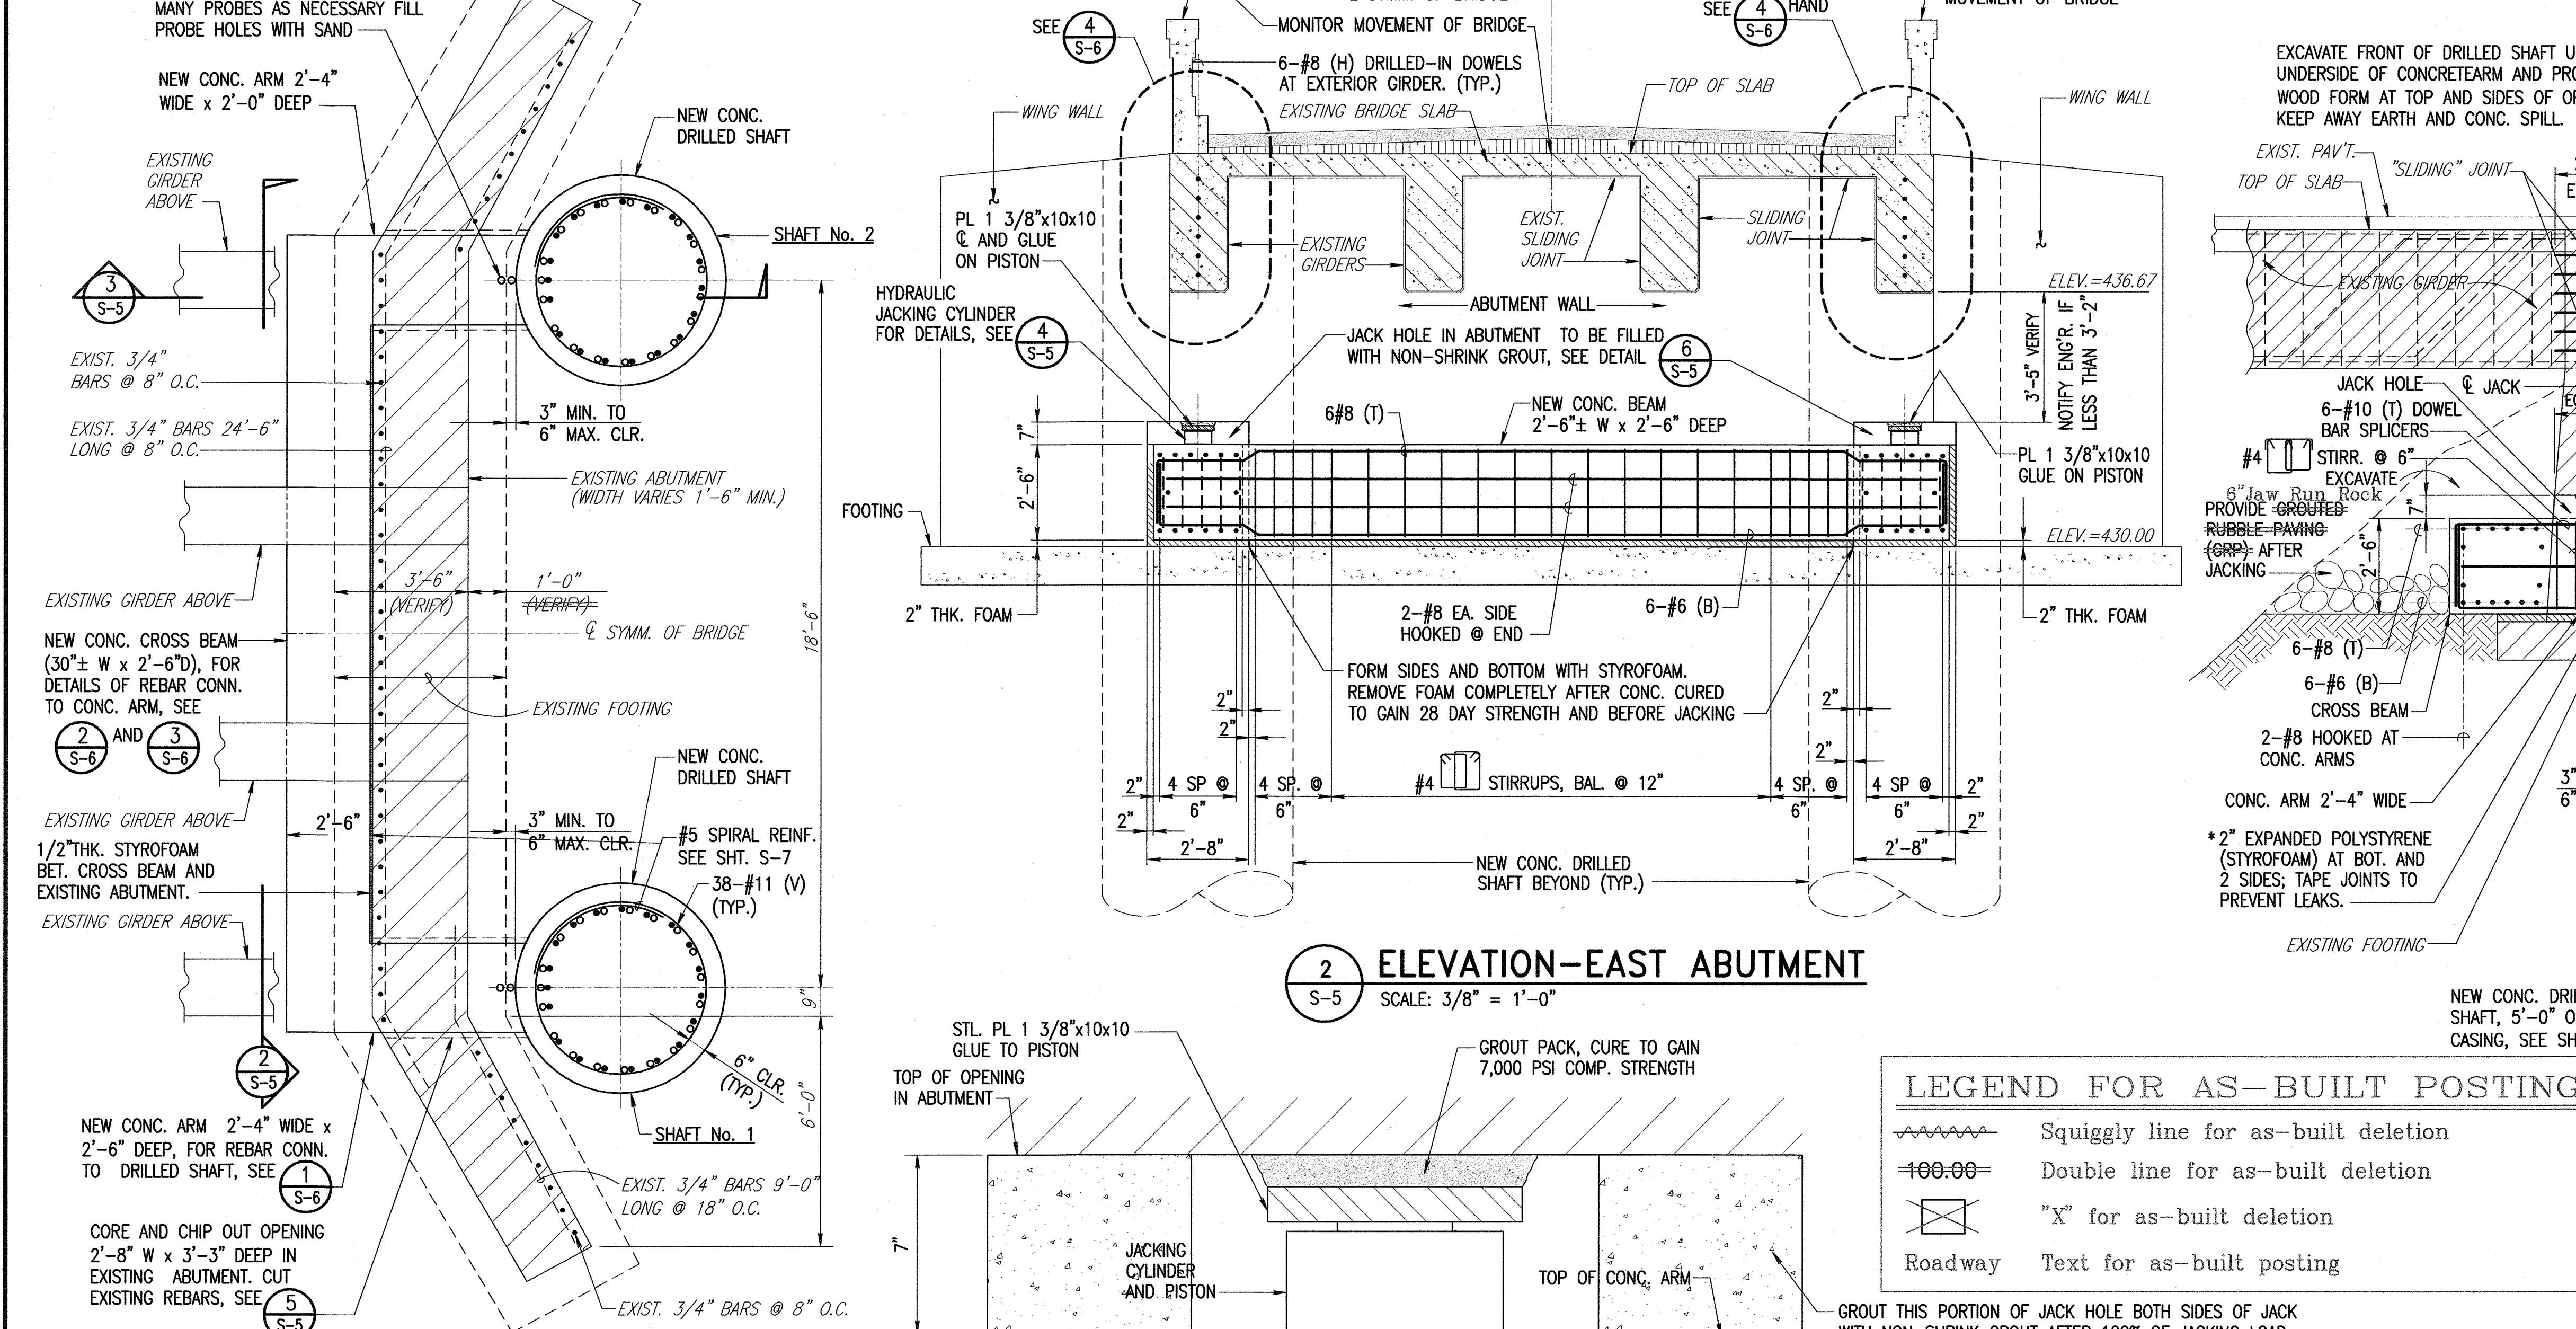

1 PLAN-SECTION OF EAST ABUTMENT
S-5 SCALE: $\frac{3}{8}" = 1'-0"$

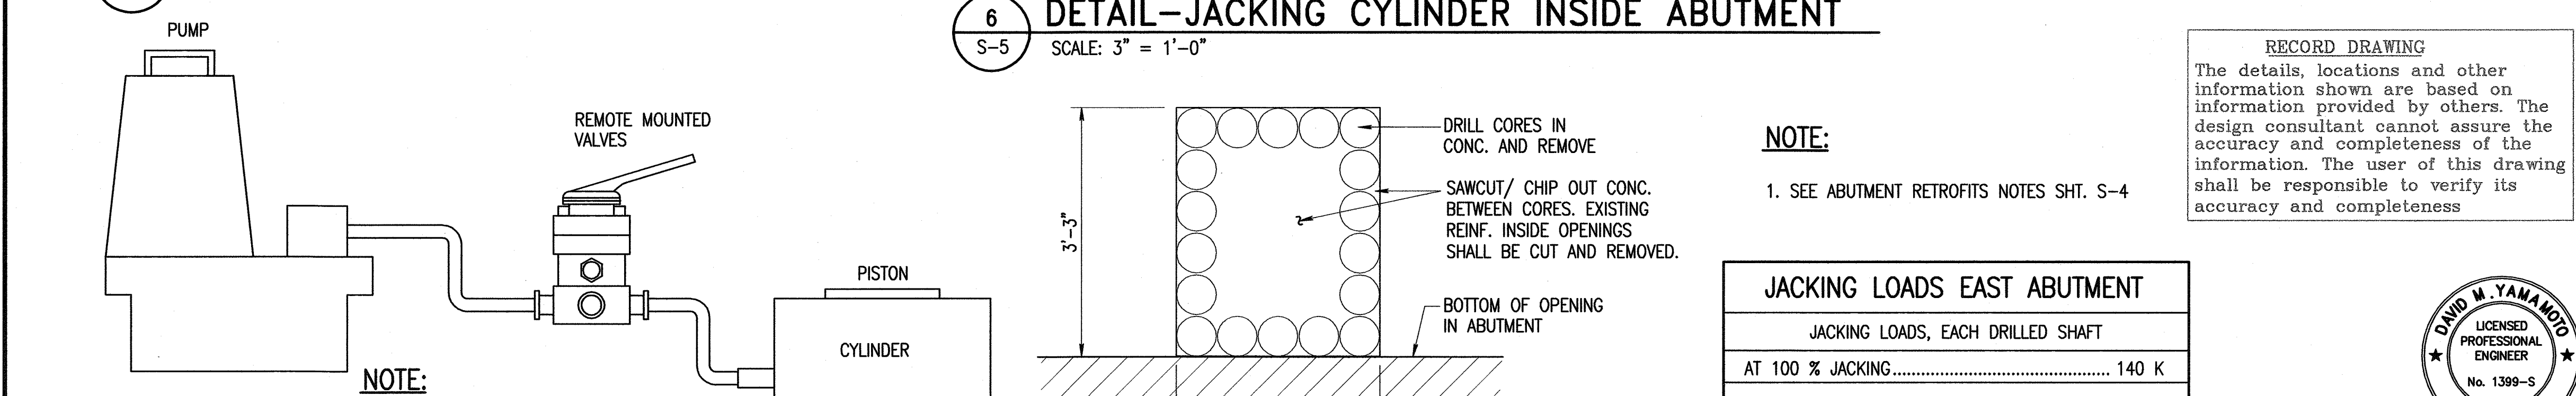

EXISTING GIRDER ABOVE



EXISTING FOOTING

NEW CONC. DRILL

2
S-5

ELEVATION-EAST ABUTMENT

SCALE: $\frac{3}{8}'' = 1'-0''$

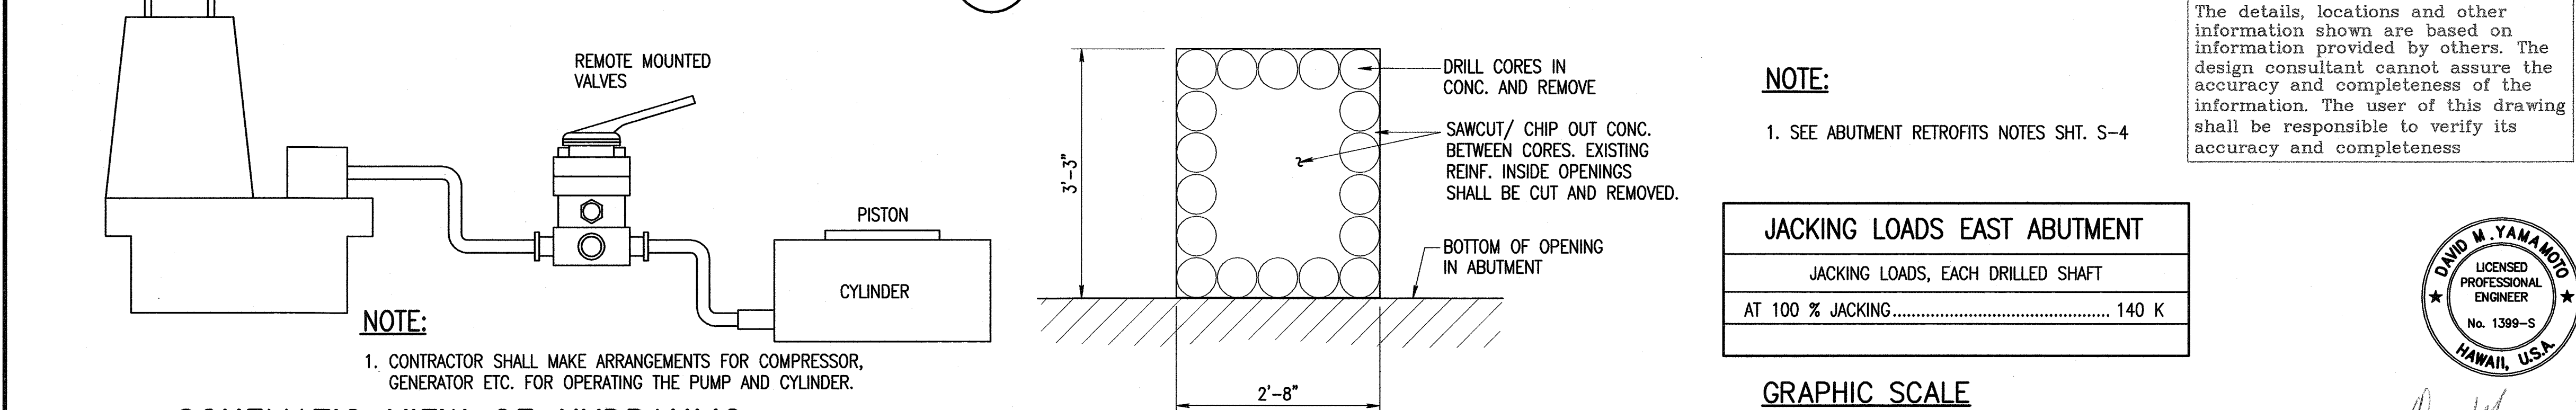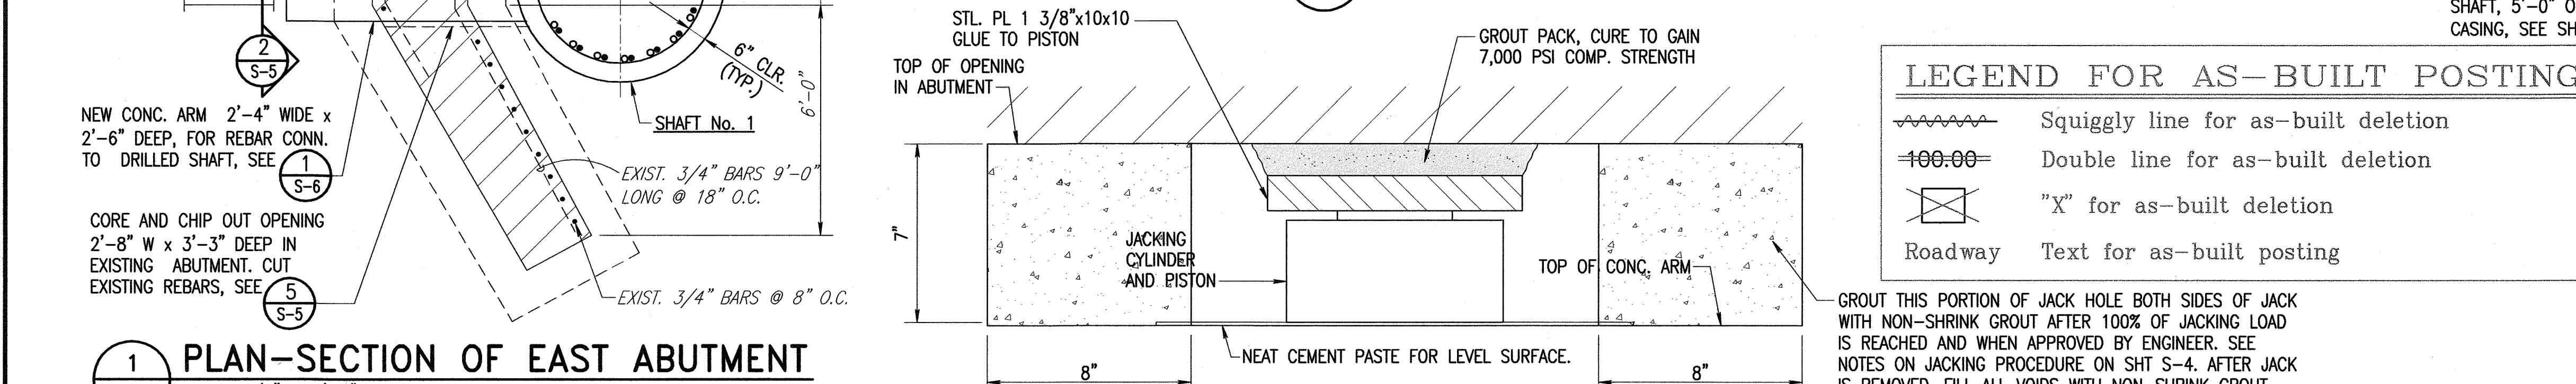

1 PLAN-SECTION OF EAST ABUTMENT
 SCALE: $\frac{3}{8}" = 1'-0"$

2 DETAIL-JACKING CYLINDER INSIDE ABUTMENT
 SCALE: $3" = 1'-0"$

3 RECORD DRAWING

EXISTING ABUTMENT: CUT EXISTING REBARS, SEE 5 S-5

EXIST. $\frac{3}{4}"$ BARS @ $8" O.C.$

PUMP

REMOTE MOUNTED VALVES

AND PISTON

NEAT CEMENT PASTE FOR LEVEL SURFACE.

TOP OF CONC. ARM

GROUT THIS PORTION OF JACK HOLE BOTH SIDES OF JACK WITH NON-SHRINK GROUT AFTER 100% OF JACKING LOAD IS REACHED AND WHEN APPROVED BY ENGINEER. SEE NOTES ON JACKING PROCEDURE ON SHT S-4. AFTER JACK IS REMOVED, FILL ALL VOIDS WITH NON-SHRINK GROUT.

NOTE:

1. SEE ABUTMENT RETROFITS NOTES SHT. S-4

NOTE: REIN. INSIDE OPENINGS SHALL BE CUT AND REMOVED.

2' 0"

PISTON

CYLINDER


BOTTOM OF OPENING IN ABUTMENT

| JACKING LOADS EAST ABUTMENT | |
|-----------------------------------|-------|
| JACKING LOADS, EACH DRILLED SHAFT | |
| AT 100 % JACKING..... | 140 K |

1. CONTRACTOR SHALL MAKE ARRANGEMENTS FOR COMPRESSOR, GENERATOR ETC. FOR OPERATING THE PUMP AND CYLINDER.


2'-8"

GRAPHIC SCALE

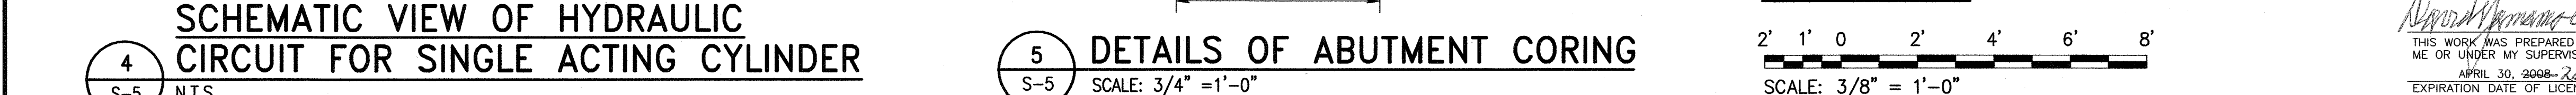


The details, locations and other information shown are based on information provided by others. The

Diagram illustrating the removal of mounted valves and the drilling of cores in concrete. The diagram shows a cross-section of a concrete structure with a row of circles representing valves. A label 'REMOVE MOUNTED VALVES' points to the top of the valves. Another label 'DRILL CORES IN CONC. AND REMOVE' points to the concrete above the valves. A third label 'SAWCUT/ CHIP OUT CONC.' points to the concrete below the valves.



SCHEMATIC VIEW OF HYDRAULIC CIRCUIT FOR SINGLE ACTING CYLINDER

4
S-5 N.T.S.

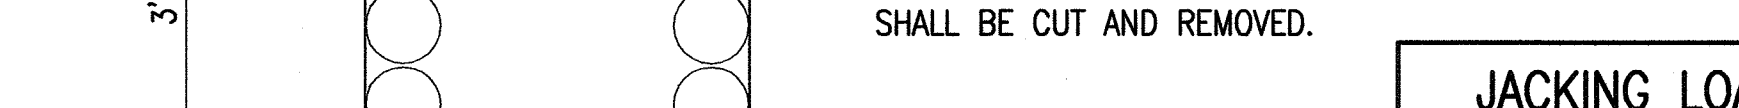

DETAILS OF ABUTMENT CORING


5
S-5 SCALE: 3/4" = 1'-0"

| |
|------------------------------------|
| JACKING LOADS EAST ABUTMENT |
| JACKING LOADS, EACH DRILLED SHAFT |
| AT 100 % JACKING..... 140 K |

GRAPHIC SCALE

2' 1' 0' 2' 4' 6' 8'

SCALE: 3/8" = 1'-0"




THIS WORK WAS PREPARED BY ME OR UNDER MY SUPERVISION
APRIL 30, 2008-2010
EXPIRATION DATE OF LICENSE


STATE OF HAWAII
 DEPARTMENT OF TRANSPORTATION
 HIGHWAYS DIVISION
RETROFITTING EAST ABUTMENT
WALAOHIA BRIDGE
 AKONI PULE HIGHWAY, SEISMIC RETROFIT
 OF WALAOHIA AND AAMAKAO BRIDGES;
 FAIP NO. BR-0270(18)
 SCALE: AS NOTED DATE: May 2006

SHEET No. **S - 5** OF 12 SHEETS


| FED. ROAD DIST. NO. | STATE | FED. AID PROJ. NO. | FISCAL YEAR | SHEET NO. | TOTAL SHEETS |
|---------------------|-------|--------------------|-------------|-----------|--------------|
| HAWAII | HAW. | BR-0270(18) | 2006 | 25 | 31 |

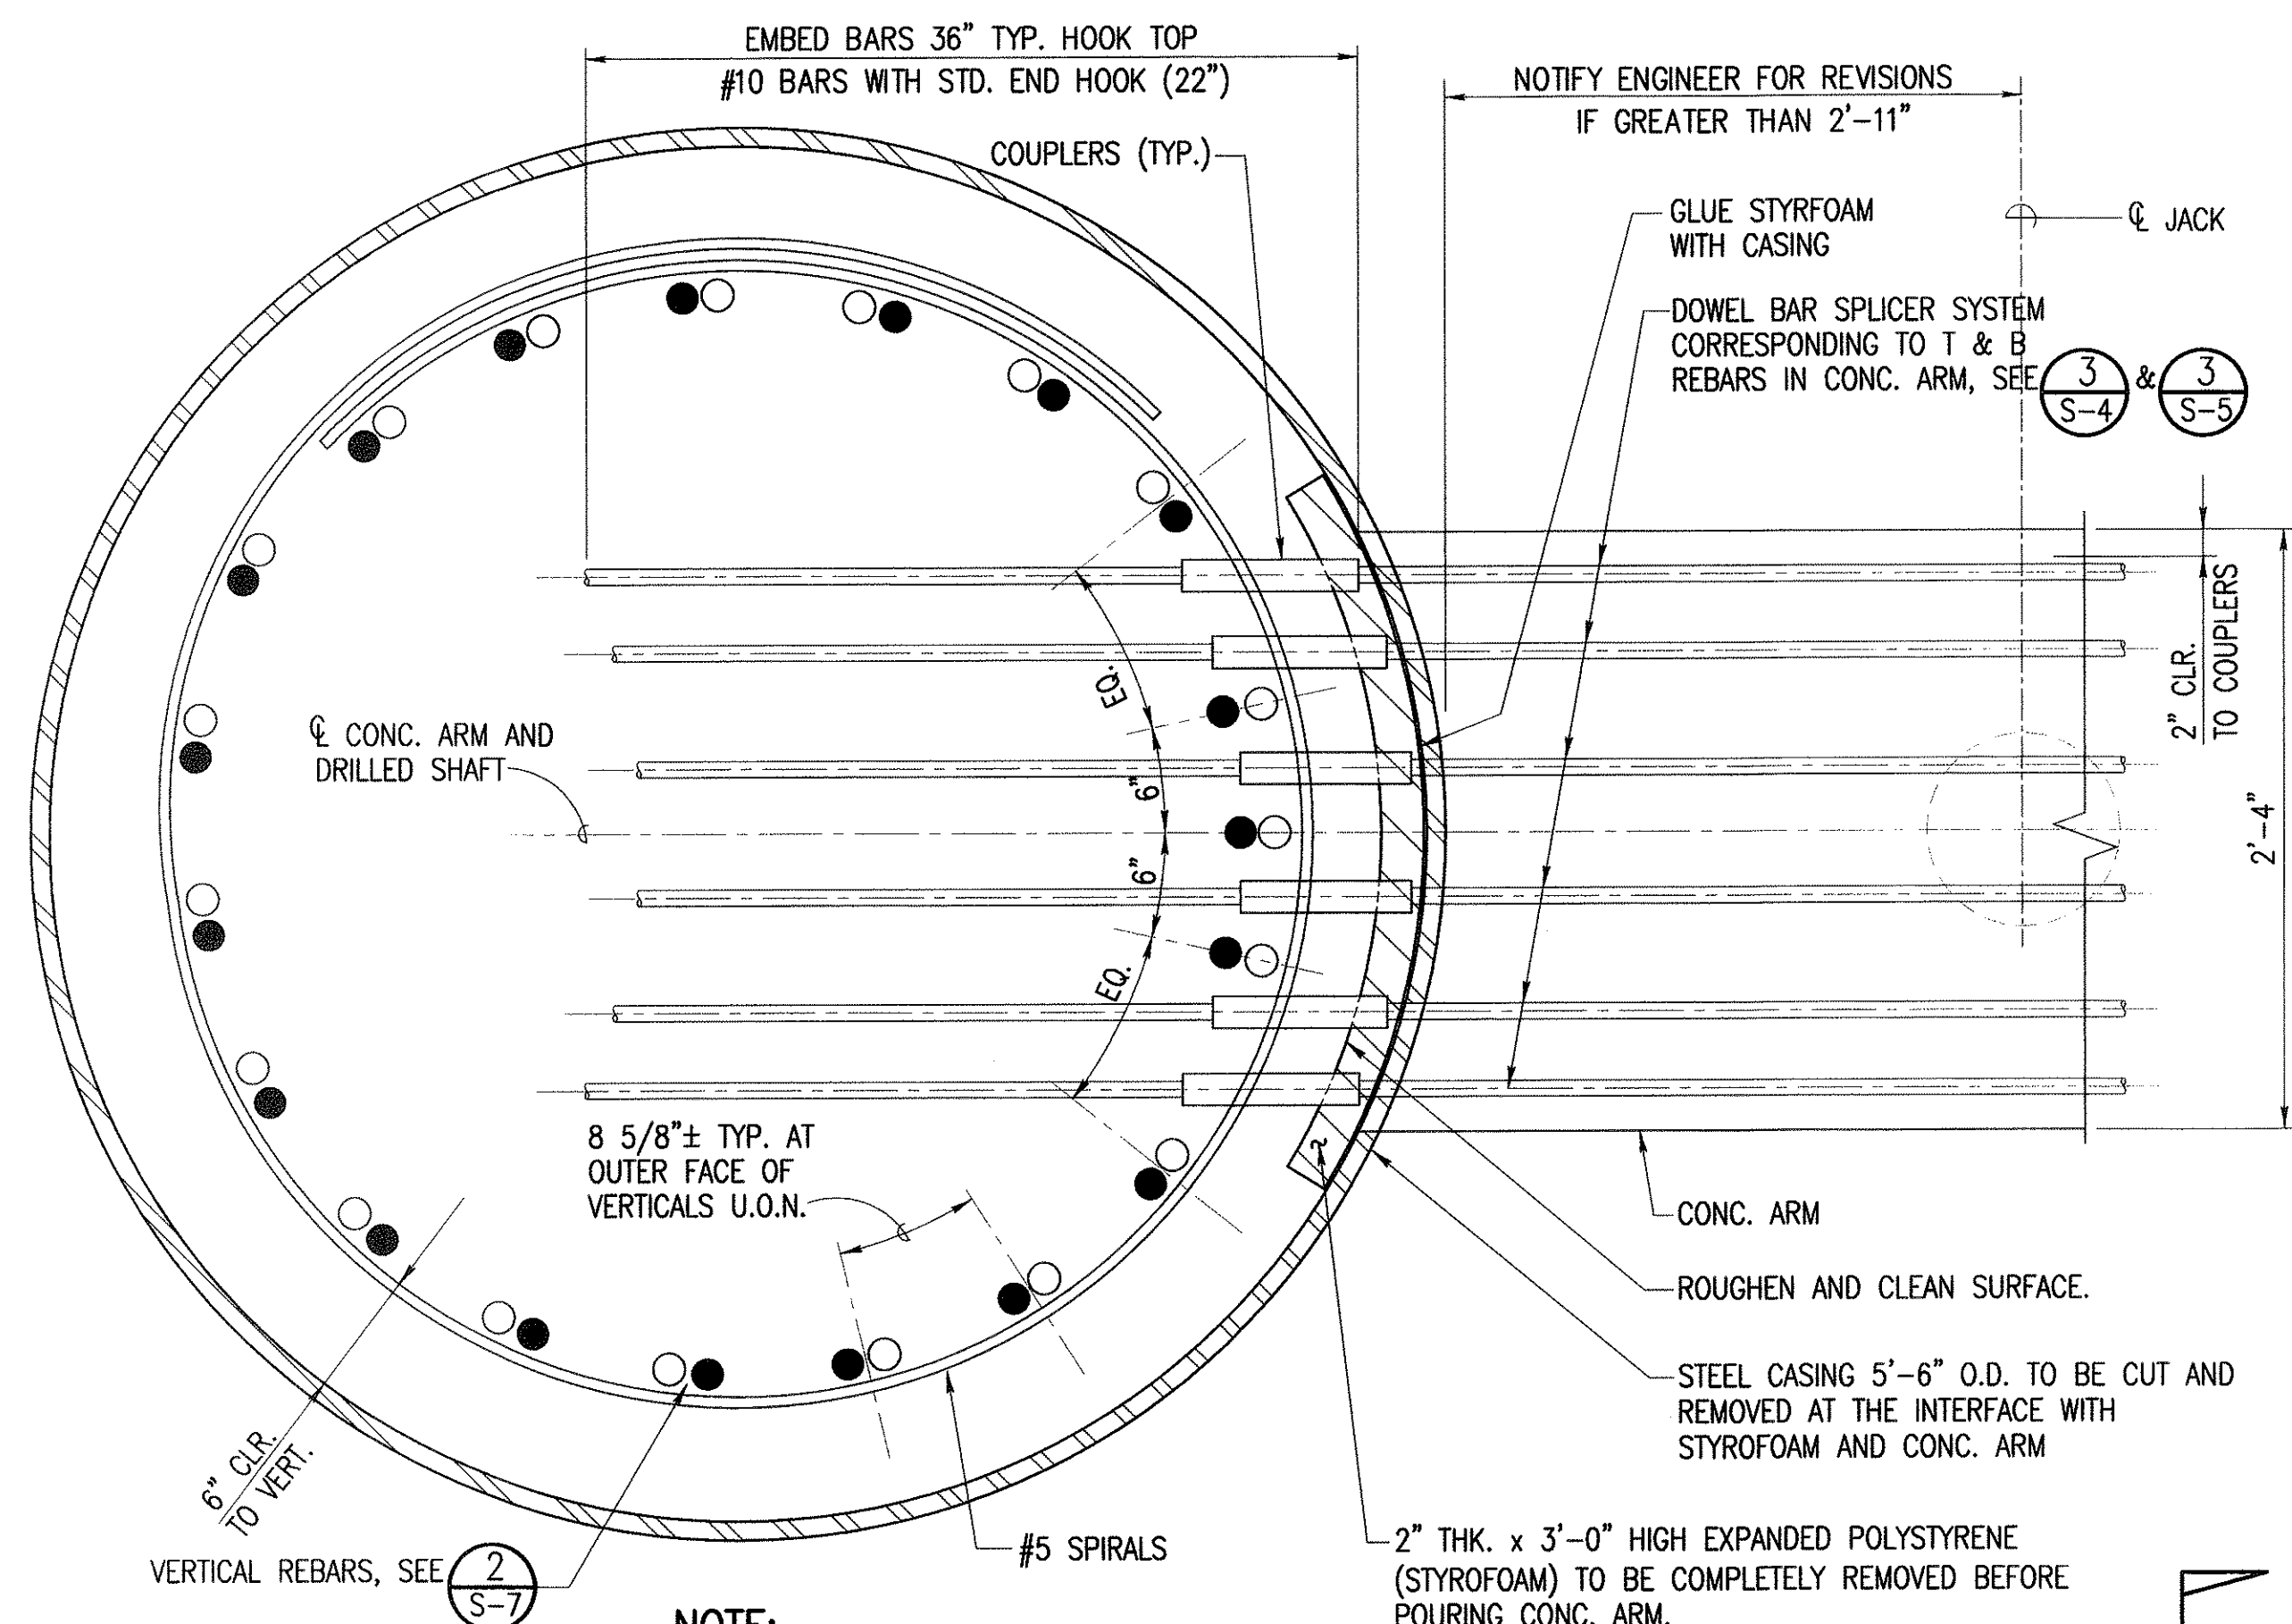


1 **DETAIL PLAN-CONC. ARM CONNECTION TO DRILLED SHAFT**
S-6 SCALE: 1 1/2" = 1'-0"

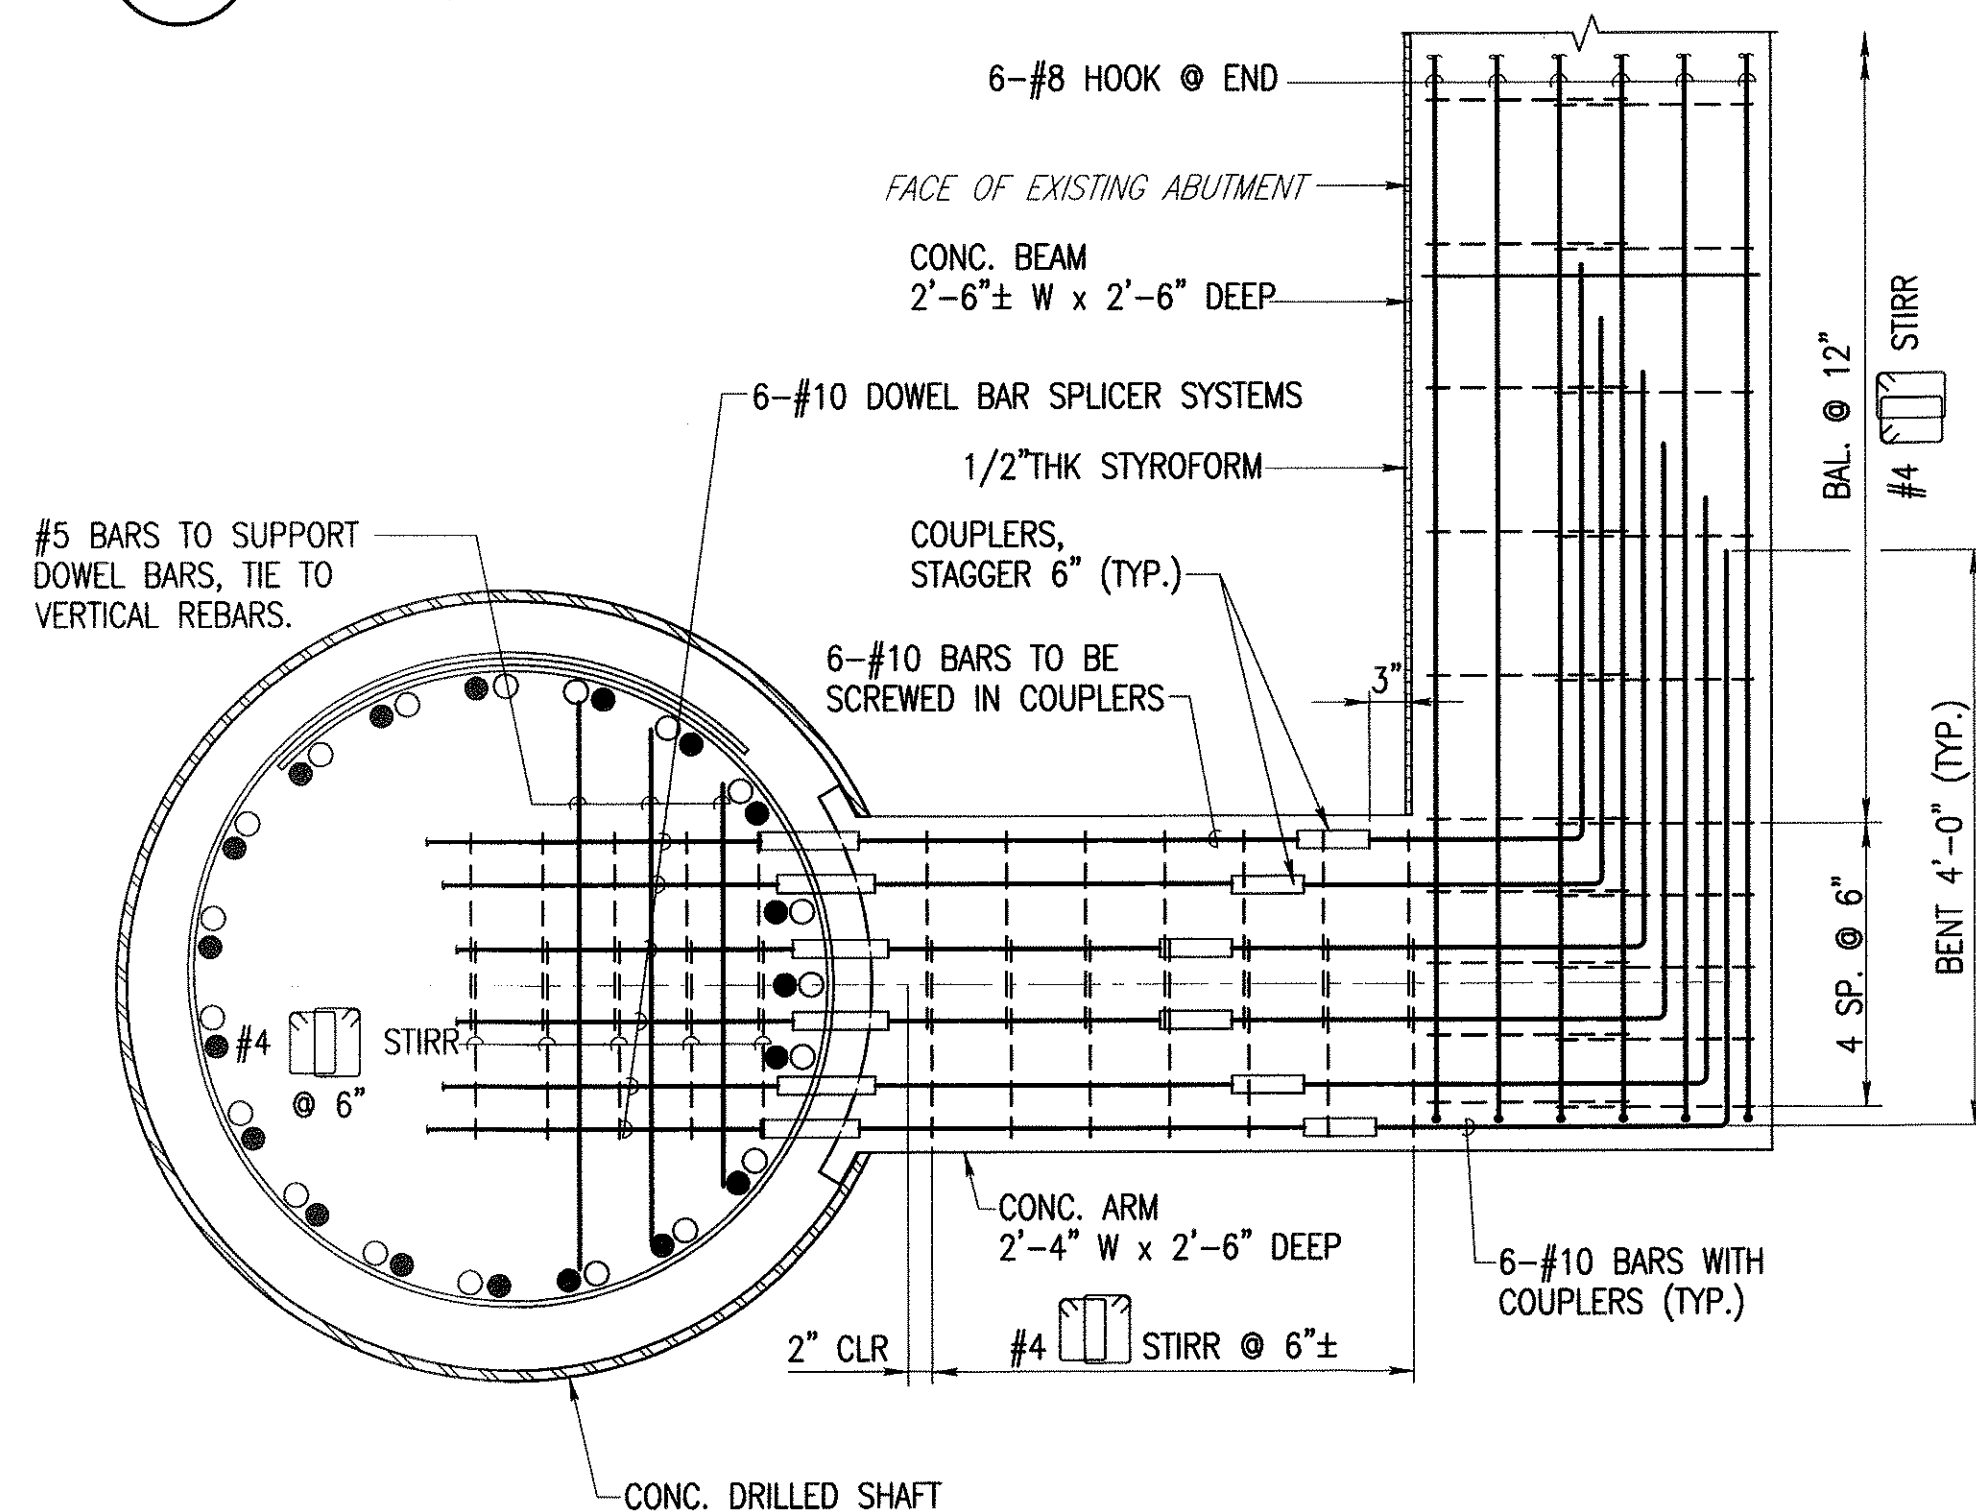

2 **DETAIL PLAN-CONCRETE ARM AND CROSS BEAM TOP REINFORCING**
S-6 SCALE: 3/4" = 1'-0"

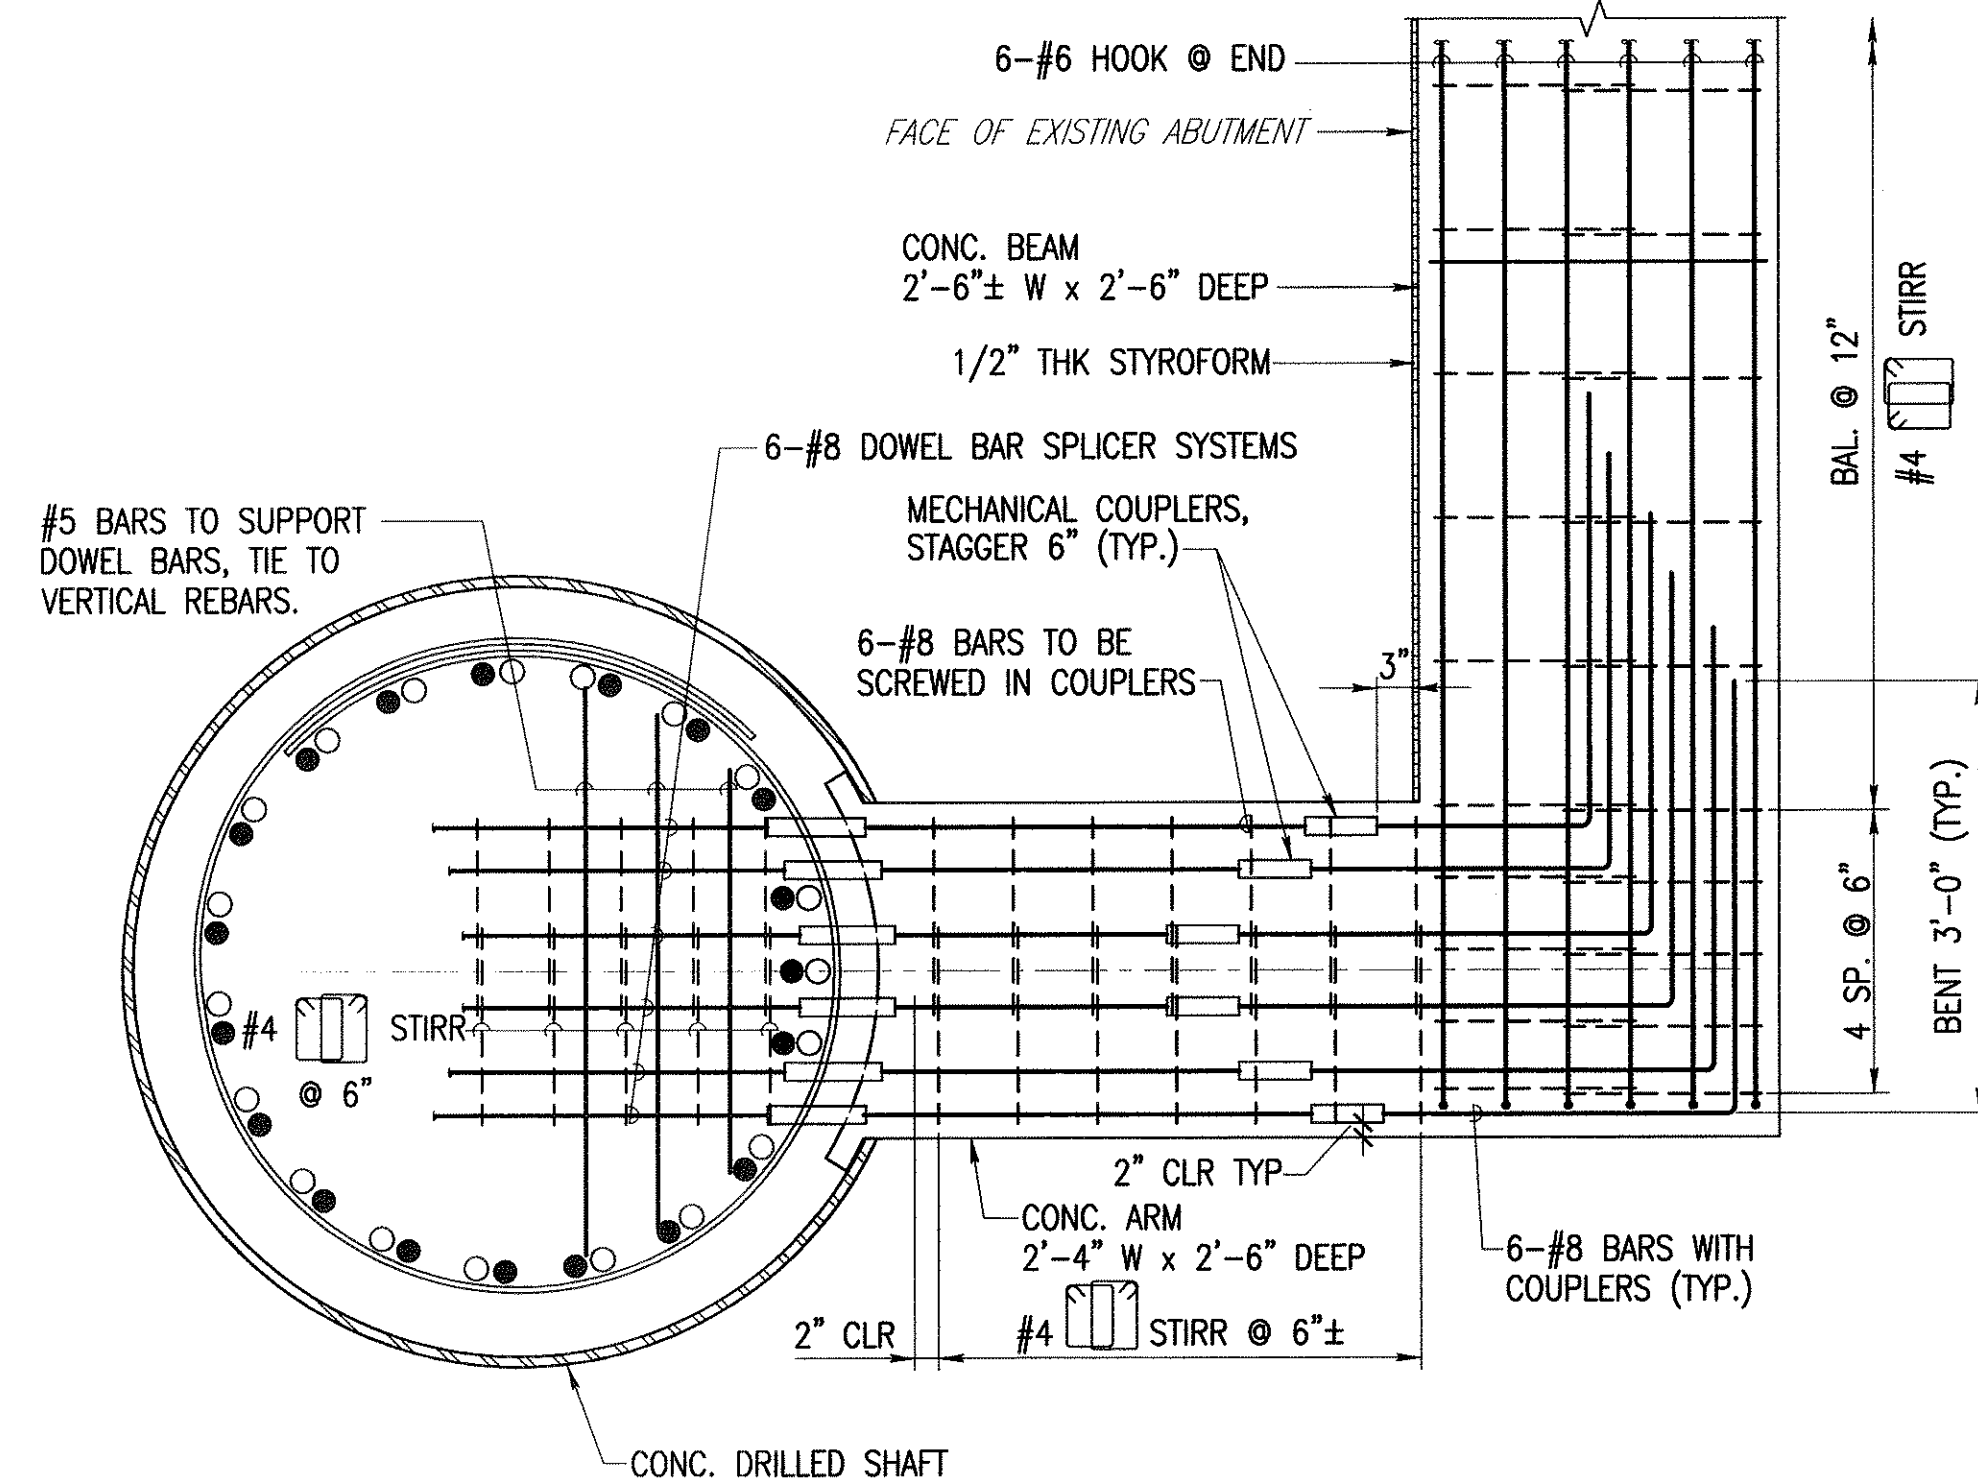


3 **DETAIL PLAN-CONCRETE ARM AND CROSS BEAM BOTTOM REINFORCING**
S-6 SCALE: 3/4" = 1'-0"

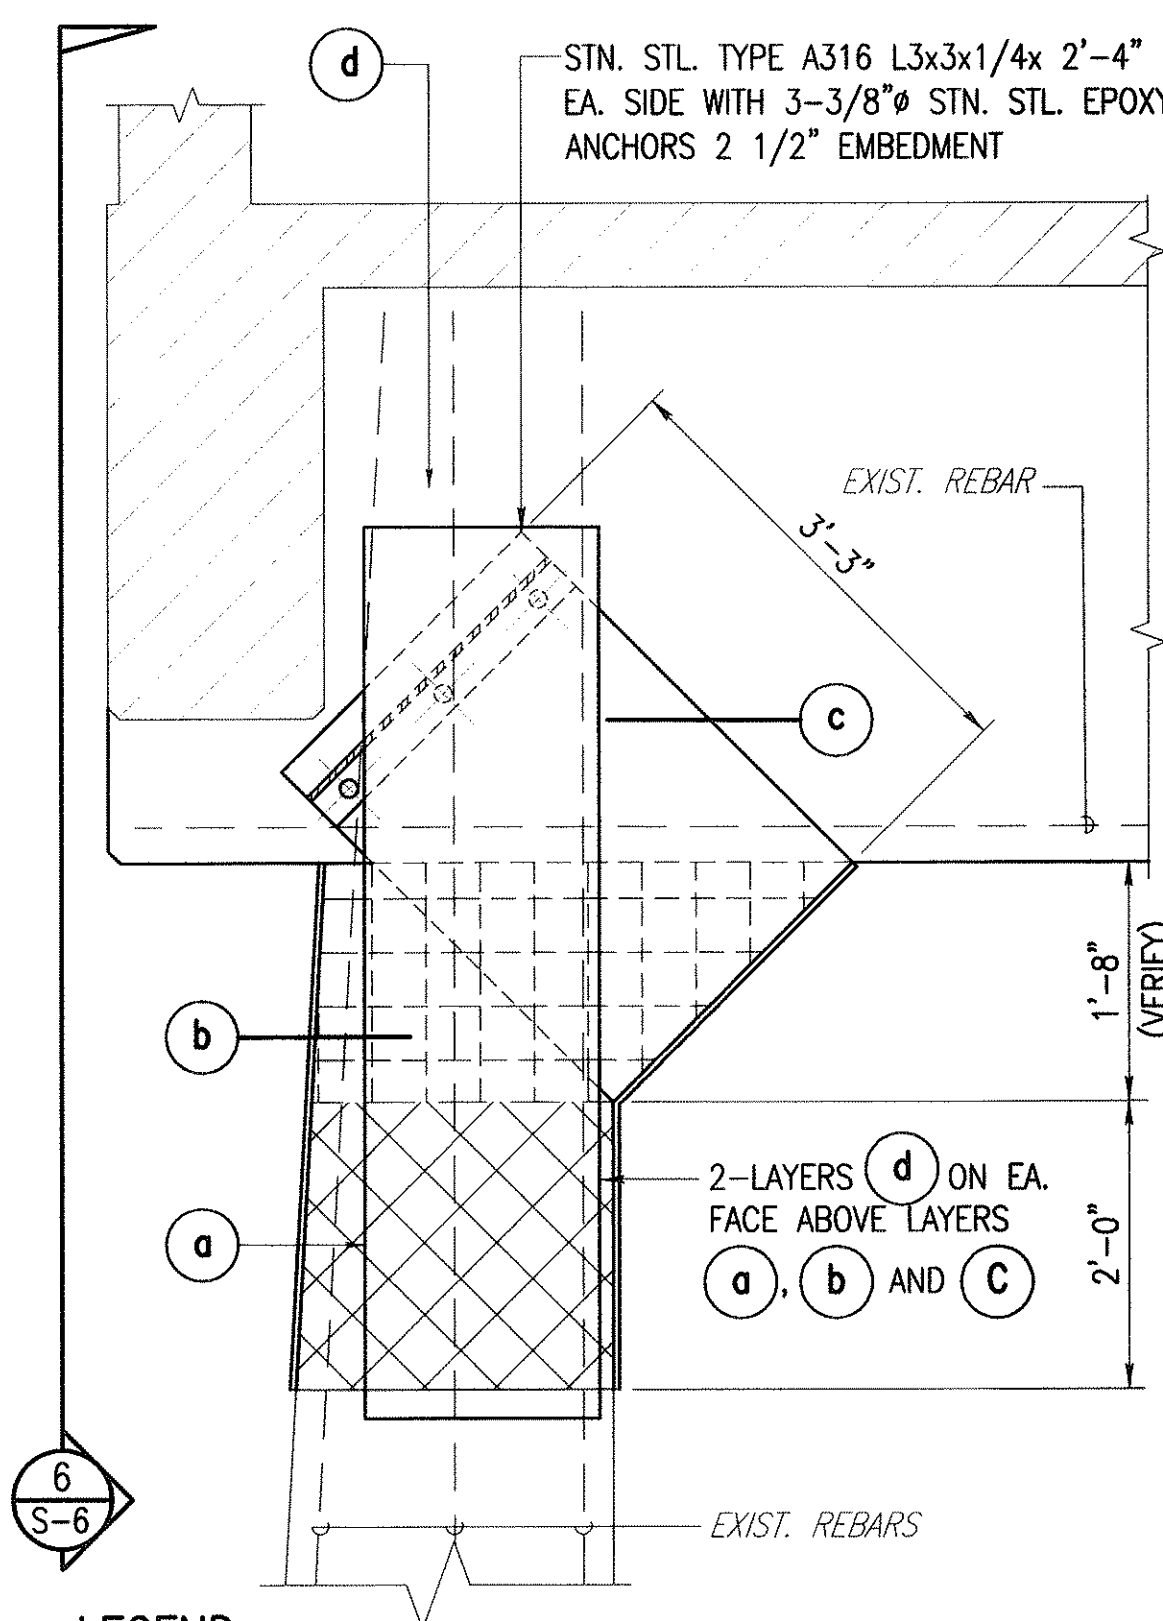


- LEGEND:**
- (a) - DENOTES 2 LAYERS OF COMPOSITE GLASS FIBER REINF. 4 SIDES.
 - (b), (c) - DENOTES 2 LAYERS OF COMPOSITE GLASS FIBER REINF. 3 SIDES.
 - (d) - DENOTES 2 LAYERS OF COMPOSITE GLASS FIBER REINF. 2 SIDES.

5 **DETAIL-'CFR' REPAIR AT COLUMN**
S-6 SCALE: 3/4" = 1'-0"

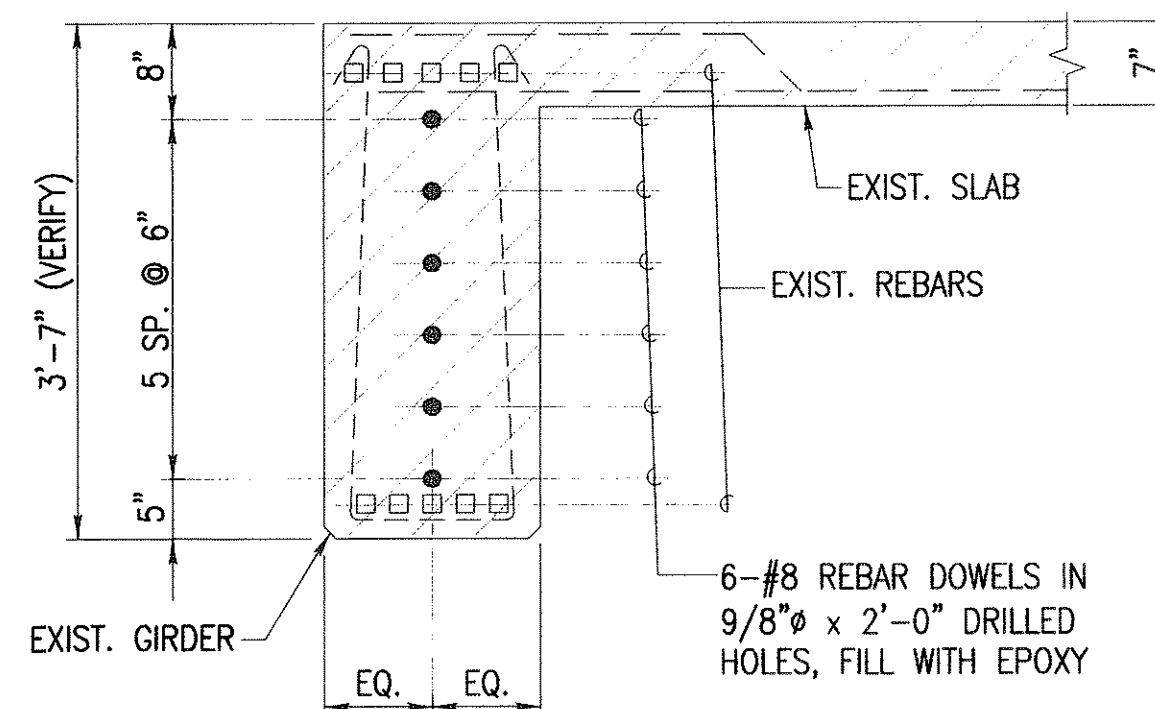

4 **DETAIL-ANCHORING ABUTMENT AT BRIDGE EXTERIOR GIRDERS**
S-6 SCALE: 3/4" = 1'-0"

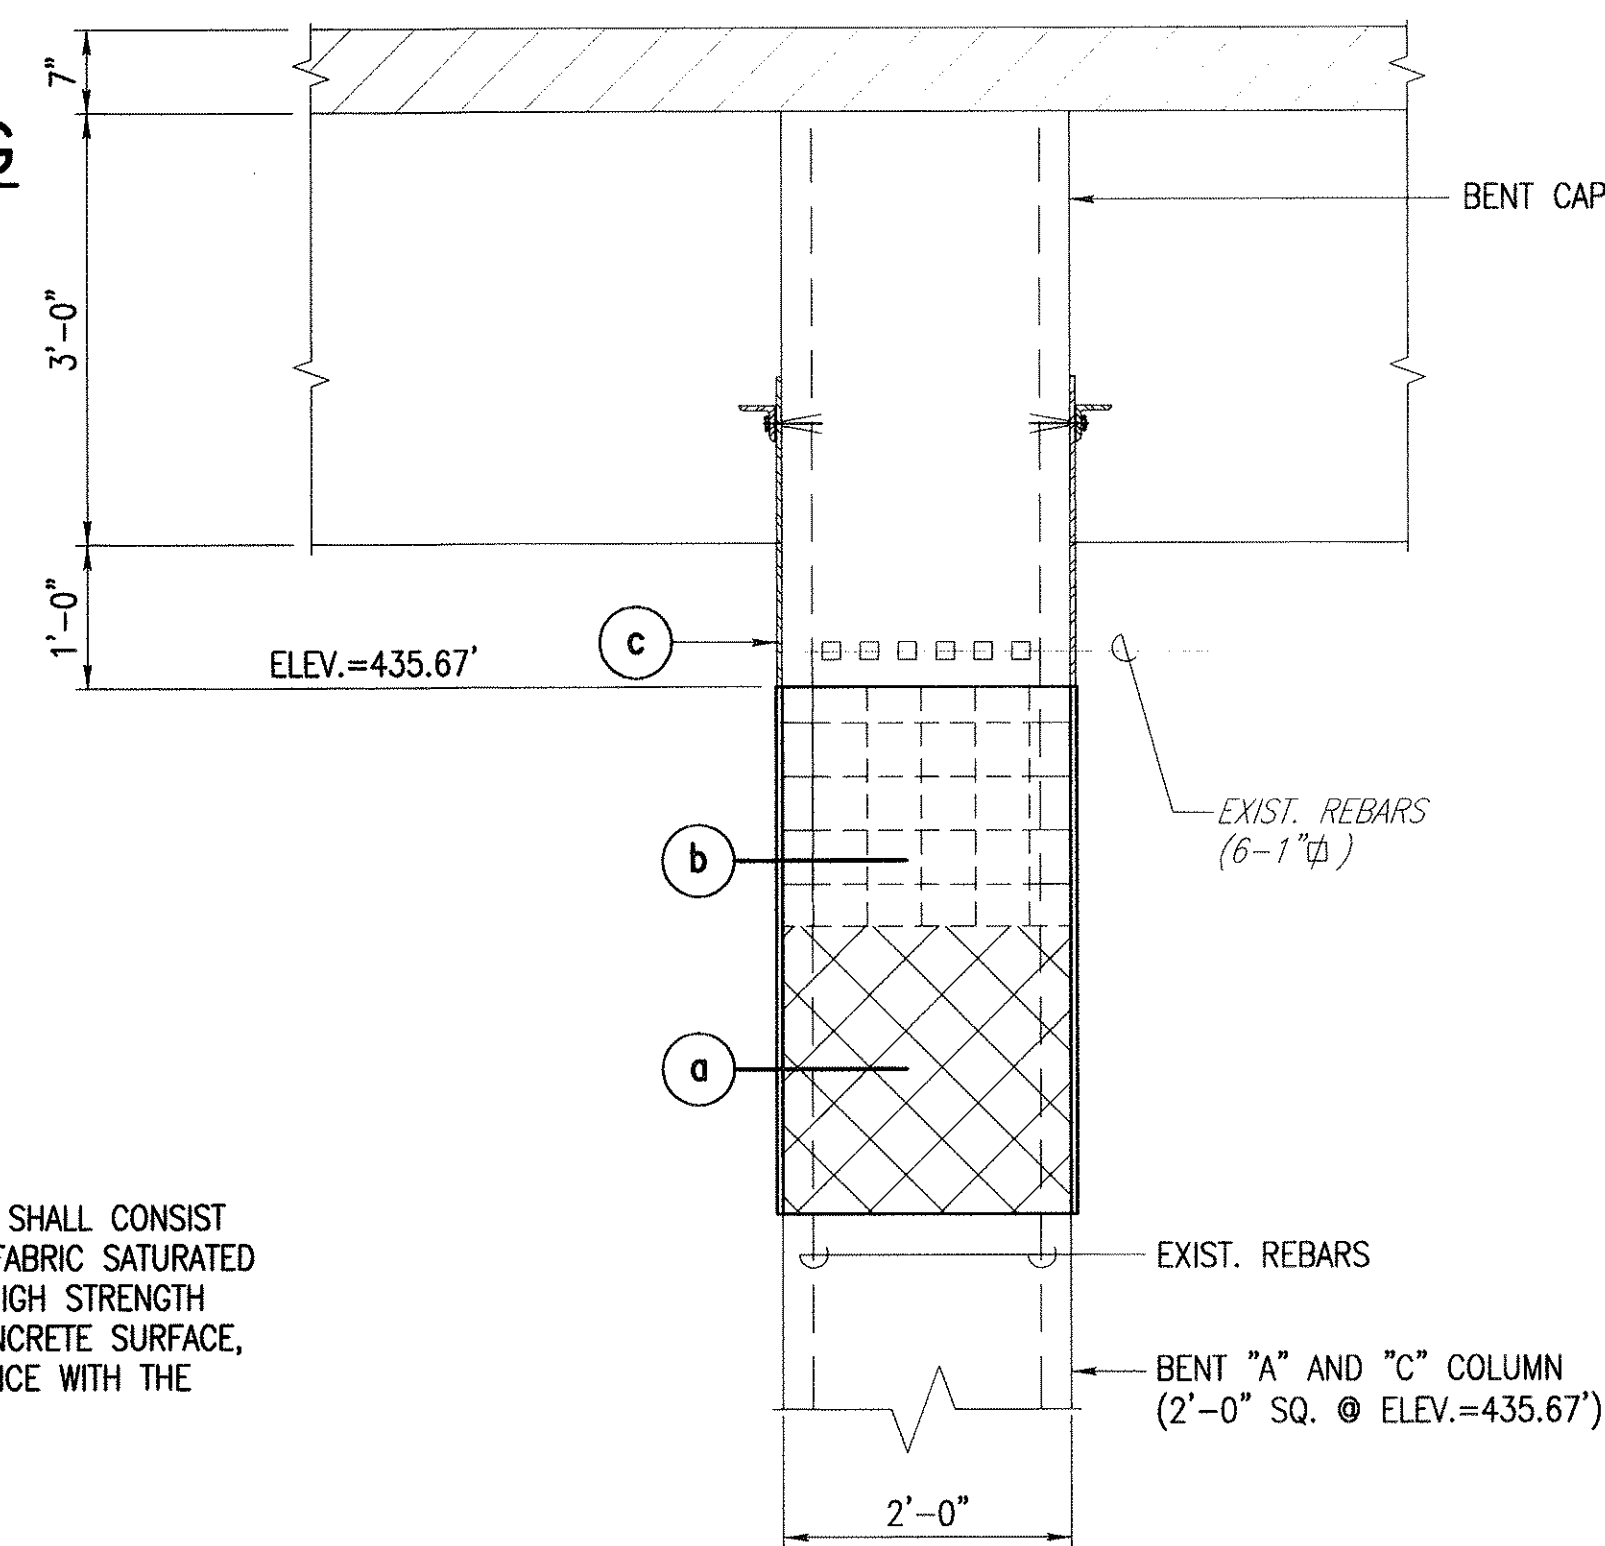


6 **DETAIL-'CFR' REPAIR AT COLUMN**
S-6 SCALE: 3/4" = 1'-0"

NOTE:

COMPOSITE FIBER REINFORCEMENT (CFR) SHALL CONSIST OF GLASS FIBER REINFORCED POLYMER FABRIC SATURATED IN FABRIC SATURANT RESIN. APPLY ON HIGH STRENGTH EPOXY PRIMER PLACED ON THE DRY CONCRETE SURFACE, FREE OF DUST. APPLY CFR IN ACCORDANCE WITH THE MANUFACTURER'S RECOMMENDATIONS.

| | |
|--|--------------------------|
| DATE: 11 May 2006 - 10:04am | SURVEY PLOTTED BY: _____ |
| FILE LOCATION: S:\02022-00\STRUCT\01\11 MAY 6-ADDITON\S-06.dwg | DRAWN BY: _____ |
| | CHECKED BY: _____ |
| | DATE: _____ |
| | NO. _____ |

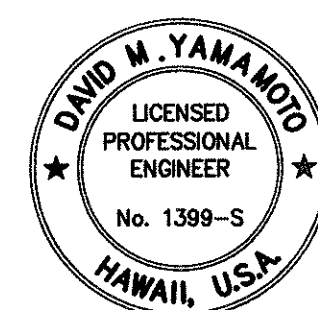

THIS WORK WAS PREPARED BY ME OR UNDER MY SUPERVISION
APRIL 30, 2008
EXPIRATION DATE OF LICENSE

| |
|---|
| STATE OF HAWAII DEPARTMENT OF TRANSPORTATION HIGHWAYS DIVISION MISCELLANEOUS RETROFIT DETAILS WALAOHIA BRIDGE AKONI PULE HIGHWAY, SEISMIC RETROFIT OF WALAOHIA AND AAMAKAO BRIDGES; FAIP NO. BR-0270(18) SCALE: AS NOTED DATE: May 2006 SHEET No. S-6 OF 12 SHEETS |
|---|

| FED. ROAD DIST. NO. | STATE | FED. AID PROJ. NO. | FISCAL YEAR | SHEET NO. | TOTAL SHEETS |
|---------------------|-------|--------------------|-------------|-----------|--------------|
| HAWAII | HAW. | BR-0270(18) | 2006 | 26 | 31 |

LEGEND

○ CUT BARS

● CONTINUOUS BARS

○ 2" I.D. MIN. ACCESS TUBES (5-TOTAL EQUALLY SPACED) FOR CROSSHOLE SONIC LOG TESTING OF DRILLED SHAFTS. INSTALL FULL DEPTH OF EACH DRILLED SHAFT. AND SECURE WITH THE REINFORCING CAGE. FILL WITH GROUT AFTER TESTING IS COMPLETED.


DRILLED SHAFT NOTES:

- THE CONTRACTOR SHALL REFER TO THE SPECIAL PROVISIONS SECTION 511 "DRILLED SHAFTS".
- ALL EXCAVATION AND DRILLING OPERATIONS SHALL BE MONITORED BY THE ENGINEER.
- BOTTOM OF DRILLED SHAFT TIP ELEVATIONS SHALL BE VERIFIED BY THE ENGINEER PRIOR TO INSTALLING REINFORCING BAR CAGE.
- CONCRETE SHALL NOT BE PLACED WITHOUT THE APPROVAL OF THE ENGINEER.
- DRILLED SHAFT CONCRETE SHALL HAVE A MINIMUM COMPRESSIVE STRENGTH OF 4000 psi AT 28 DAYS OF AGE. MAXIMUM SIZE COARSE AGGREGATE SHALL BE 3/4". SLUMP SHALL BE 7 INCHES ± 1 INCH FOR CONCRETE POURED IN WATER FREE HOLE AND 8 INCH ± 1 INCH FOR CONCRETE PLACED UNDER WATER OR UNDER DRILLING SLURRY.
- LONGITUDINAL BARS SHALL CONFORM TO ASTM A615, GRADE 60. TIES AND SPIRAL REINFORCING SHALL BE DEFORMED BARS CONFORMING TO ASTM A615, GRADE 60.
- LONGITUDINAL BARS SHALL NOT BE LAP SPICED. SPICES, IF REQUIRED, SHALL BE MECHANICAL SPICES CAPABLE OF DEVELOPING IN TENSION AND COMPRESSION AT LEAST 125 PERCENT OF THE SPECIFIED YIELD STRENGTH OF SMALLER BAR CONNECTED. SPICES SHALL BE STAGGERED.
- MINIMUM LAP LENGTH FOR SPIRAL LATERAL REINFORCEMENT SHALL BE 36 INCHES.
- PLASTIC SPACER WHEELS, RIGIDLY SECURE RELATIVE TO REINFORCING SHALL BE USED TO MAINTAIN PROPER POSITION AND CLEARANCE OF THE REINFORCEMENT CAGE WITHIN THE SHAFT.

LEGEND FOR AS-BUILT POSTINGS


- ~~~~~ Squiggly line for as-built deletion
- == Double line for as-built deletion
- ⊗ "X" for as-built deletion
- Roadway Text for as-built posting

GRAPHIC SCALES

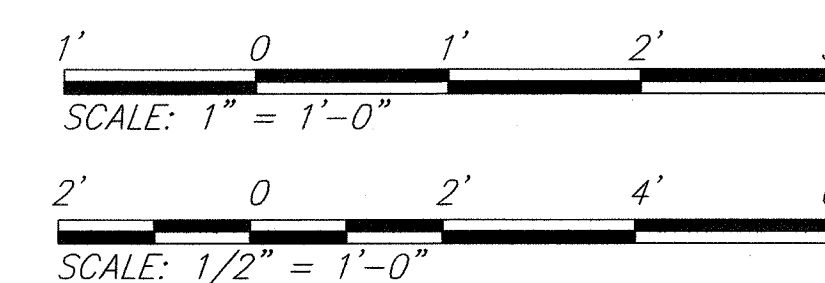

RECORD DRAWING

The details, locations and other information shown are based on information provided by others. The design consultant cannot assure the accuracy and completeness of the information. The user of this drawing shall be responsible to verify its accuracy and completeness

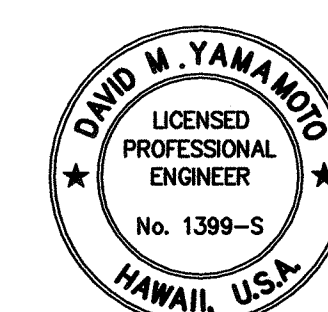


STATE OF HAWAII
DEPARTMENT OF TRANSPORTATION
HIGHWAYS DIVISION
DRILLED SHAFT DETAILS
WALAOHIA BRIDGE

AKONI PULE HIGHWAY, SEISMIC RETROFIT
OF WALAOHIA AND AAMAKAO BRIDGES;
FAIP NO. BR-0270(18)

SCALE: AS NOTED DATE: May 2006

SHEET No. **S-7** OF 12 SHEETS

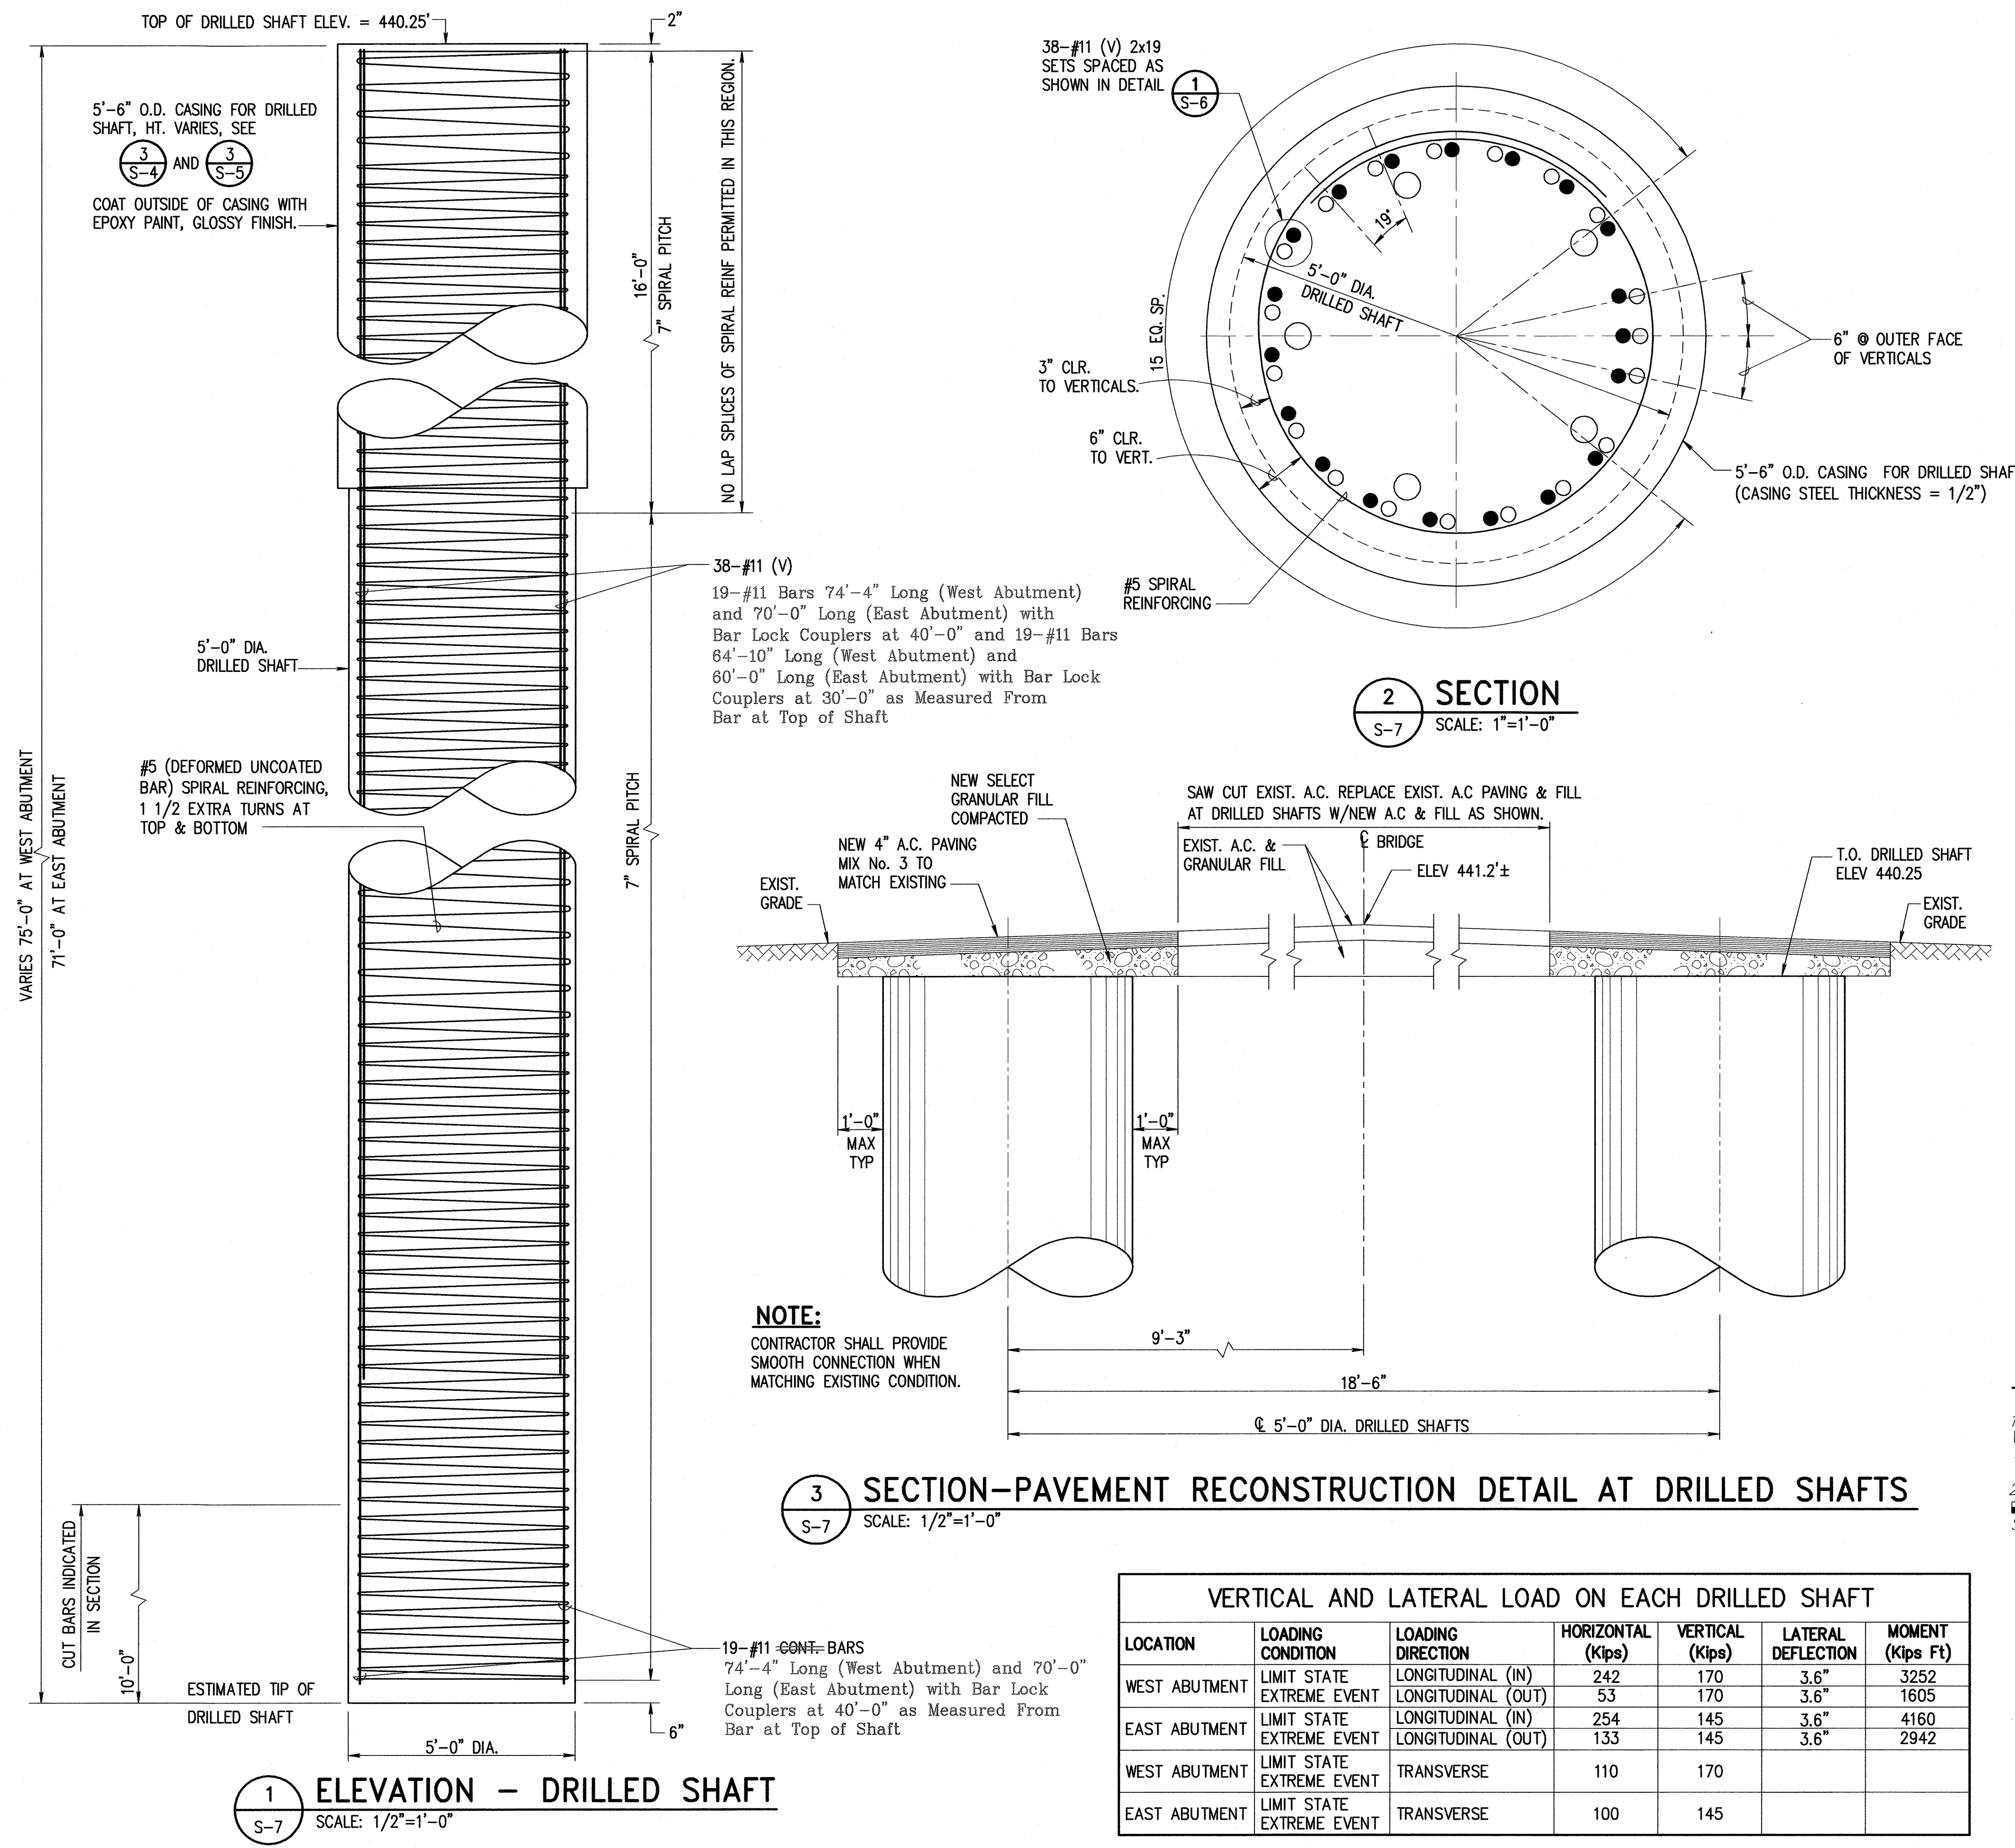

| VERTICAL AND LATERAL LOAD ON EACH DRILLED SHAFT | | | | | | |
|---|-------------------|--------------------|-------------------|-----------------|--------------------|------------------|
| LOCATION | LOADING CONDITION | LOADING DIRECTION | HORIZONTAL (Kips) | VERTICAL (Kips) | LATERAL DEFLECTION | MOMENT (Kips Ft) |
| WEST ABUTMENT | LIMIT STATE | LONGITUDINAL (IN) | 242 | 170 | 3.6" | 3252 |
| | EXTREME EVENT | LONGITUDINAL (OUT) | 53 | 170 | 3.6" | 1605 |
| EAST ABUTMENT | LIMIT STATE | LONGITUDINAL (IN) | 254 | 145 | 3.6" | 4160 |
| | EXTREME EVENT | LONGITUDINAL (OUT) | 133 | 145 | 3.6" | 2942 |
| WEST ABUTMENT | LIMIT STATE | TRANSVERSE | 110 | 170 | | |
| EAST ABUTMENT | LIMIT STATE | TRANSVERSE | 100 | 145 | | |

Date Plotted: Thu, 23 Jul 2009 - 11:50am
File Name: Z:\Project Archive\0222-00\STRUCT\final\MAY 6-ADDITION-AS-BUILT\S-S-07.dwg

| | |
|-------------------|------|
| SURVEY PLOTTED BY | DATE |
| DRAWN BY | |
| TRACED BY | |
| REVIEWED BY | |
| QUANTITIES BY | |
| CHECKED BY | |


ORIGINAL PLAN

NOTE BOOK

No.


"AS-BUILT"

| FED. ROAD DIST. NO. | STATE | FED. AID PROJ. NO. | FISCAL YEAR | SHEET NO. | TOTAL SHEETS |
|---------------------|-------|--------------------|-------------|-----------|--------------|
| HAWAII | HAW. | BR-0270(18) | 2006 | 27 | 31 |

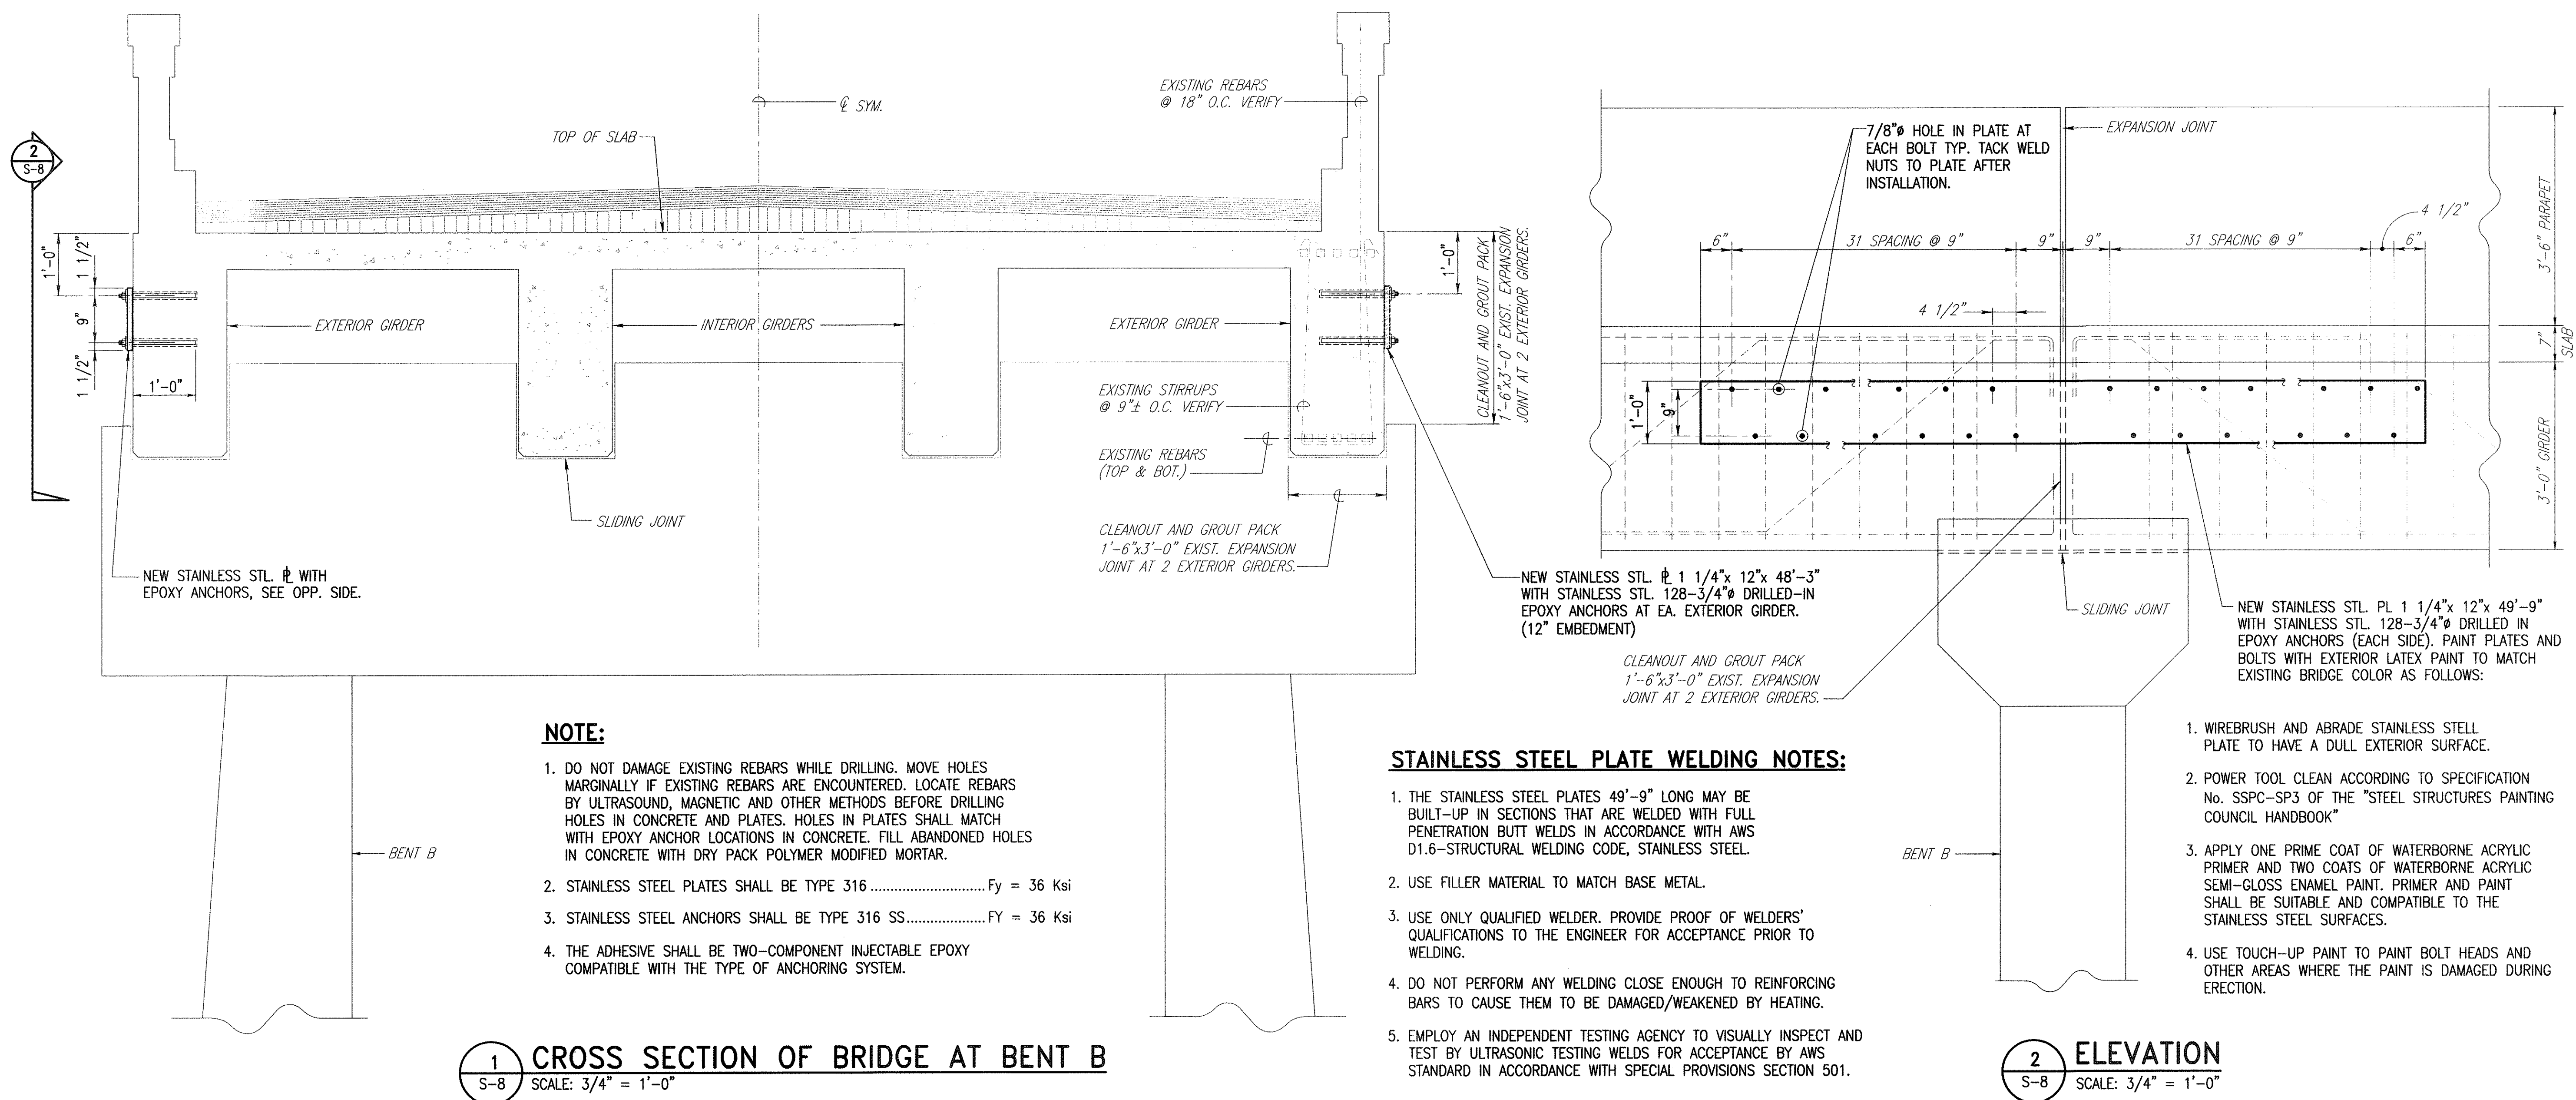

Date Plotted: Thu, 11 May 2006 - 10:11 am
File Name: S:\02222-00\STRUCT\01\041\041\G-ADDITIONS\08.dwg

| | |
|-------------------|------|
| SURVEY PLOTTED BY | DATE |
| DRAWN BY | |
| TRACED BY | |
| DESIGNED BY | |
| QUANTITIES BY | |
| CHECKED BY | |
| NOTE BOOK | |
| No. | |

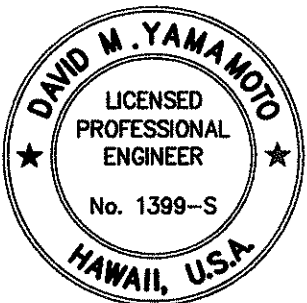

THIS WORK WAS PREPARED BY
 ME OR UNDER MY SUPERVISION
 APRIL 30, 2008
 EXPIRATION DATE OF LICENSE

STATE OF HAWAII
DEPARTMENT OF TRANSPORTATION
HIGHWAYS DIVISION

RETROFITTING EXTERIOR
GIRDERS AT EXPANSION JOINT


AKONI PULE HIGHWAY, SEISMIC RETROFIT
OF WALAOHIA AND AAMAKAO BRIDGES;

FAIP NO. BR-0270(18)


SCALE: AS NOTED DATE: May 2006

SHEET No. **S - 8** OF 12 SHEETS

| FED. ROAD DIST. NO. | STATE | FED. AID PROJ. NO. | FISCAL YEAR | SHEET NO. | TOTAL SHEETS |
|---------------------|-------|--------------------|-------------|-----------|--------------|
| HAWAII | HAW. | BR-0270(18) | 2006 | 28 | 31 |

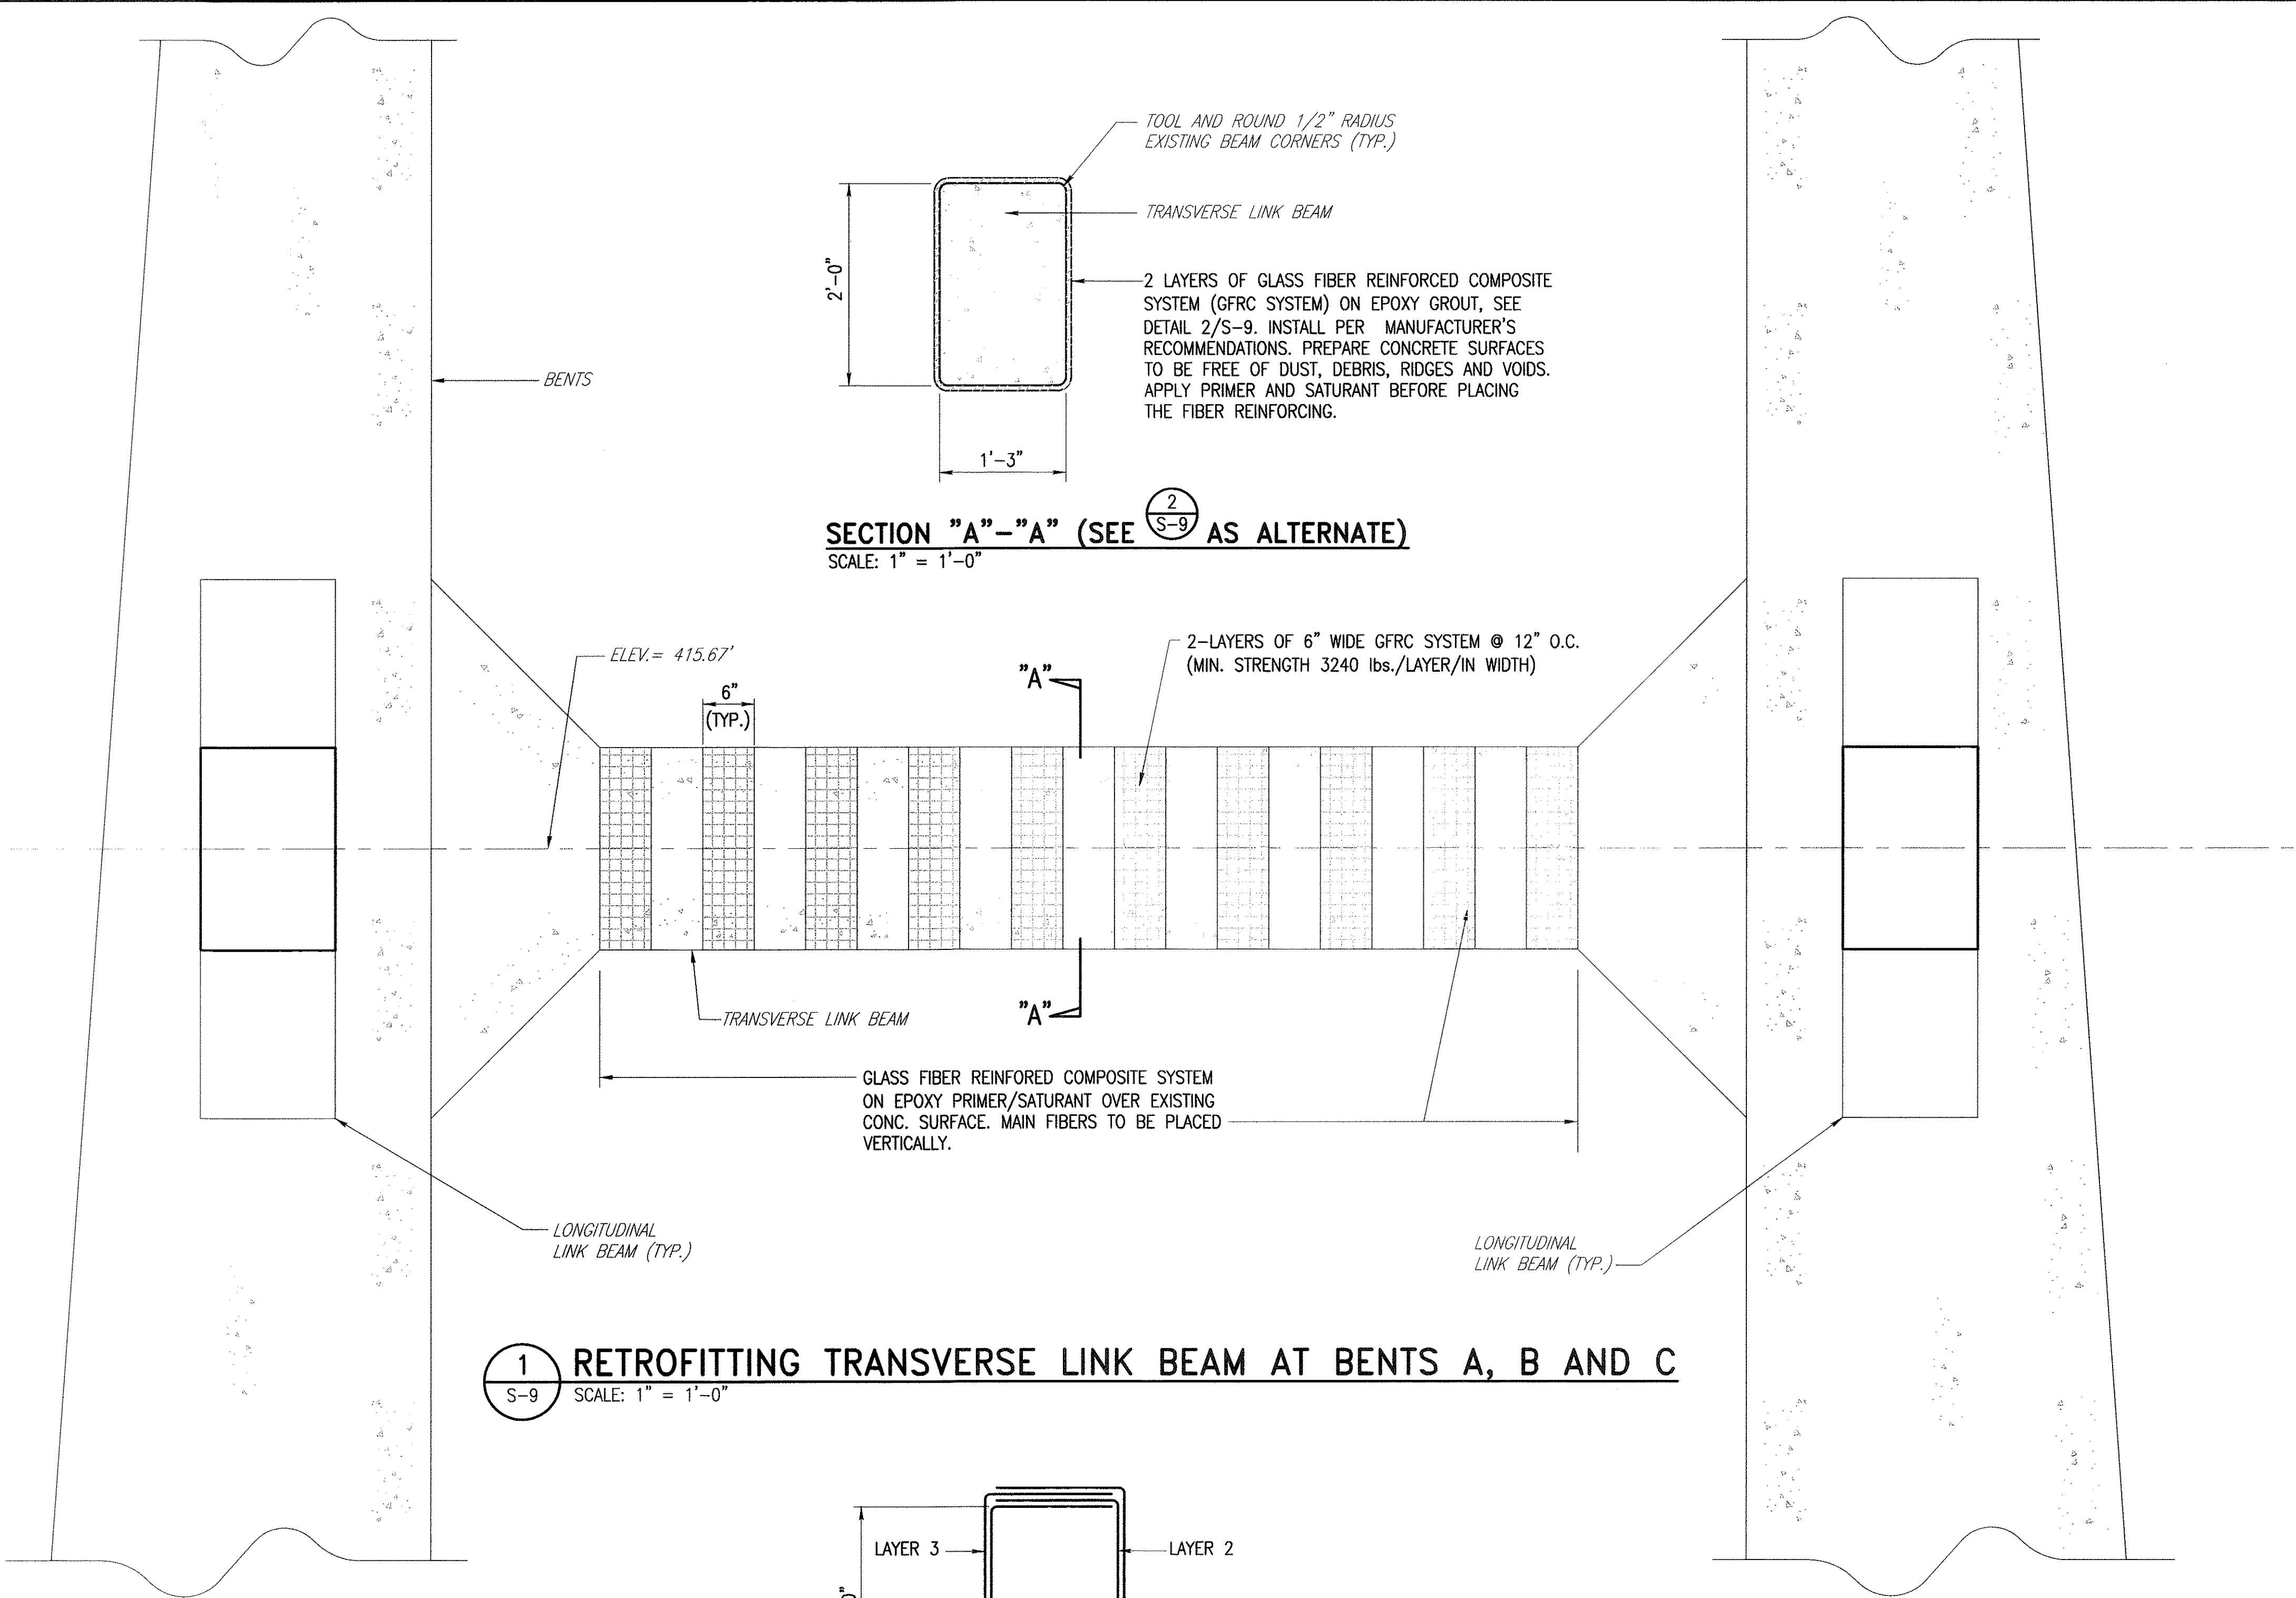



1 RETROFITTING TRANSVERSE LINK BEAM AT BENTS A, B AND C
 S-9 SCALE: 1" = 1'-0"

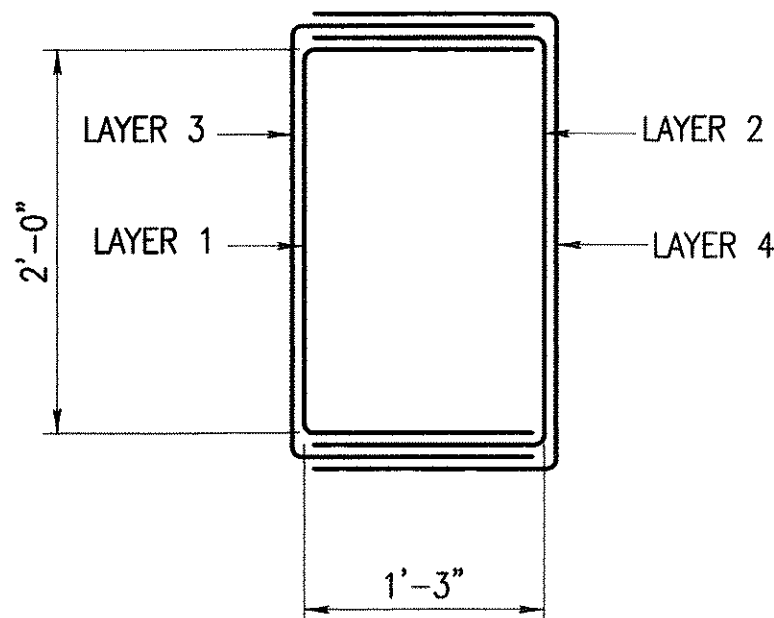

NOTE:
 GLASS FIBER REINF. CAN ALSO BE PLACED IN 2 LAYERS CONT. WRAP.

2 DETAIL-GLASSFIBER REINF. LAYER (ALTERNATE)
 S-9 SCALE: 1" = 1'-0"

GRAPHIC SCALE

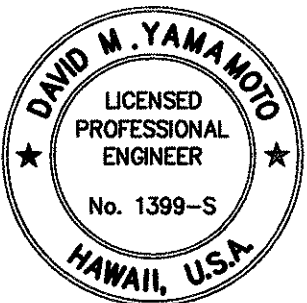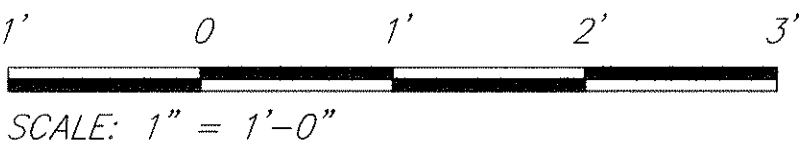

THIS WORK WAS PREPARED BY
 ME OR UNDER MY SUPERVISION
 APRIL 30, 2008
 EXPIRATION DATE OF LICENSE



STATE OF HAWAII
DEPARTMENT OF TRANSPORTATION
HIGHWAYS DIVISION
RETROFITTING TRANSVERSE LINK BEAMS
WALAOHIA BRIDGE
AKONI PULE HIGHWAY, SEISMIC RETROFIT
OF WALAOHIA AND AAMAKAO BRIDGES;
FAIP NO. BR-0270(18)
SCALE: AS NOTED DATE: May 2006
SHEET No. **S-9** OF 12 SHEETS

28

Date Plotted: Thu, 11 May 2006 - 10:13am
File Name: S:\02022-00\STRUCT\final\MAY 6-ADDITION S-09.dwg

| | | |
|---------------|-------------------|------|
| ORIGINAL PLAN | SURVEY PLOTTED BY | DATE |
| NOTE BOOK | DRAWN BY | " " |
| No. | DESIGNED BY | " " |
| | CHECKED BY | " " |


| FED. ROAD DIST. NO. | STATE | FED. AID PROJ. NO. | FISCAL YEAR | SHEET NO. | TOTAL SHEETS |
|---------------------|-------|--------------------|-------------|-----------|--------------|
| HAWAII | HAW. | BR-0270(18) | 2006 | 29 | 31 |

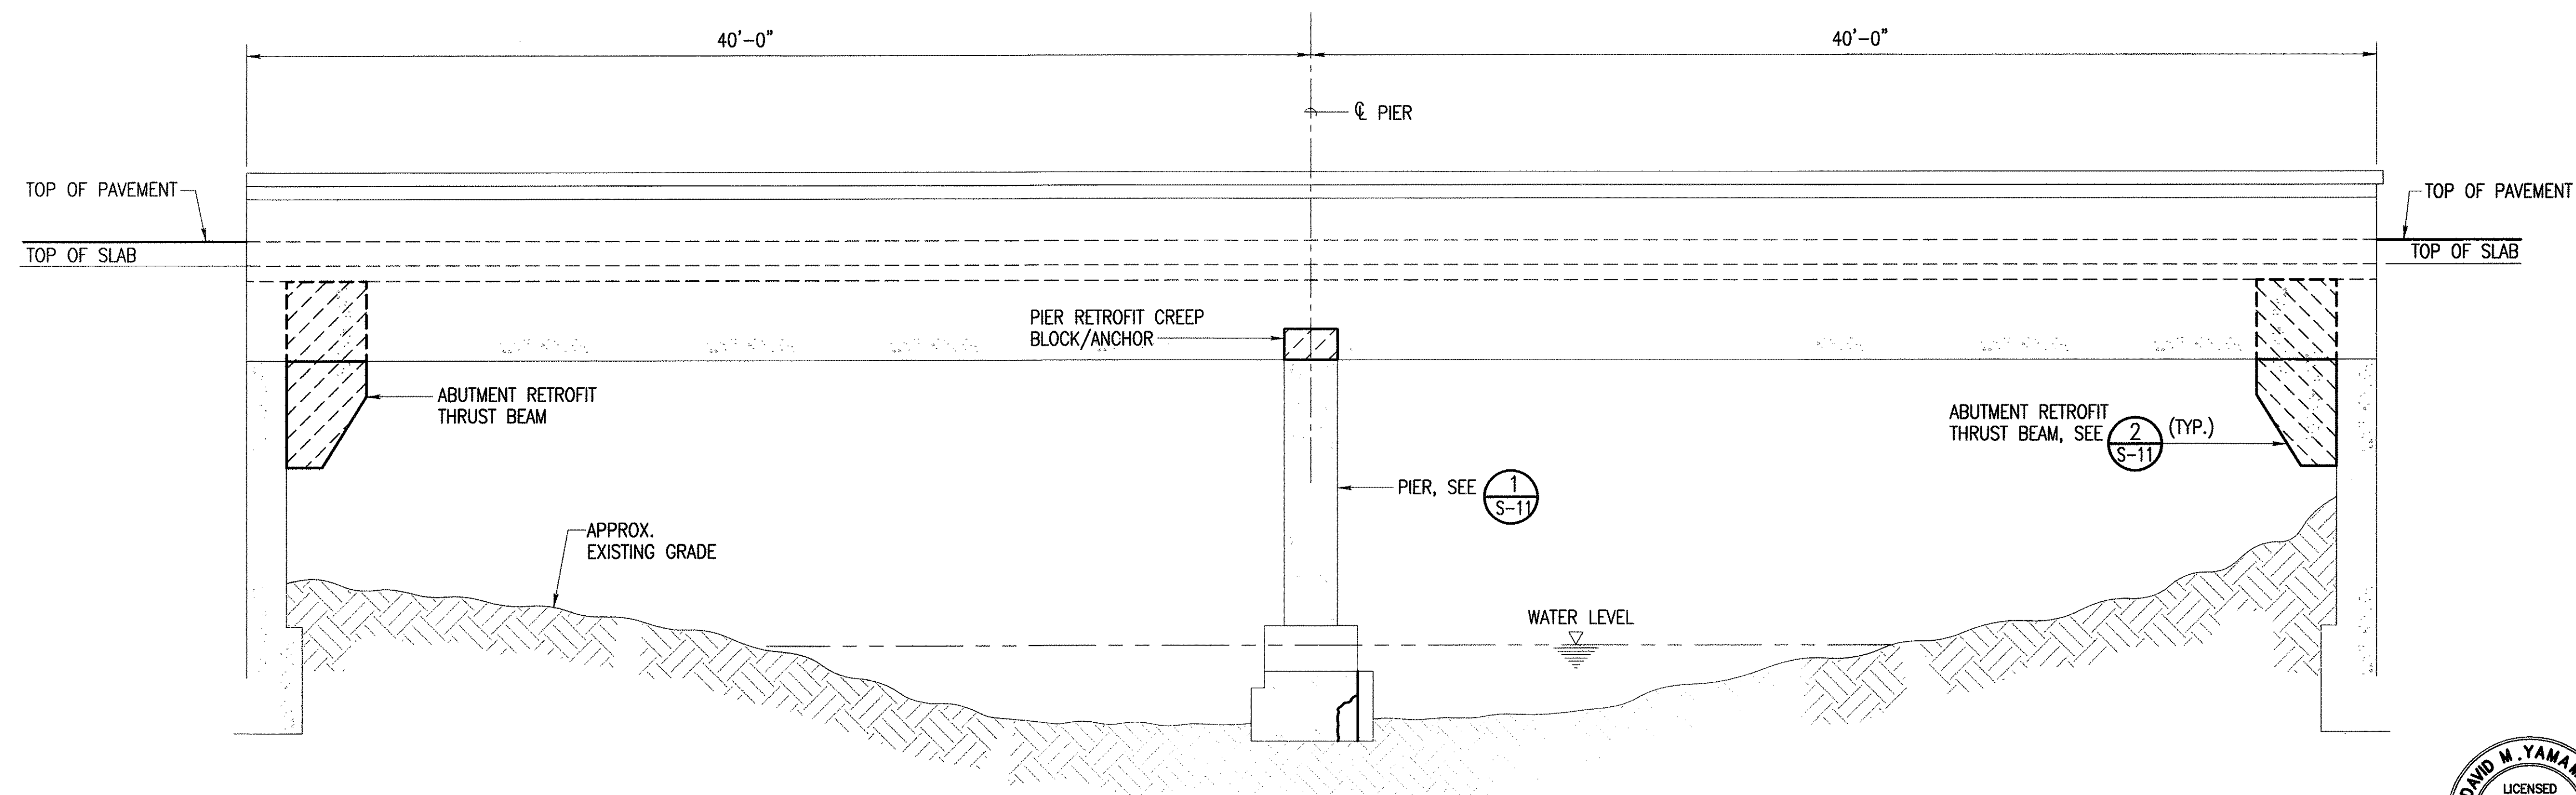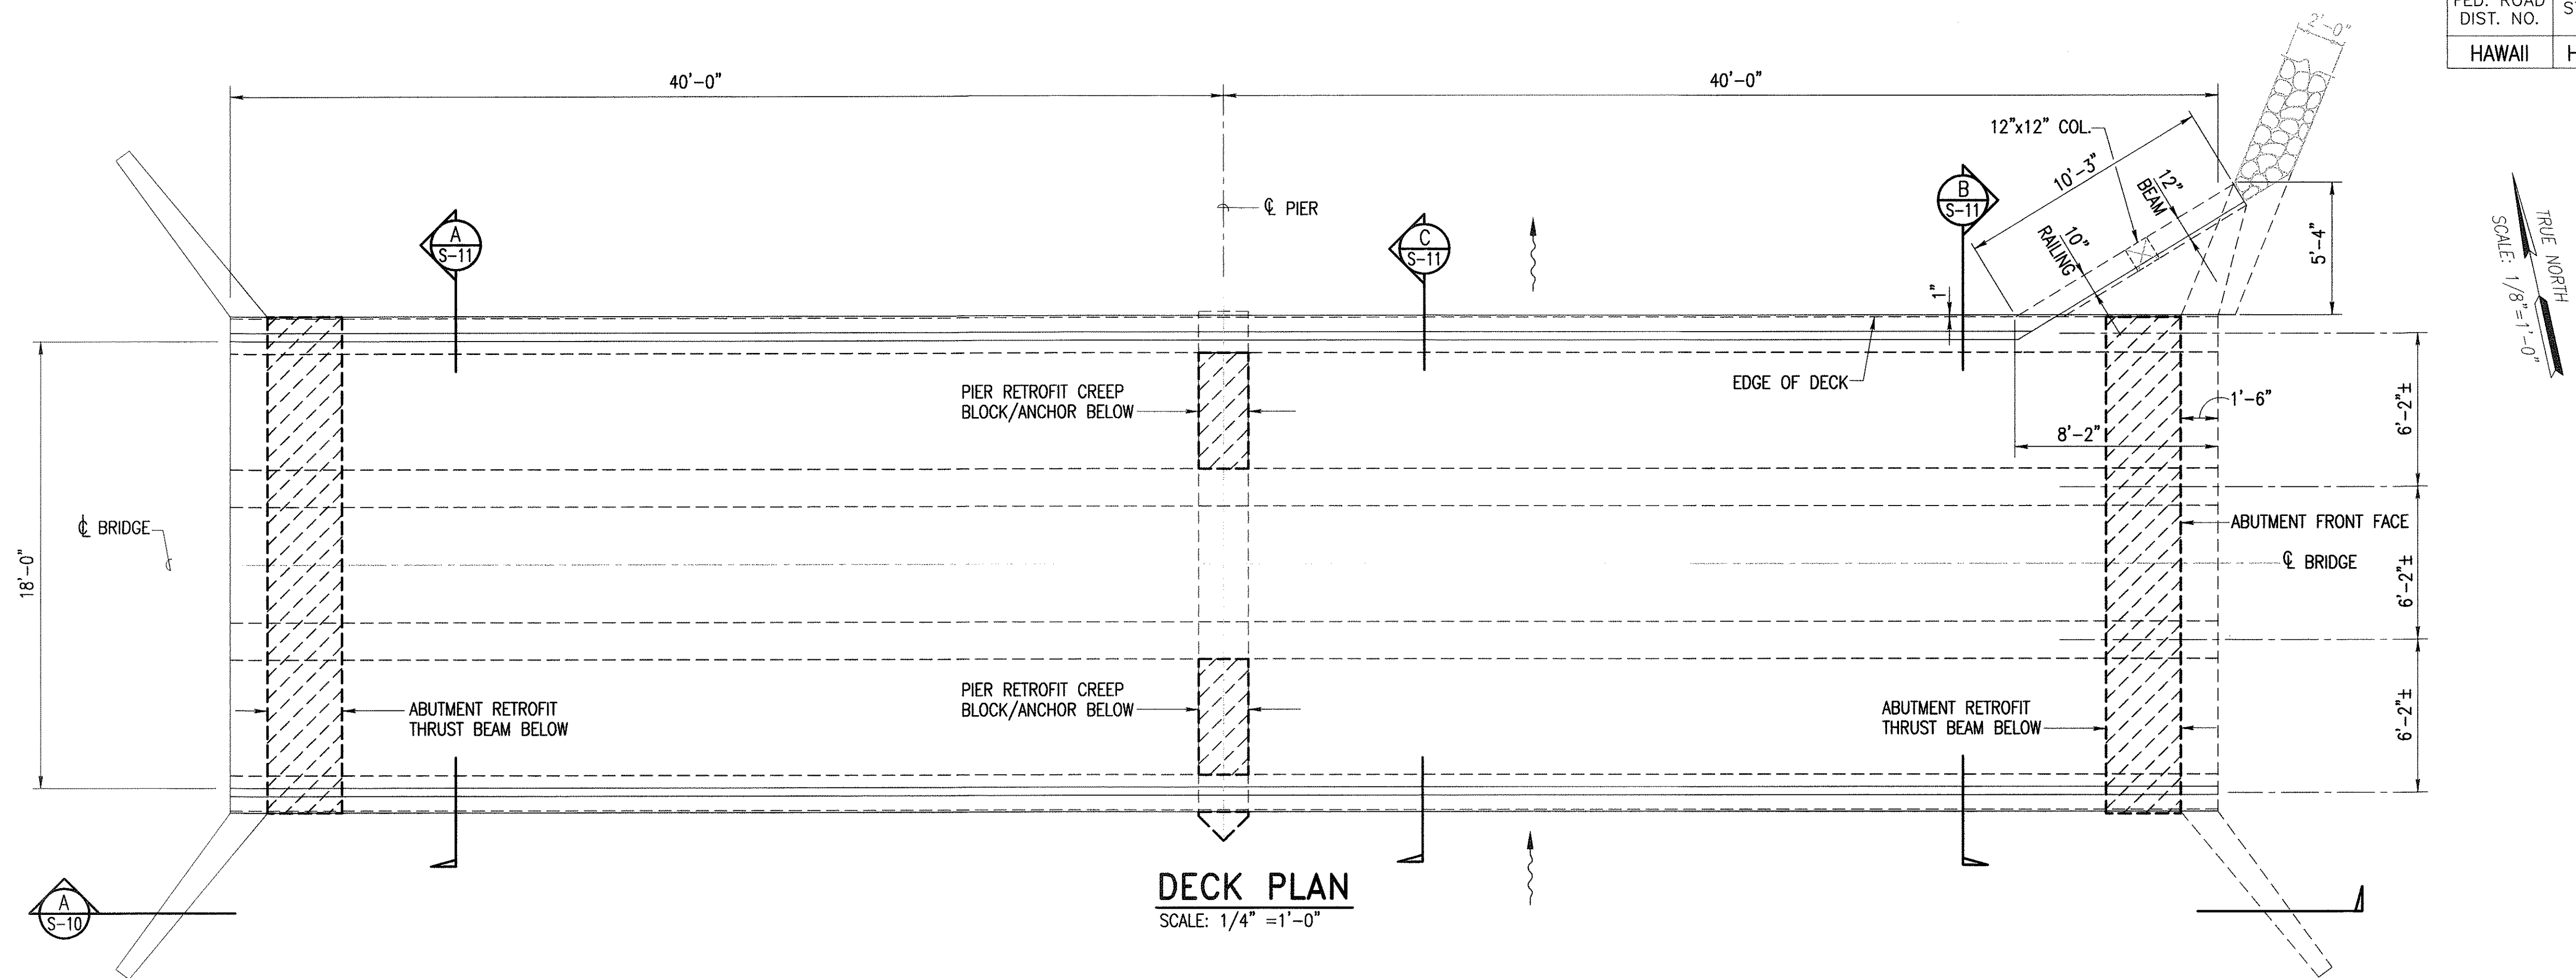

GRAPHIC SCALE



SCALE: 1/4" = 1'-0"

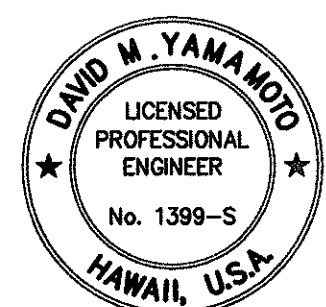

THIS WORK WAS PREPARED BY
ME OR UNDER MY SUPERVISION
APRIL 30, 2008
EXPIRATION DATE OF LICENSE

STATE OF HAWAII
DEPARTMENT OF TRANSPORTATION
HIGHWAYS DIVISION

BRIDGE PLAN AND ELEVATION

AAMAKAO BRIDGE

AKONI PULE HIGHWAY, SEISMIC RETROFIT
OF WALAOHIA AND AAMAKAO BRIDGES;


FAIP NO. BR-0270(18)

SCALE: AS NOTED DATE: May 2006


SHEET No. **S - 10** OF 12 SHEETS

| | | |
|---|-------------------|------|
| DATE: Thu, 11 May 2006 10:14am | SURVEY PLOTTED BY | DATE |
| FILE LOCATION: S:\02022\00\STRUCT\final\may 6-ADDITION\S-10.dwg | DRAWN BY | |
| | TRACED BY | |
| | DESIGNED BY | |
| | QUANTITIES BY | |
| | CHECKED BY | |
| | NO. | |


| FED. ROAD DIST. NO. | STATE | FED. AID PROJ. NO. | FISCAL YEAR | SHEET NO. | TOTAL SHEETS |
|---------------------|-------|--------------------|-------------|-----------|--------------|
| HAWAII | HAW. | BR-0270(18) | 2006 | 30 | 31 |

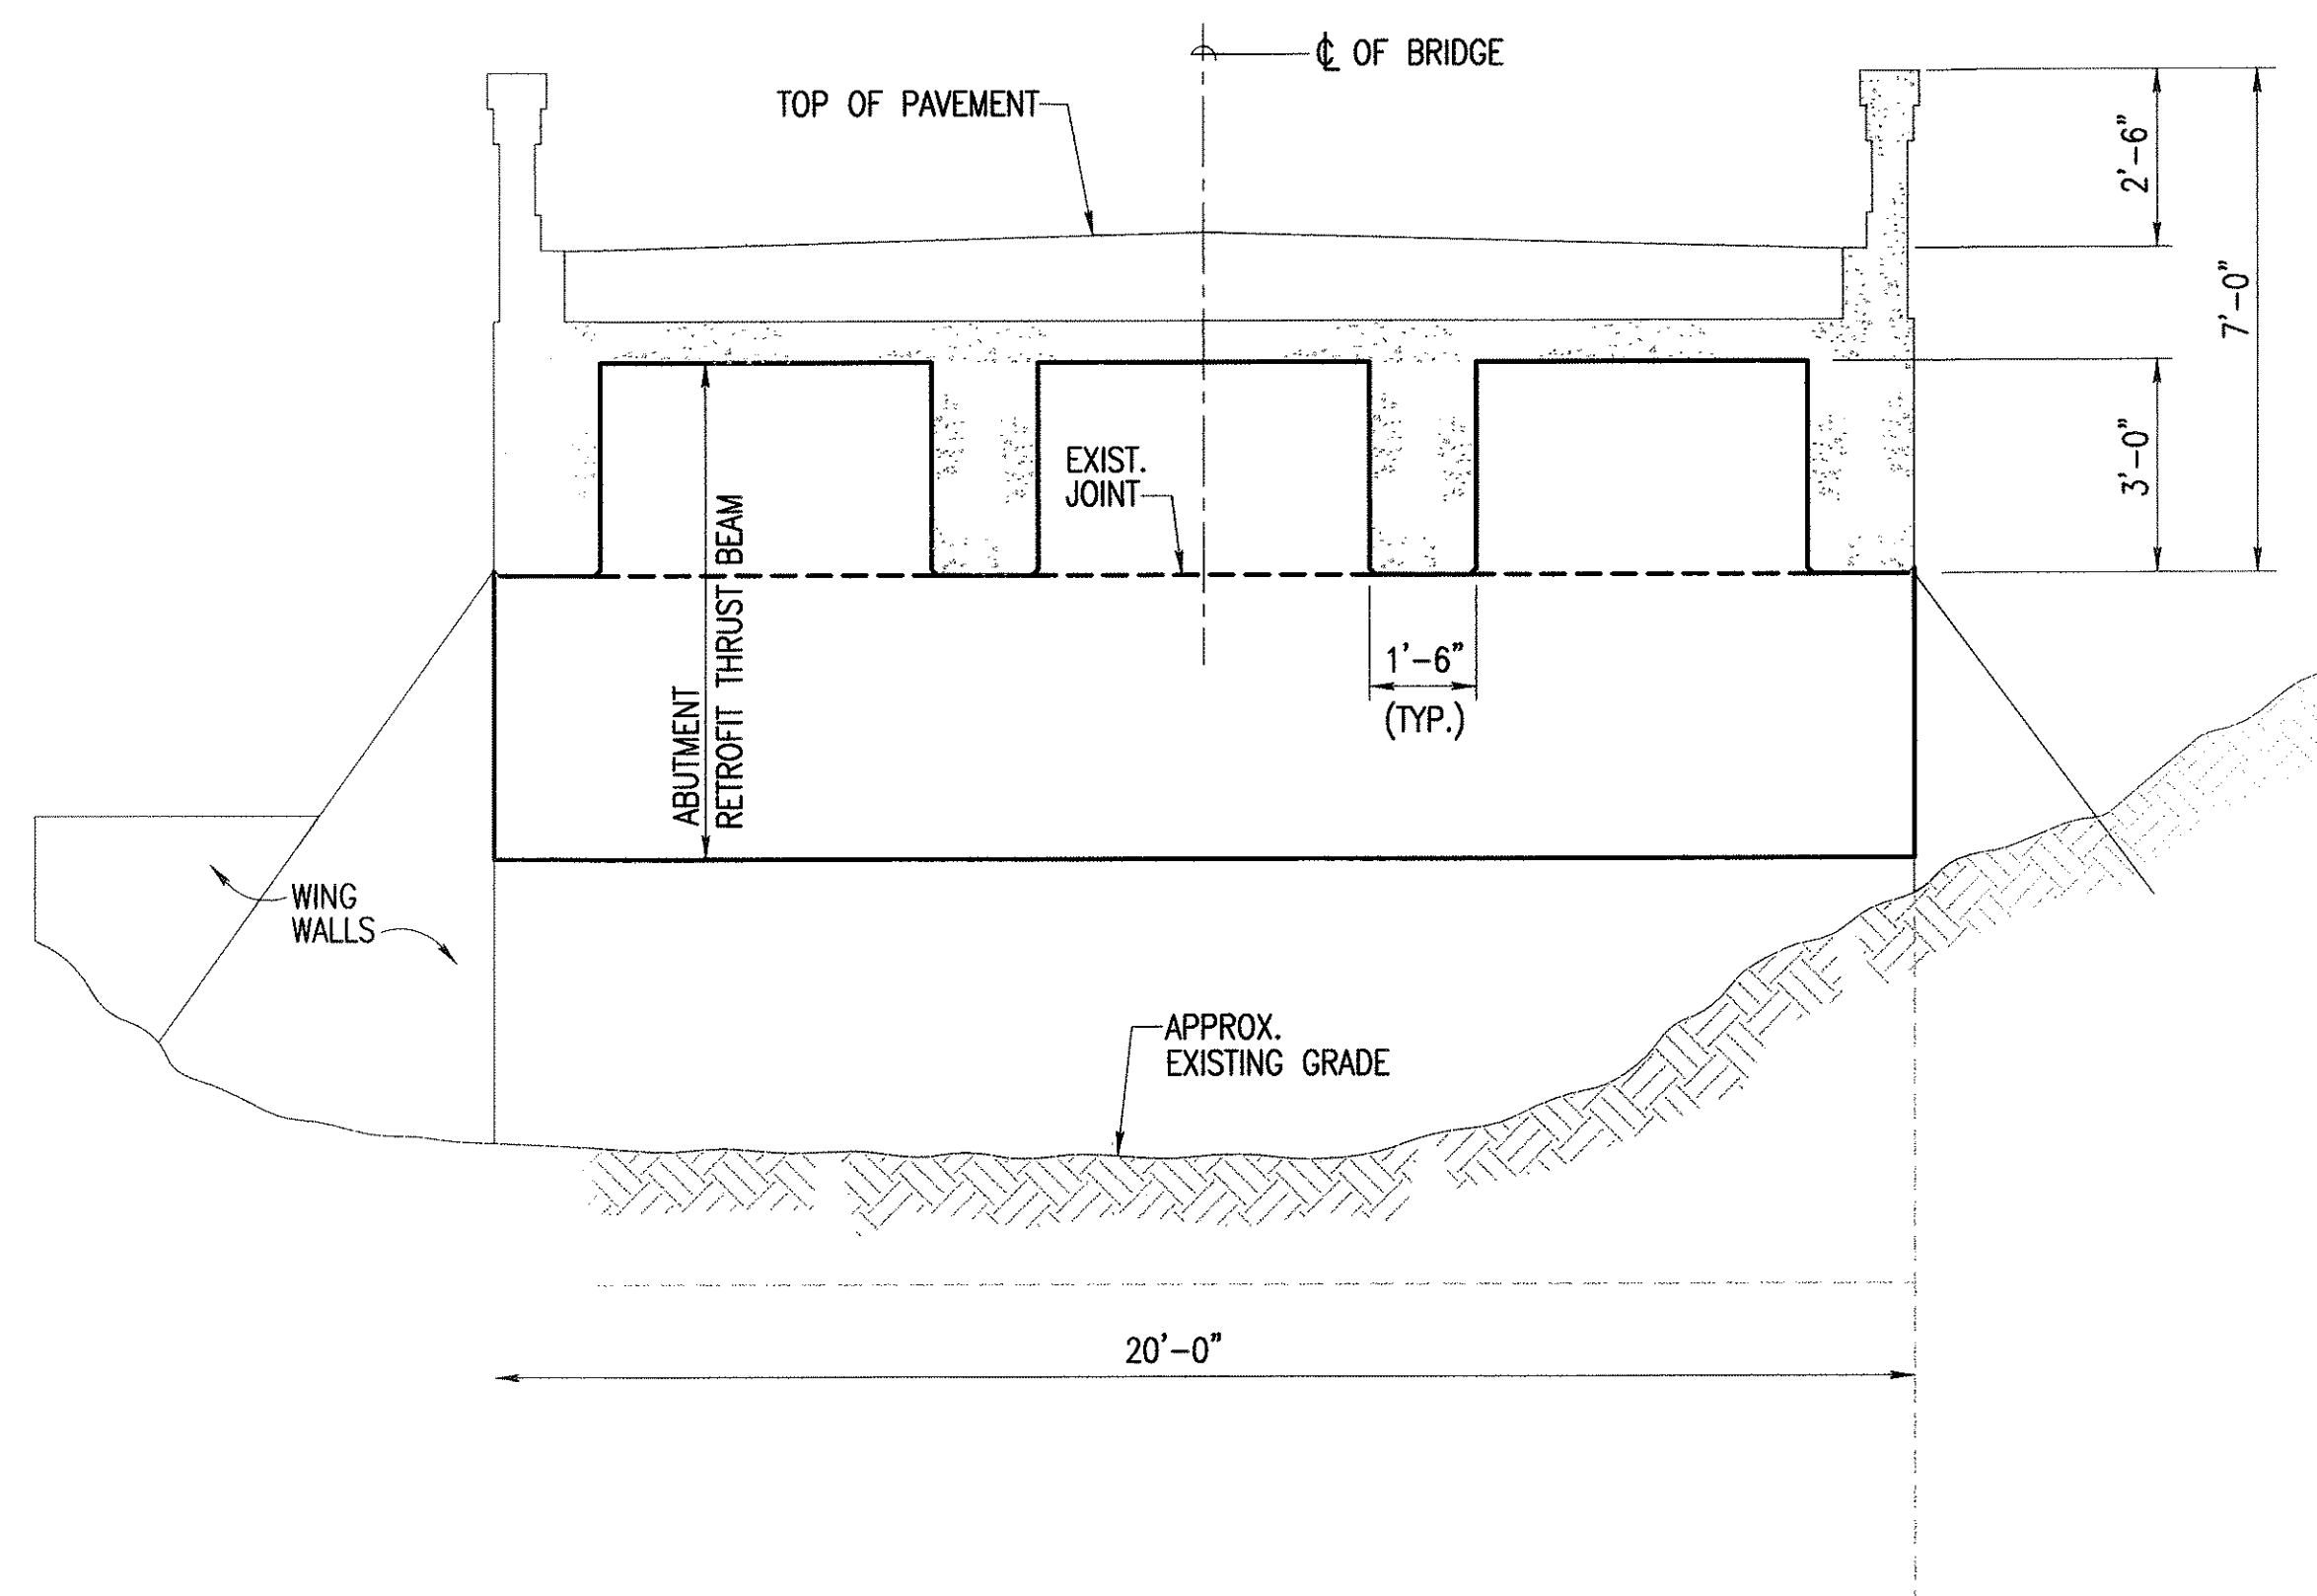


A WEST ABUTMENT ELEVATION
S-11 SCALE: 3/8" = 1'-0"

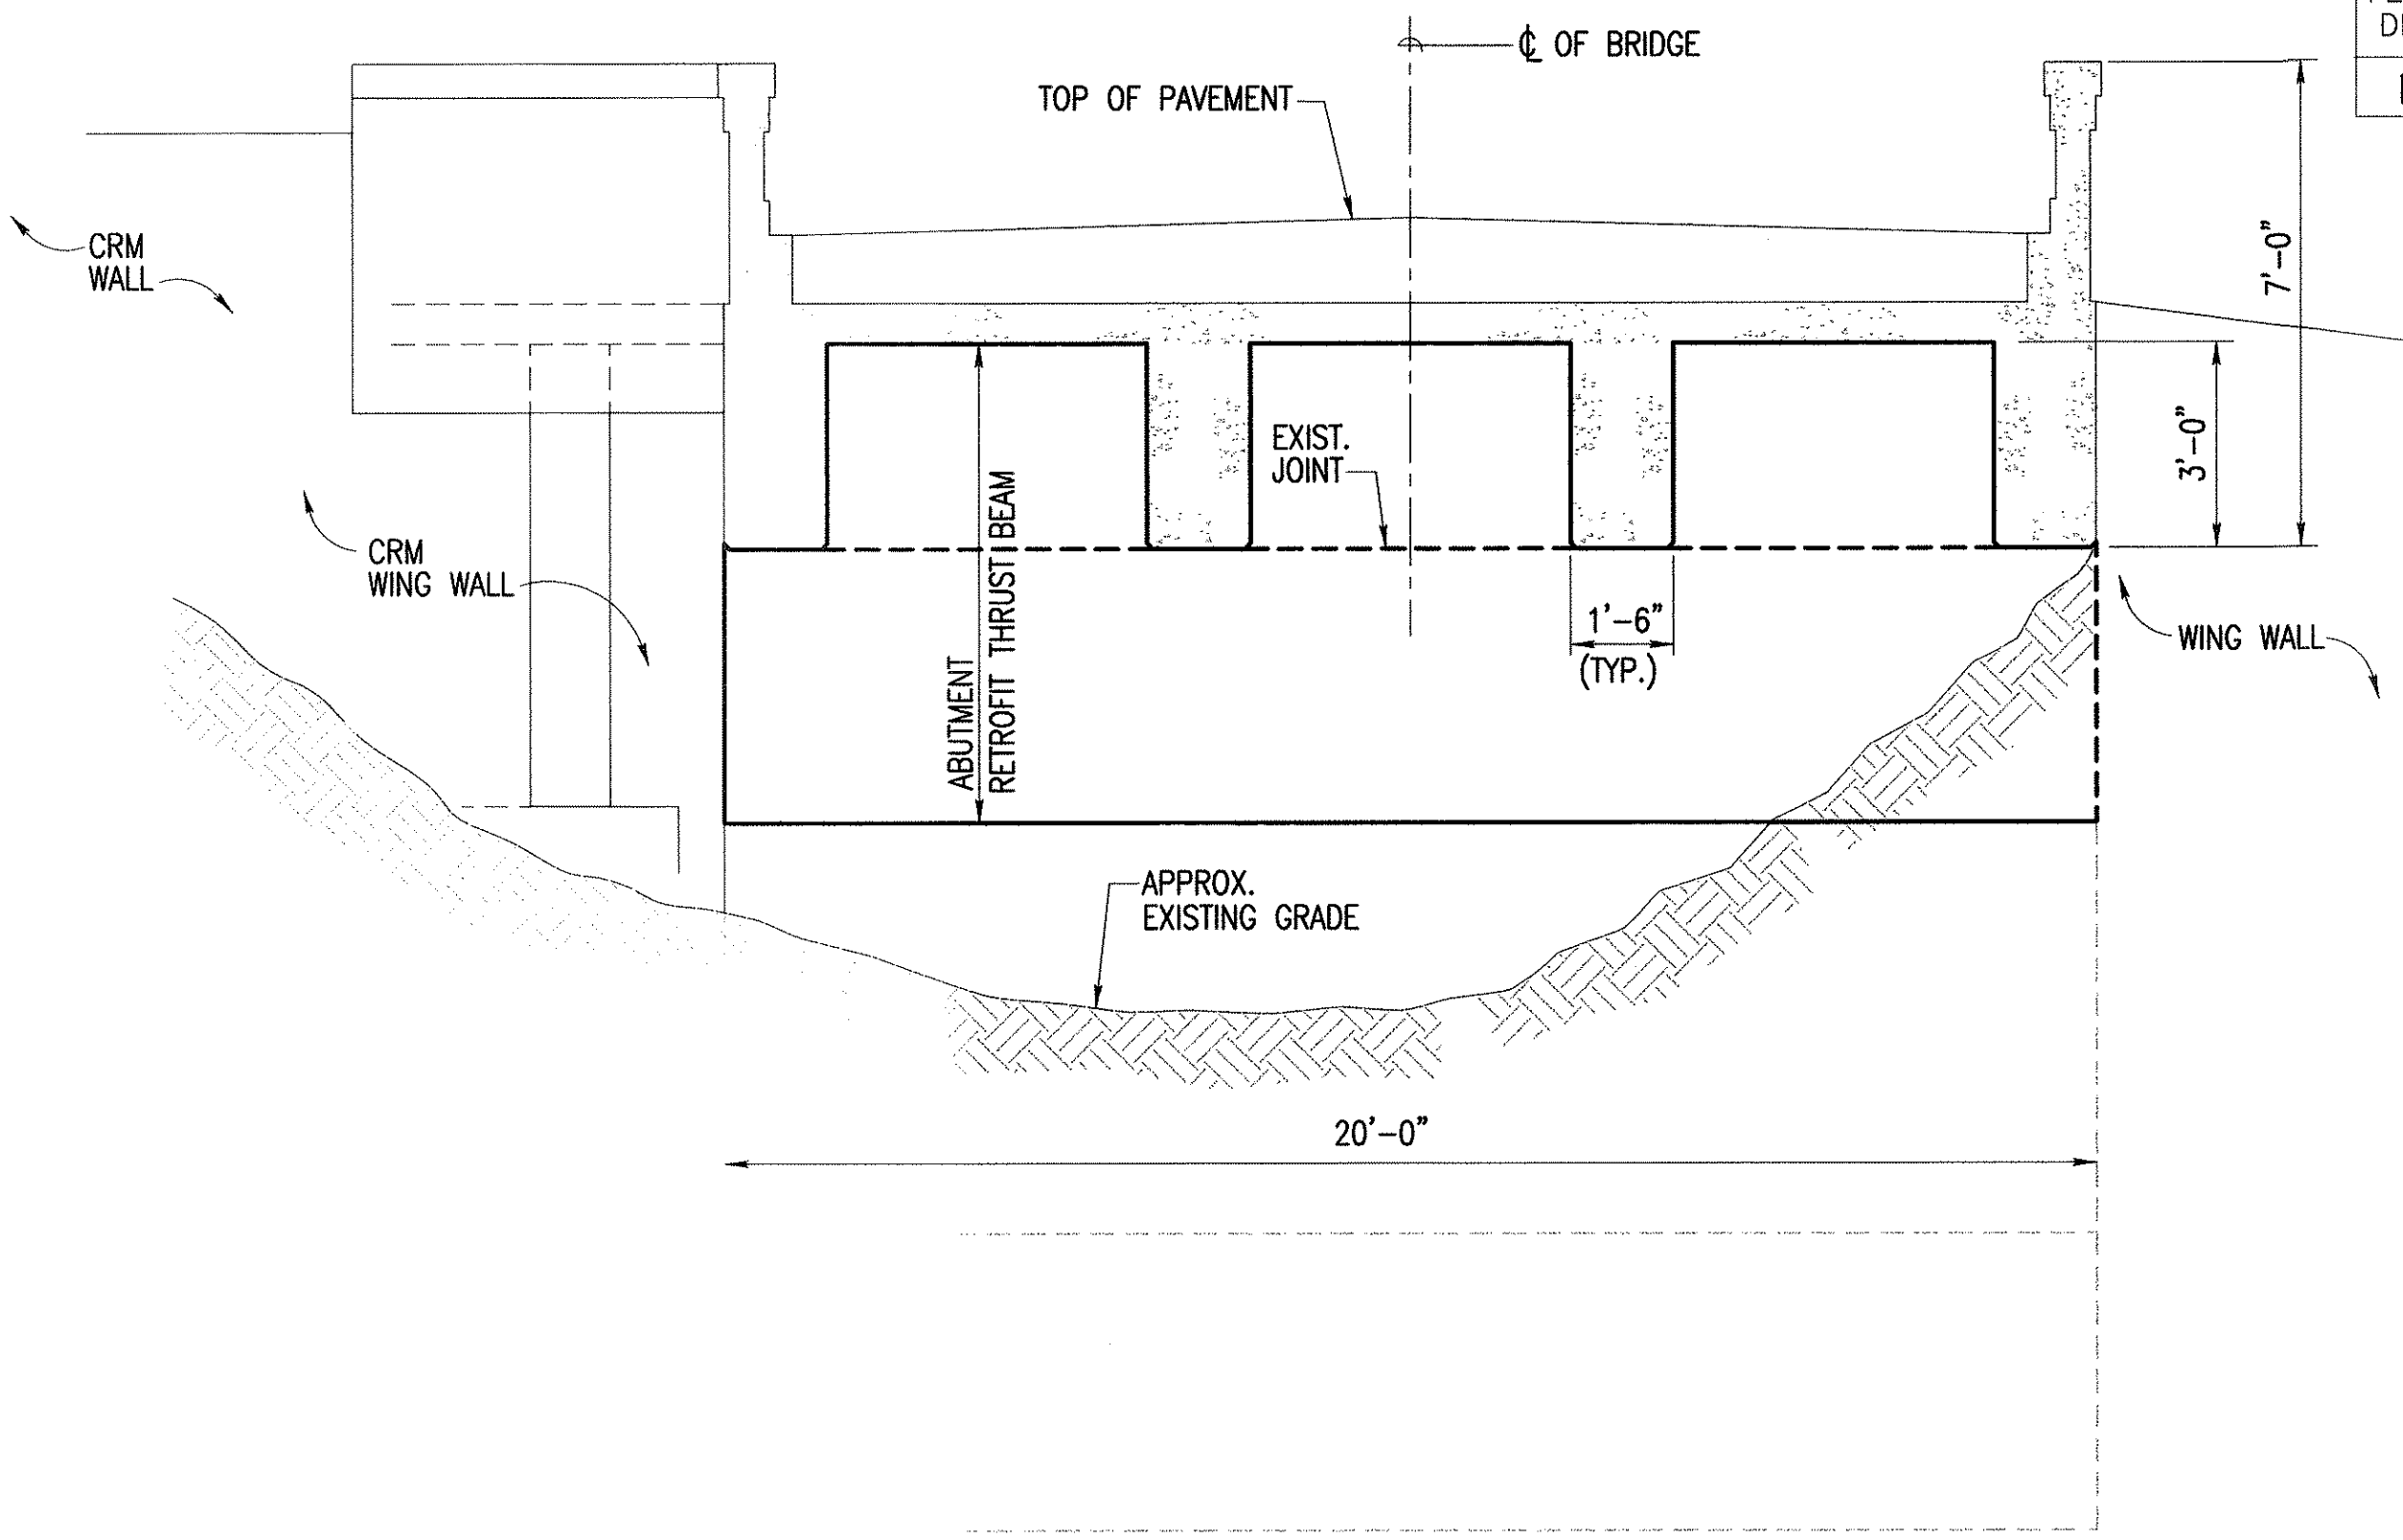


B EAST ABUTMENT ELEVATION
S-11 SCALE: 3/8" = 1'-0"

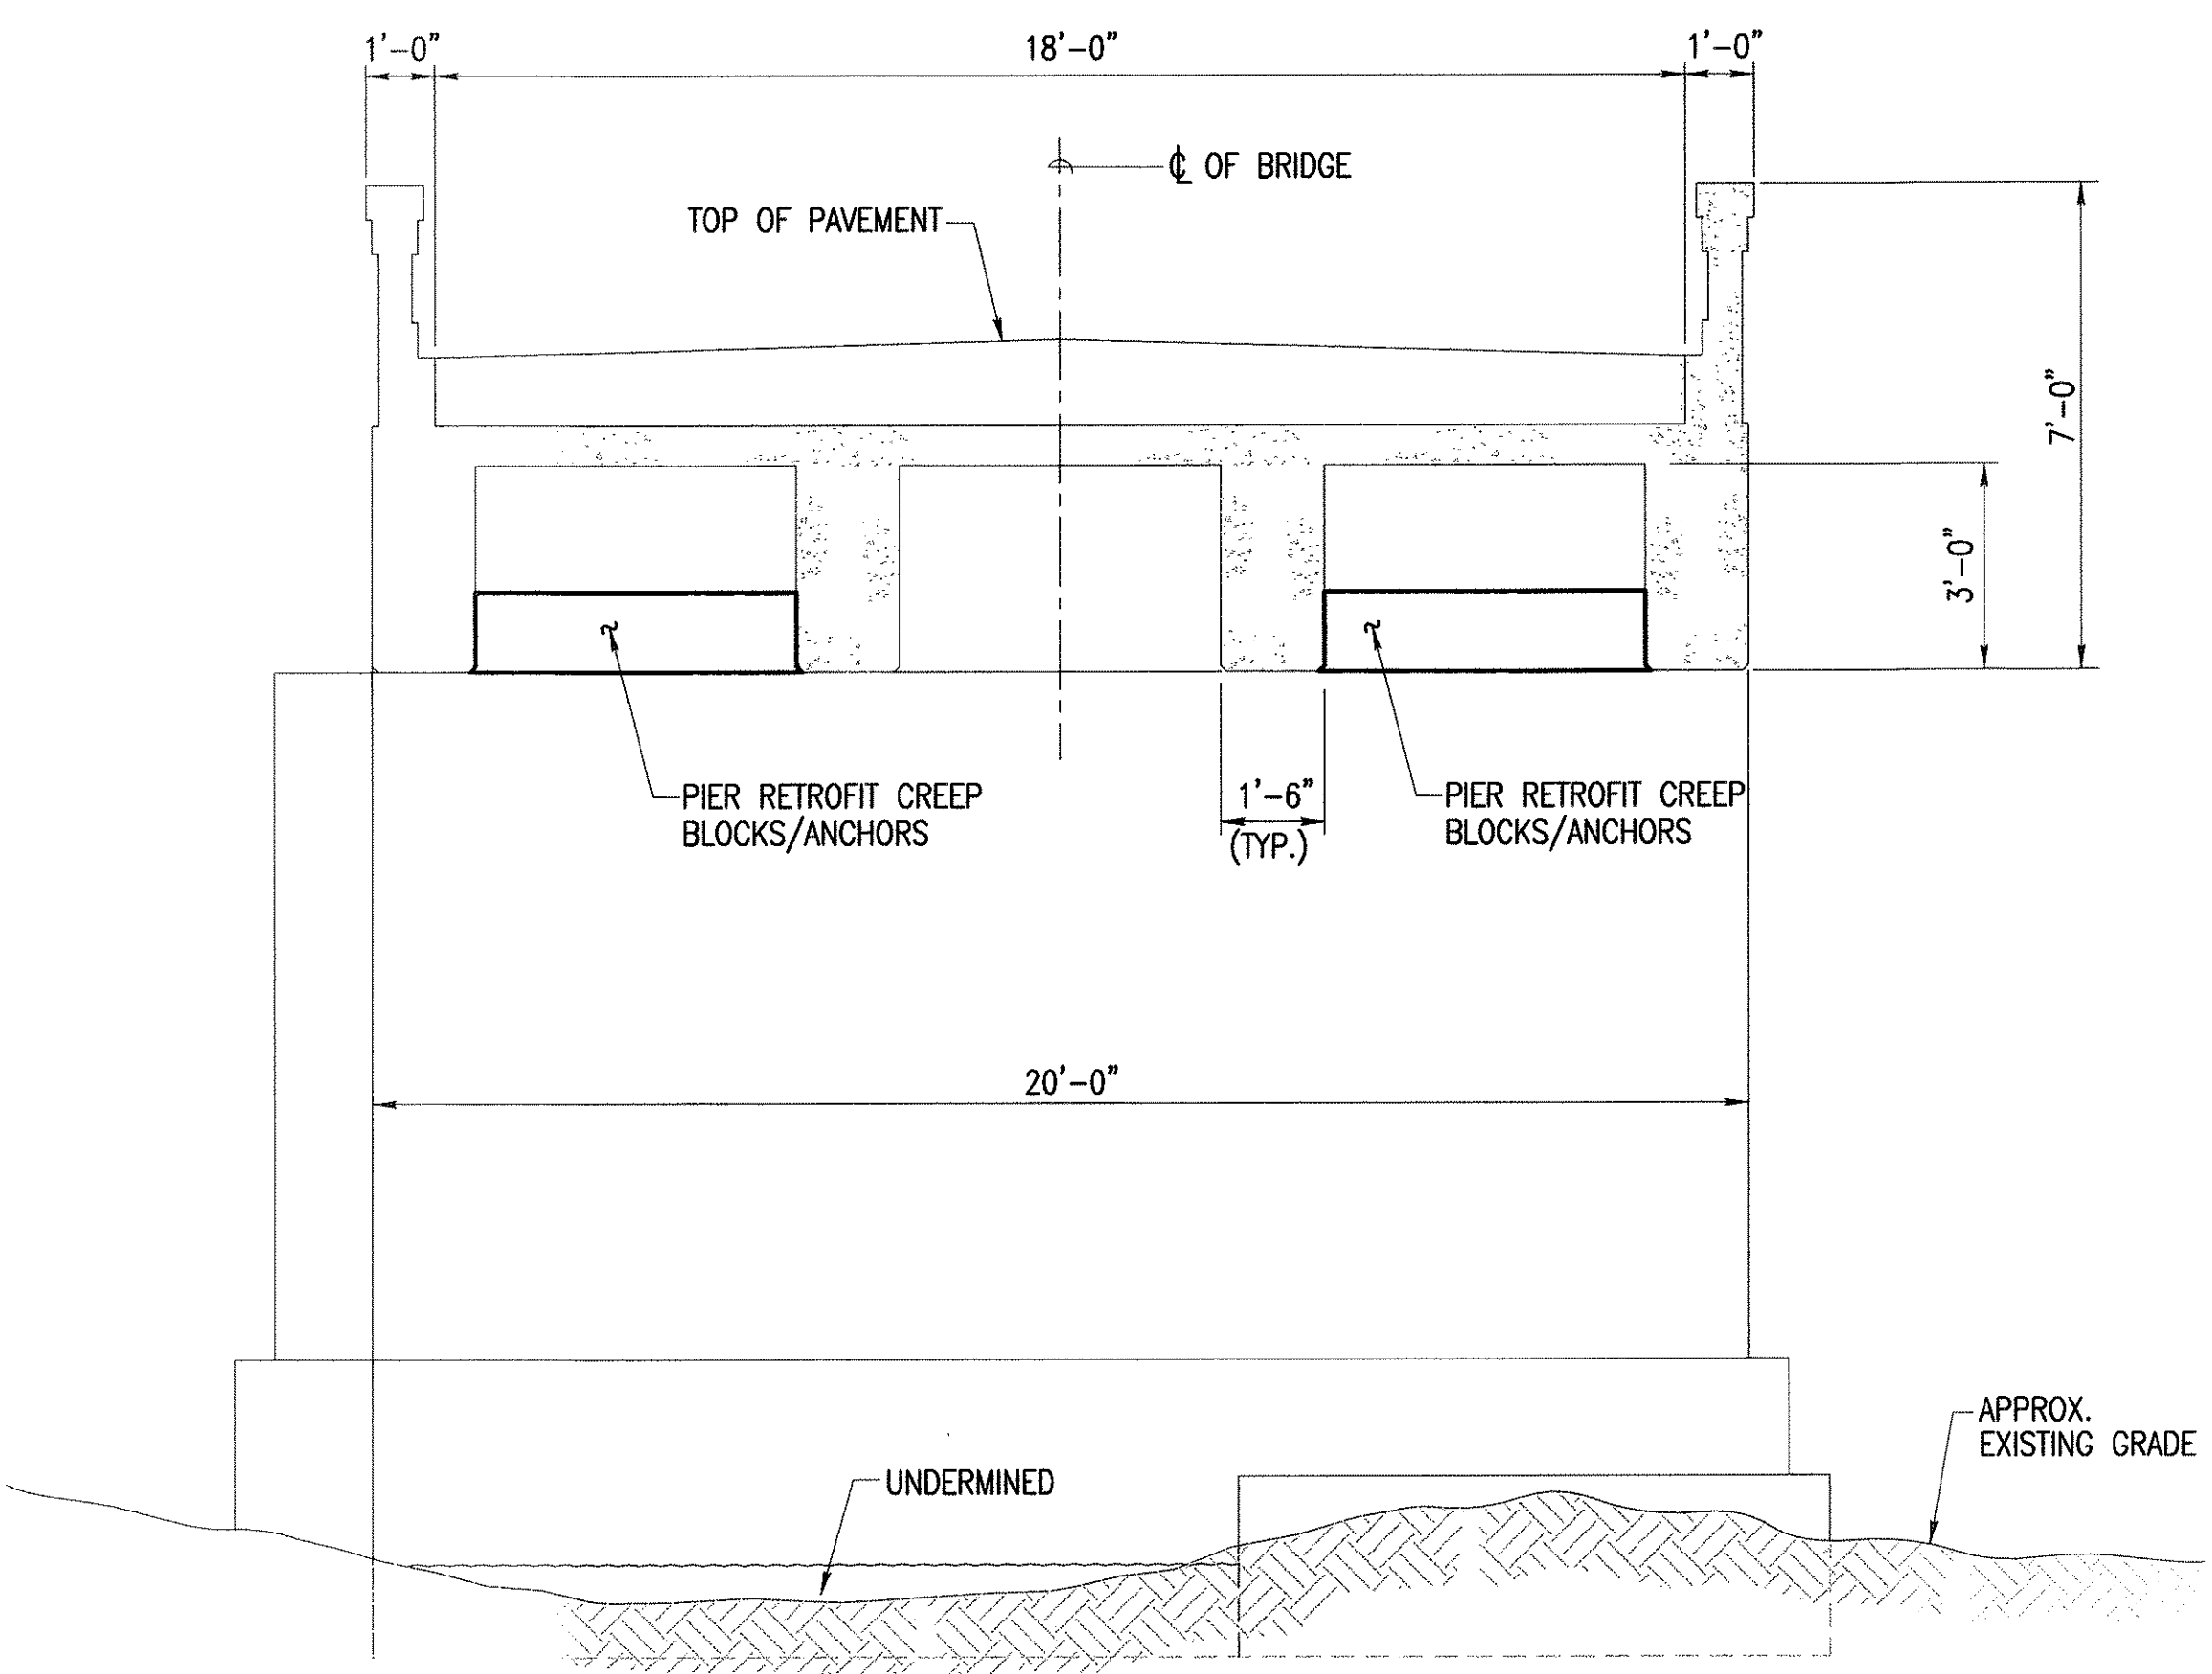



C PIER ELEVATION
S-11 SCALE: 3/8" = 1'-0"

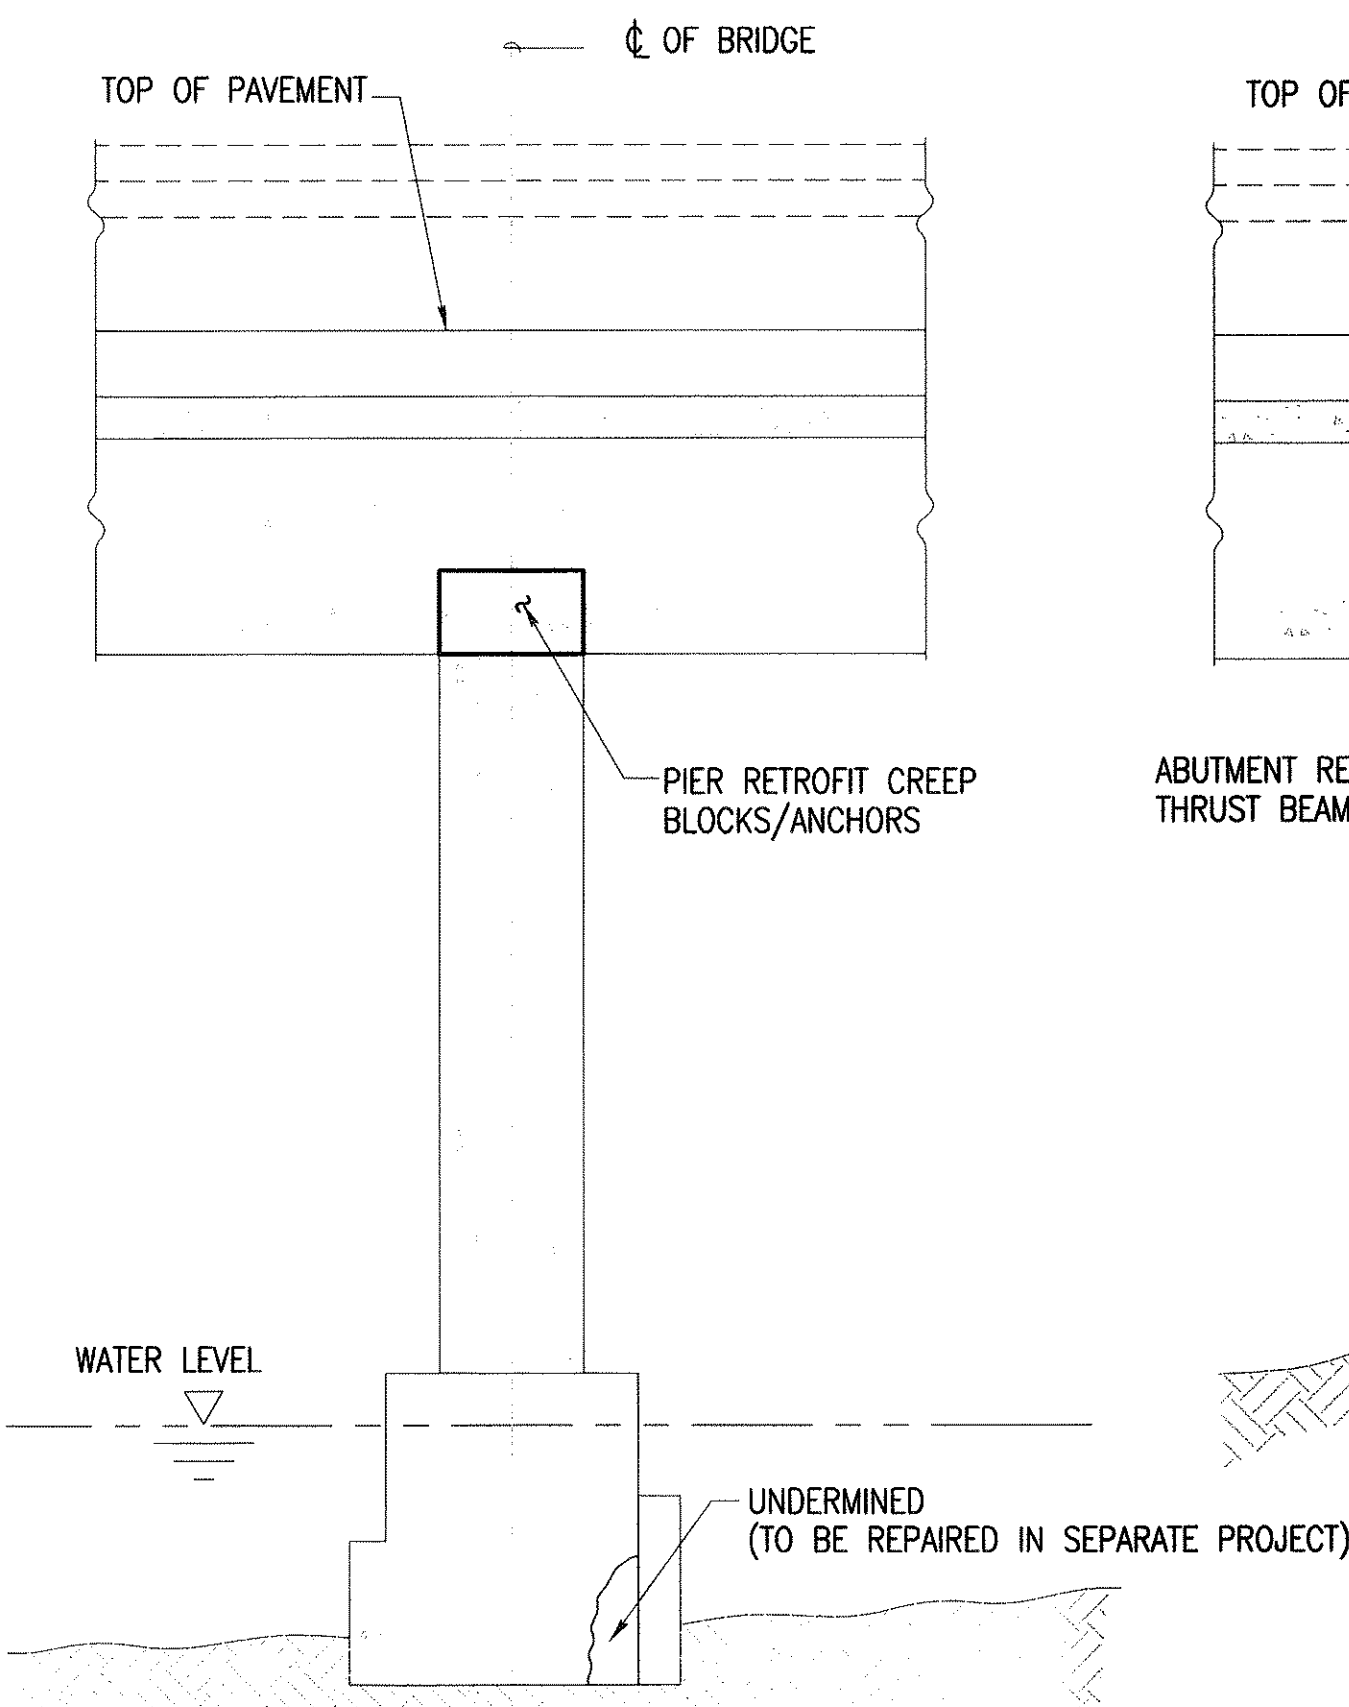

1 PIER SECTION
S-11 SCALE: 3/8" = 1'-0"

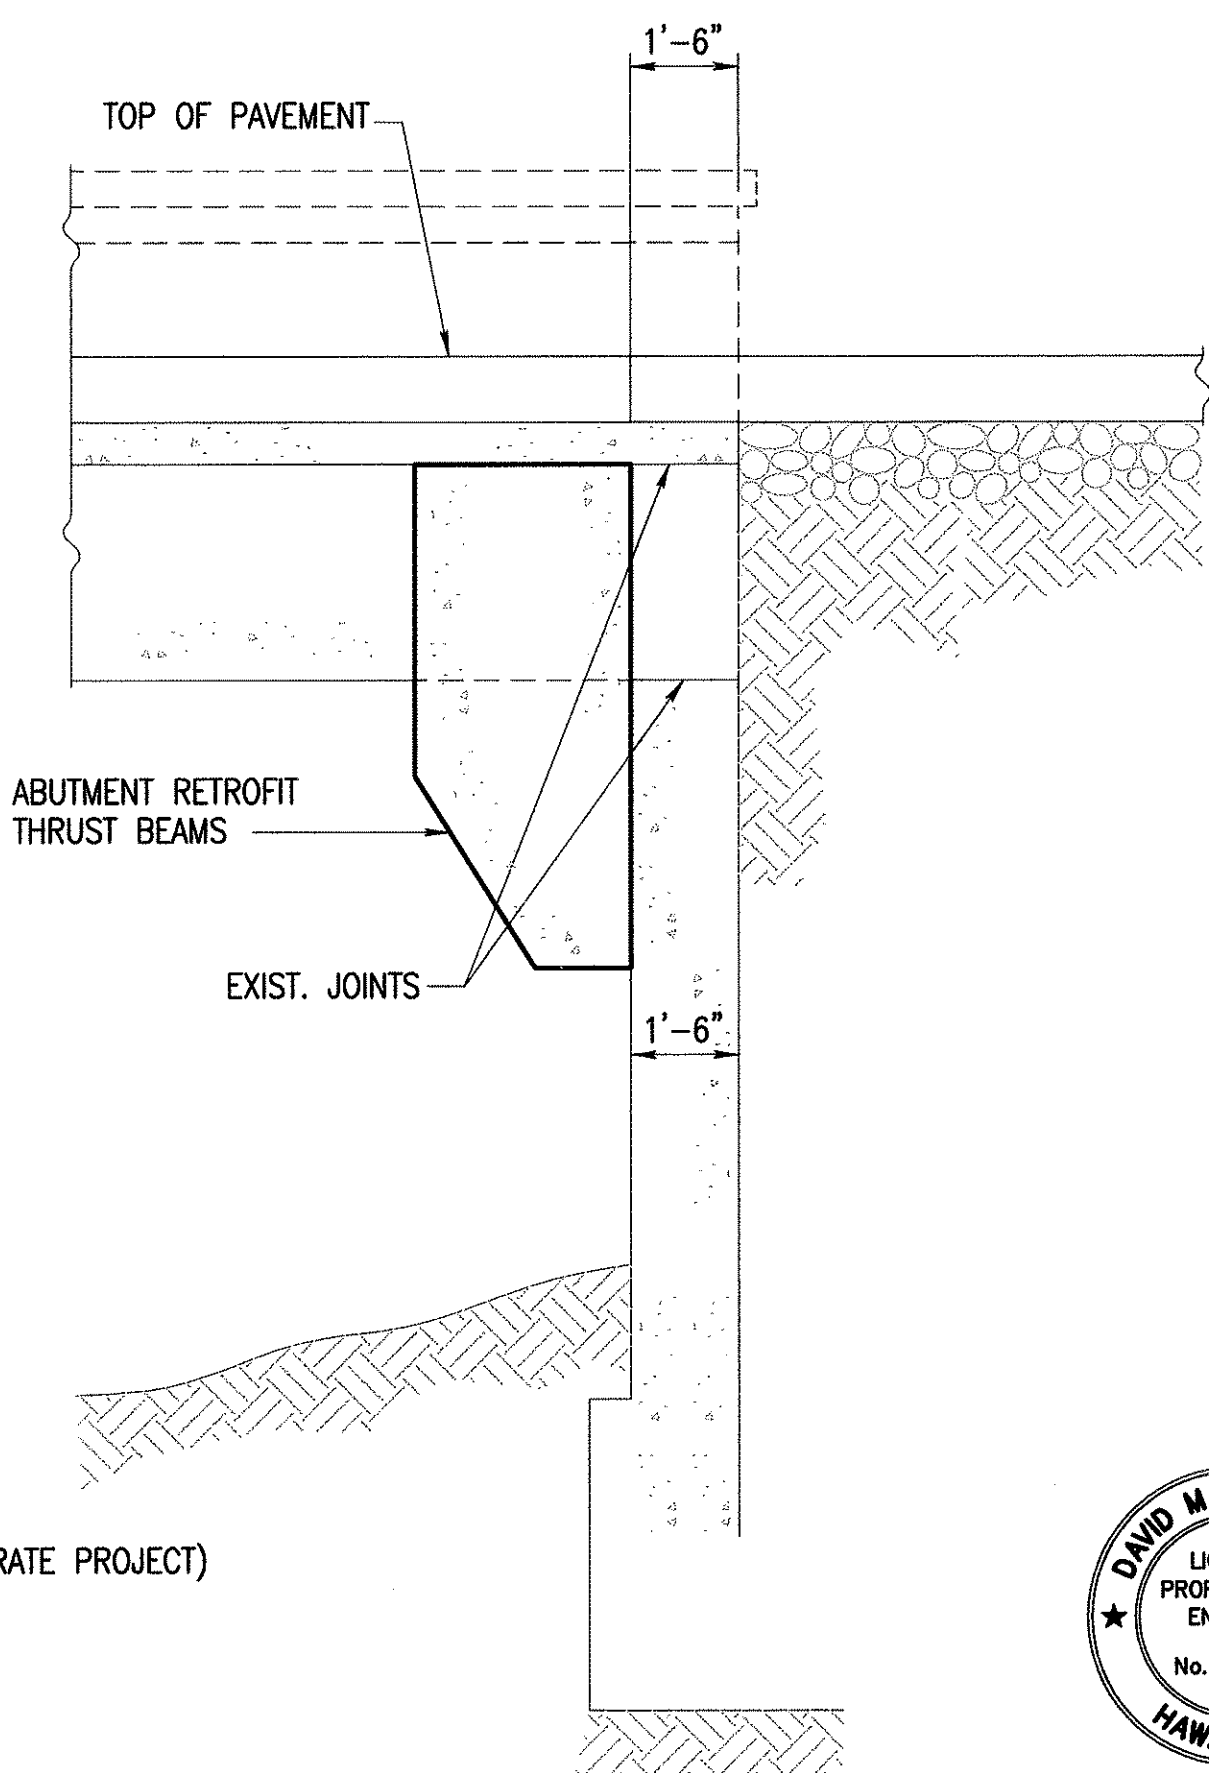

2 ABUTMENT SECTION
S-11 SCALE: 3/8" = 1'-0"

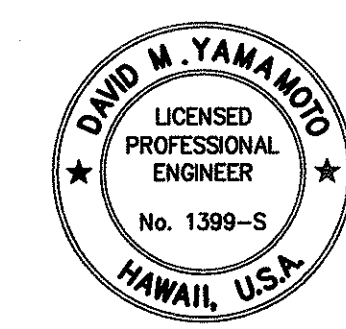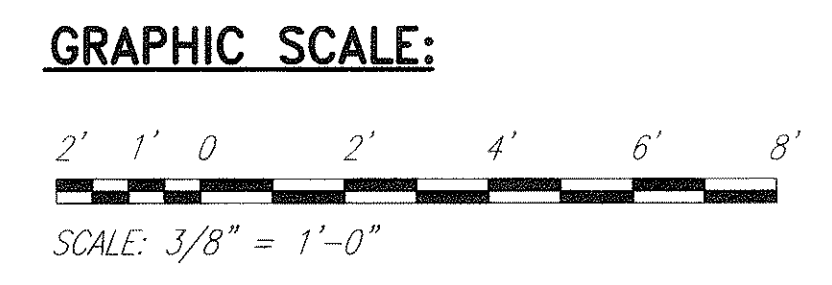

STATE OF HAWAII
DEPARTMENT OF TRANSPORTATION
HIGHWAYS DIVISION

ABUTMENTS & PIER SECTIONS & ELEVATIONS

AAMAKAO BRIDGE

AKONI PULE HIGHWAY, SEISMIC RETROFIT
OF WALAOHIA AND AAMAKAO BRIDGES;
FAIP NO. BR-0270(18)

SCALE: AS NOTED DATE: May 2006

SHEET No. **S-11** OF 12 SHEETS

THIS WORK WAS PREPARED BY
ME OR UNDER MY SUPERVISION
APRIL 30, 2008
EXPIRATION DATE OF LICENSE

Date Saved: Thu, 11 May 2006, 11:31 am
File Location: S:\0222-00\STRUCT\HAWAII\04\6-ADDITION\S-11.dwg

| | | |
|---------------|-------------------|------|
| ORIGINAL PLAN | SURVEY PLOTTED BY | DATE |
| NOTE BOOK | DRAWN BY | |
| No. | DESIGNED BY | |
| | CHECKED BY | |

28"

10" (TYP.)

#5 DOWELS IN DRILLED EPOXIED HOLE. 10 @ BACK FACE, 2 @ FRONT FACE, EACH GIRDER

SYMMETRICAL ABT. C. OF BRIDGE

EXISTING 1/2" BARS @ 5 1/2"

EXISTING DECK

EXISTING PAVEMENT

B
S-12

3'-0"

3-#7 FRONT FACE

1'-6"

9" (TYP.)

EXISTING GIRDER (TYP.)

NEW THRUST BEAM

#5 TIES, 7 PER SPACE

#5 DOWELS TOP & BOT TYP.

#5 TIES, 3 UNDER EACH GIRDER

Technical drawing of a bridge abutment retrofit elevation. The drawing shows a cross-section of the bridge deck and abutment structure. Key components include the existing deck, existing pavement, existing girders, and new creep blocks. Reinforcement details are shown, including existing 1/2 inch diameter stirrups and 1 inch diameter bars, and new #5 dowels in drilled/epoxied holes. Dimensions are provided for various components, such as 9 inches typical for the new creep block width and 12 inches typical for the spacing between the new creep blocks. A note indicates that the existing 1 inch diameter bars are possibly spliced at the pier. A label "D S-12" is present in the upper left corner.

HAWAII

A
S-12

PRESSURE GROUT TOP PORTION OF NEW CONCRETE TO FILL SPACE SOLID.

EXISTING DECK

#5 @ 12" MAX. SPACING ALL AROUND

EXIST. PAVEMENT

EXIST. 1/2" STIRRUPS IN BEAM

#5 DOWELS 10 REQ'D. EACH GIRDER

#5 @ 12" MAX. SPACING ALL AROUND

EXIST. 5-1" BARS IN BEAM

EXISTING ABUTMENT WALL

6" SPACING

28" 10" (TYP.)

#5 DOWELS IN DRILLED EPOXIED HOLE. 4-TOP AND BOTTOM EACH SPACE BETWEEN GIRDERS

TIE REINFORCING CONDITION UNDER GIRDERS.

CLEAN AND ROUGHEN CONTACT SURFACE

9" (TYP.)

1'-0"

5" 7" 5"

6" 6"

1'-8" KEY

1'-4"

4'-0"

3-#7 CONT.

SEE KEY DETAIL

E
S-12

EXIST. 5-1" BARS IN BEAM

#5 DOWEL, 2 REQ'D. EACH GIRDER

CLEAN AND ROUGHEN CONTACT SURFACE

EXIST. 1/2" @ 6" E.W.

1'-4"

3'-0"

#5 @ 12" MAX. SPACING ALL AROUND

NEW THRUST BLOCK

1'-6"

NOTE:
CONCRETE FOR THRUST BEAMS

[illegible]

31