
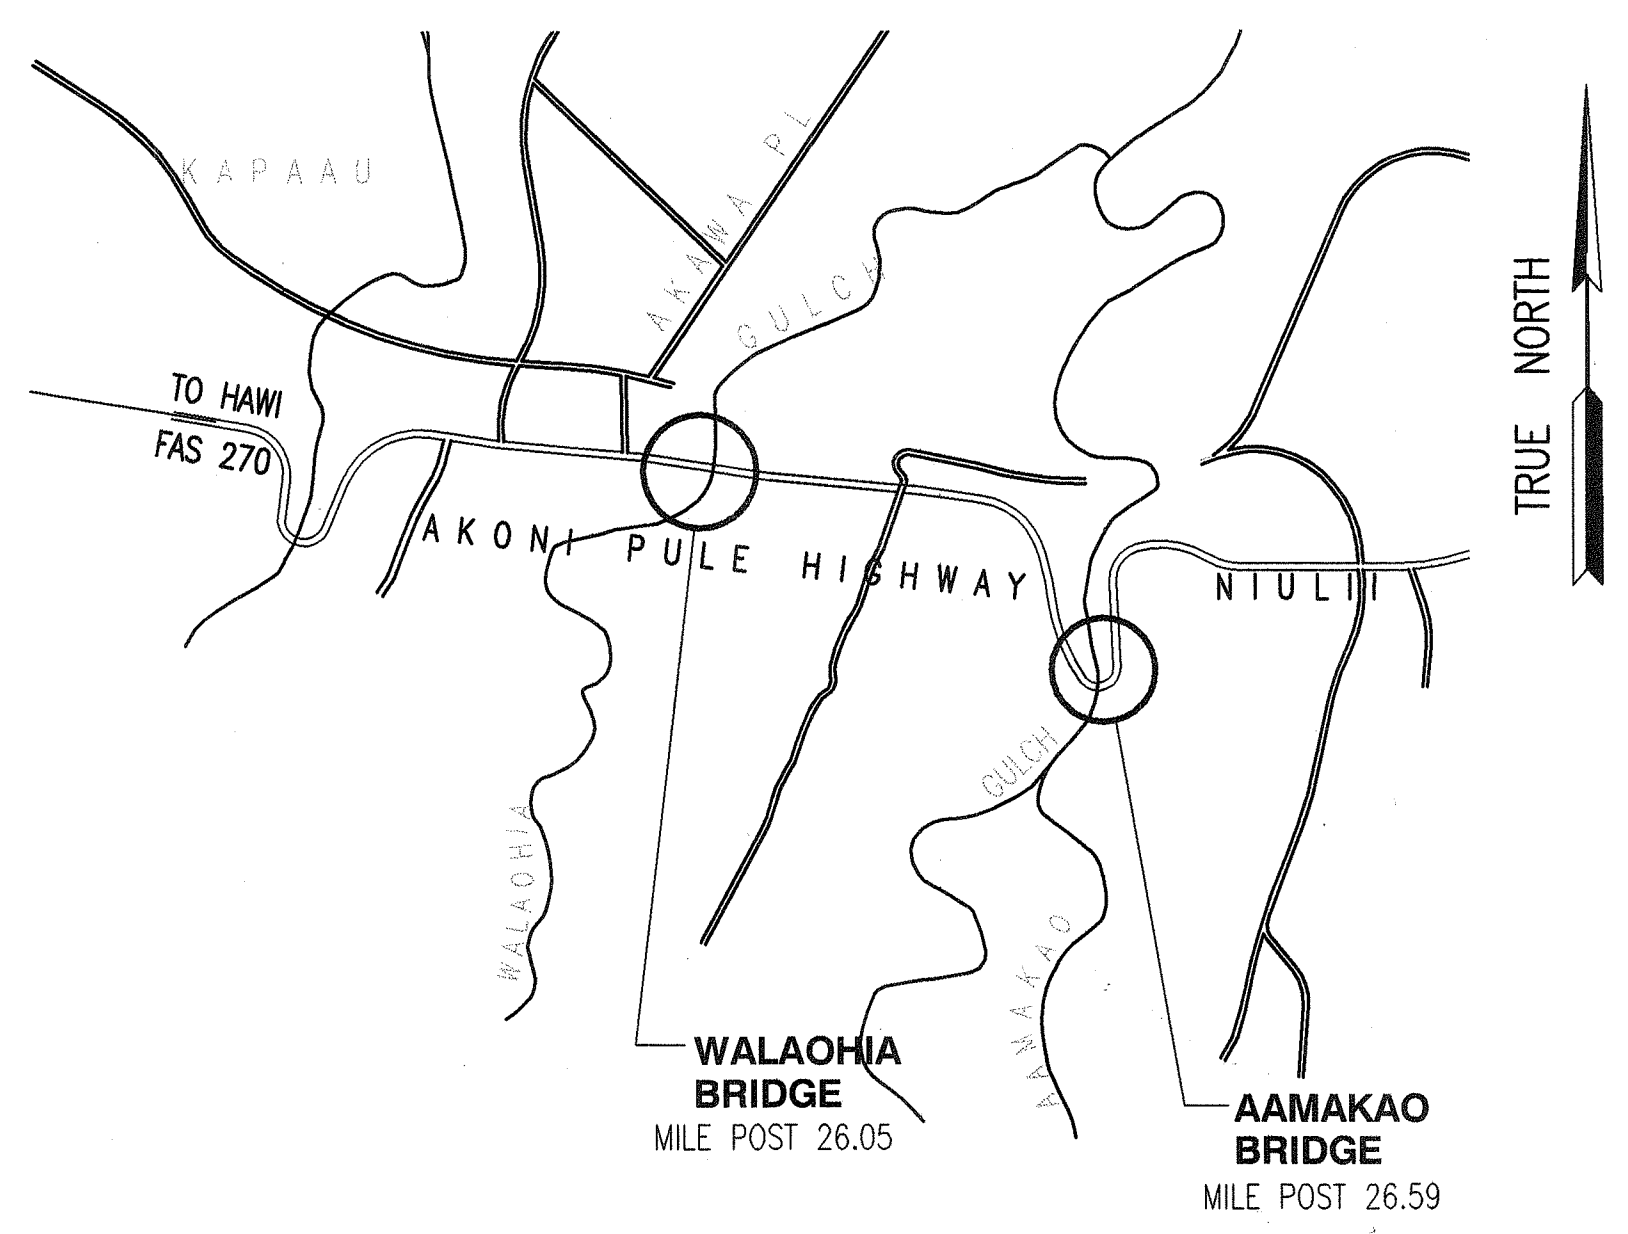
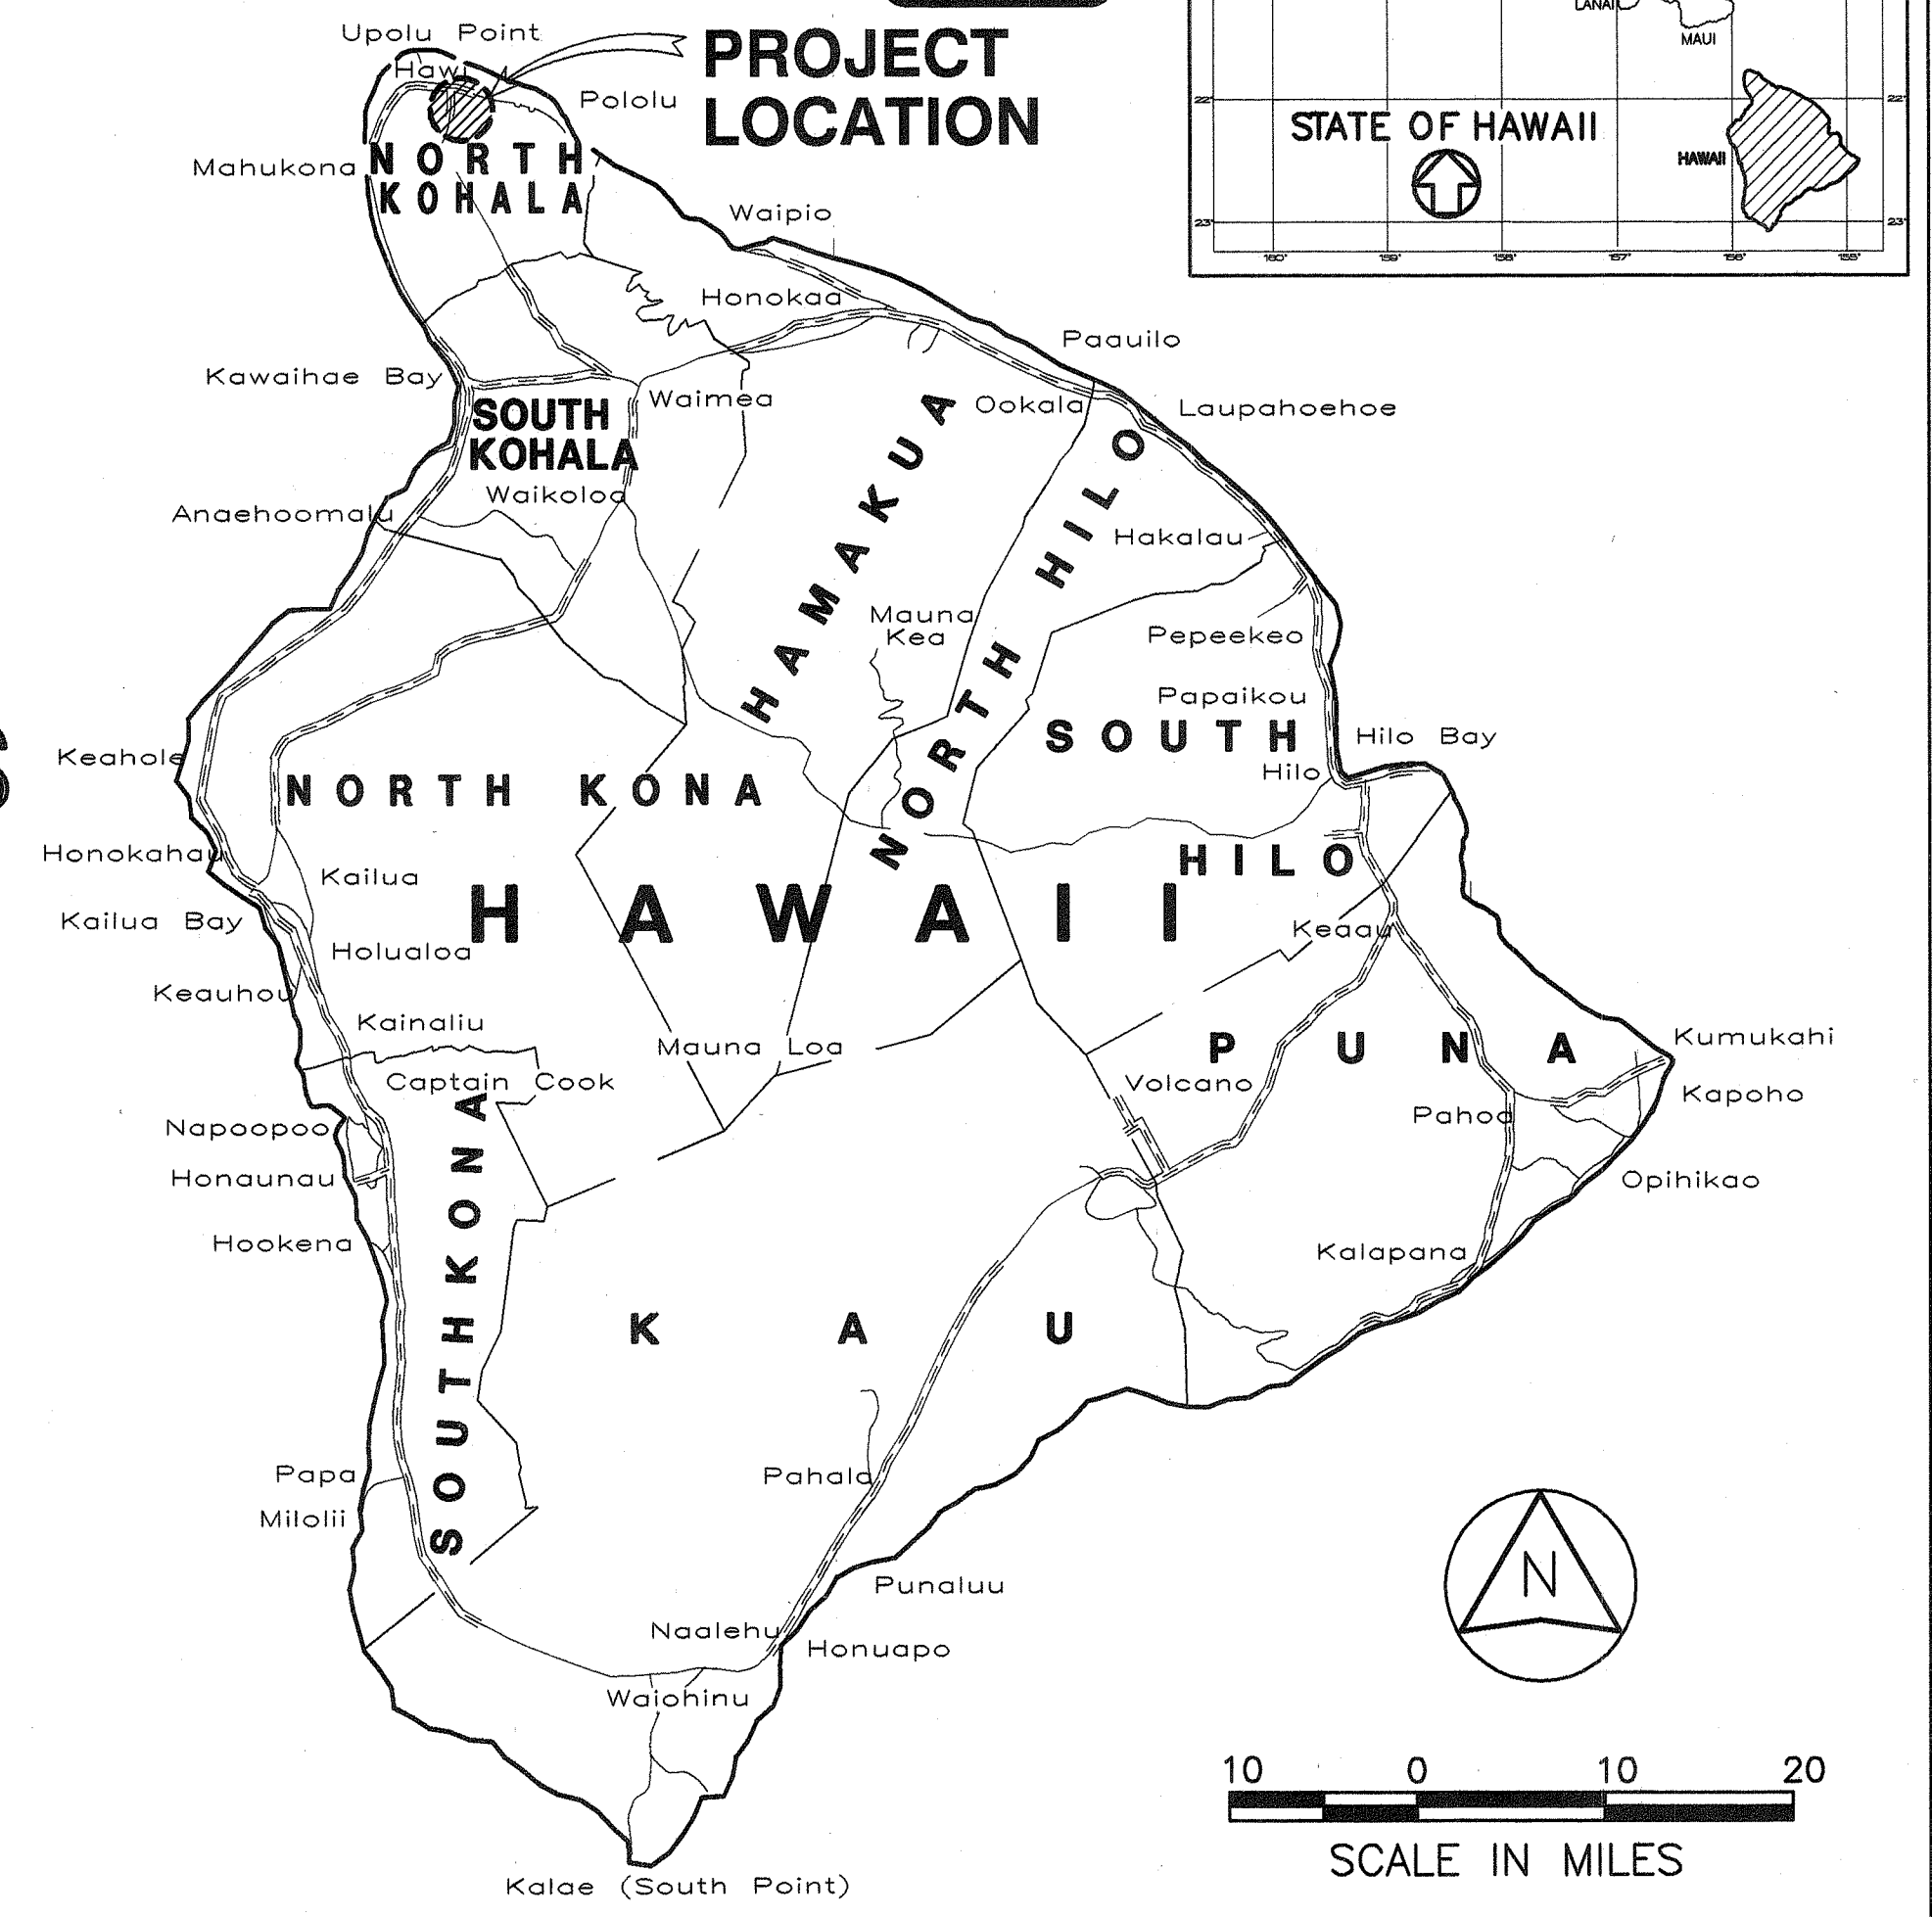


| FED. ROAD DIST. NO. | STATE | FEDERAL - AID PROJ. NO. | FISCAL YEAR | SHEET NO. | TOTAL SHEETS |
|---------------------|-------|-------------------------|-------------|-----------|--------------|
| HAWAII | HAW. | BR-0270(18) | 2006 | 1 | 31 |

| INDEX TO DRAWINGS | |
|-------------------|--|
| SHEET NO. | DESCRIPTION |
| 1 | TITLE SHEET |
| 2 | STANDARD PLANS SUMMARY |
| 3-4 | CONSTRUCTION NOTES & LEGEND |
| 5-6 | ENVIRONMENTAL NOTES |
| 7 | BEST MANAGEMENT PRACTICE NOTES |
| 8-10 | BORING LOGS |
| 11 | KEY PLAN |
| 12 | SITE PLAN - CONSTRUCTION PARCEL |
| 13 | SITE PLAN - WALAOHIA BRIDGE |
| 14 | SITE PLAN - AAMAKAO BRIDGE |
| 15 | TRAFFIC CONTROL NOTES |
| 16 | LOW SPEED UNDIVIDED HIGHWAY WORKS ZONE SIGNING NOTES & DETAILS |
| 17-19 | TRAFFIC CONTROL PLANS |
| 20-31 | STRUCTURAL PLANS |

STATE OF HAWAII
 DEPARTMENT OF TRANSPORTATION
 HIGHWAYS DIVISION
 HONOLULU, HAWAII
"AS-BUILT"
 PLANS FOR
AKONI PULE HIGHWAY
SEISMIC RETROFIT OF
WALAOHIA AND AAMAKAO BRIDGES
 FEDERAL - AID PROJECT No. BR-0270(18)
 DISTRICT OF NORTH KOHALA
 ISLAND OF HAWAII

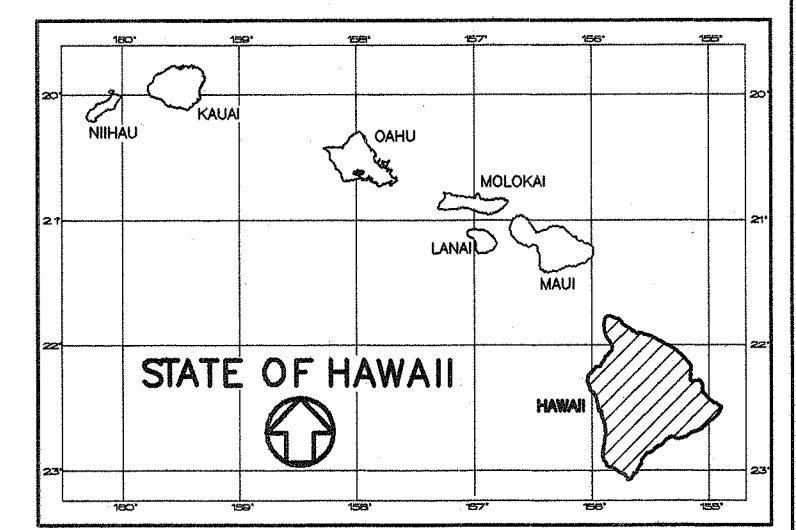

——— FEDERAL AID PROJECTS PREVIOUSLY CONSTRUCTED OR UNDER CONSTRUCTION
 AKONI PULE HIGHWAY MILE POST 26.05 AND MILE POST 26.59

ISLAND OF HAWAII

CHANGES MADE DURING CONSTRUCTION HAVE BEEN INCORPORATED ON THESE PLANS EXCEPT CHANGES IN THE ORIGINAL THEORETICAL QUANTITIES. FOR ACTUAL QUANTITIES, REFER TO PROJECT LEDGER AND/OR COMPUTATION BOOK.
 S. J. L. Chan 11-30-09
 RESIDENT ENGINEER DATE

DEPARTMENT OF TRANSPORTATION
 STATE OF HAWAII
 APPROVED:
 [Signature] 12-28-05
 DIR. OF TRANSPORTATION DATE

SATO & ASSOCIATES, INC. HWY - DS 692-7545 DECEMBER 2005
 DESIGNED BY P. S. & E. BY PHONE DATE

| | | |
|---------------|-------------------|------|
| ORIGINAL PLAN | SURVEY PLOTTED BY | DATE |
| NOTE BOOK | DRAWN BY | |
| No. | TRACED BY | |
| | QUANTITIES BY | |
| | CHECKED BY | |

FILE: R:\AkoniPuleHwy\SH1.dwg
 XREF: 02022-00
 Date Saved: Wed, 14 Dec 2005, 2:51pm
 File Location: R:\AkoniPuleHwy\WORKING\DWGS\Aamakao-tb1e.dwg