


FED. ROAD DIST. NO.	STATE	FED. AID PROJECT	FISCAL YEAR	SHEET NO.	TOTAL SHEETS
HAWAII	HAW.	STP-0270(020)	2012	7	15

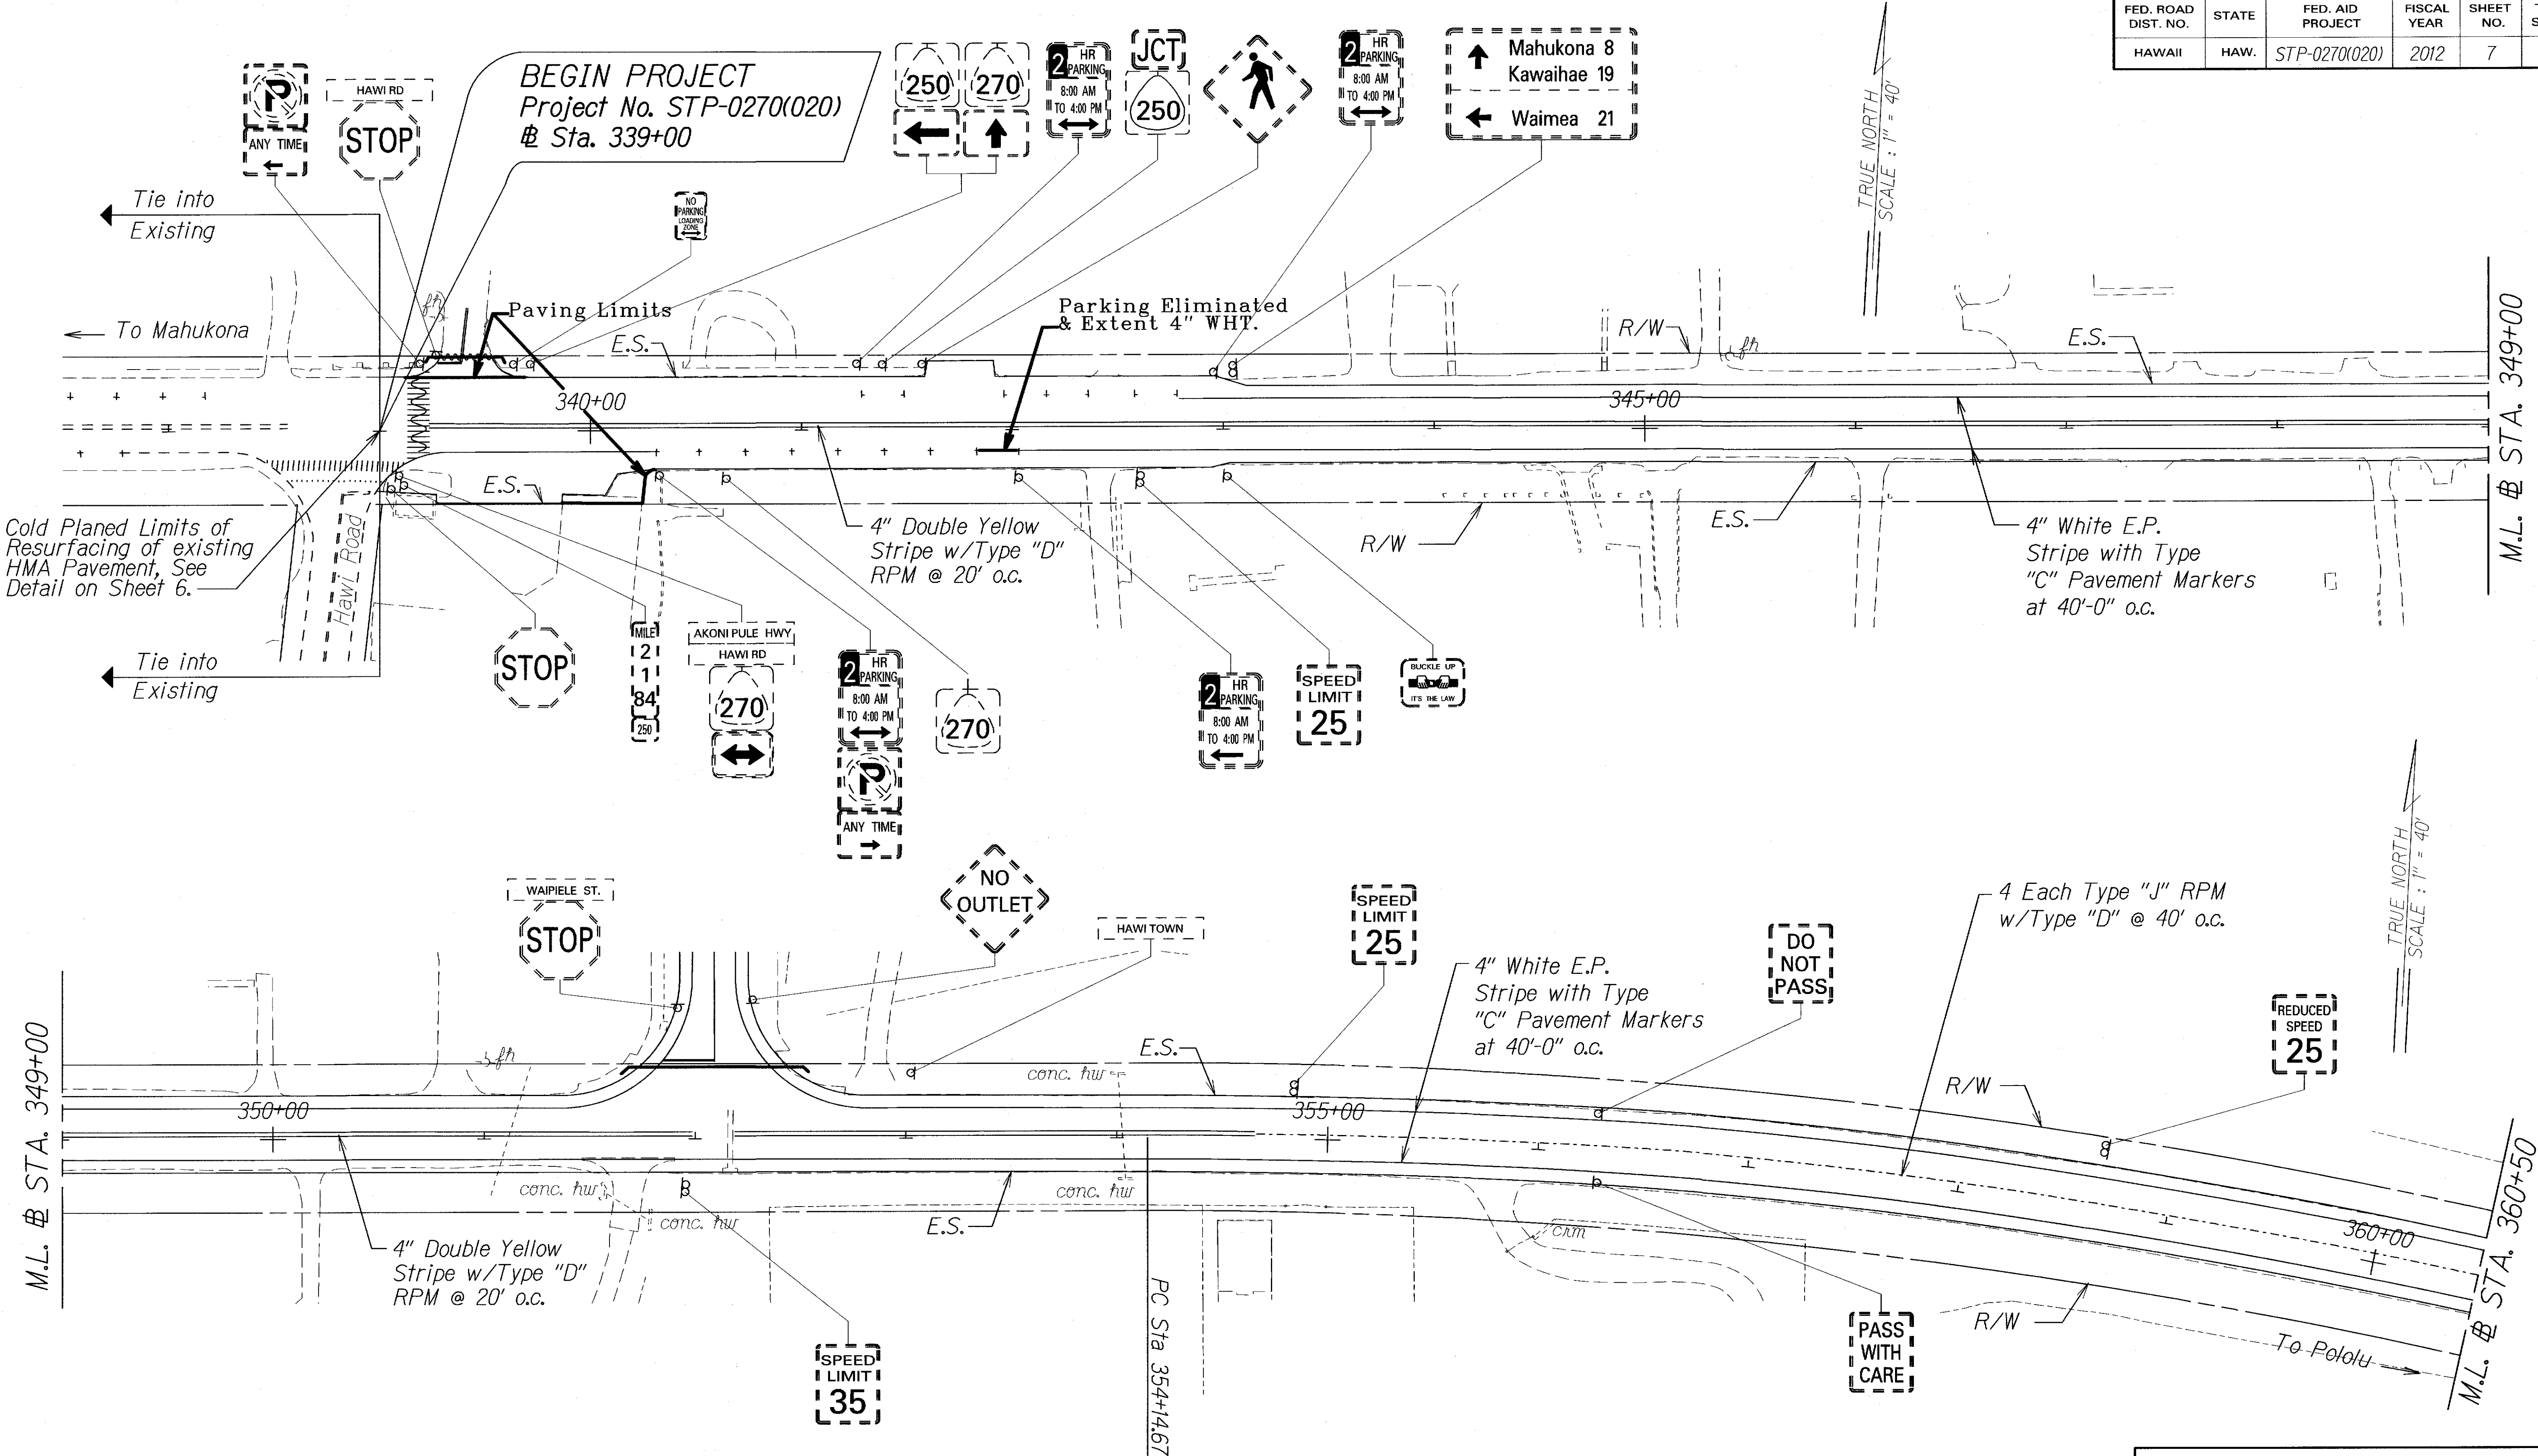

SURVEY PLOTTED BY	DATE
DRAWN BY	
DESIGNED BY	
CHECKED BY	
ORIGINAL PLAN	
NOTE BOOK	
DATE	
BY	

- Notes:
1. All existing signs (dashed) with post are to remain.
 2. All existing signs in conflict with construction signs are to be covered.
 3. This work shall be considered incidental to various contract items.


LEGEND FOR AS-BUILT POSTINGS	
	Squiggly line for as-built deletion
	Double line for as-built deletion
Roadway	Text for as-built posting

STATE OF HAWAII
DEPARTMENT OF TRANSPORTATION
HIGHWAYS DIVISION

ROADWAY PLANS
AKONI PULE HIGHWAY
Pavement Preventive Maintenance
Hawi Town to Kapaau Town
Federal Aid Project No. STP-0270(020)
Scale: 1"=40' Date: February, 2012

SHEET No. 1 OF 6 SHEETS

FED. ROAD DIST. NO.	STATE	FED. AID PROJECT	FISCAL YEAR	SHEET NO.	TOTAL SHEETS
HAWAII	HAW.	STP-0270(020)	2012	8	15

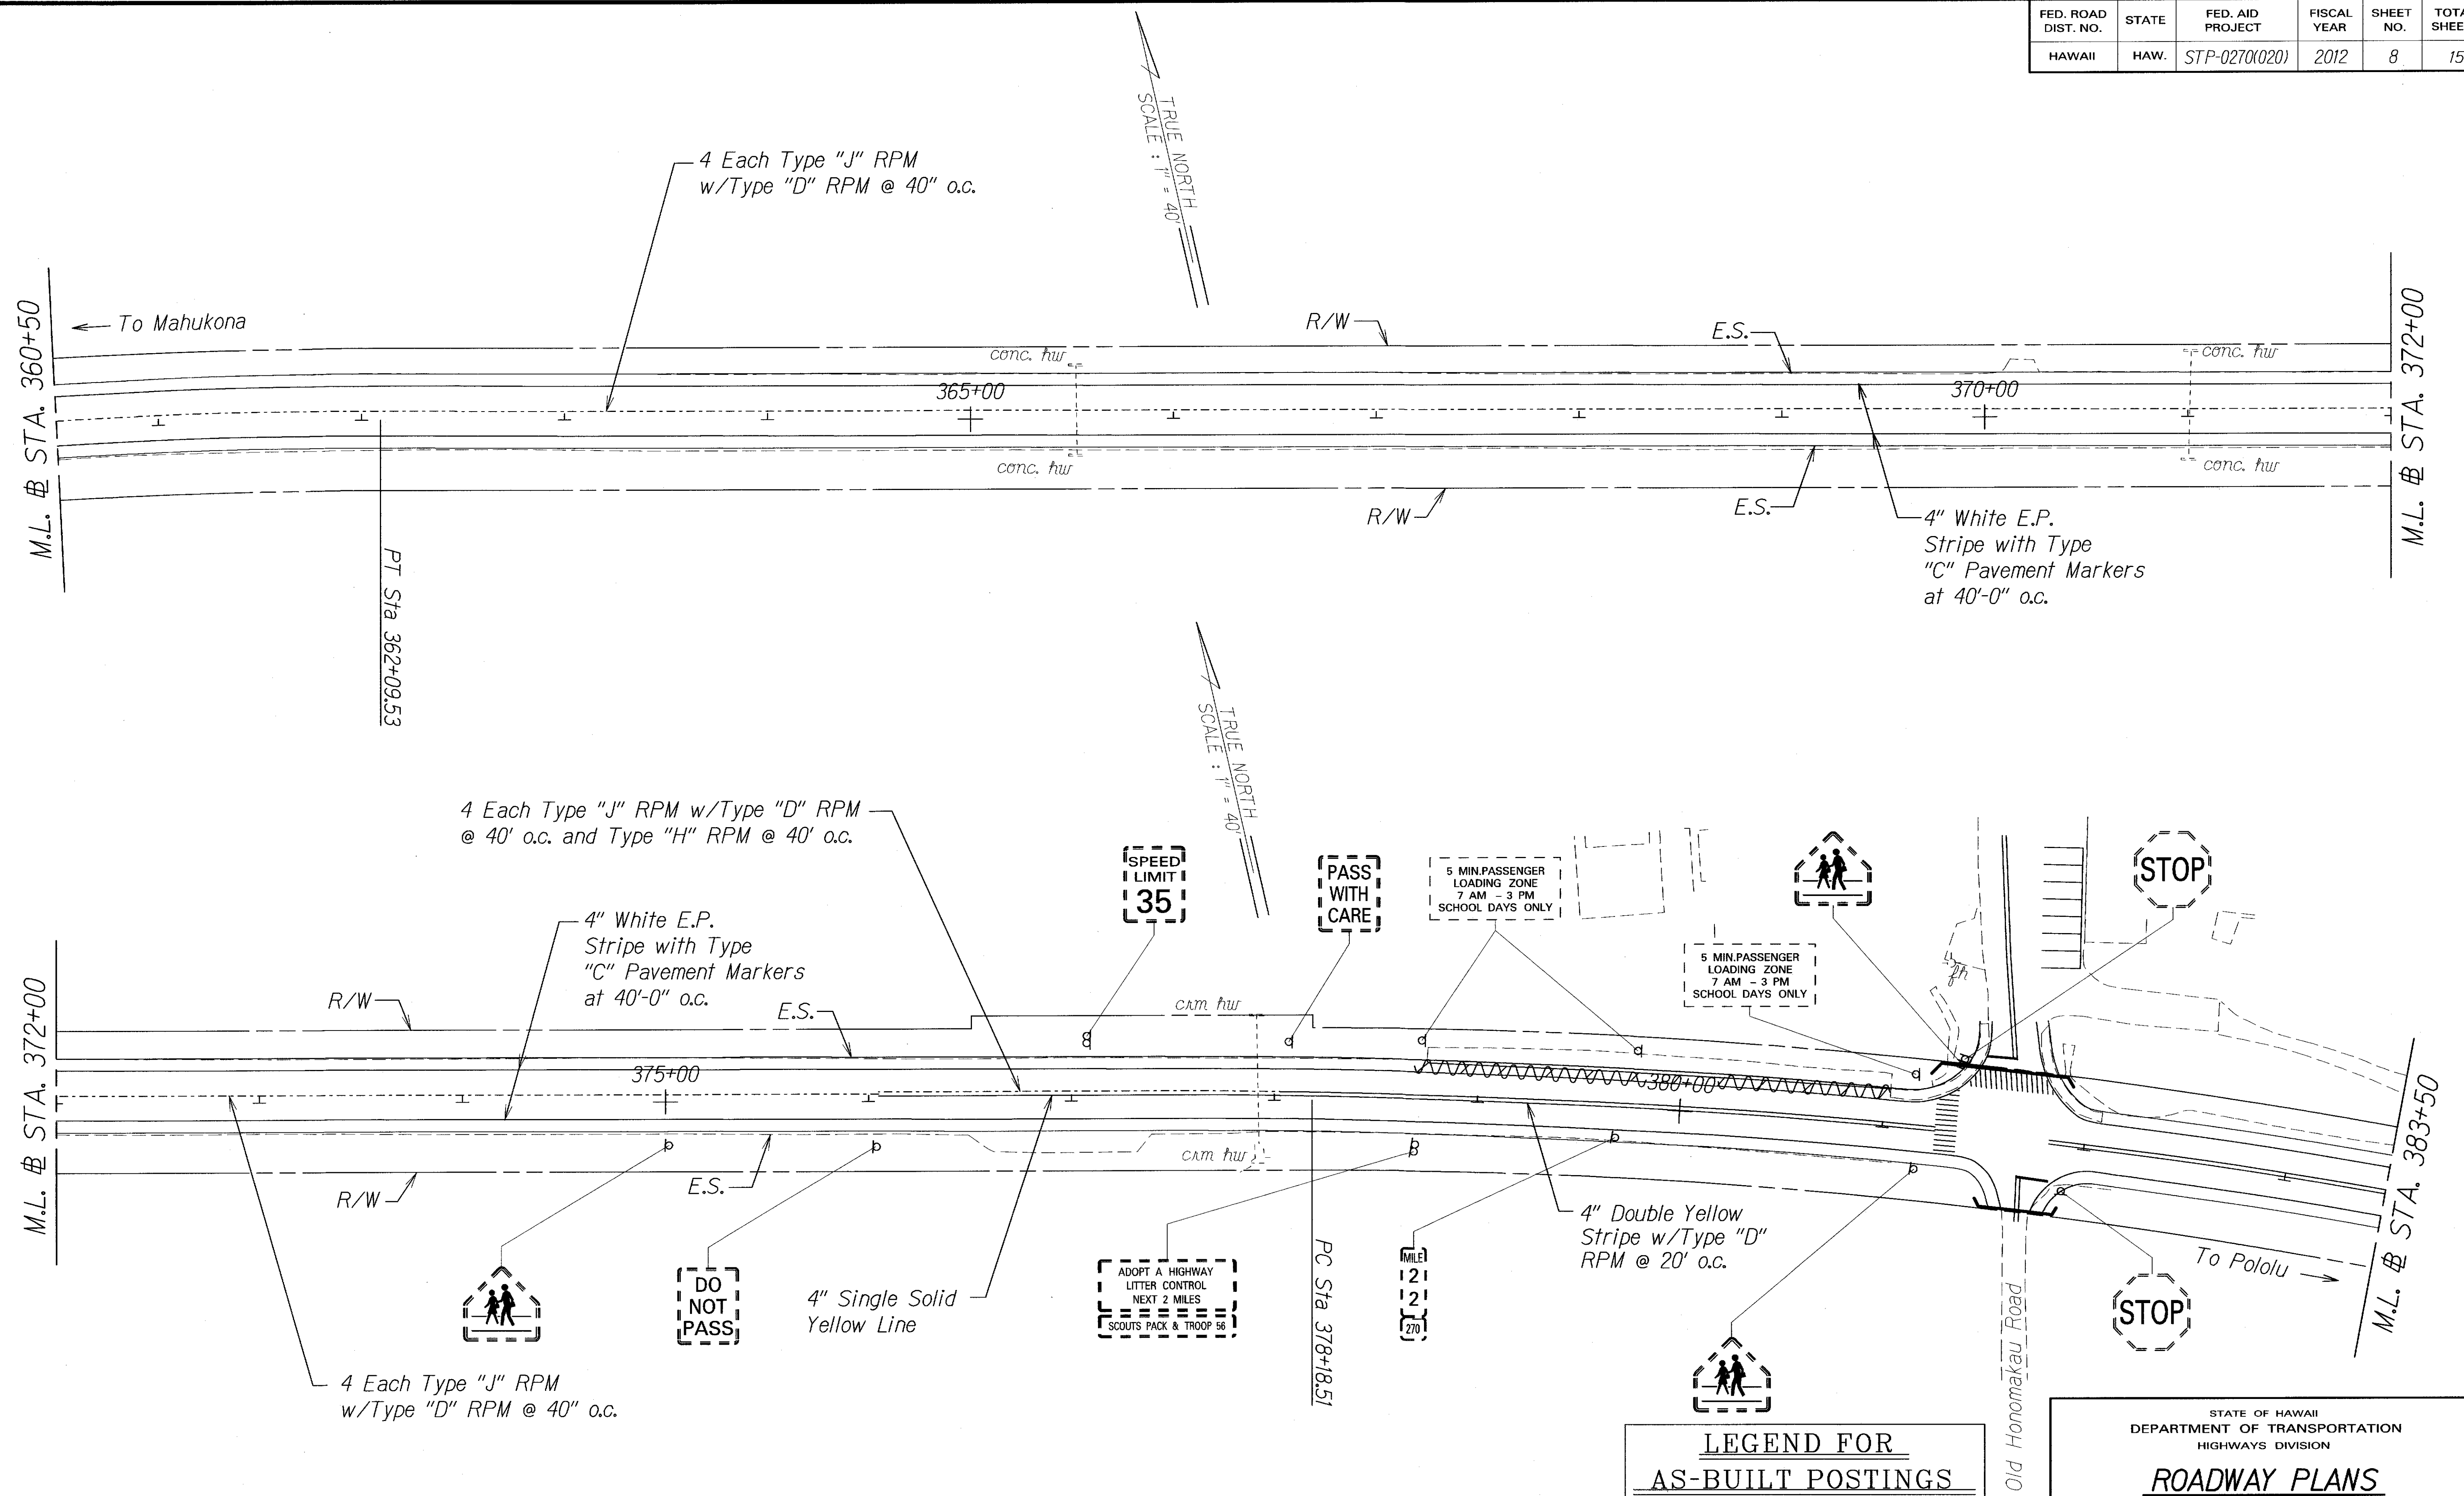

- Notes:
1. All existing signs (dashed) with post are to remain.
 2. All existing signs in conflict with construction signs are to be covered.
 3. This work shall be considered incidental to various contract items.

LEGEND FOR AS-BUILT POSTINGS



	Squiggly line for as-built deletion
	Double line for as-built deletion
Roadway	Text for as-built posting

STATE OF HAWAII
DEPARTMENT OF TRANSPORTATION
HIGHWAYS DIVISION

ROADWAY PLANS

AKONI PULE HIGHWAY
Pavement Preventive Maintenance
Hawi Town to Kapaau Town
Federal Aid Project No. STP-0270(020)
Scale: 1"=40' Date: February, 2012

FED. ROAD DIST. NO.	STATE	FED. AID PROJECT	FISCAL YEAR	SHEET NO.	TOTAL SHEETS
HAWAII	HAW.	STP-0270(020)	2012	9	15

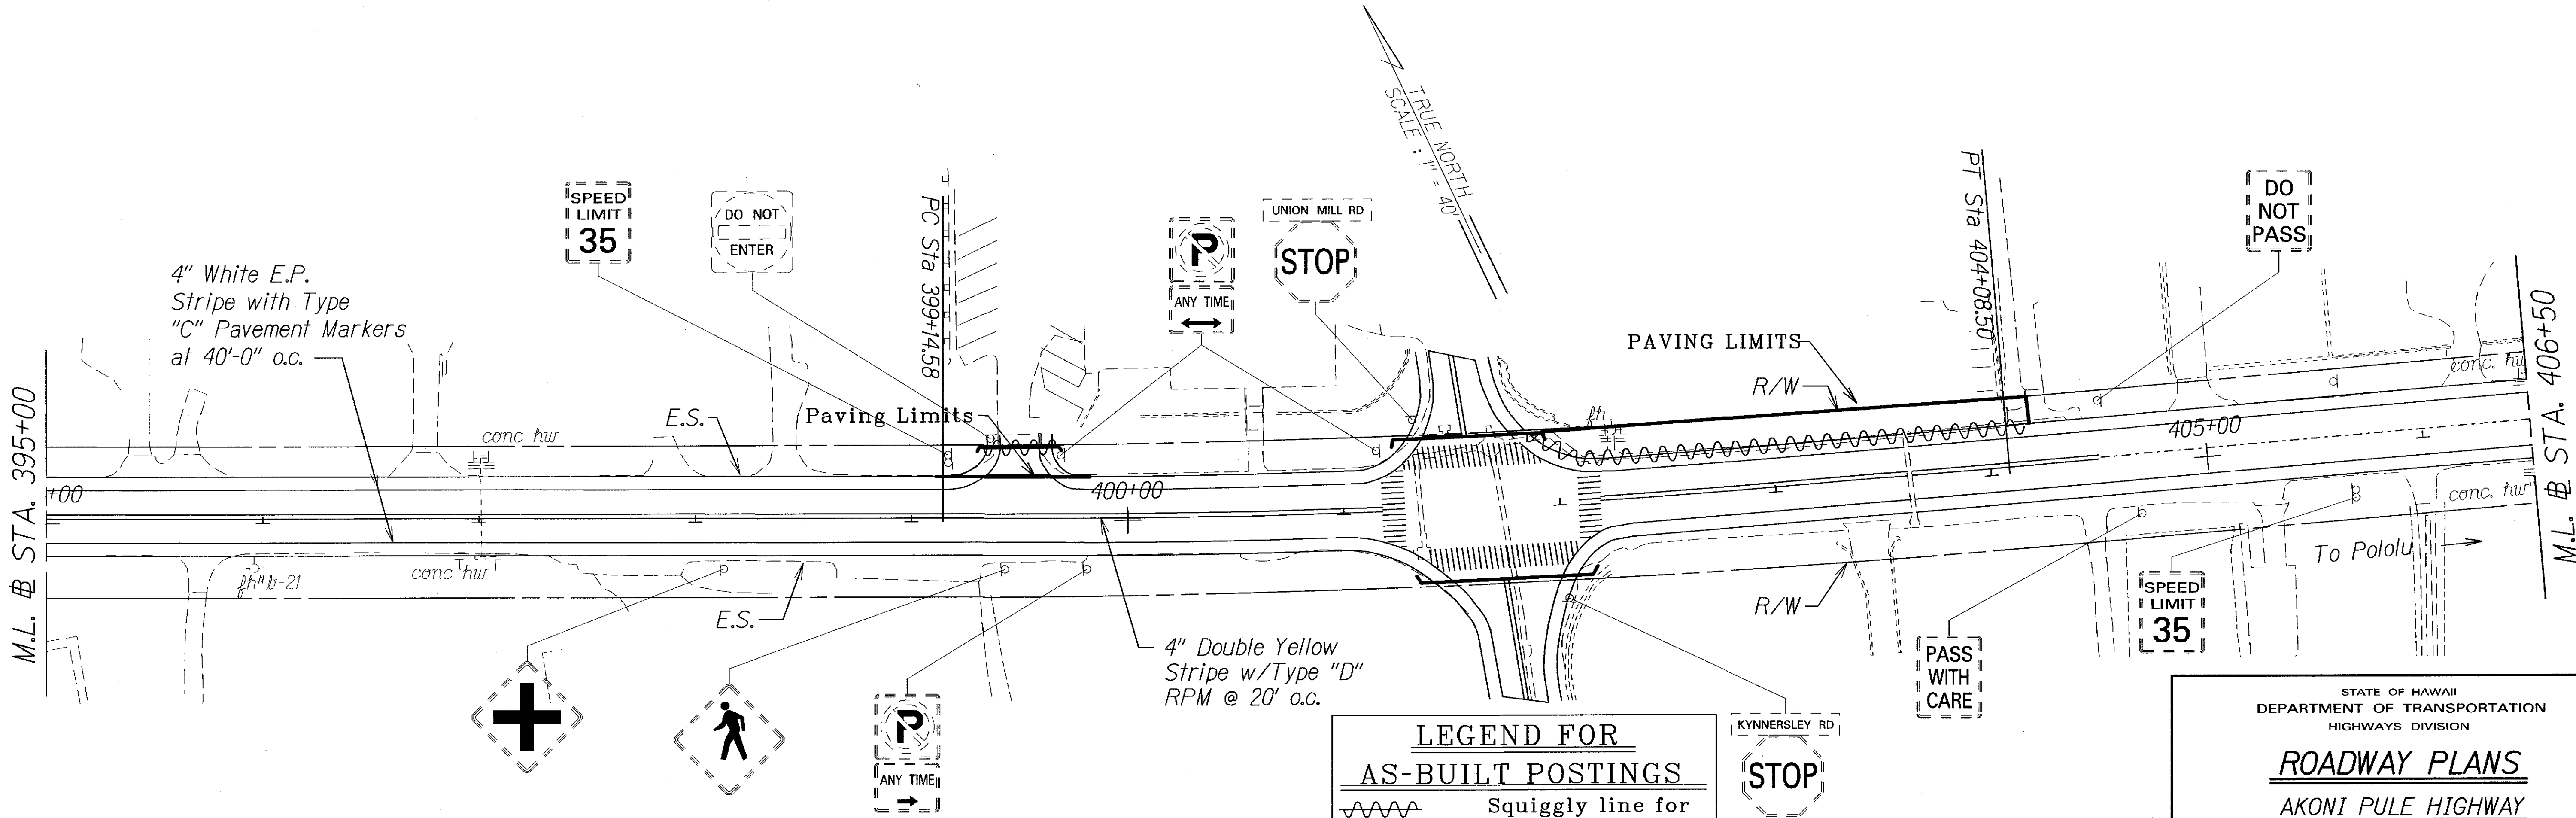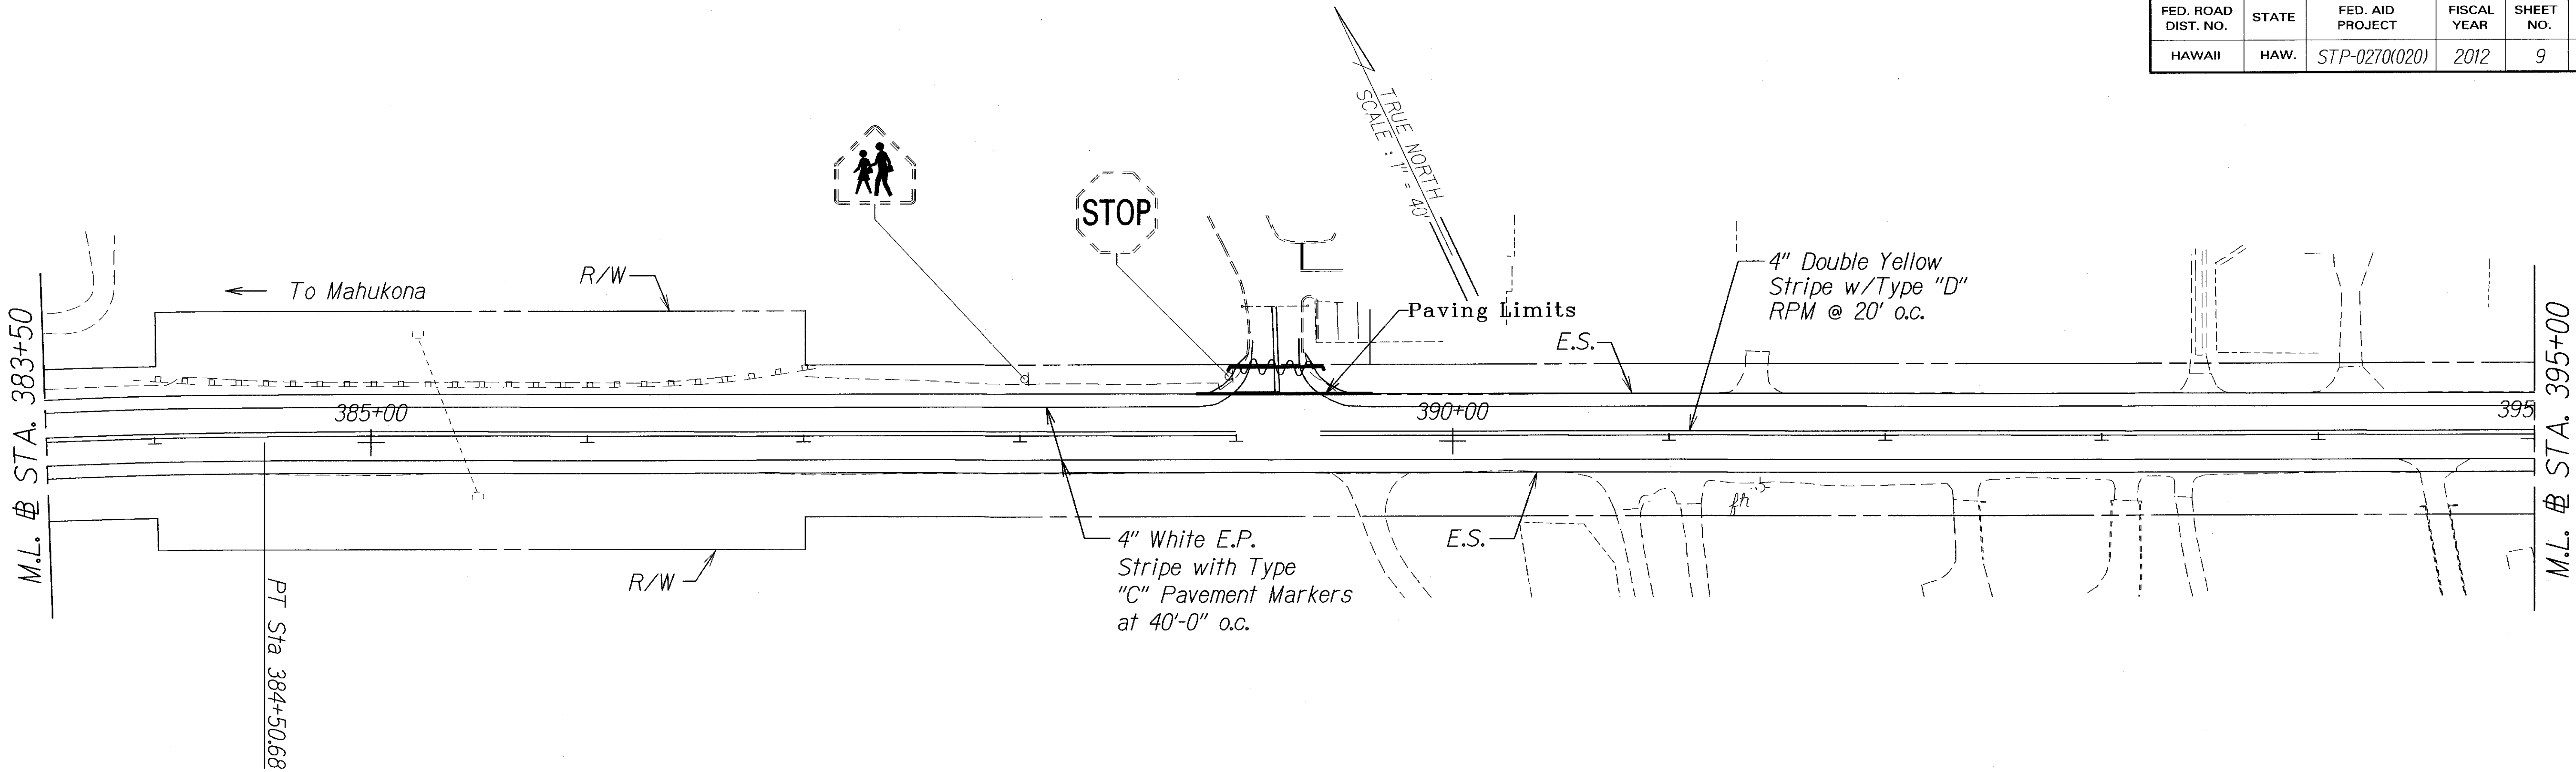

ORIGINAL PLAN	SURVEY PLOTTED BY	DATE
NOTE BOOK	DESIGNED BY	
	QUANTITIES BY	
	CHECKED BY	

- Notes:
1. All existing signs (dashed) with post are to remain.
 2. All existing signs in conflict with construction signs are to be covered.
 3. This work shall be considered incidental to various contract items.


LEGEND FOR AS-BUILT POSTINGS	
	Squiggly line for as-built deletion
	Double line for as-built deletion
Roadway	Text for as-built posting

STATE OF HAWAII
DEPARTMENT OF TRANSPORTATION
HIGHWAYS DIVISION

ROADWAY PLANS
AKONI PULE HIGHWAY
Pavement Preventive Maintenance
Hawi Town to Kapaau Town
Federal Aid Project No. STP-0270(020)
Scale: 1"=40' Date: February, 2012

SHEET No. 3 OF 6 SHEETS

FED. ROAD DIST. NO.	STATE	FED. AID PROJECT	FISCAL YEAR	SHEET NO.	TOTAL SHEETS
HAWAII	HAW.	STP-0270(020)	2012	10	15

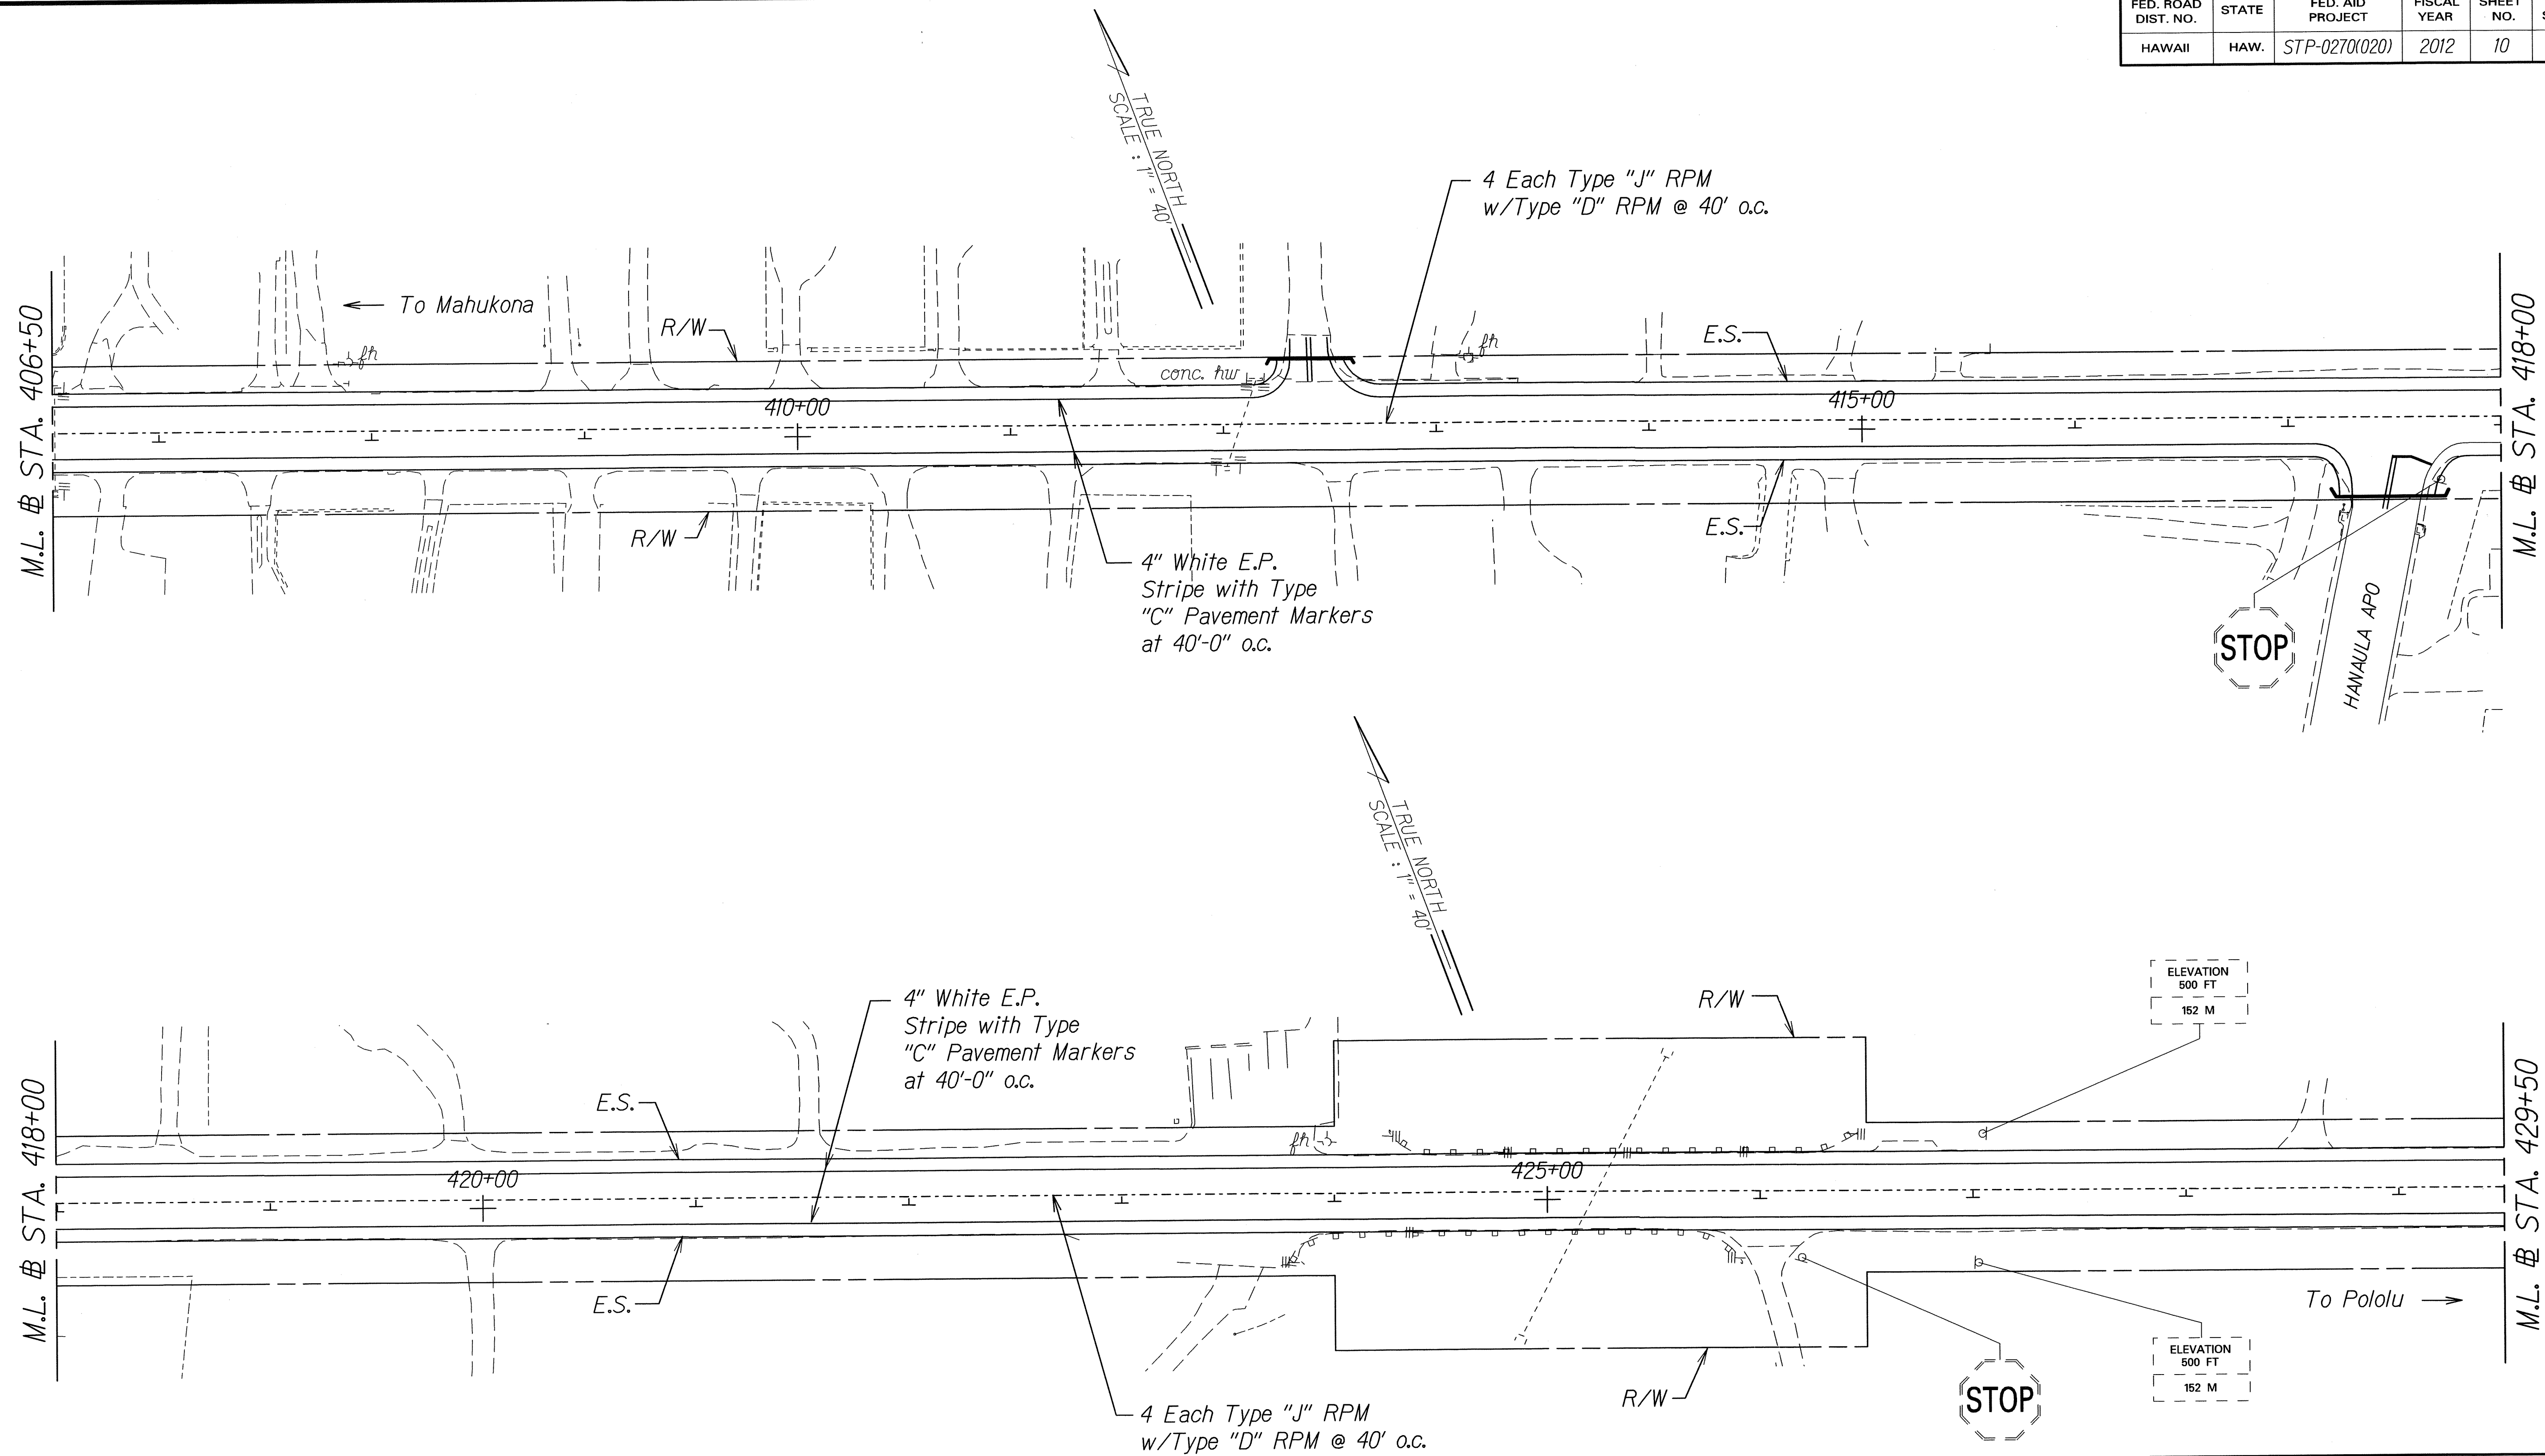

Notes:

1. All existing signs (dashed) with post are to remain.
2. All existing signs in conflict with construction signs are to be covered.
3. This work shall be considered incidental to various contract items.

ORIGINAL PLAN	SURVEY PLOTTED BY	DATE
NOTE BOOK	DRAWN BY	
DESIGNED BY	DESIGNED BY	
QUANTITIES BY	QUANTITIES BY	
CHECKED BY	CHECKED BY	

STATE OF HAWAII
DEPARTMENT OF TRANSPORTATION
HIGHWAYS DIVISION

ROADWAY PLANS

AKONI PULE HIGHWAY

Pavement Preventive Maintenance


Hawi Town to Kapaau Town

Federal Aid Project No. STP-0270(020)

Scale: 1"=40' Date: February, 2012

SHEET No. 4 OF 6 SHEETS

FED. ROAD DIST. NO.	STATE	FED. AID PROJECT	FISCAL YEAR	SHEET NO.	TOTAL SHEETS
HAWAII	HAW.	STP-0270(020)	2012	11	15

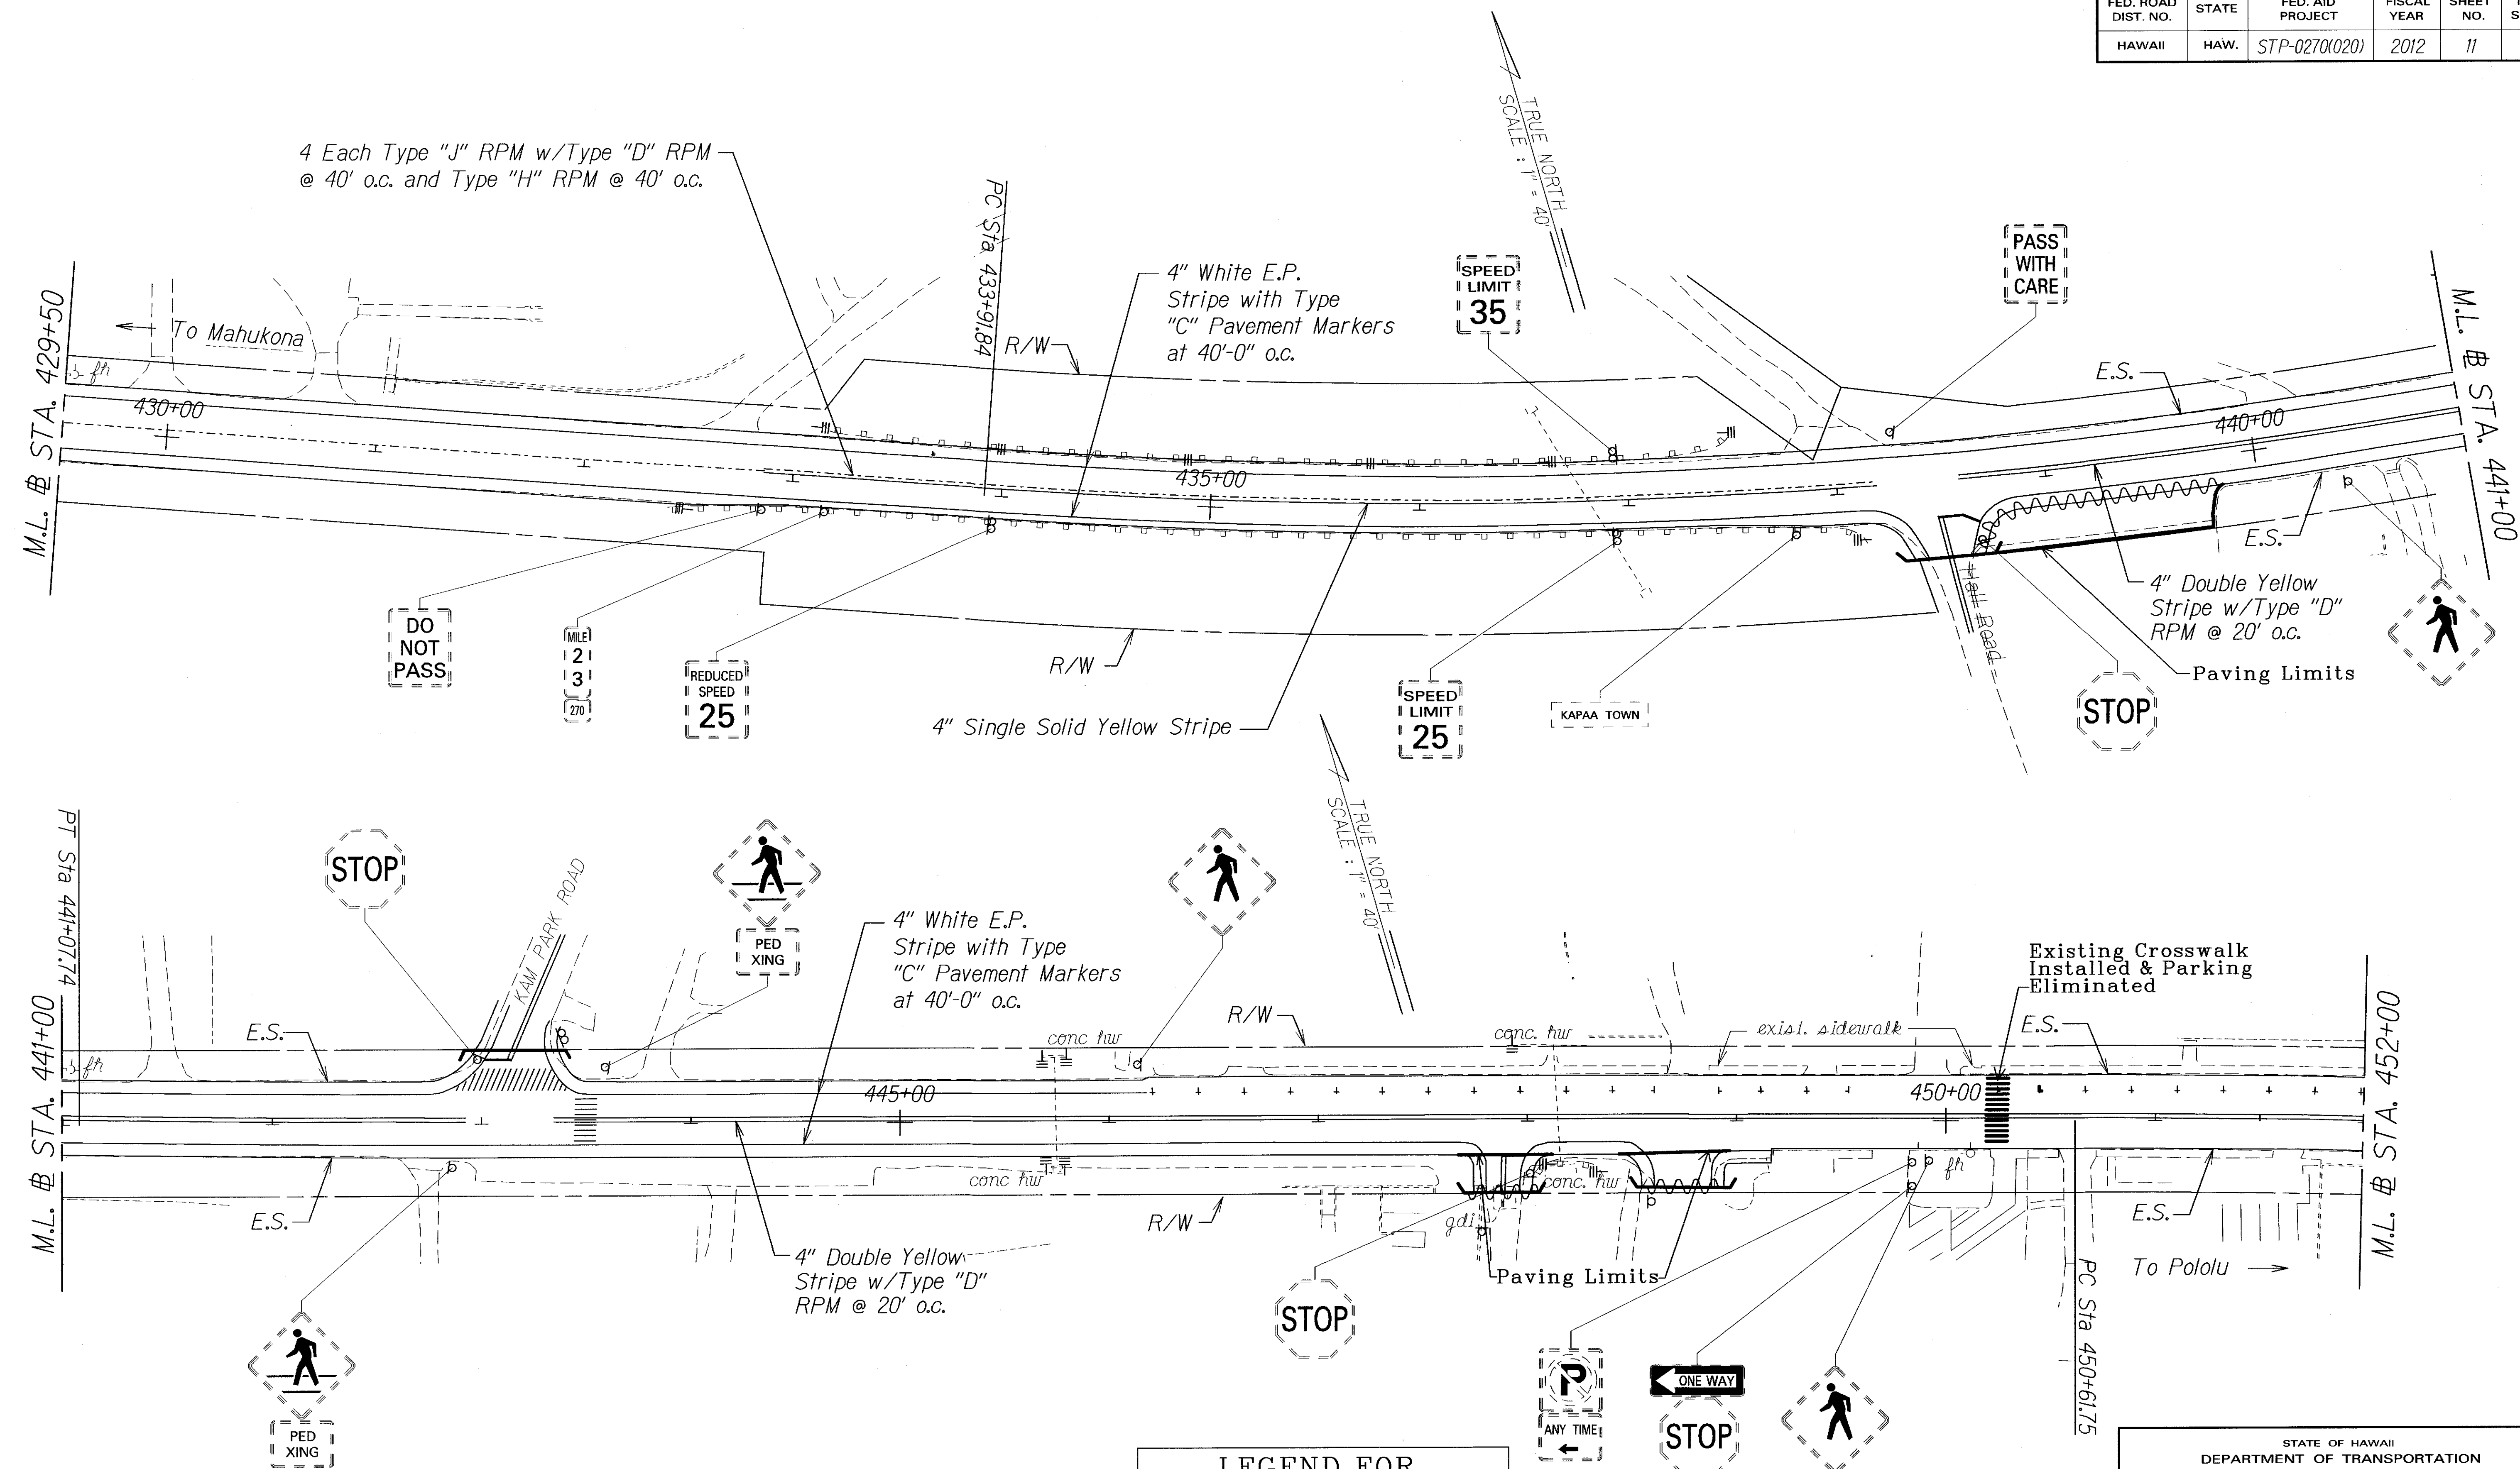

LEGEND FOR AS-BUILT POSTINGS	
	Squiggly line for as-built deletion
	Double line for as-built deletion
Roadway	Text for as-built posting

- Notes:
1. All existing signs (dashed) with post are to remain.
 2. All existing signs in conflict with construction signs are to be covered.
 3. This work shall be considered incidental to various contract items.

STATE OF HAWAII
DEPARTMENT OF TRANSPORTATION
HIGHWAYS DIVISION

ROADWAY PLANS

AKONI PULE HIGHWAY

Pavement Preventive Maintenance

Hawi Town to Kapaau Town


Federal Aid Project No. STP-0270(020)

Scale: 1"=40' Date: February, 2012

SHEET No. 5 OF 6 SHEETS

"AS-BUILT"

FED. ROAD DIST. NO.	STATE	FED. AID PROJECT	FISCAL YEAR	SHEET NO.	TOTAL SHEETS
HAWAII	HAW.	STP-0270(020)	2012	12	15

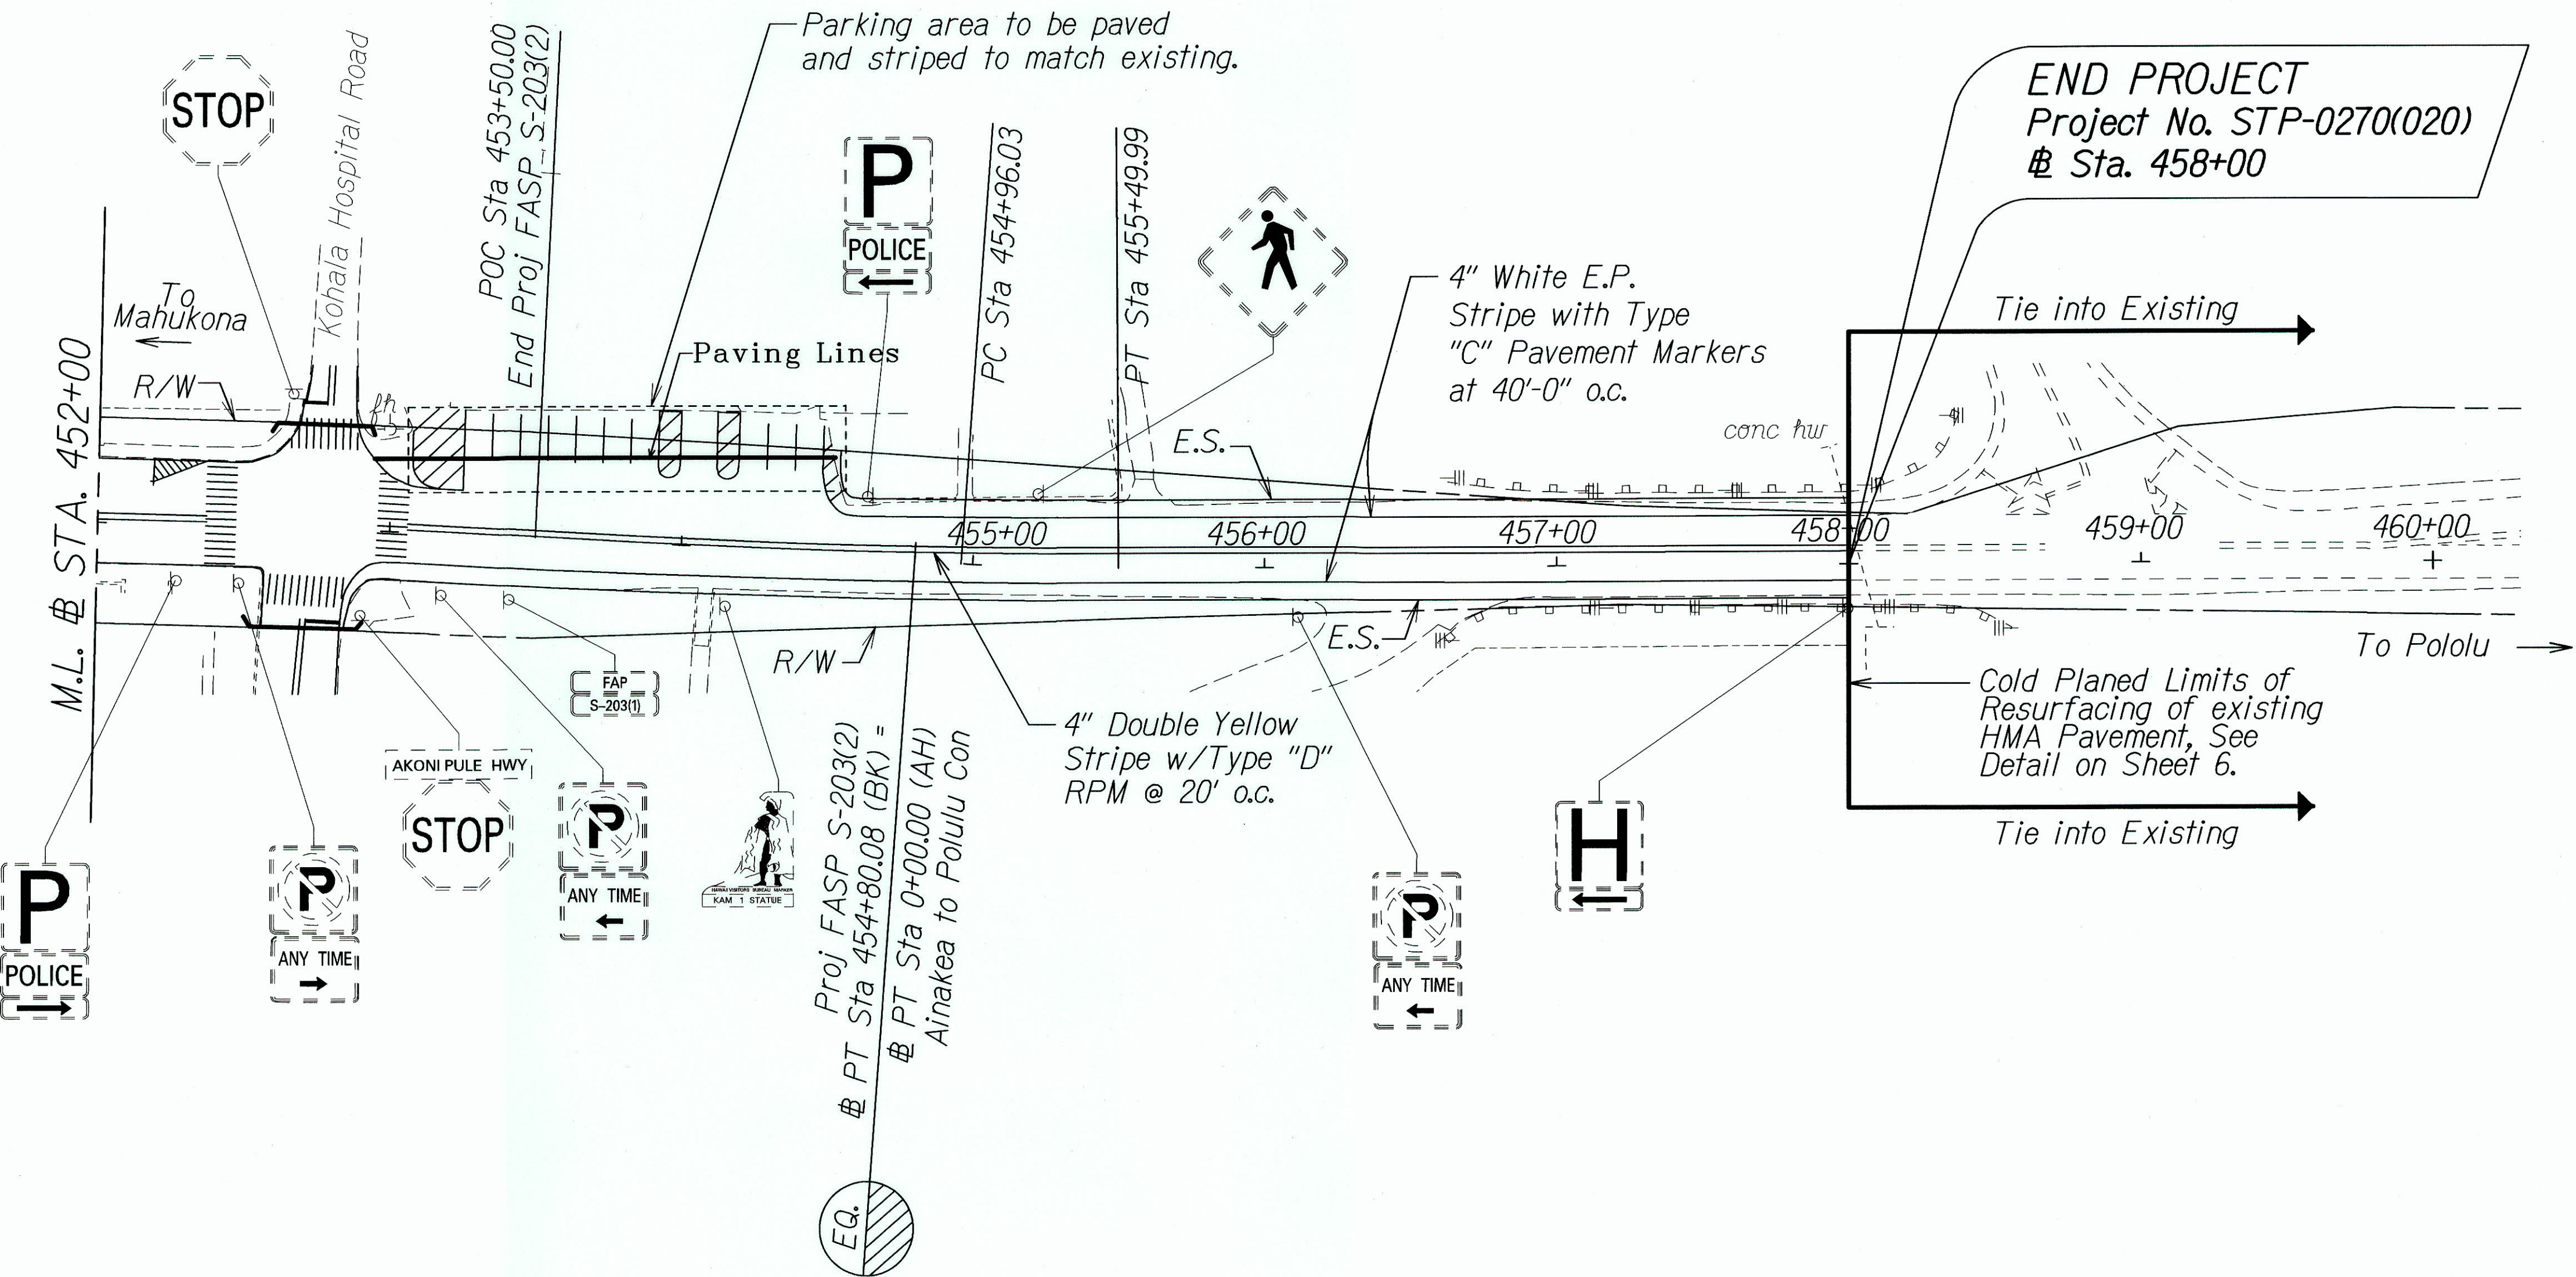

TRUE NORTH
SCALE: 1" = 40'

Notes:

1. All existing signs (dashed) with post are to remain.
2. All existing signs in conflict with construction signs are to be covered.
3. This work shall be considered incidental to various contract items.

LEGEND FOR AS-BUILT POSTINGS	
	Squiggly line for as-built deletion
	Double line for as-built deletion
Roadway	Text for as-built posting

STATE OF HAWAII
DEPARTMENT OF TRANSPORTATION
HIGHWAYS DIVISION

ROADWAY PLANS

AKONI PULE HIGHWAY

Pavement Preventive Maintenance

Hawi Town to Kapaau Town

Federal Aid Project No. STP-0270(020)

Scale: 1"=40' Date: February, 2012

SHEET No. 6 OF 6 SHEETS

"AS-BUILT"

12

ORIGINAL PLAN	SURVEY PLOTTED BY	DATE
NOTE BOOK	DRAWN BY	
DESIGNED BY	TRACED BY	
CHECKED BY	DESIGNED BY	
	CHECKED BY	