

INDEX TO DRAWINGS	
SHEET NO.	DESCRIPTION
1	TITLE SHEET
2	STANDARD PLANS SUMMARY
3	GENERAL NOTES AND LEGEND
4-5	WATER POLLUTION AND EROSION CONTROL NOTES
6	TYPICAL SECTION AND DETAILS
7-12	ROADWAY PLANS
13	PAVEMENT MARKING LEGEND AND NOTES
14	PAVEMENT MARKING SCHEDULE
15	LOW SPEED UNDIVIDED HIGHWAY WORK ZONE SIGNING PLAN, NOTES AND DETAILS

STATE OF HAWAII

DEPARTMENT OF TRANSPORTATION

HIGHWAYS DIVISION

HONOLULU, HAWAII

"AS-BUILT"

PLANS FOR

AKONI PULE HIGHWAY

PAVEMENT PREVENTIVE MAINTENANCE


HAWI TOWN TO KAPAAU TOWN

FEDERAL AID PROJECT NO. STP-0270(020)

DISTRICT OF NORTH KOHALA

ISLAND OF HAWAII

PROJECT LOCATION

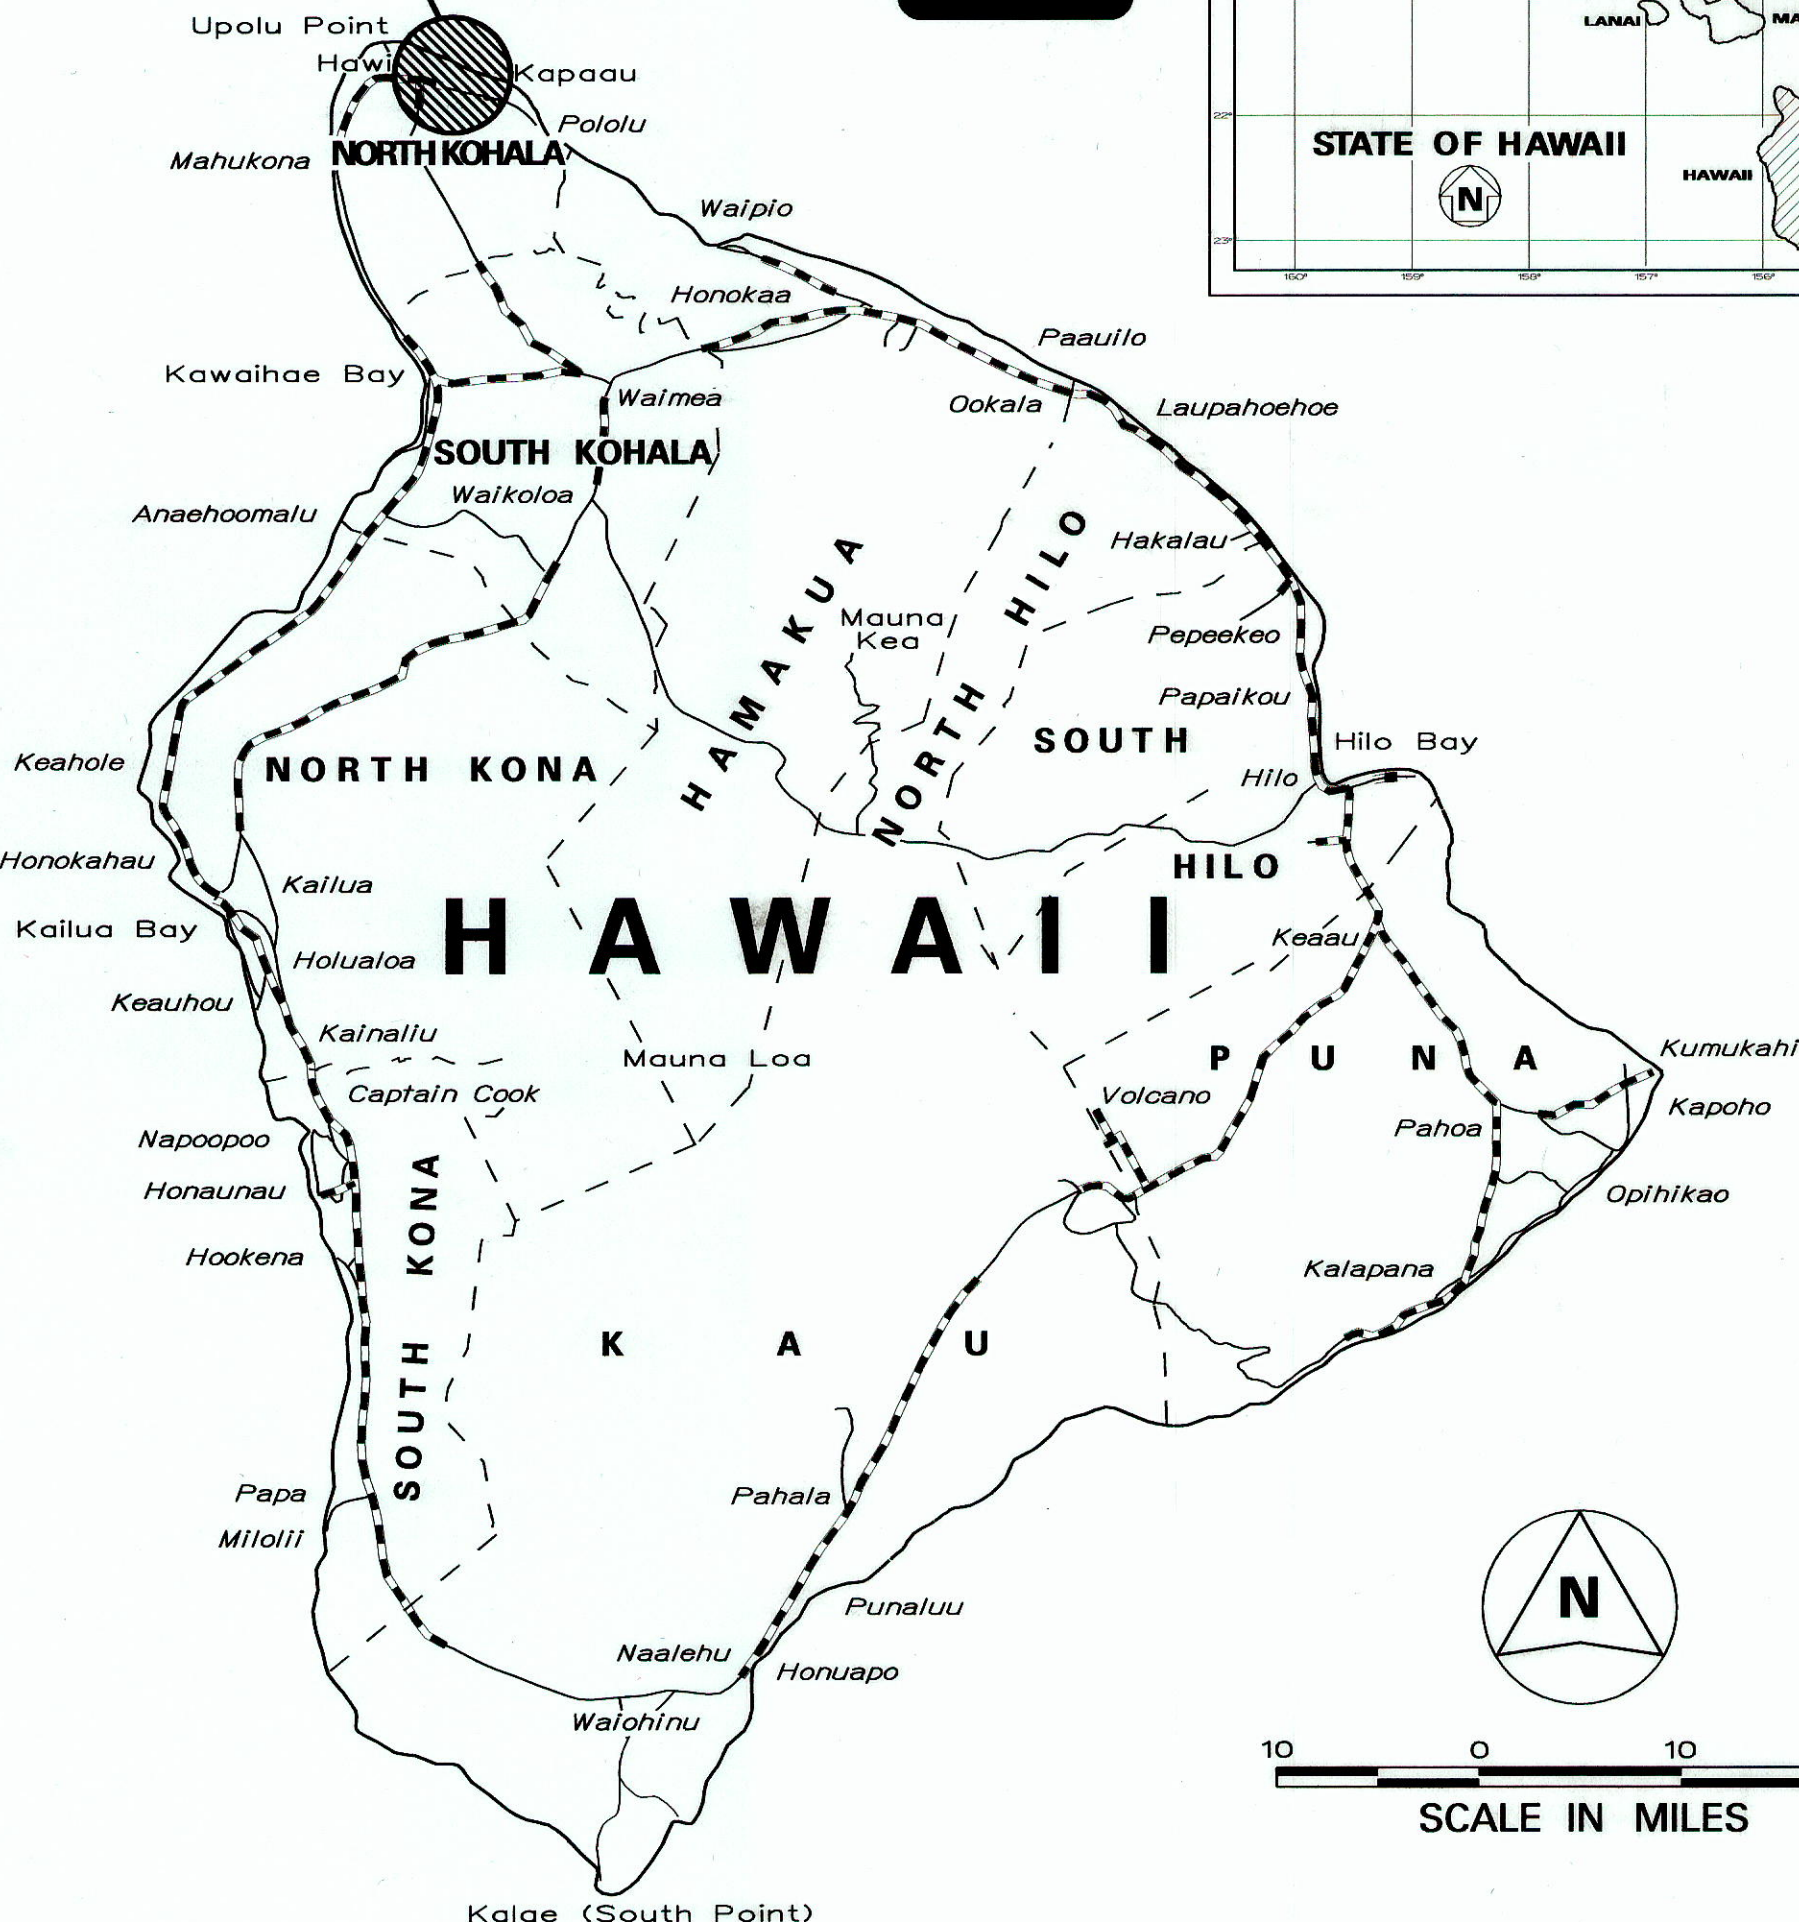

FEDERAL AID PROJECTS PREVIOUSLY CONSTRUCTED OR UNDER CONSTRUCTION

MILE POST 21.22 TO MILE POST 23.47

DESIGN DESIGNATION

ADT (2012)	7,200
ADT (2022)	8,700
DHV	780
D	60/40
T	4.0 %
V	40 M.P.H.

HAWAII DISTRICT

DESIGNED BY

HWY-HE



MANAGED BY

933-8866

MARCH, 2012

DATE

PHONE

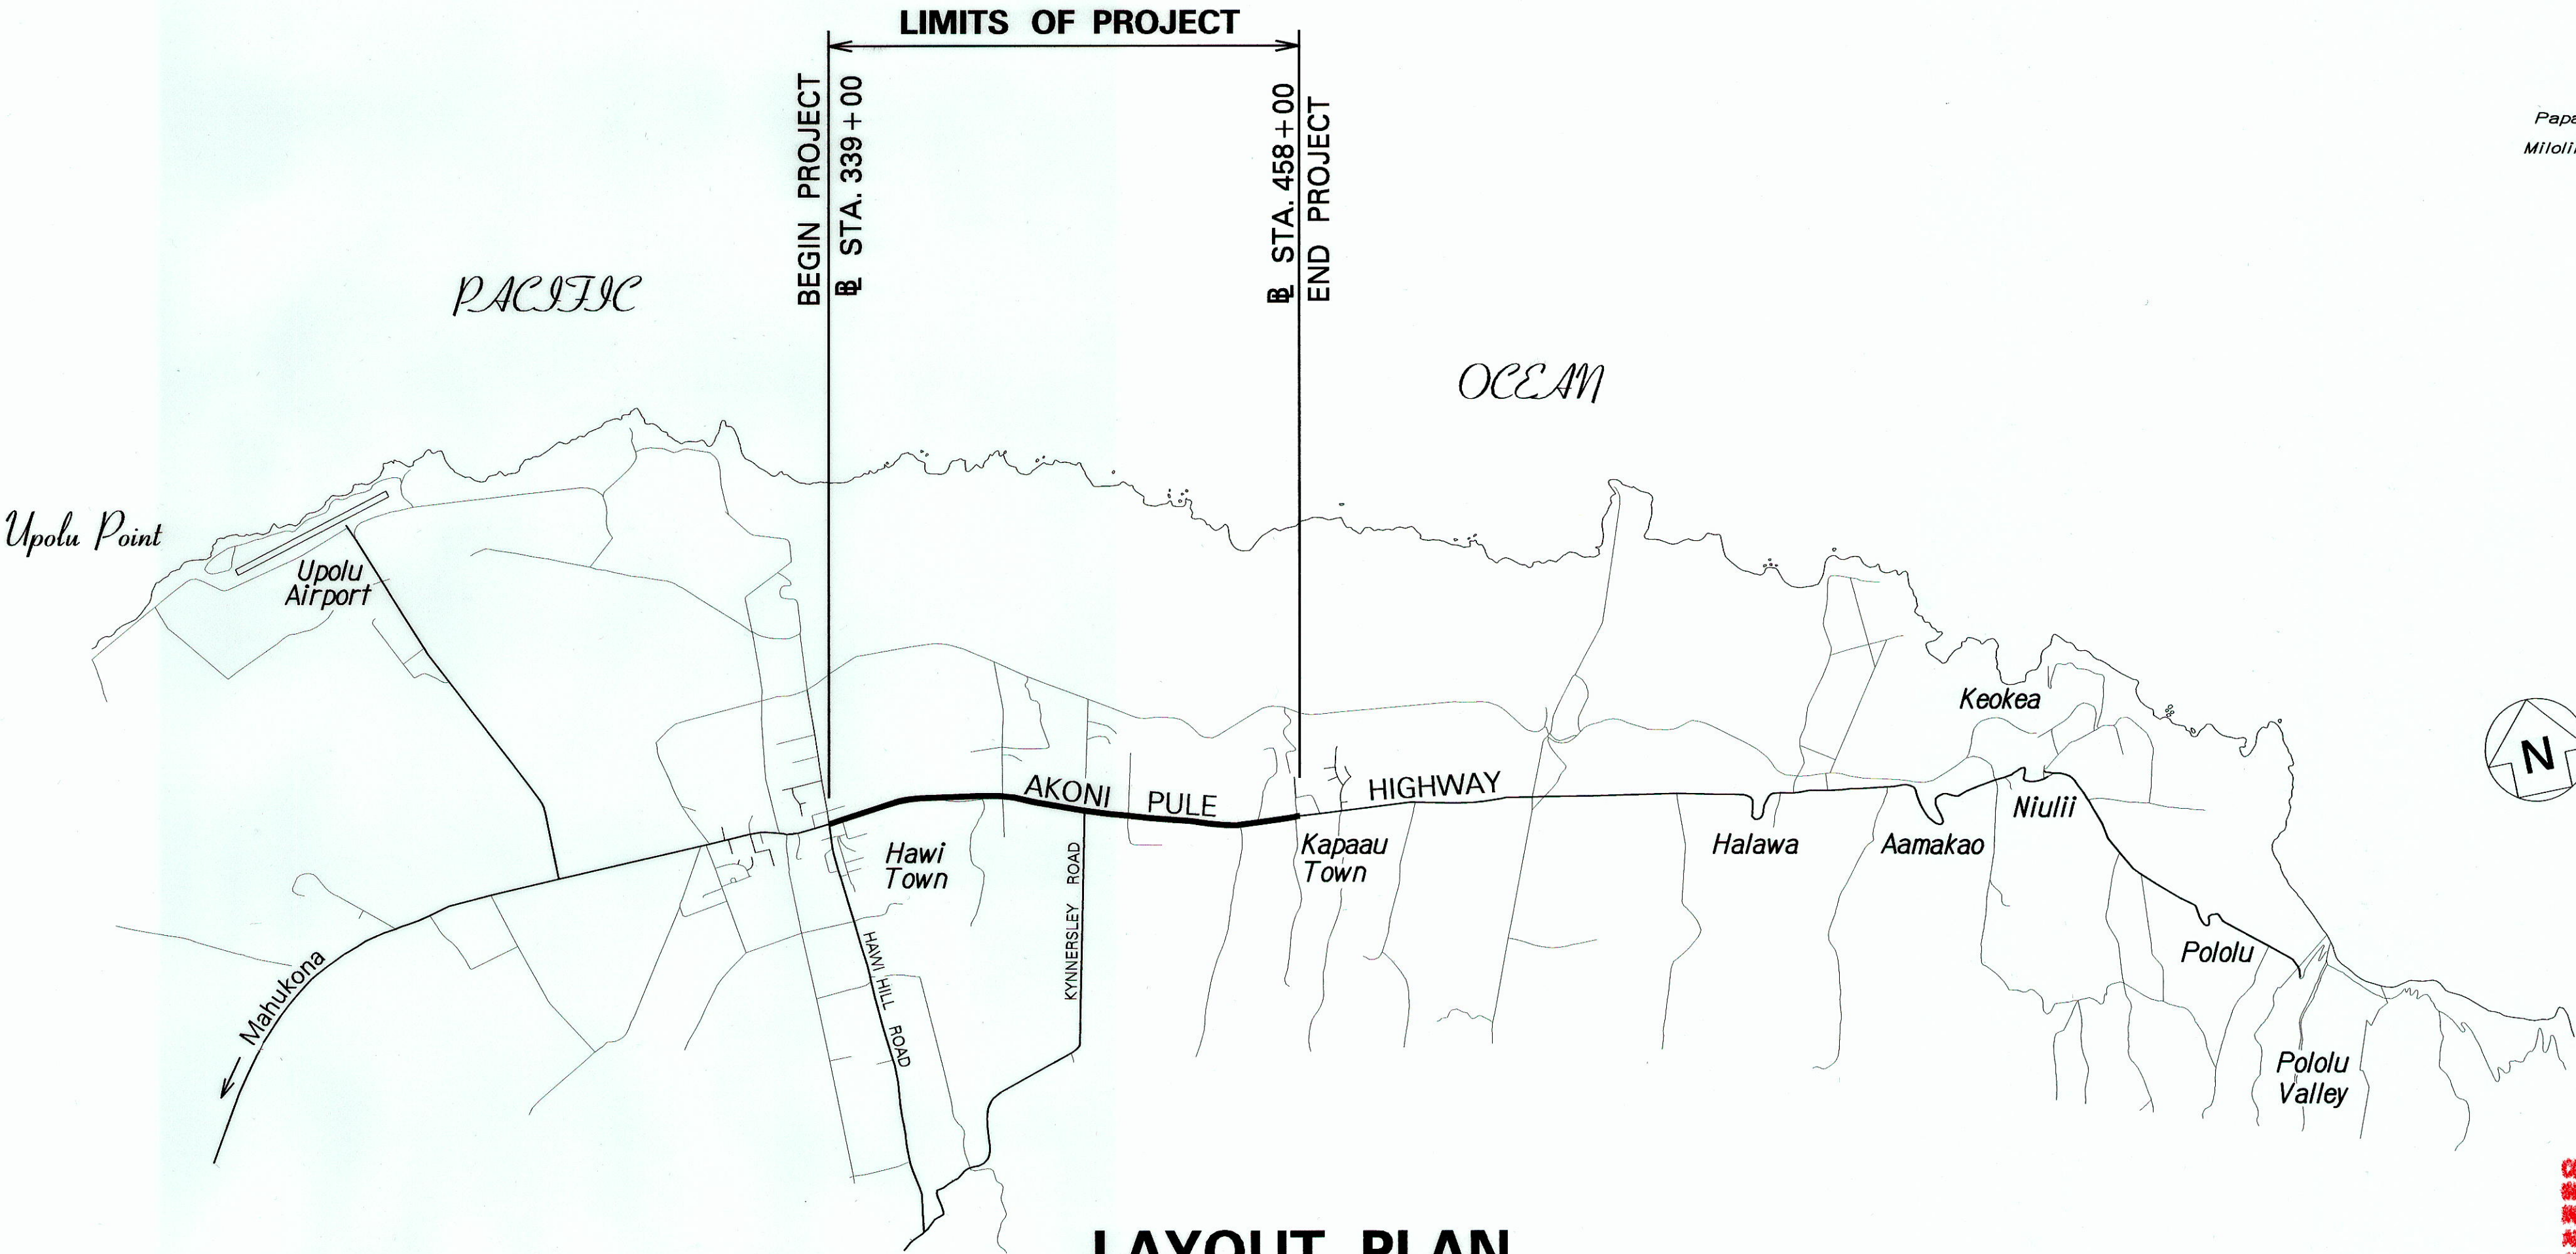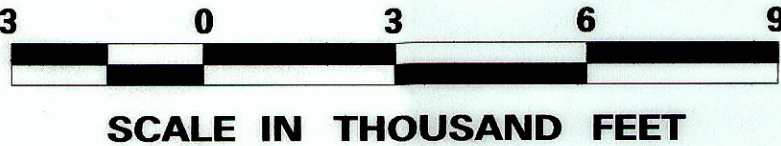

LAYOUT PLAN

LENGTH OF PROJECT.....2.25 MILES

CHANGES MADE DURING CONSTRUCTION HAVE BEEN INCORPORATED ON THESE PLANS EXCEPT CHANGES IN THE ORIGINAL THEORETICAL QUANTITIES. FOR ACTUAL QUANTITIES, REFER TO PROJECT LEDGER AND/OR COMPUTATION BOOK.

12/18/13

DATE

DEPARTMENT OF TRANSPORTATION

STATE OF HAWAII

APPROVED:

3/29/12

DATE