

INDEX TO DRAWINGS	
SHEET NO.	DESCRIPTION
1	TITLE SHEET
2	GENERAL NOTES
3 - 4	WATER POLLUTION AND EROSION CONTROL NOTES
5 - 12	STRUCTURAL PLANS



STATE OF HAWAII
DEPARTMENT OF TRANSPORTATION

HIGHWAYS DIVISION
HONOLULU, HAWAII
"AS-BUILT"
PLANS FOR
AKONI PULE HIGHWAY

HONOKOA BRIDGE REPAIRS
PROJECT NO. ER-15(1)

DISTRICT OF SOUTH KOHALA
ISLAND OF HAWAII

FED. ROAD DIST. NO.	STATE	PROJ. NO.	FISCAL YEAR	SHEET NO.	TOTAL SHEETS
HAWAII	HAW.	ER-15(1)	2007	1	12

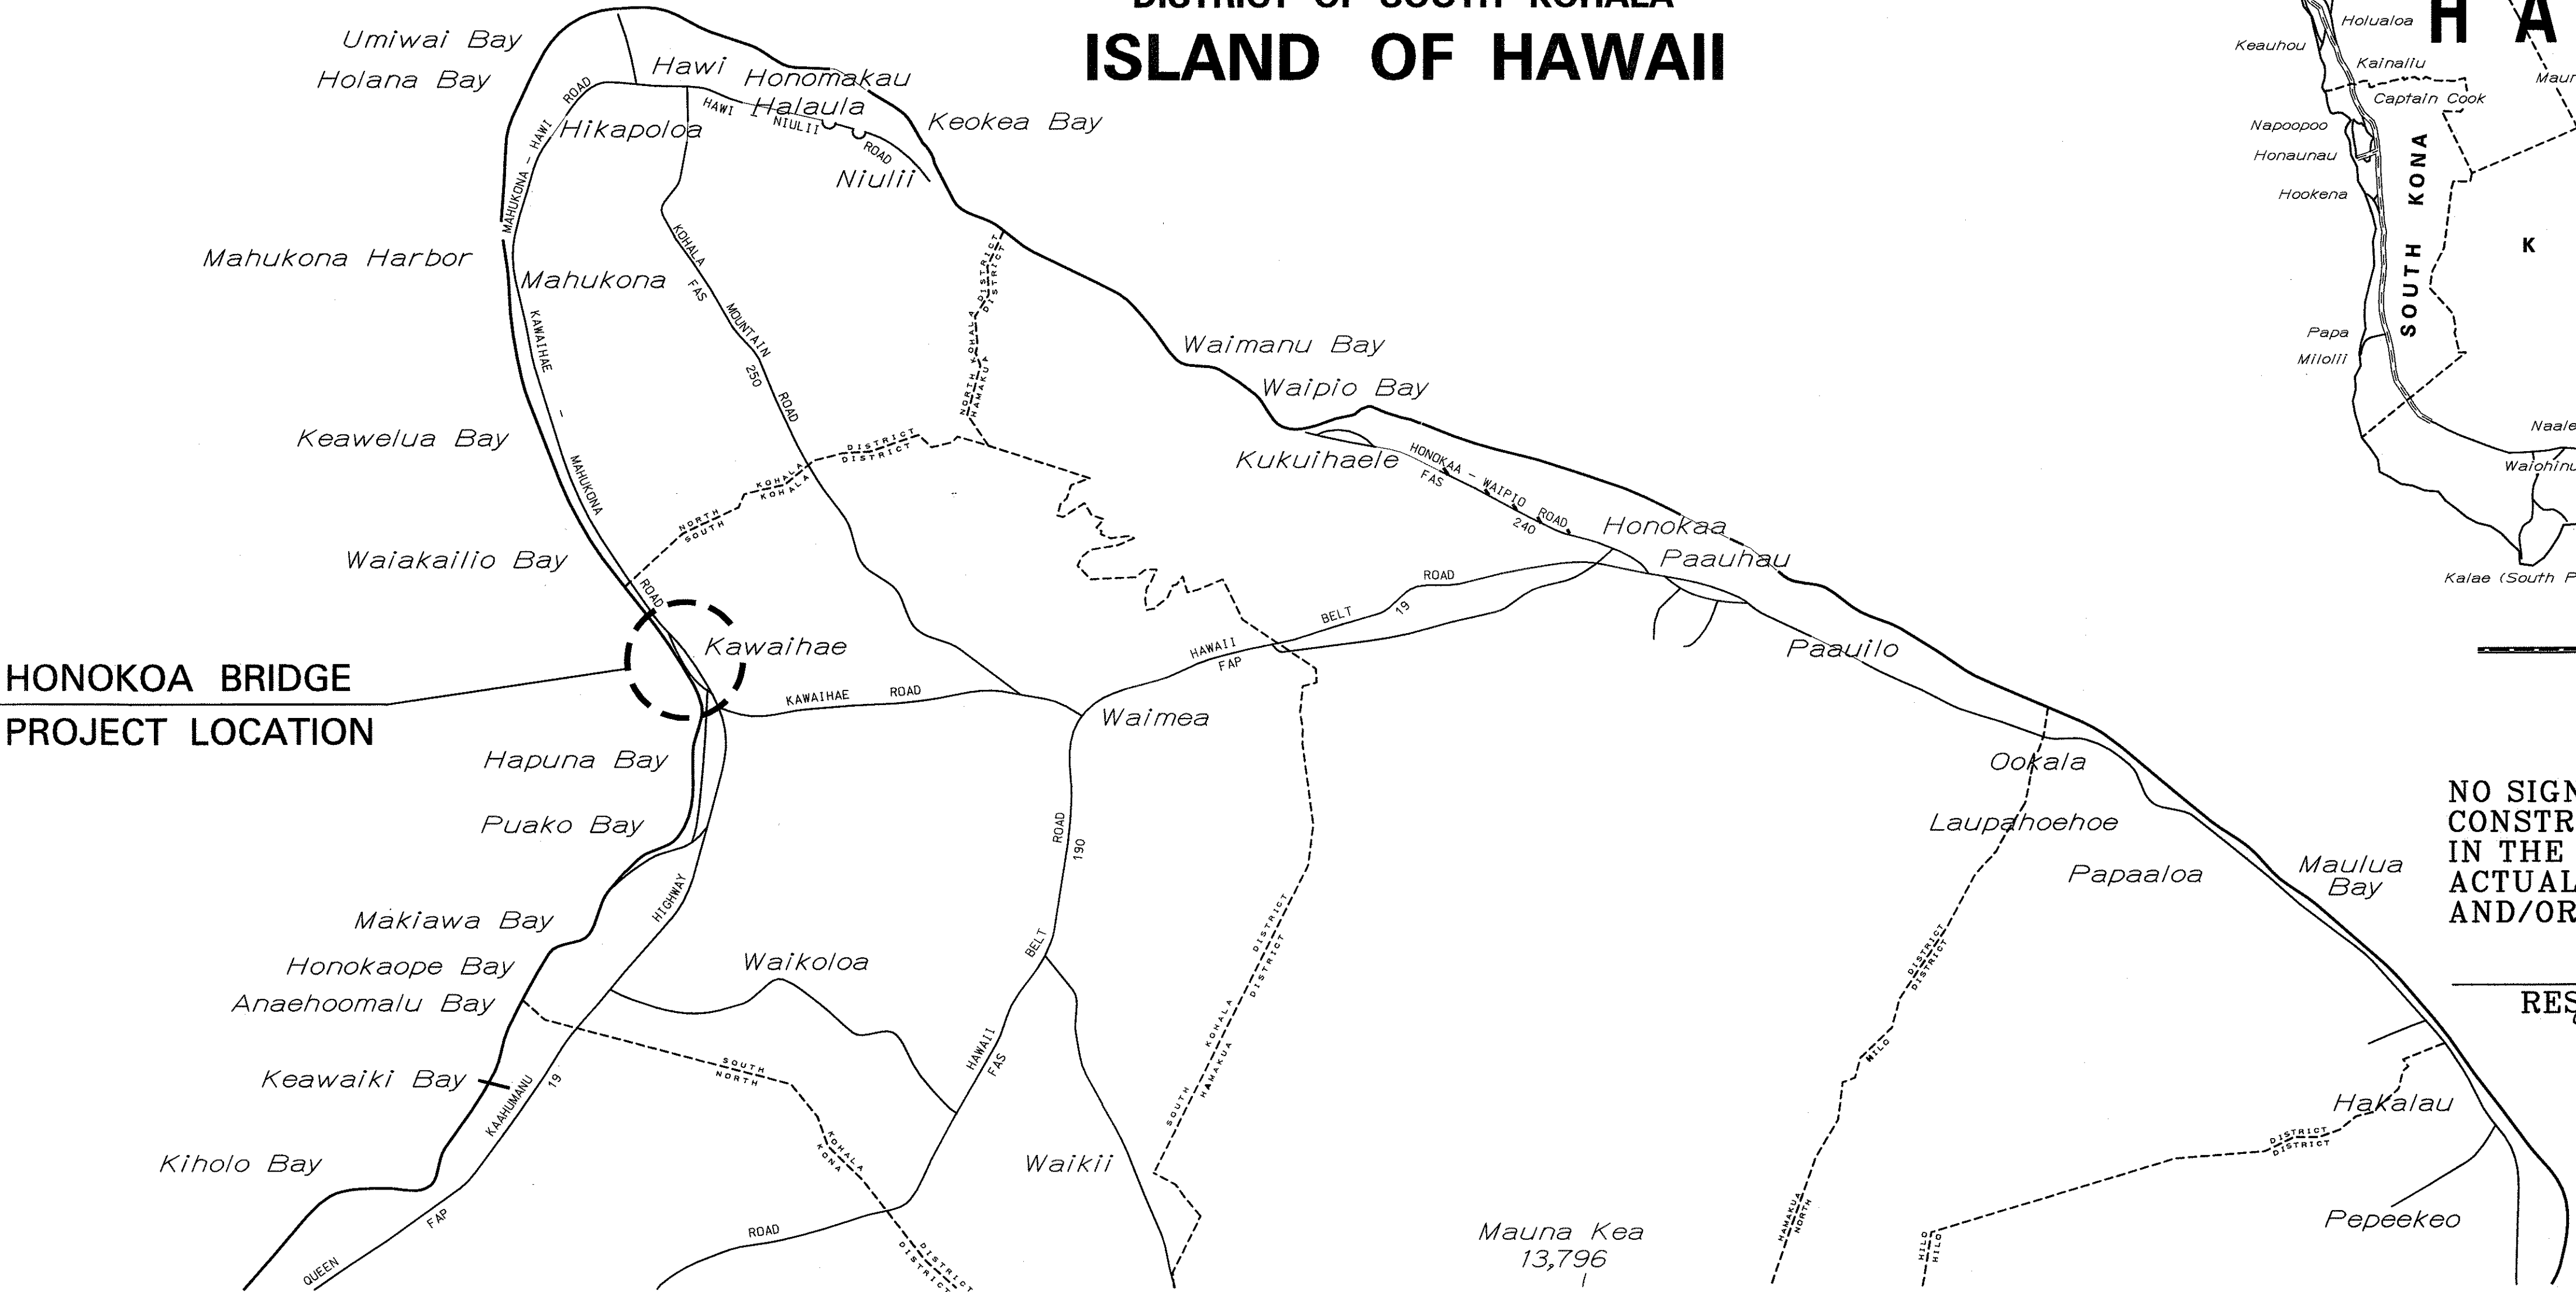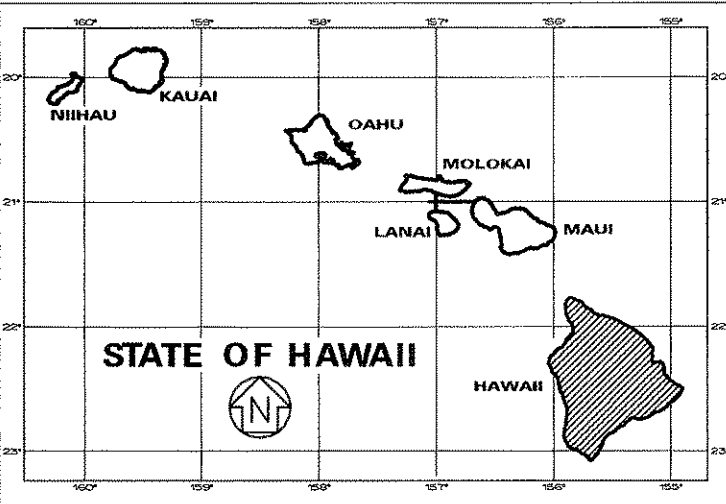

FEDERAL AID INTERSTATE PROJECTS PREVIOUSLY
CONSTRUCTED OR UNDER CONSTRUCTION

MILE POST 2.64

NO SIGNIFICANT CHANGES WERE MADE DURING
CONSTRUCTION ON THESE PLANS EXCEPT CHANGES
IN THE ORIGINAL THEORETICAL QUANTITIES. FOR
ACTUAL QUANTITIES, REFER TO PROJECT LEDGER
AND/OR COMPUTATION BOOK.

RESIDENT ENGINEER 4-9-07
DATE

DEPARTMENT OF TRANSPORTATION STATE OF HAWAII	
APPROVED:	DATE
<u> </u>	<u> </u>
SHEET NO. T1.1 OF 4 SHEETS	

SURVEY PLOTTED BY	DATE
DRAWN BY	
DESIGNED BY	
QUANTITIES BY	
CHECKED BY	

NOV. 2006
DATE

PHONE

P. S. & E. BY

DESIGNED BY

