
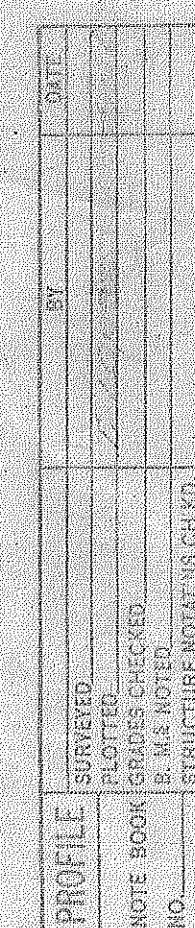




FED. ROAD DIST NO.	STATE	FED. AID PROJ. NO.	FISCAL YEAR	SHEET NO.	TOTAL SHEETS
HAWAII	HAW.	31861	1948	3	22

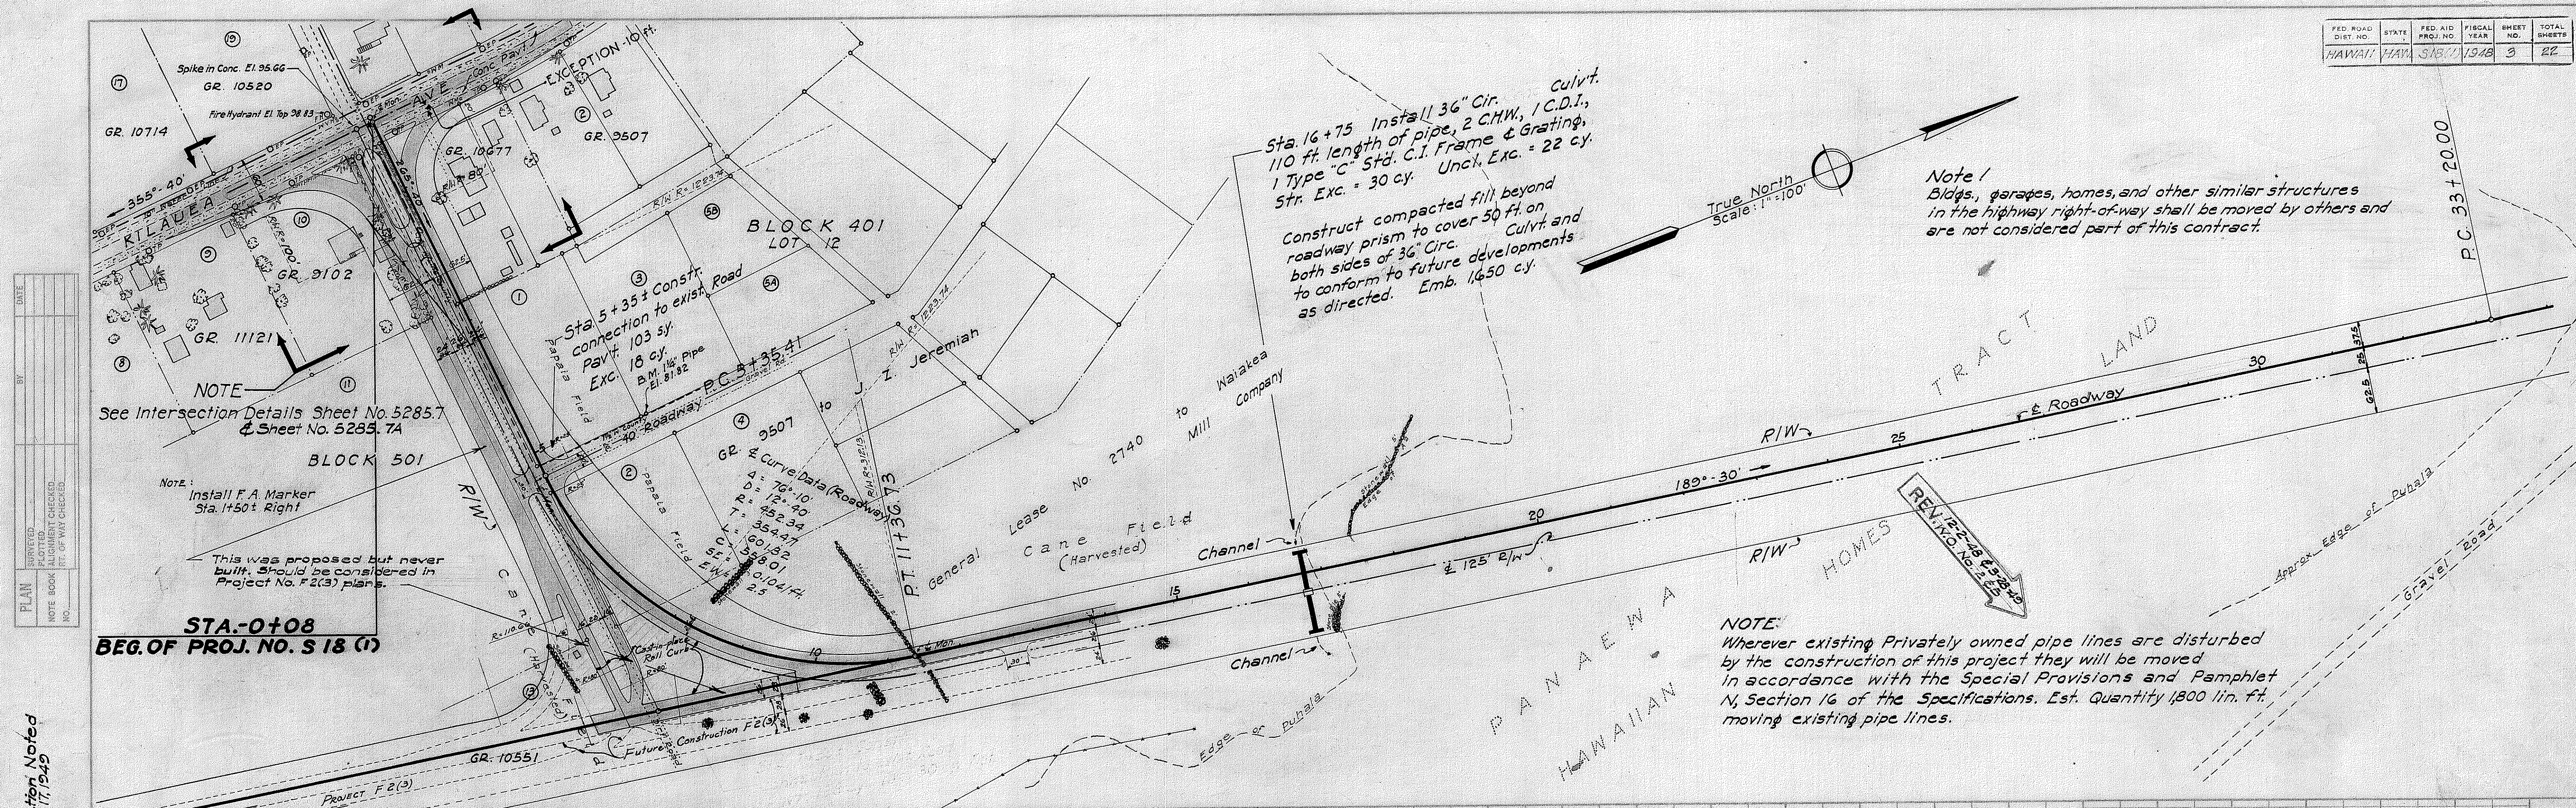


PLAN	DATE
REVISION	
NOTE BOOK ALIGNMENT CHECKED	
NO.	


PROFILE	DATE
REVISION	
NOTE BOOK GRADES CHECKED	
NO.	

Correction Noted
Revised May 17, 1945

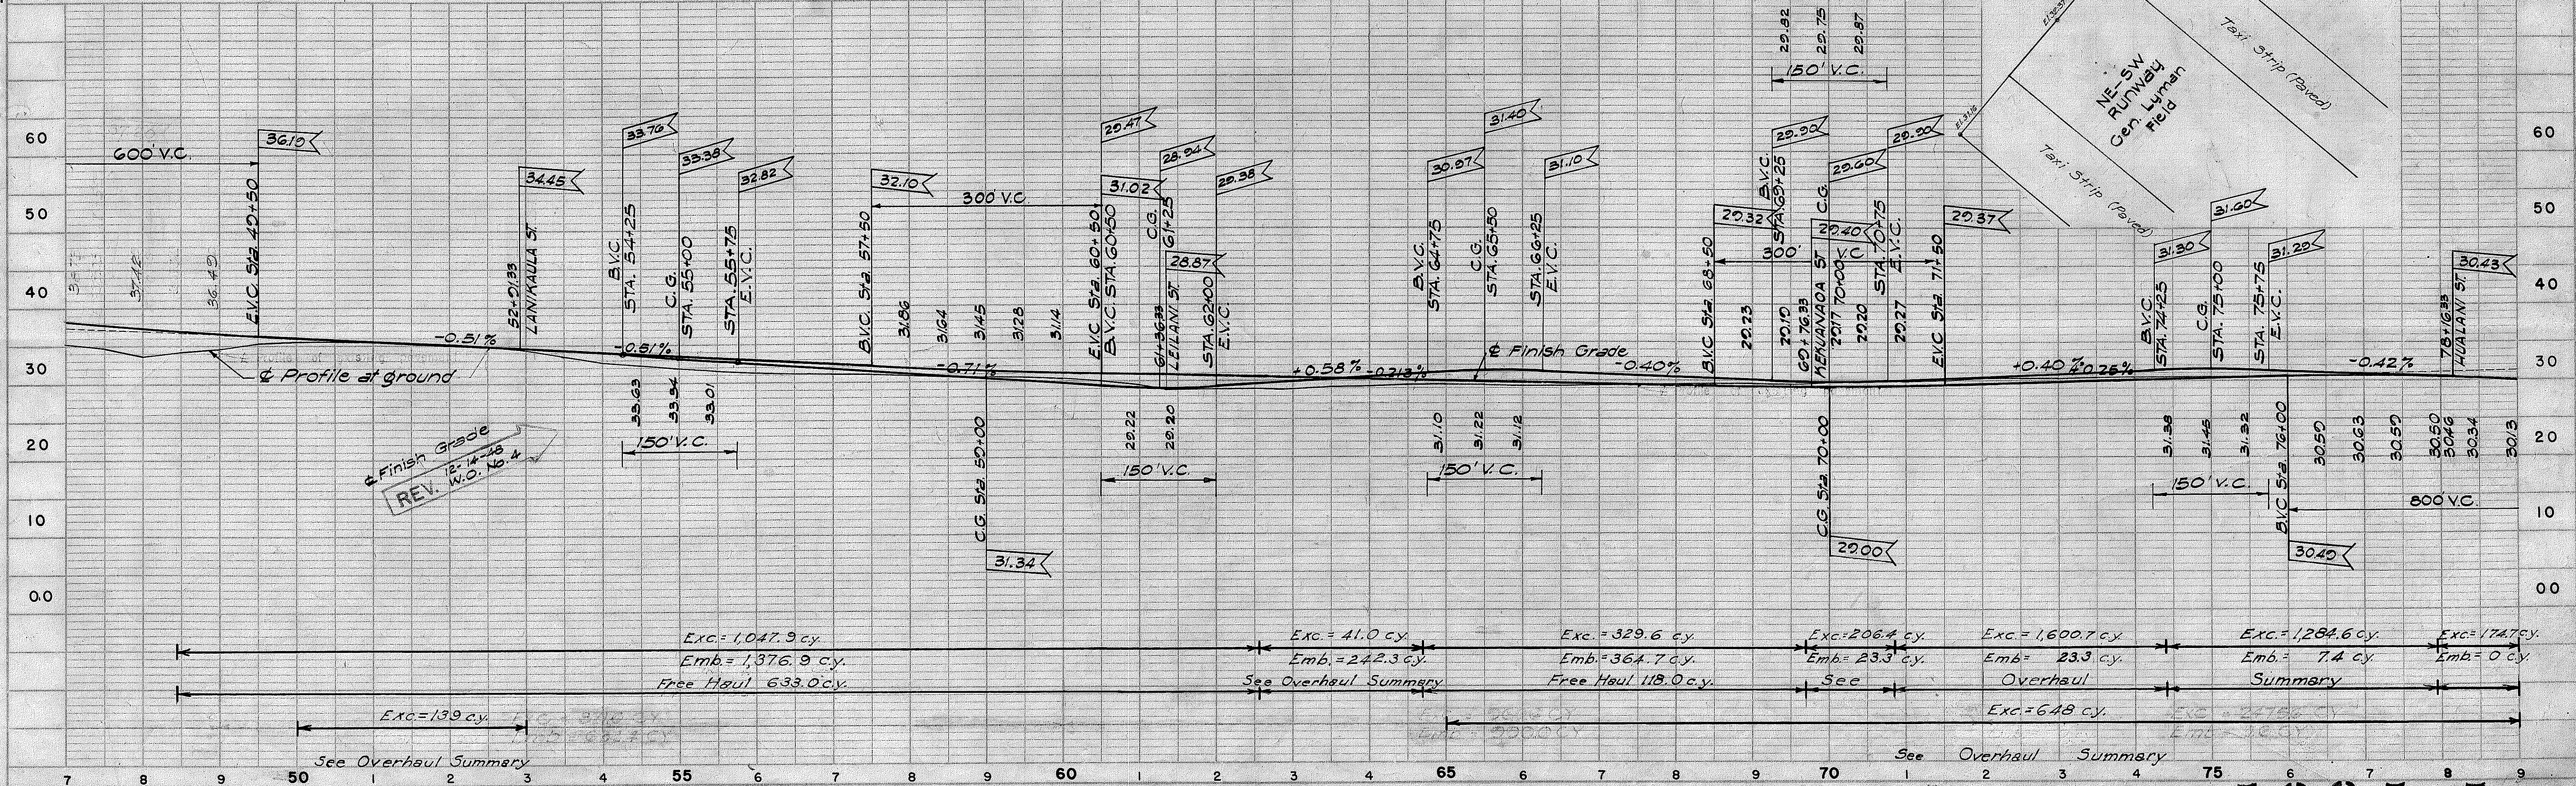
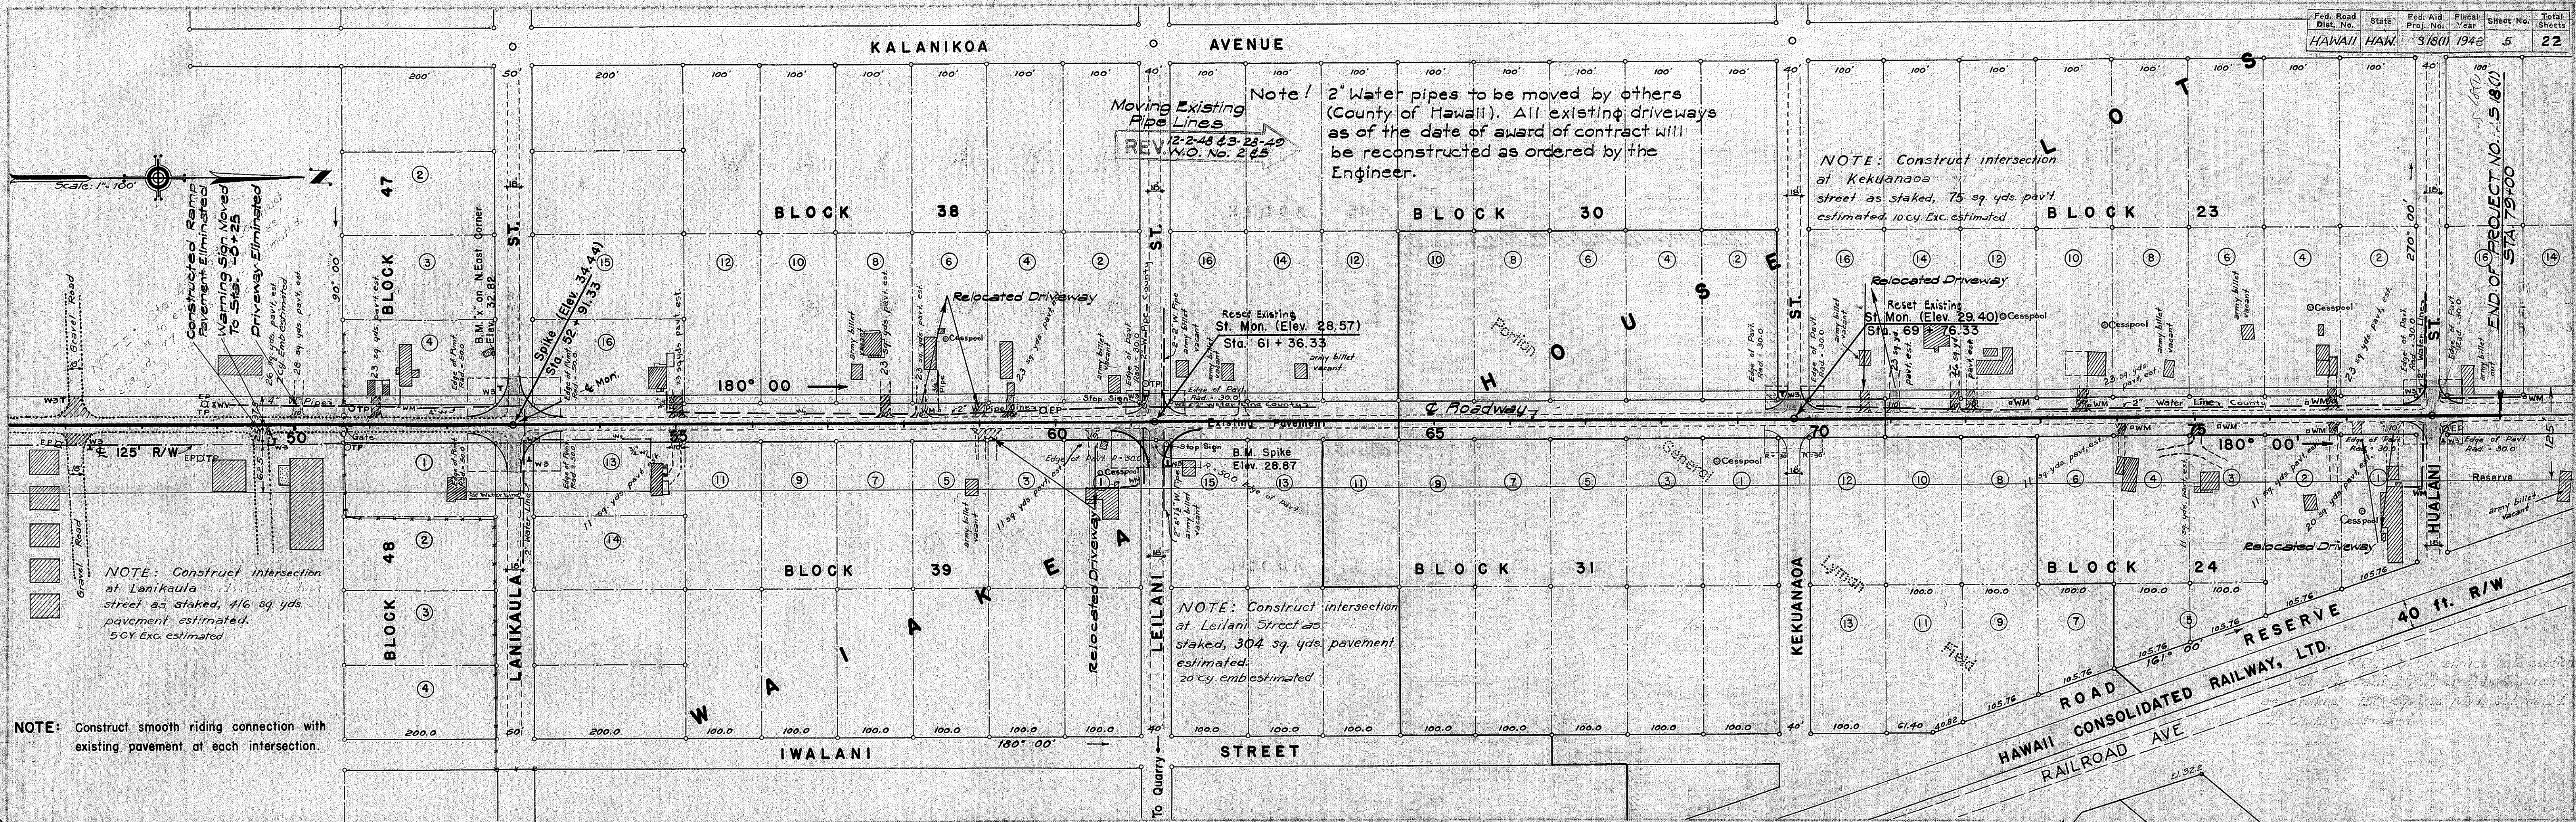


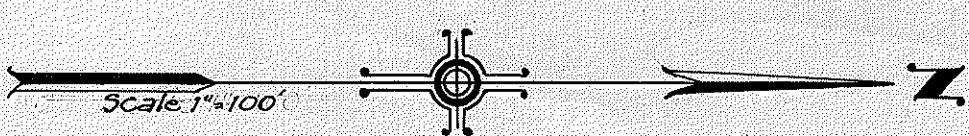

HAWAII CONSOLIDATED RAILWAY, LTD.
Shops & Yards

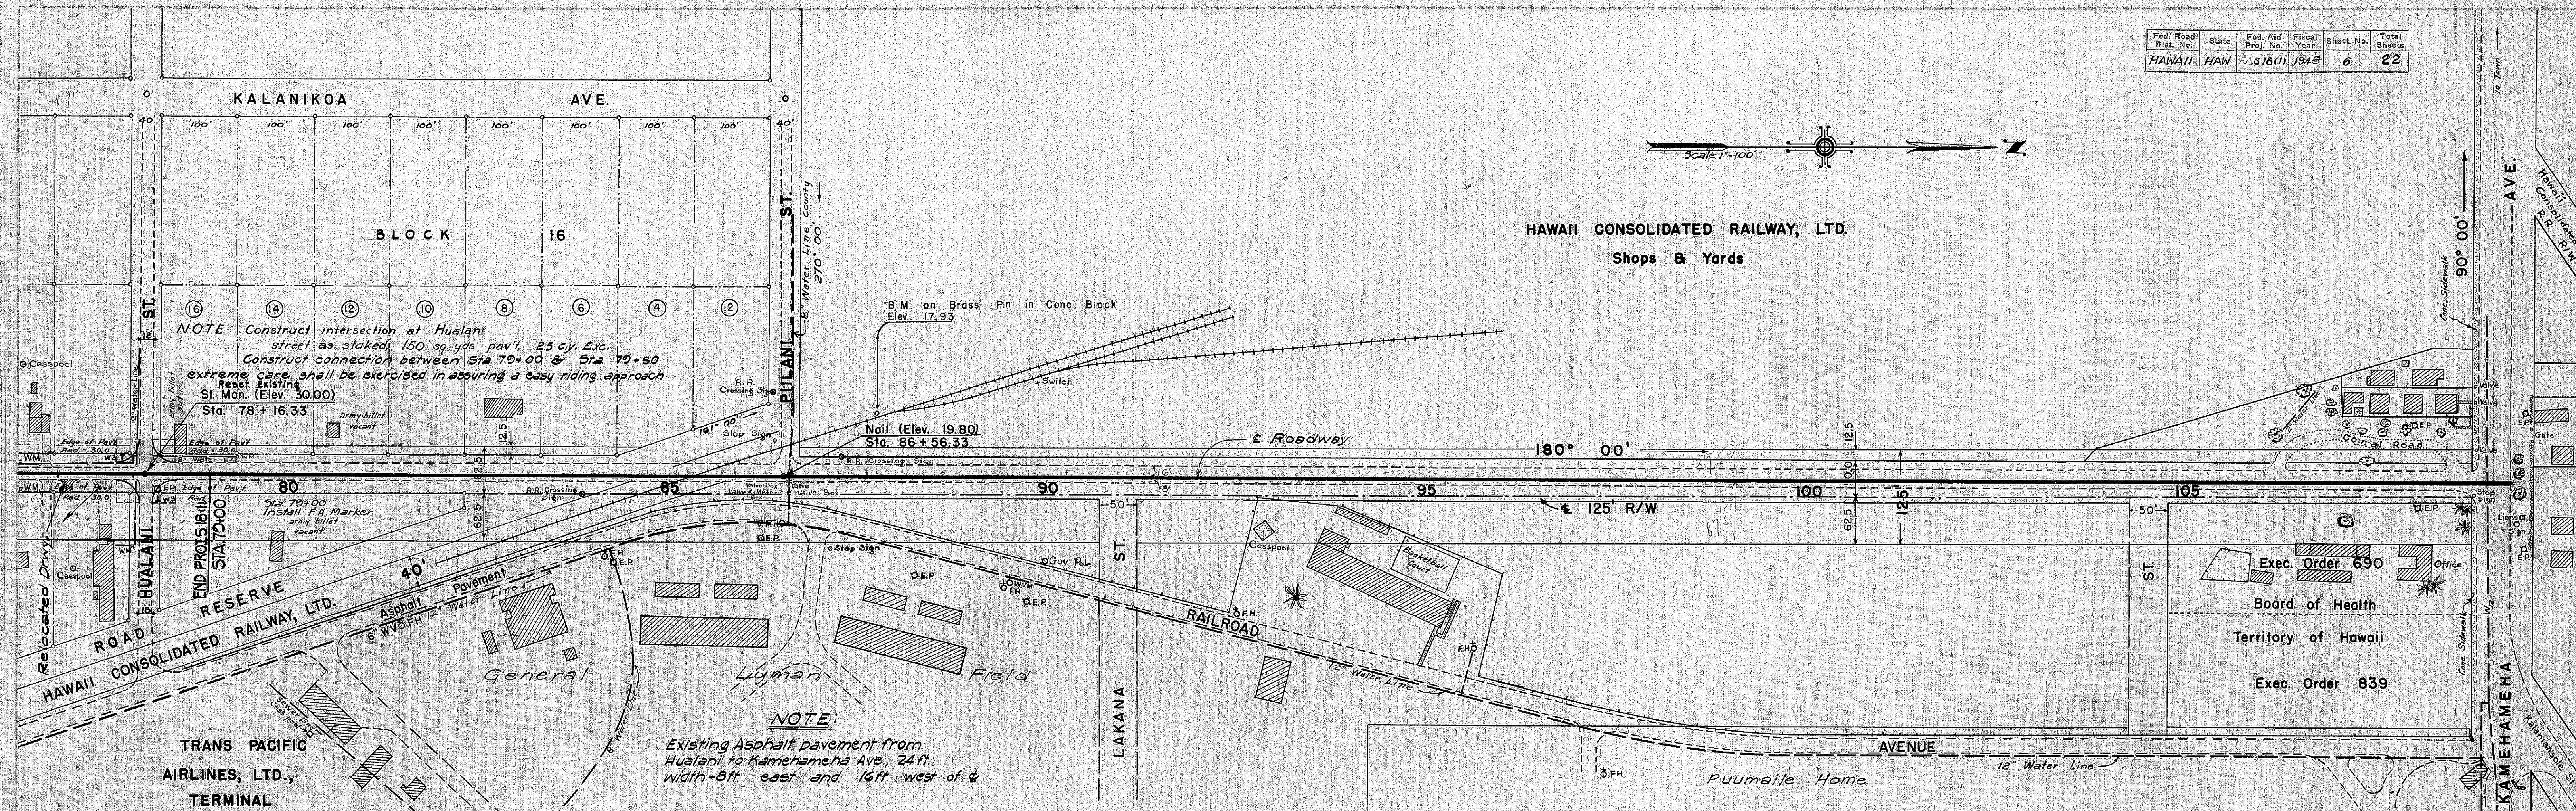

OVERHAUL SUMMARY					
STA.	STA.	OVER DIST.	C.Y.	STA. YD.	M. YD.
1+00	17+00	1,010	1,250	12,625.0	
4+40	17+00	760	734	5,578.4	
6+80	16+50	470	2,000	13,630.0	
17+00	25+00	300	185	555.0	
24+70	41+00	1,200	1,750	21,350.0	
35+00	40+00	60	250	150.0	
35+00	44+00	400	231	924.0	
44+00	51+50	250	139	347.5	
44+00	72+00	2,300	648		282.3
44+00	78+30	2,930	191		106.0
44+00	75+80	2,520	1,250		613.2
47+10	73+00	2,090	1,600		633.3
69+50	70+30	180	180	3,240	
Sub-Total Roadway			11,308	55,483.2	1,634.8
FROM BORROW PIT	4+40	10,780	734		1,498.6
	20+00	9,220	185		323.0
	25+00	8,720	185		305.5
	35+00	1,720	231		337.8
	51+50	8,770	139		230.2
	72+00	10,820	648		1,327.9
Sub-Total Fine Select Material			2,122		4,023.7
GRAND TOTAL				55,483.2	5,658.5

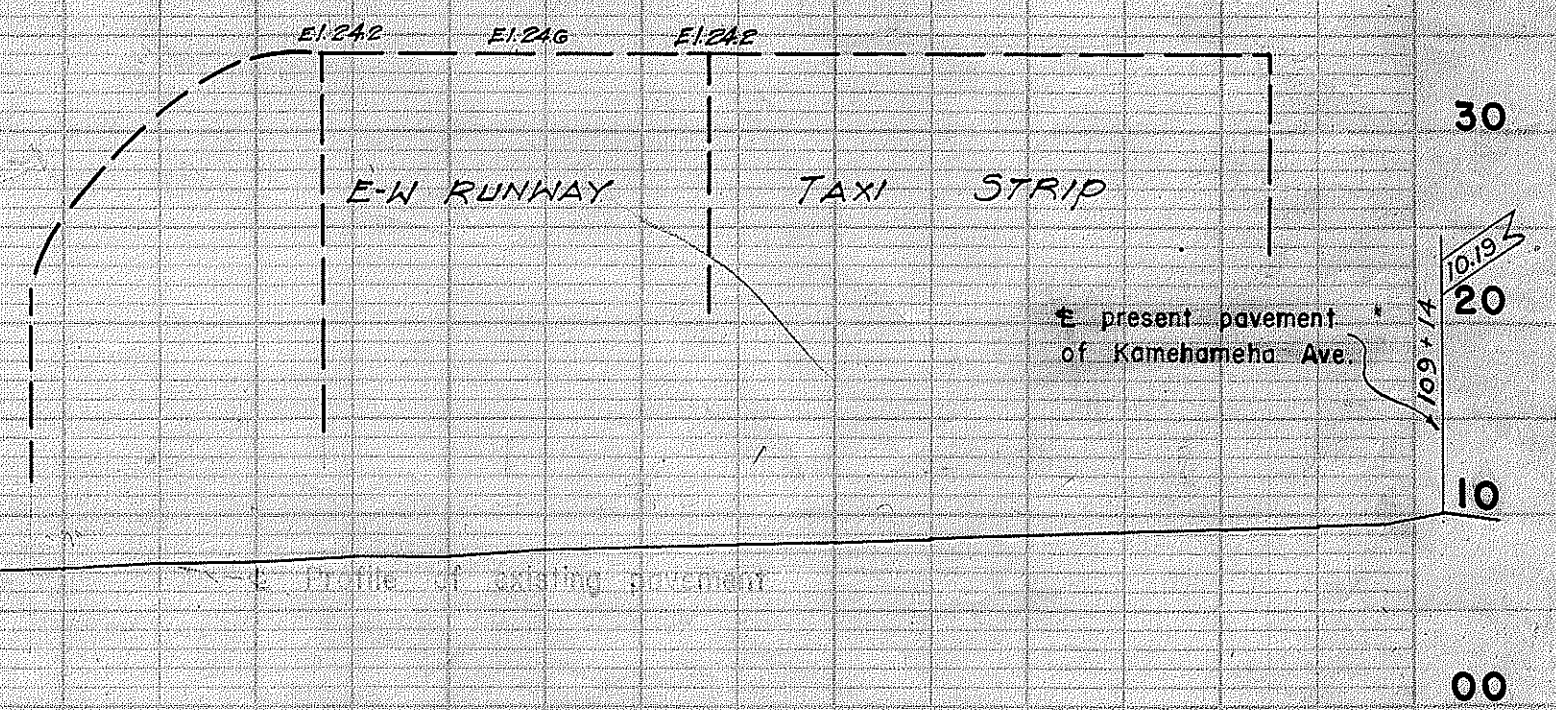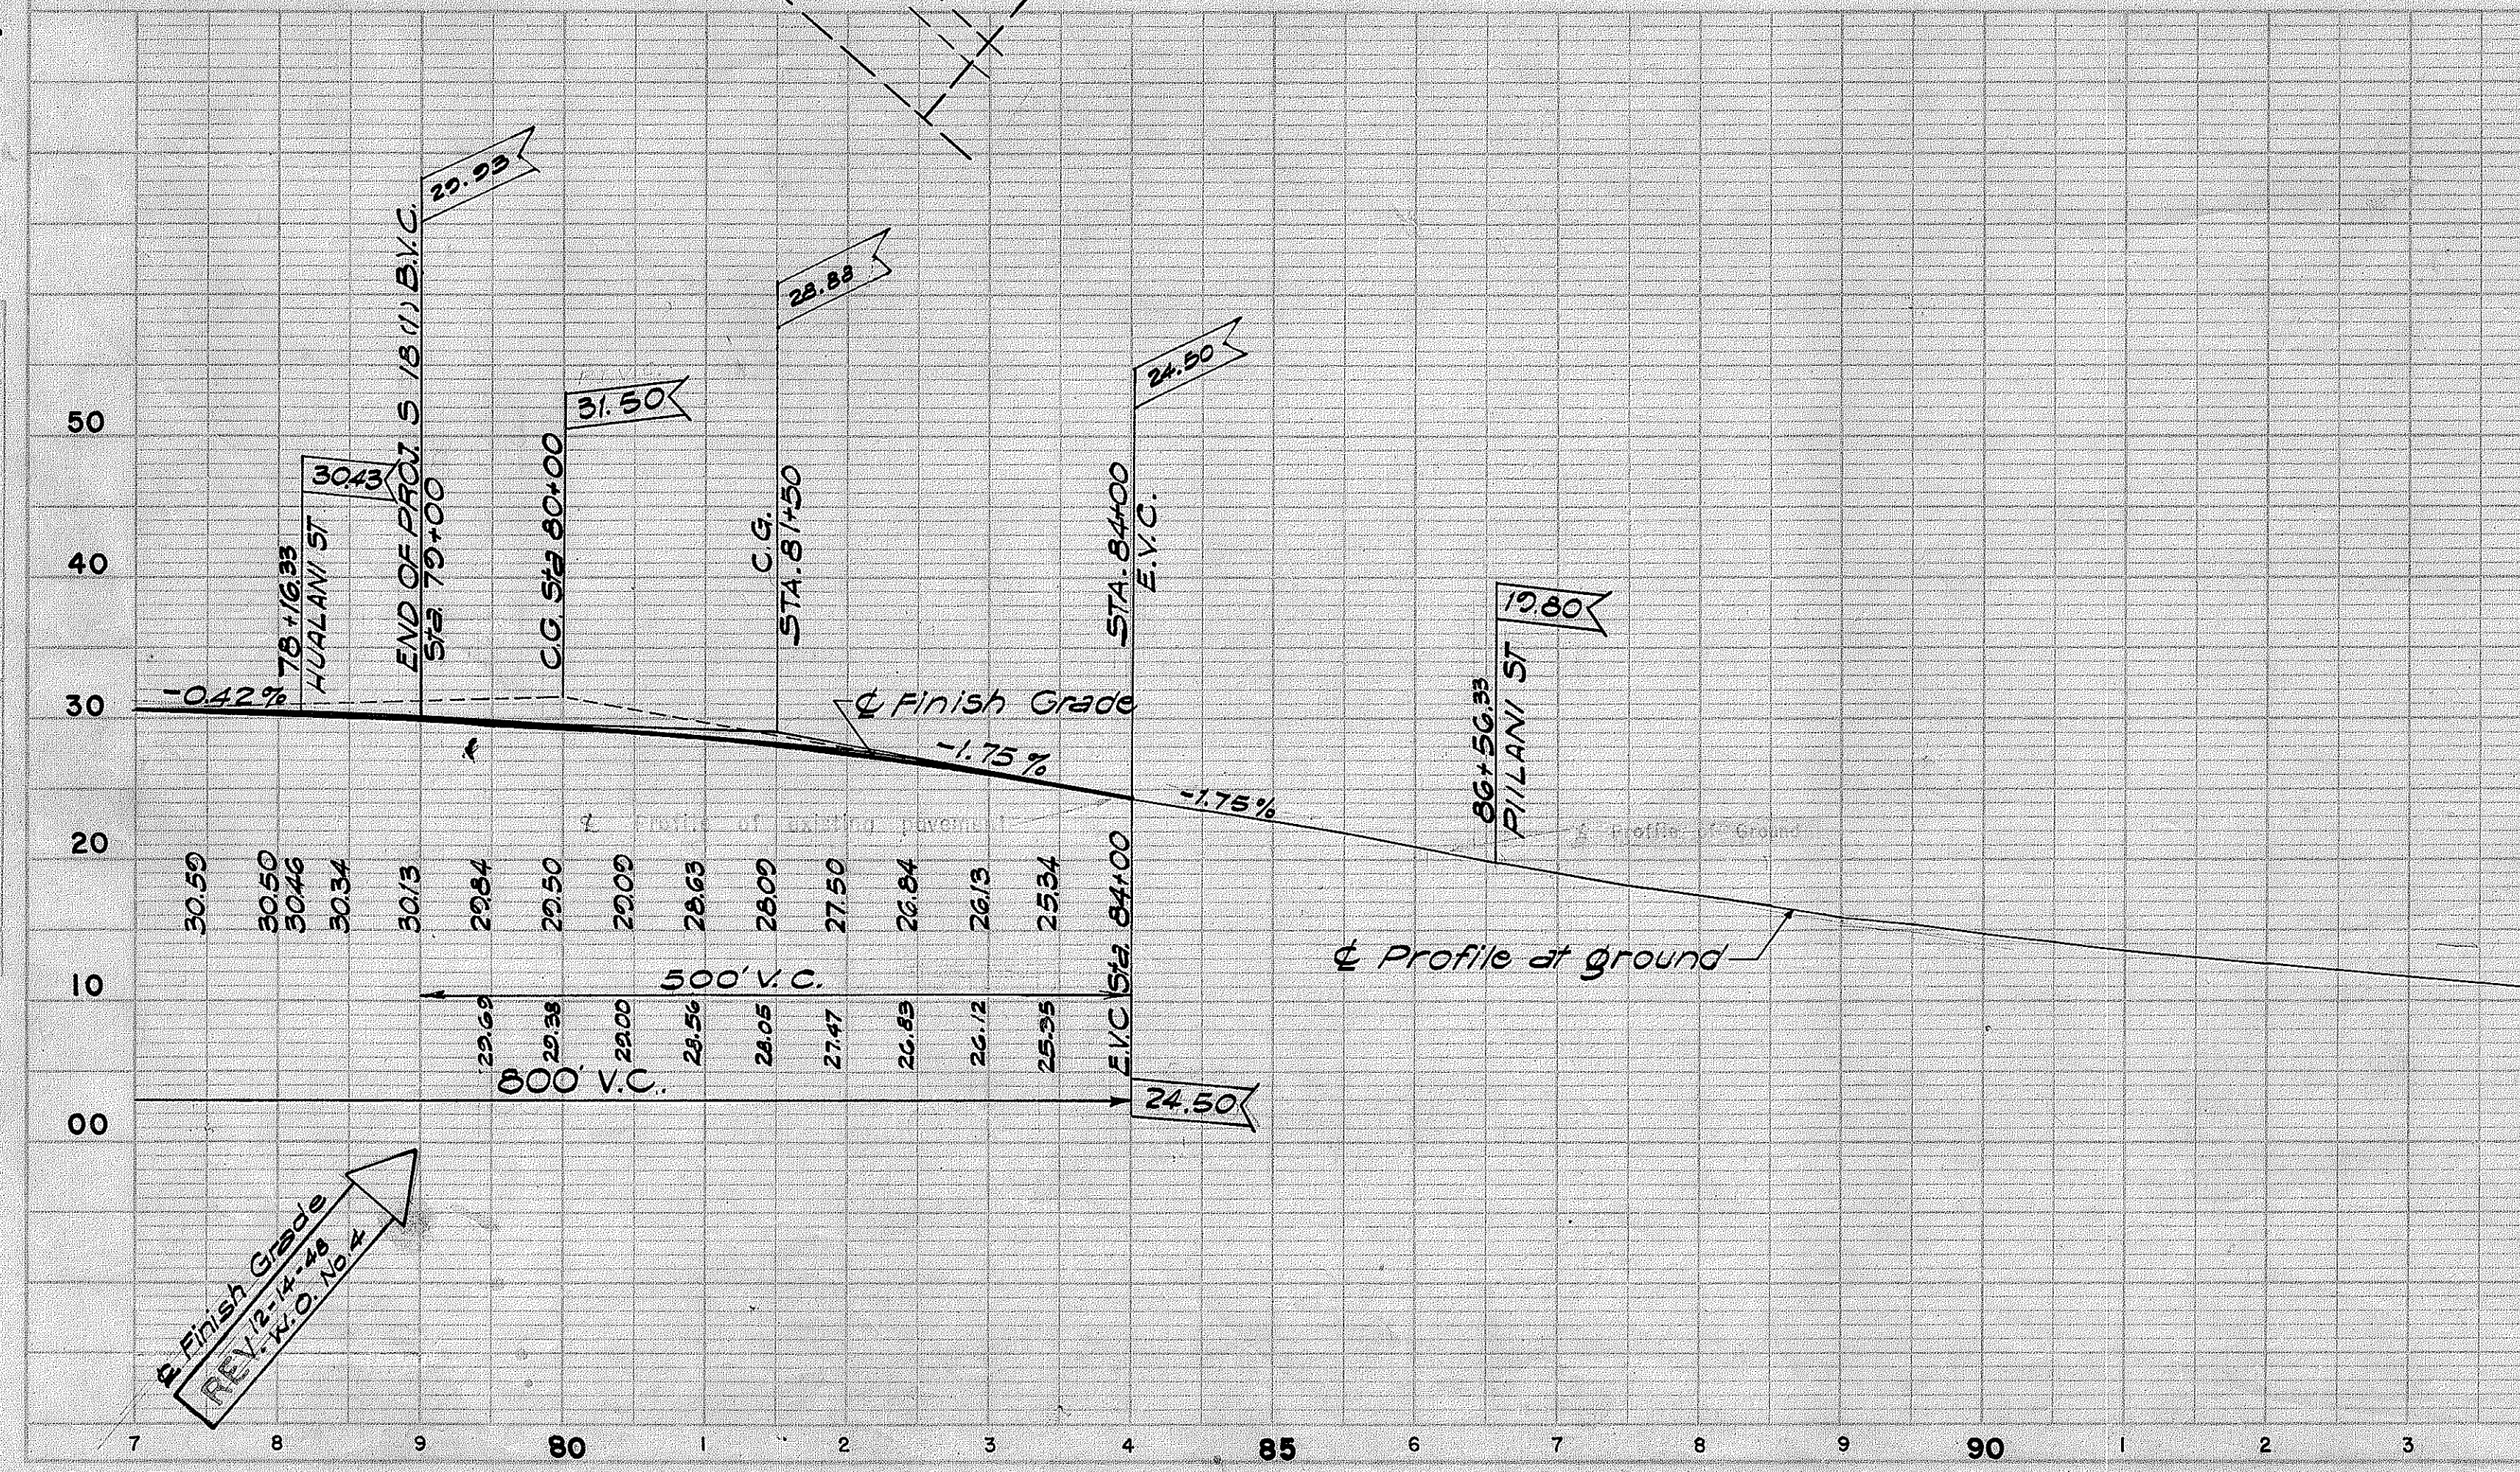

5285.6