



FINAL SURVEY
NO. _____
DATE _____
BY _____
SURVEYED _____
TEMPLATE _____
AREAS _____
CHECKED _____

ORIGINAL SURVEY
NO. _____
DATE _____
BY _____
SURVEYED _____
TEMPLATE _____
AREAS _____
CHECKED _____

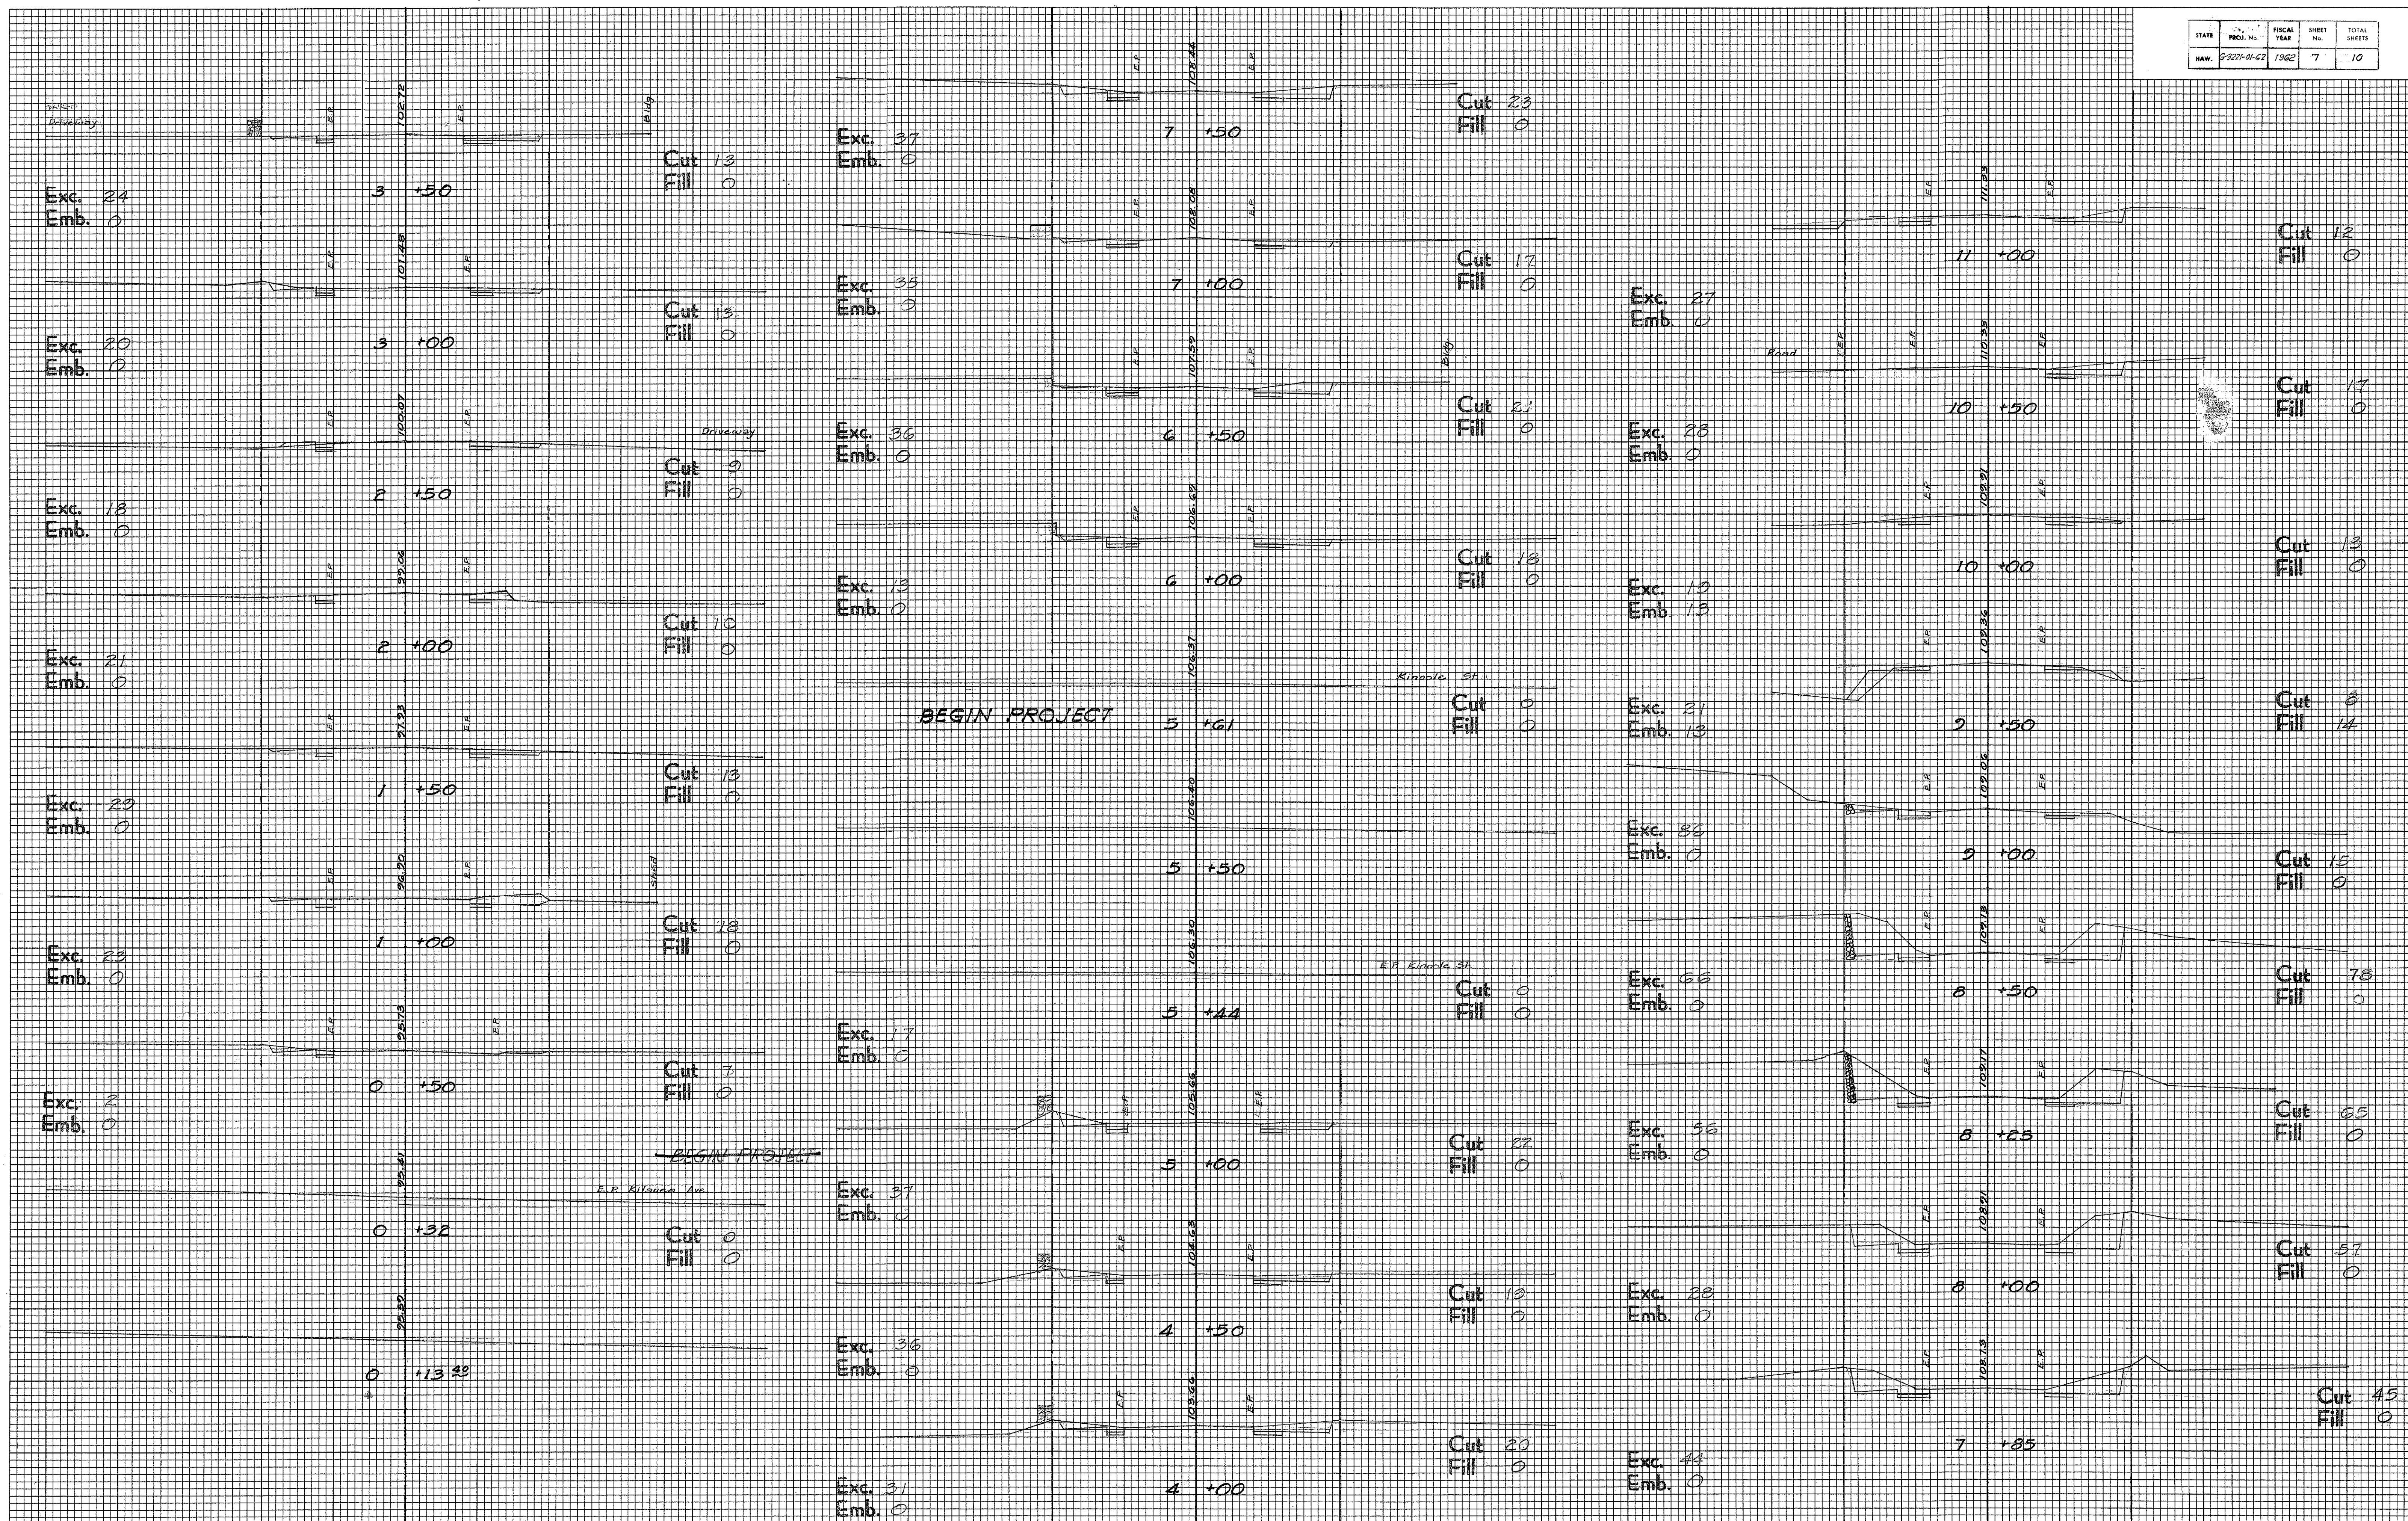

FINAL SURVEY	SURVEYED	DATE
NOTE BOOK	PLOTTED	BY
NO.	AREAS CHECKED	


ORIGINAL SURVEY	SURVEYED	DATE
NOTE BOOK	PLOTTED	BY
NO.	AREAS CHECKED	

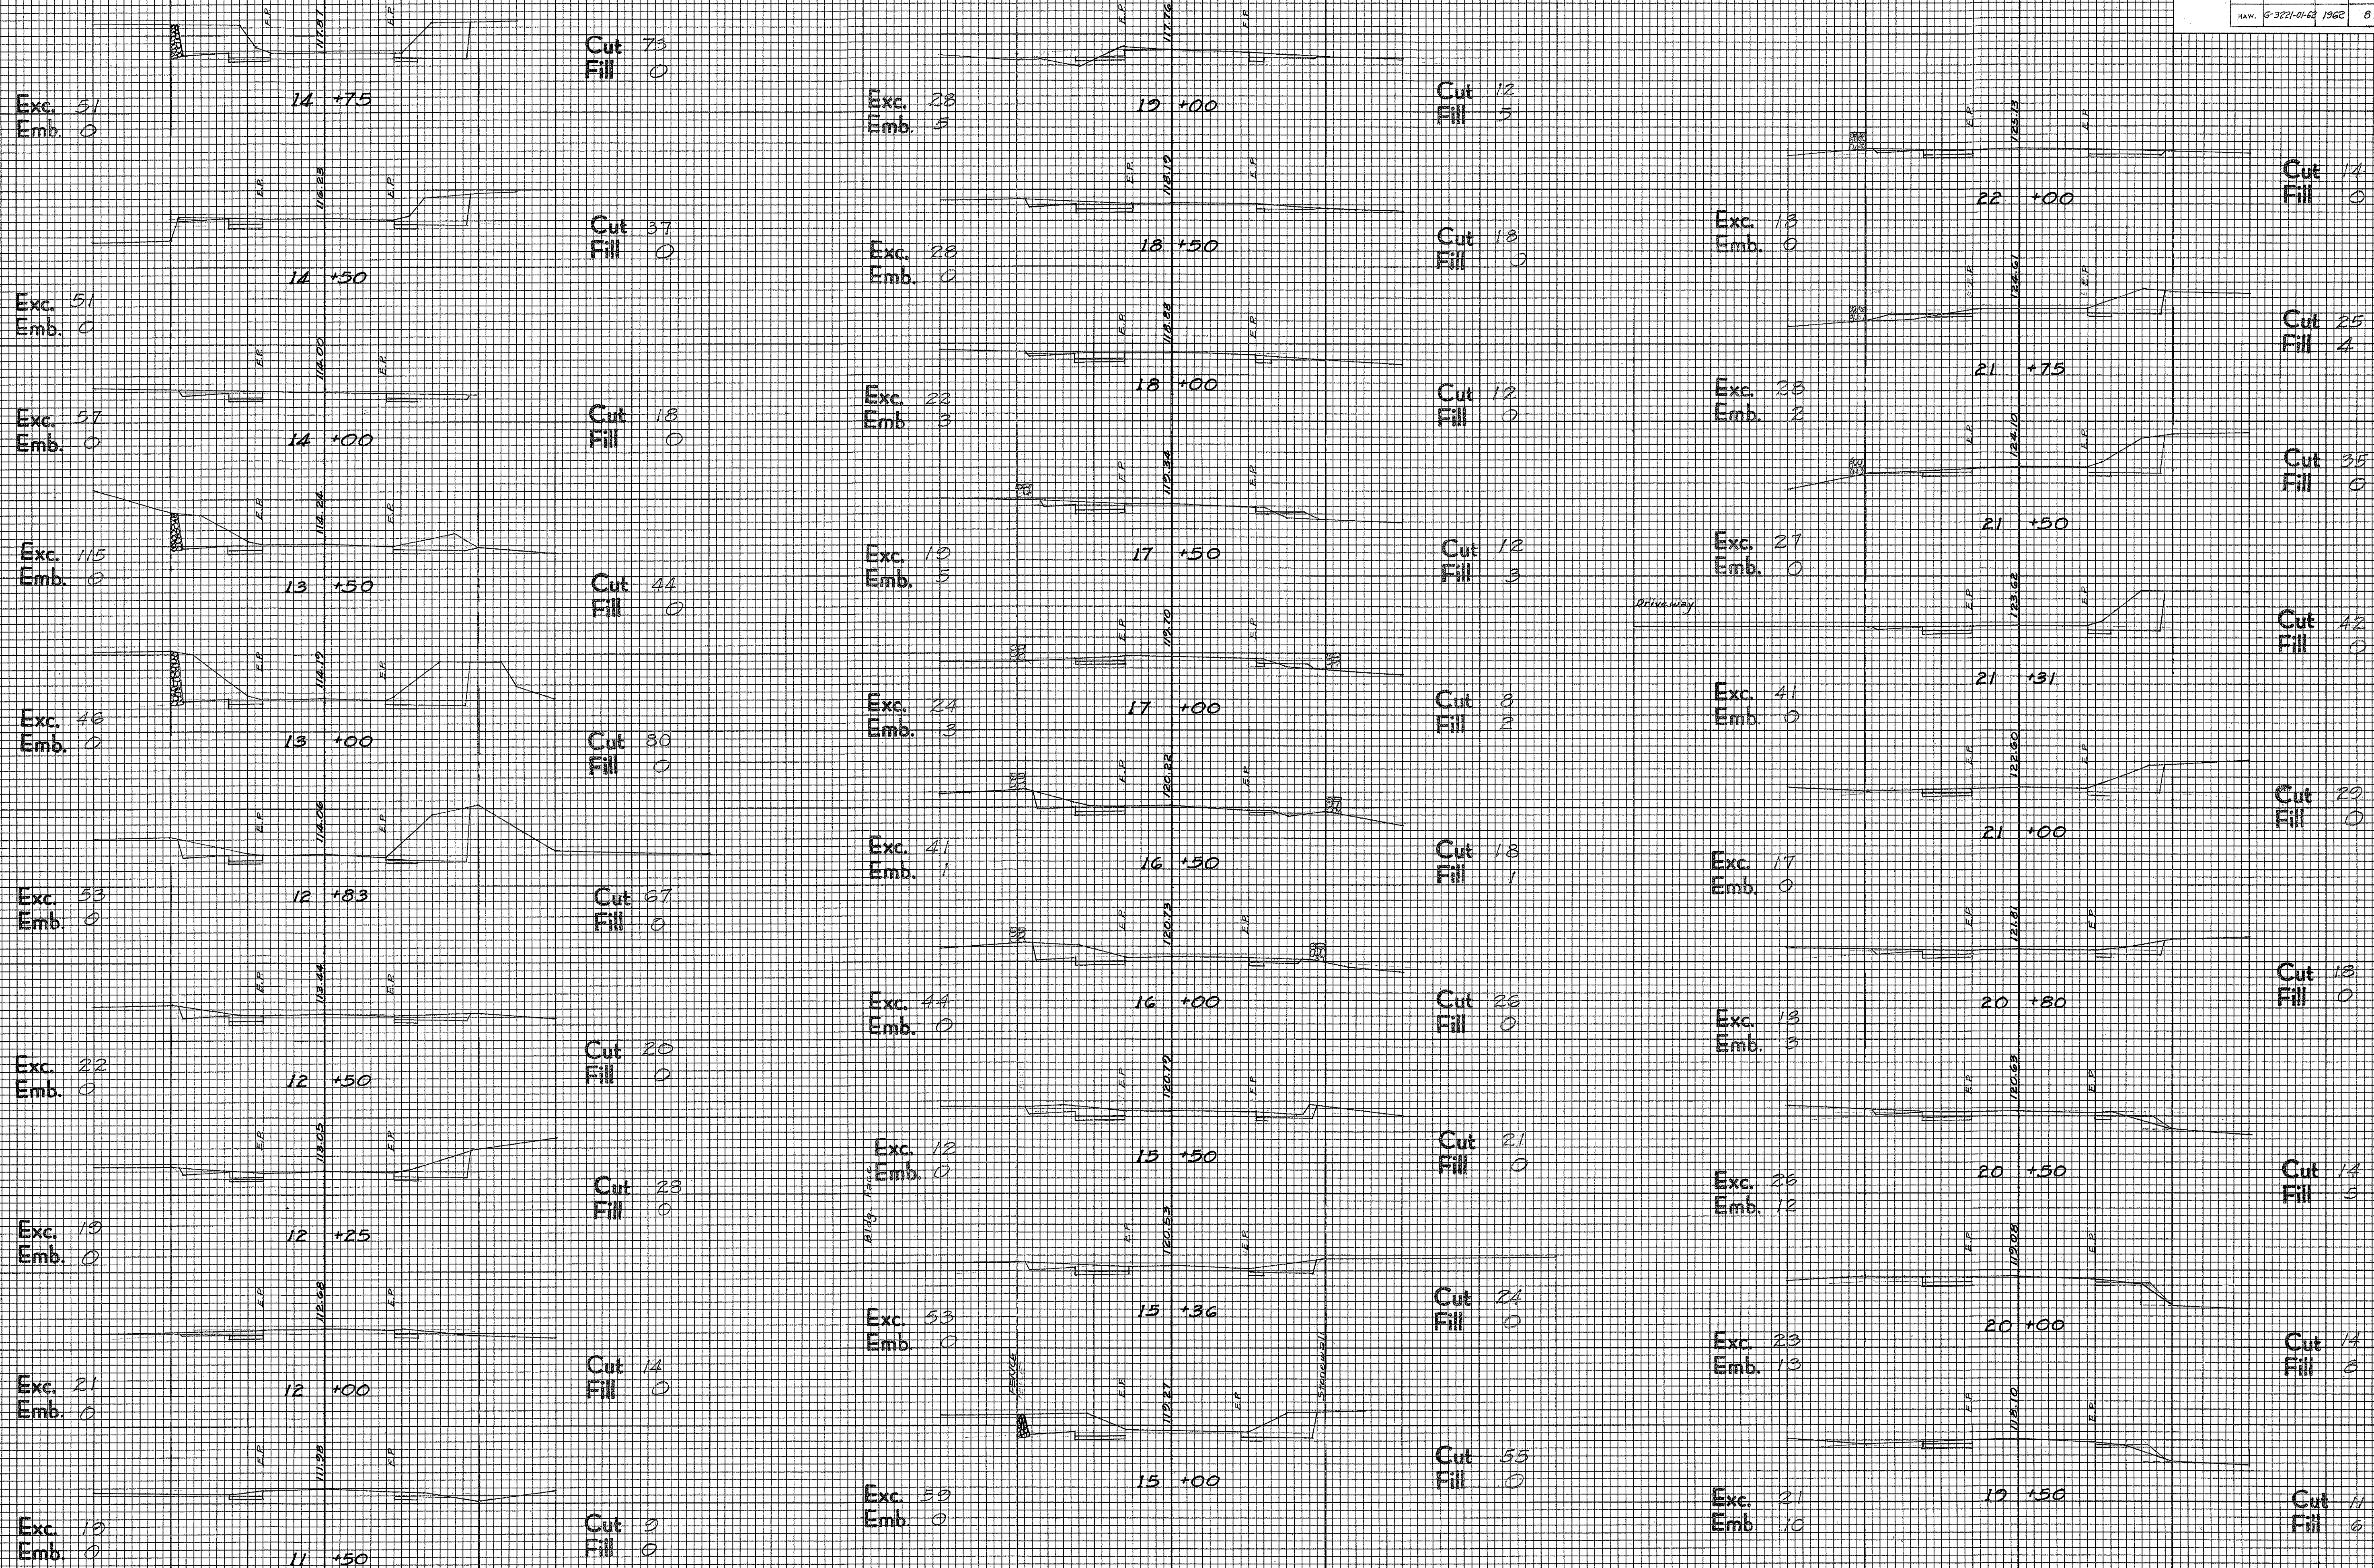

FINAL SURVEY	DATE
	BY
	SURVEYED PLOTTED NOTE BOOK AREAS CHECKED
	NO.



ORIGINAL SURVEY	DATE
	BY
	SURVEYED PLOTTED NOTE BOOK AREAS CHECKED
	NO.

STATE	PROJ. NO.	FISCAL YEAR	SHEET NO.	TOTAL SHEETS
HAW.	G-3210-42	1962	9	10

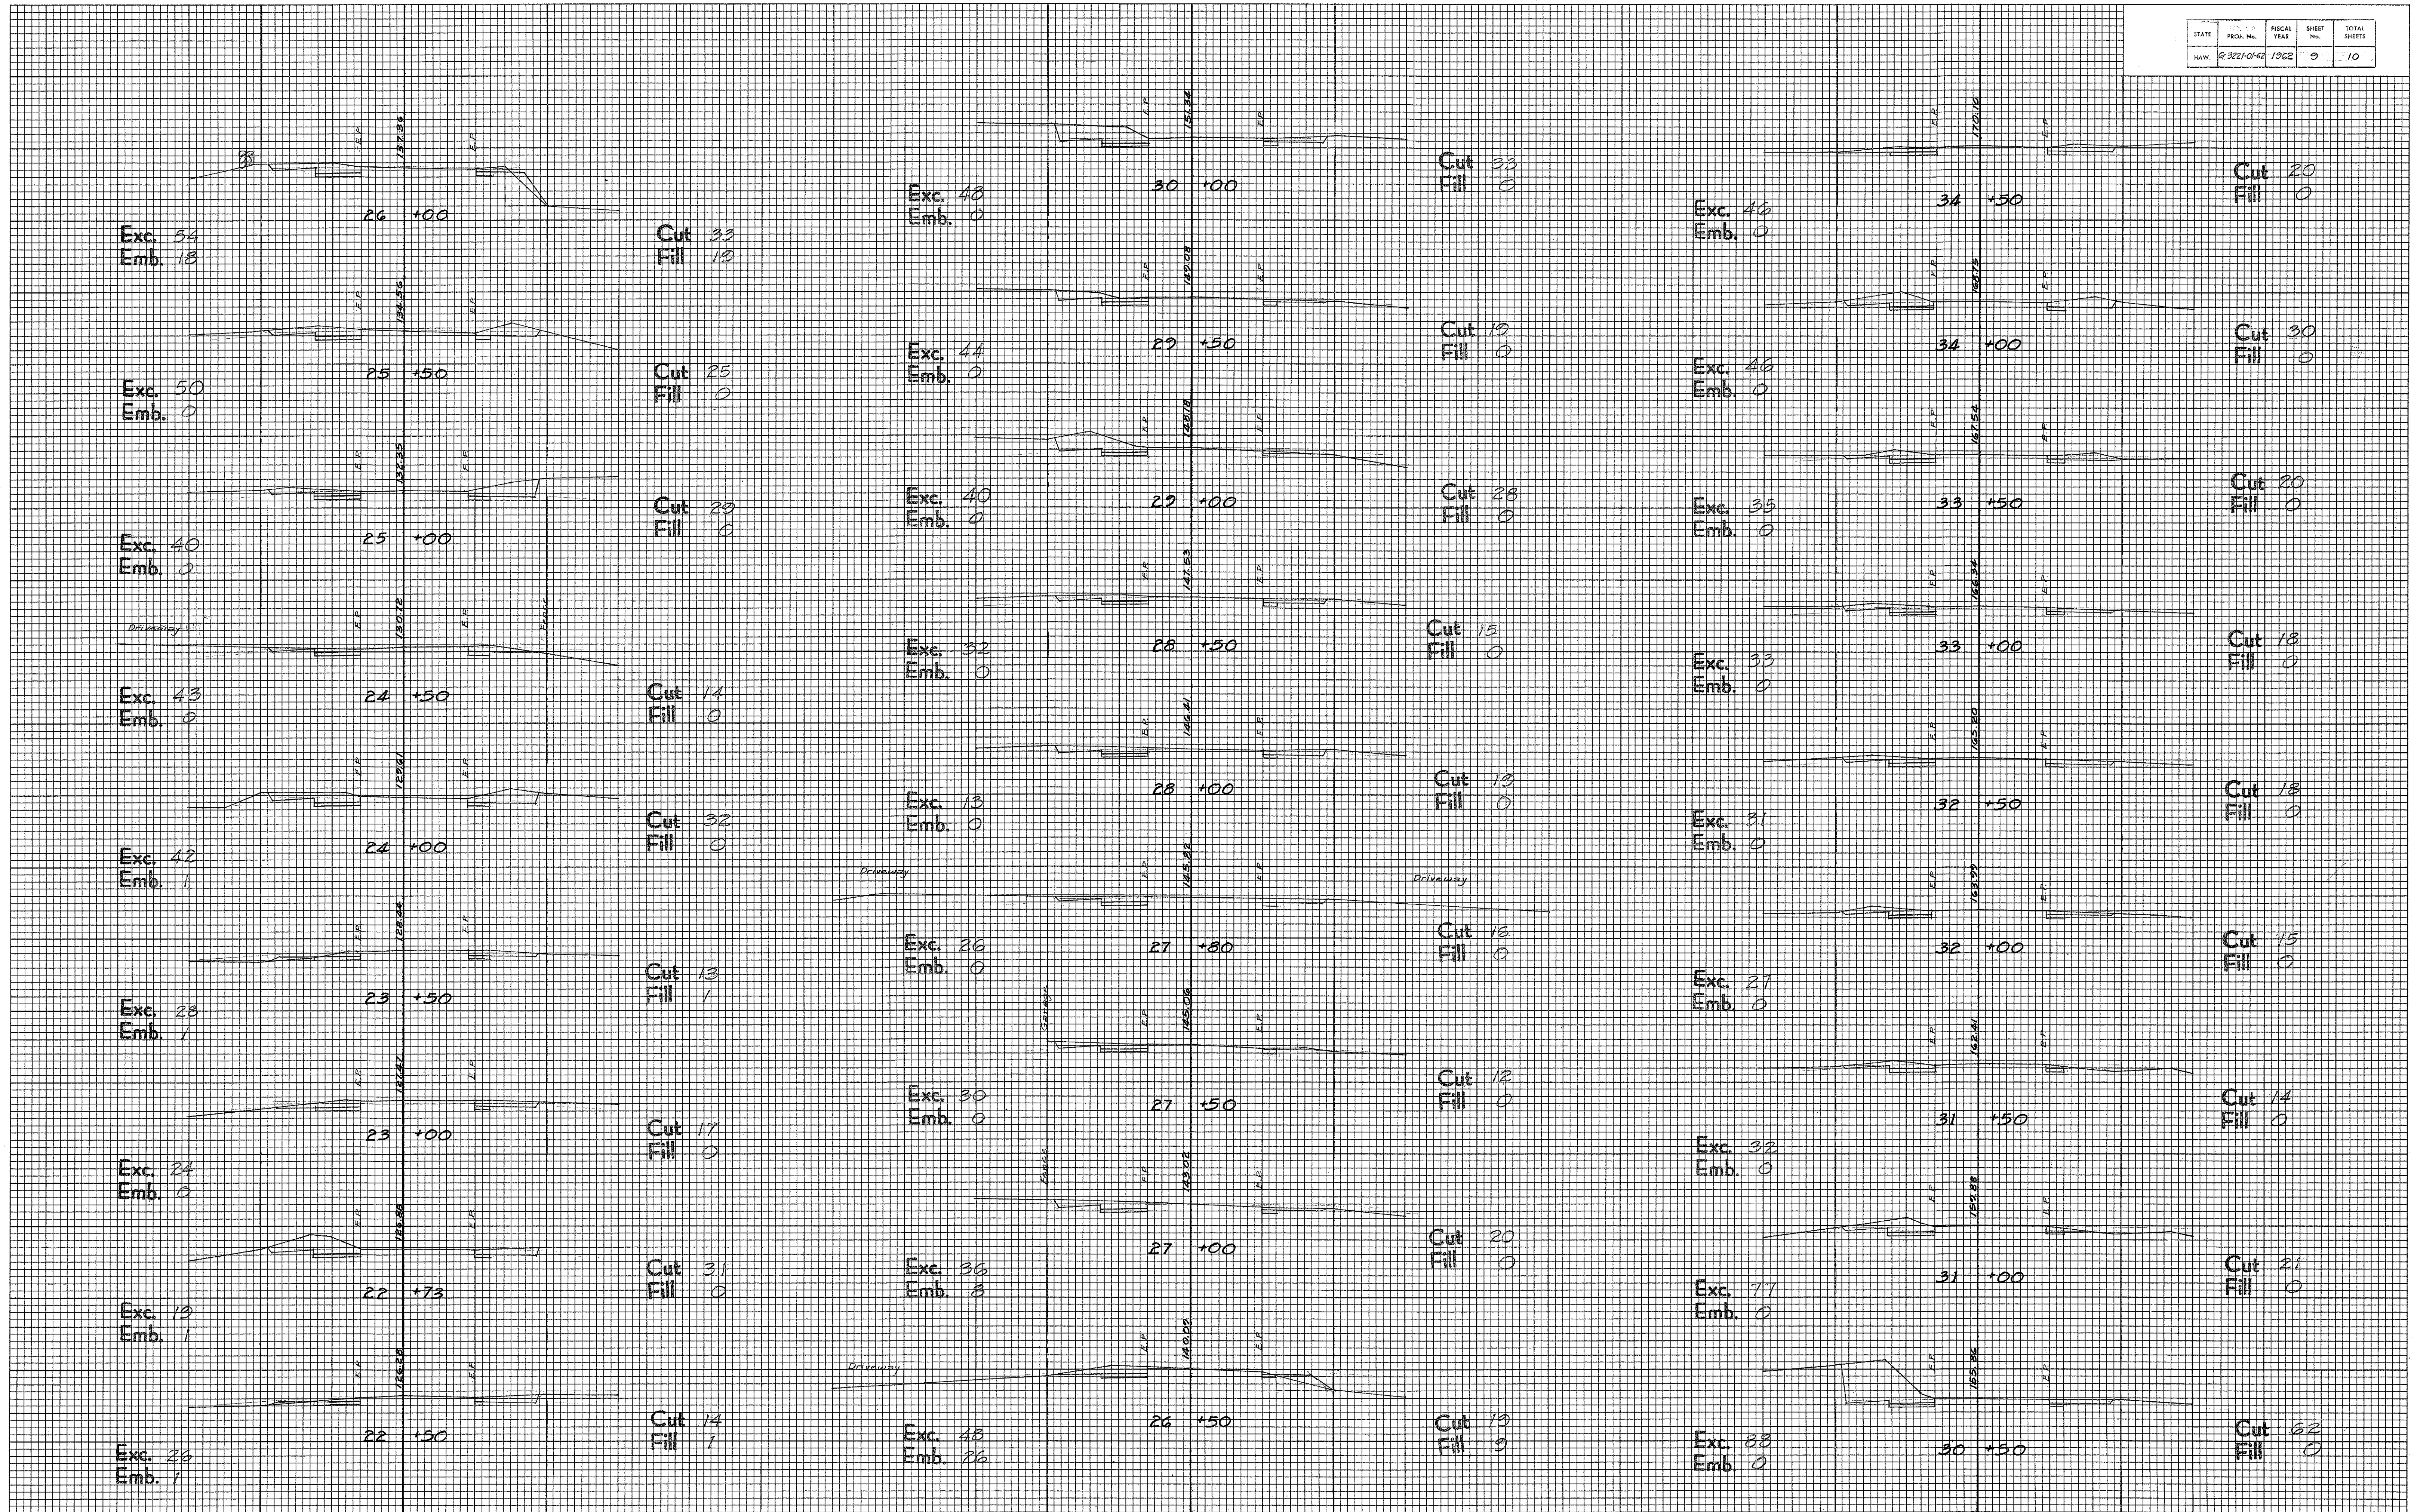

FINAL SURVEY	SURVEYED	DATE
	NOTE BOOK	BY
	AREAS	
	AREAS CHECKED	

ORIGINAL SURVEY	SURVEYED	DATE
	NOTE BOOK	BY
	AREAS	
	AREAS CHECKED	

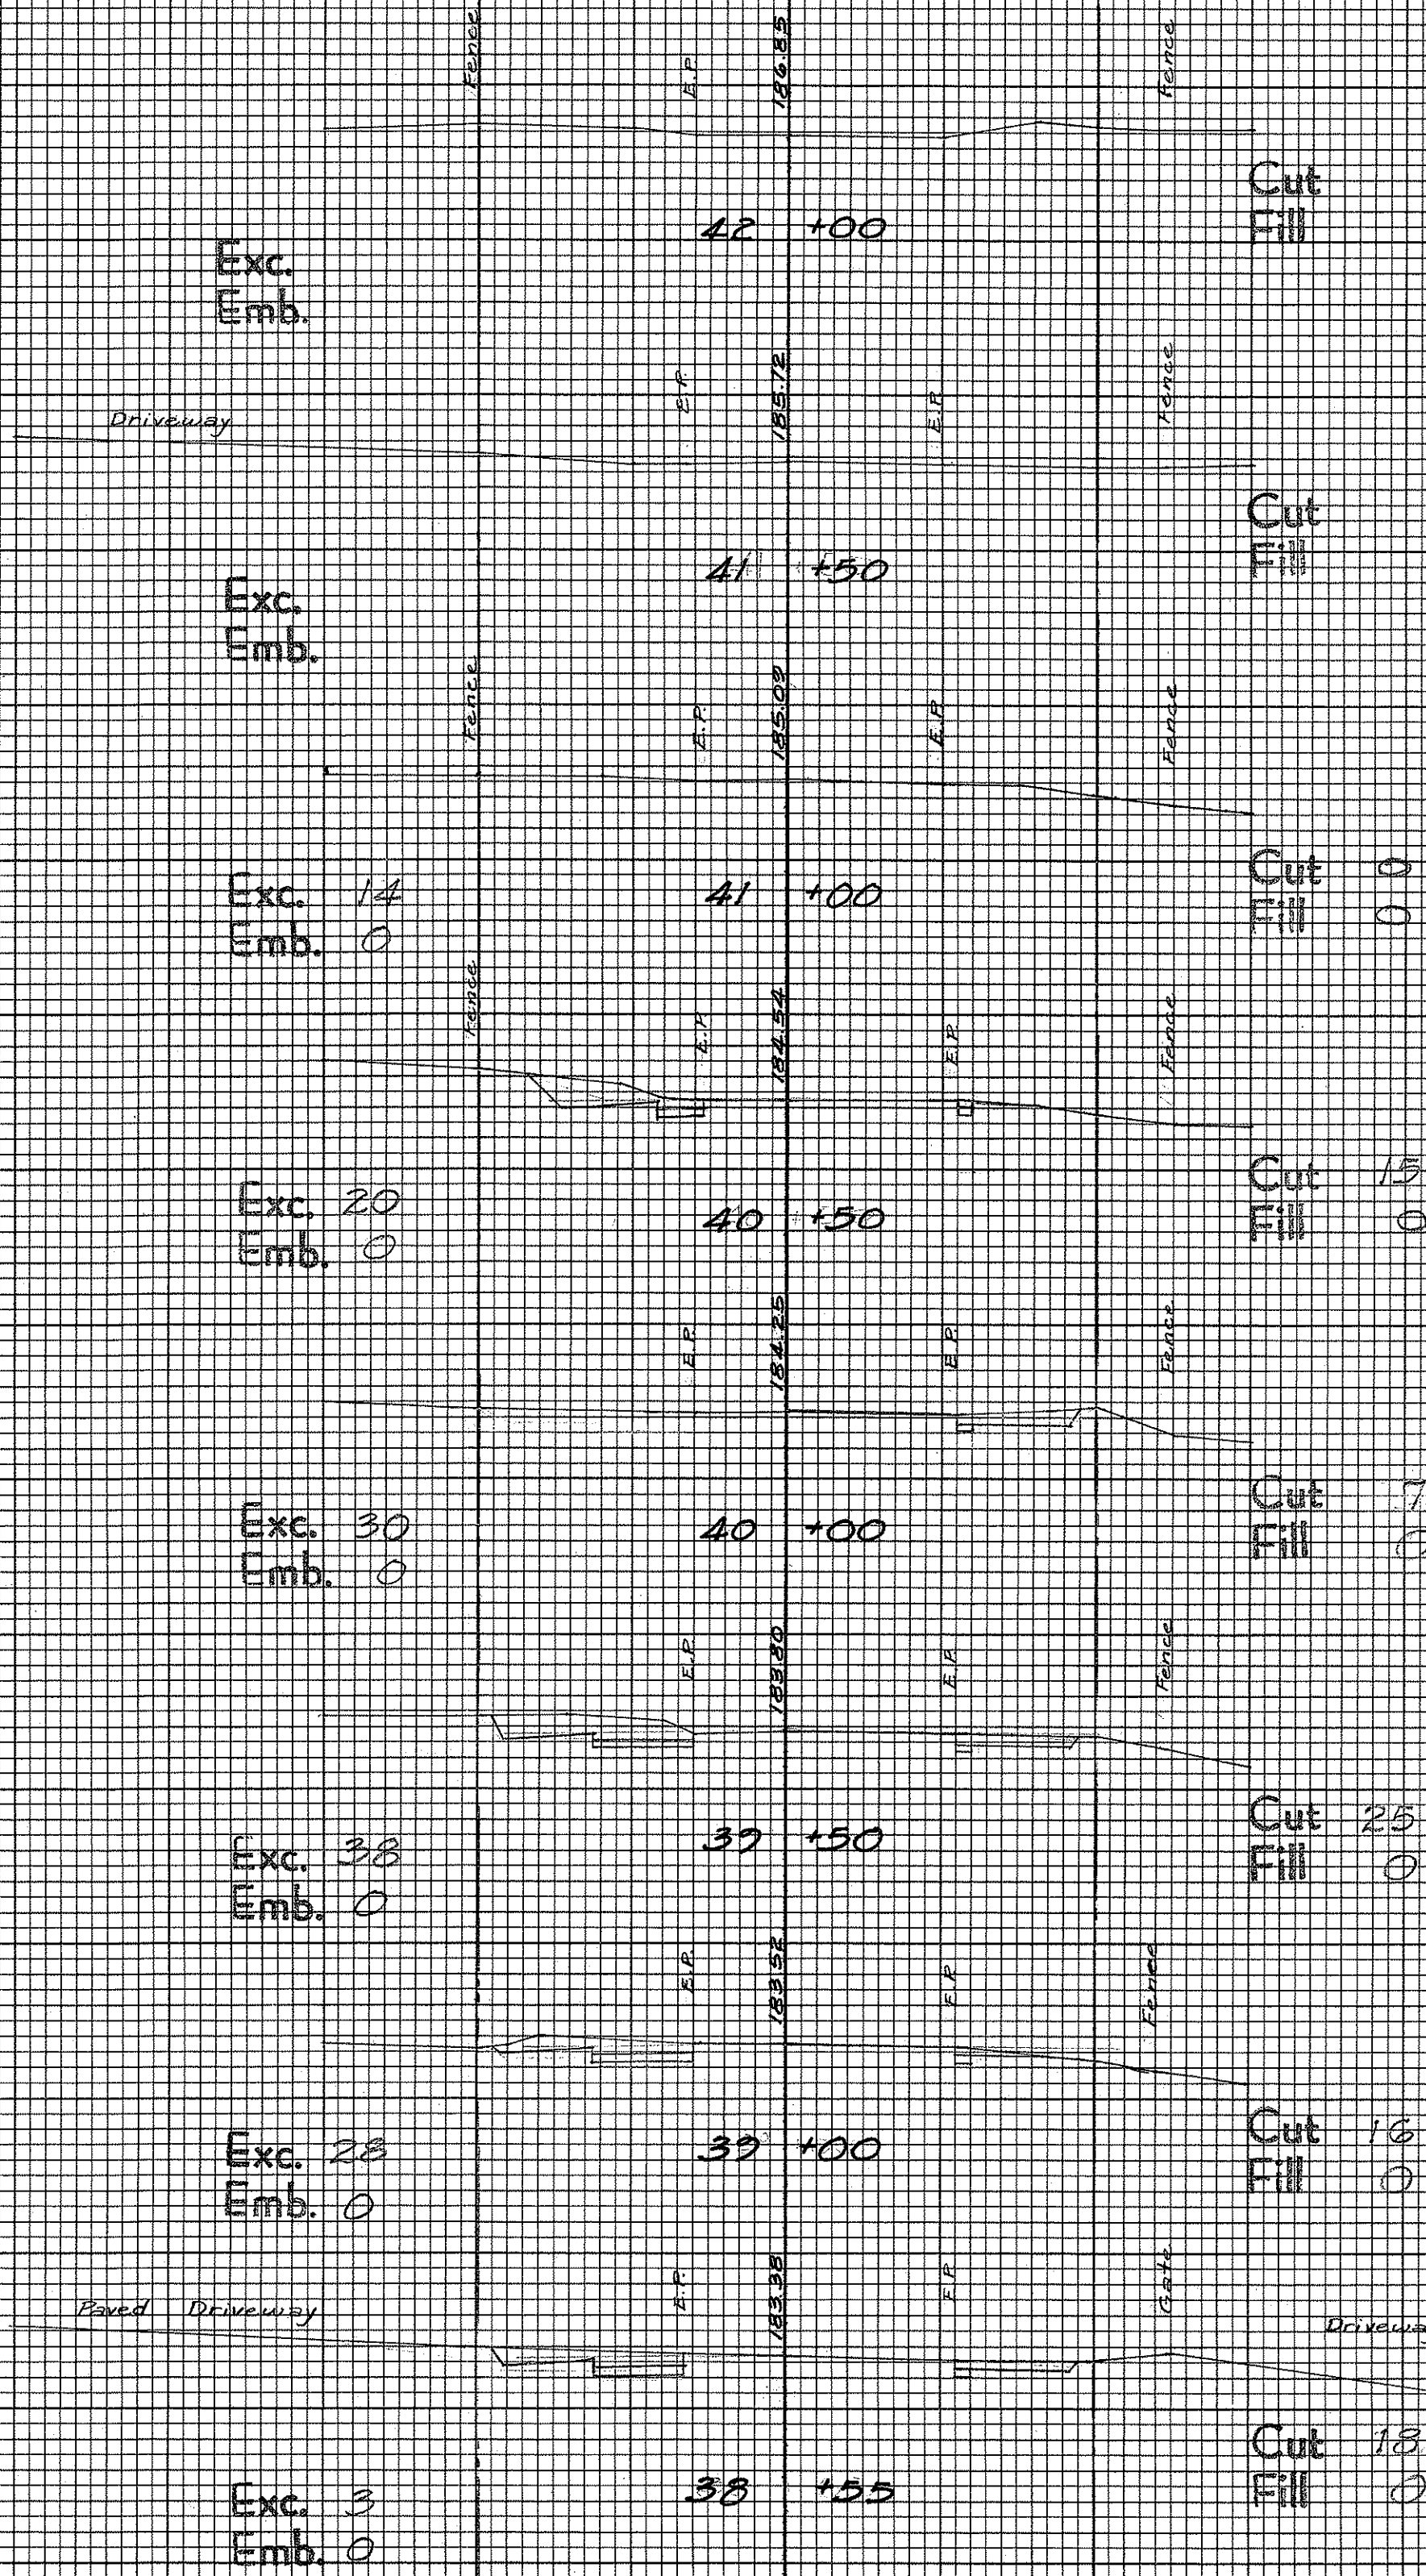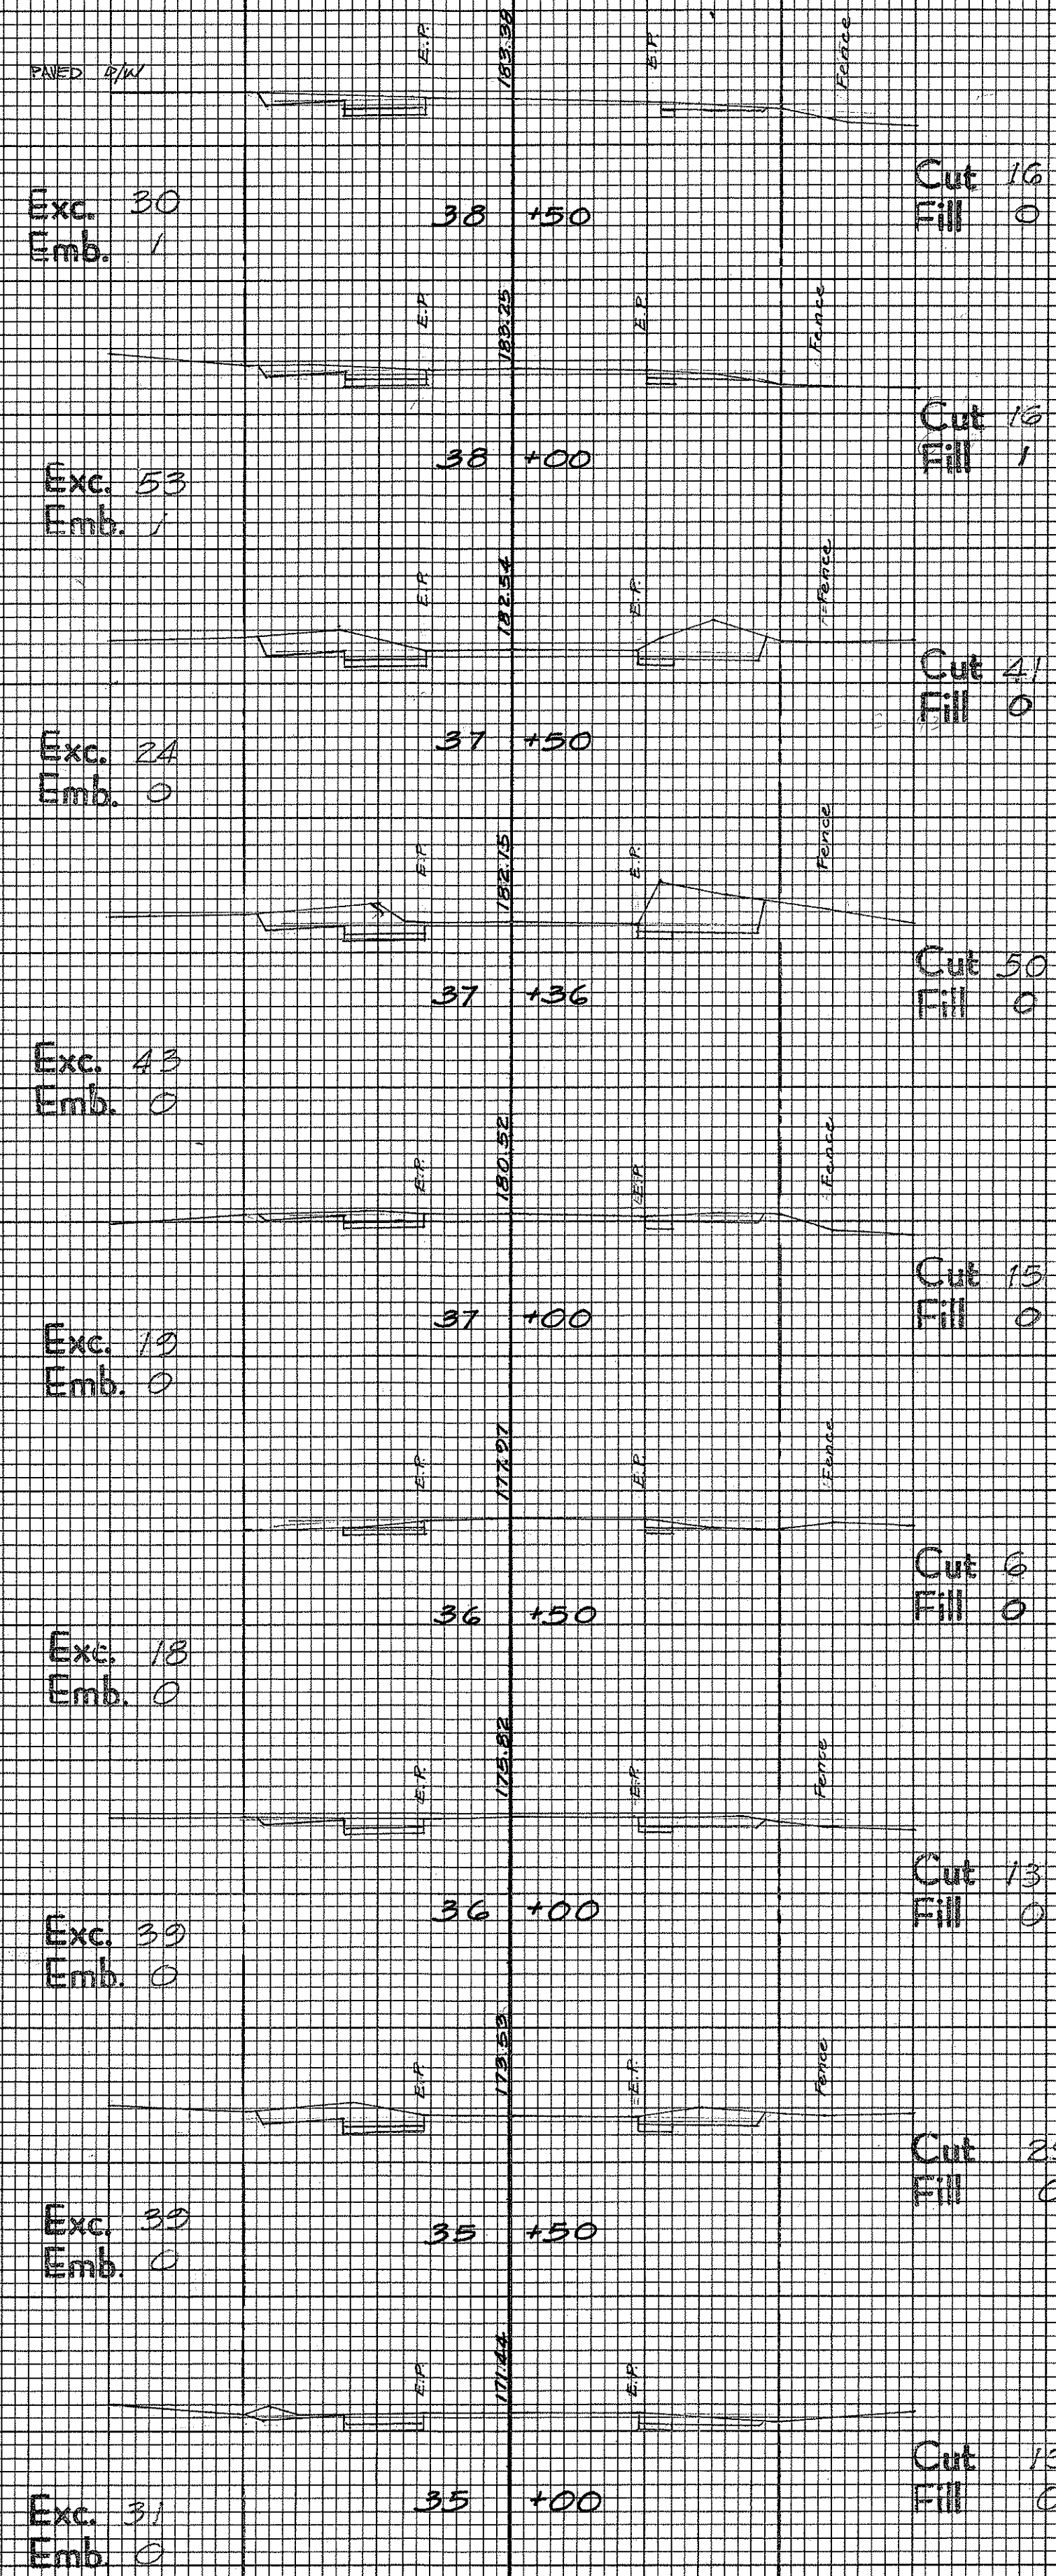

END OF CONTRACT