

INDEX TO DRAWINGS	
SHEET	DESCRIPTION
1	TITLE SHEET
2	TYPICAL SECTIONS & SIGNS
3-5	PLAN AND PROFILE
6	WATER DETAILS
7-10	CROSS SECTIONS

STATE OF HAWAII

DEPARTMENT OF TRANSPORTATION

HIGHWAYS DIVISION

AS-BUILT PLANS OF

WIDENING AND RESURFACING

OF A PORTION OF

PUAINAKO STREET



HAWAII PROJECT NO. G-3221-01-62

WAIAKEA SECTION

DISTRICT OF SOUTH HILO


ISLAND OF HAWAII

SCALES			
PLAN		1 INCH	= 50 FT.
PROFILE		HOR. 1 INCH	= 50 FT.
		VER. 1 INCH	= 5 FT.
CROSS SECTION		HOR. 1 INCH	= 10 FT.
		VER. 1 INCH	= 10 FT.

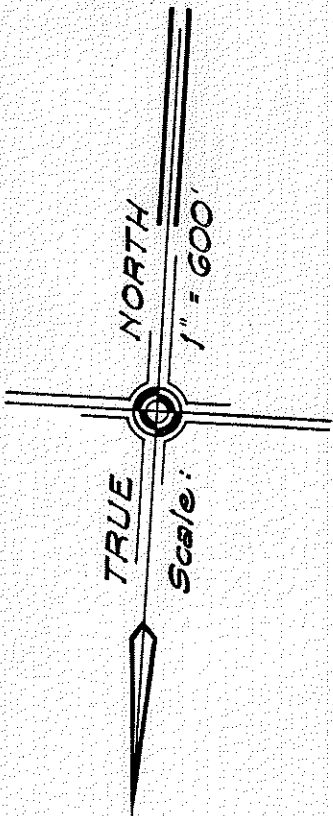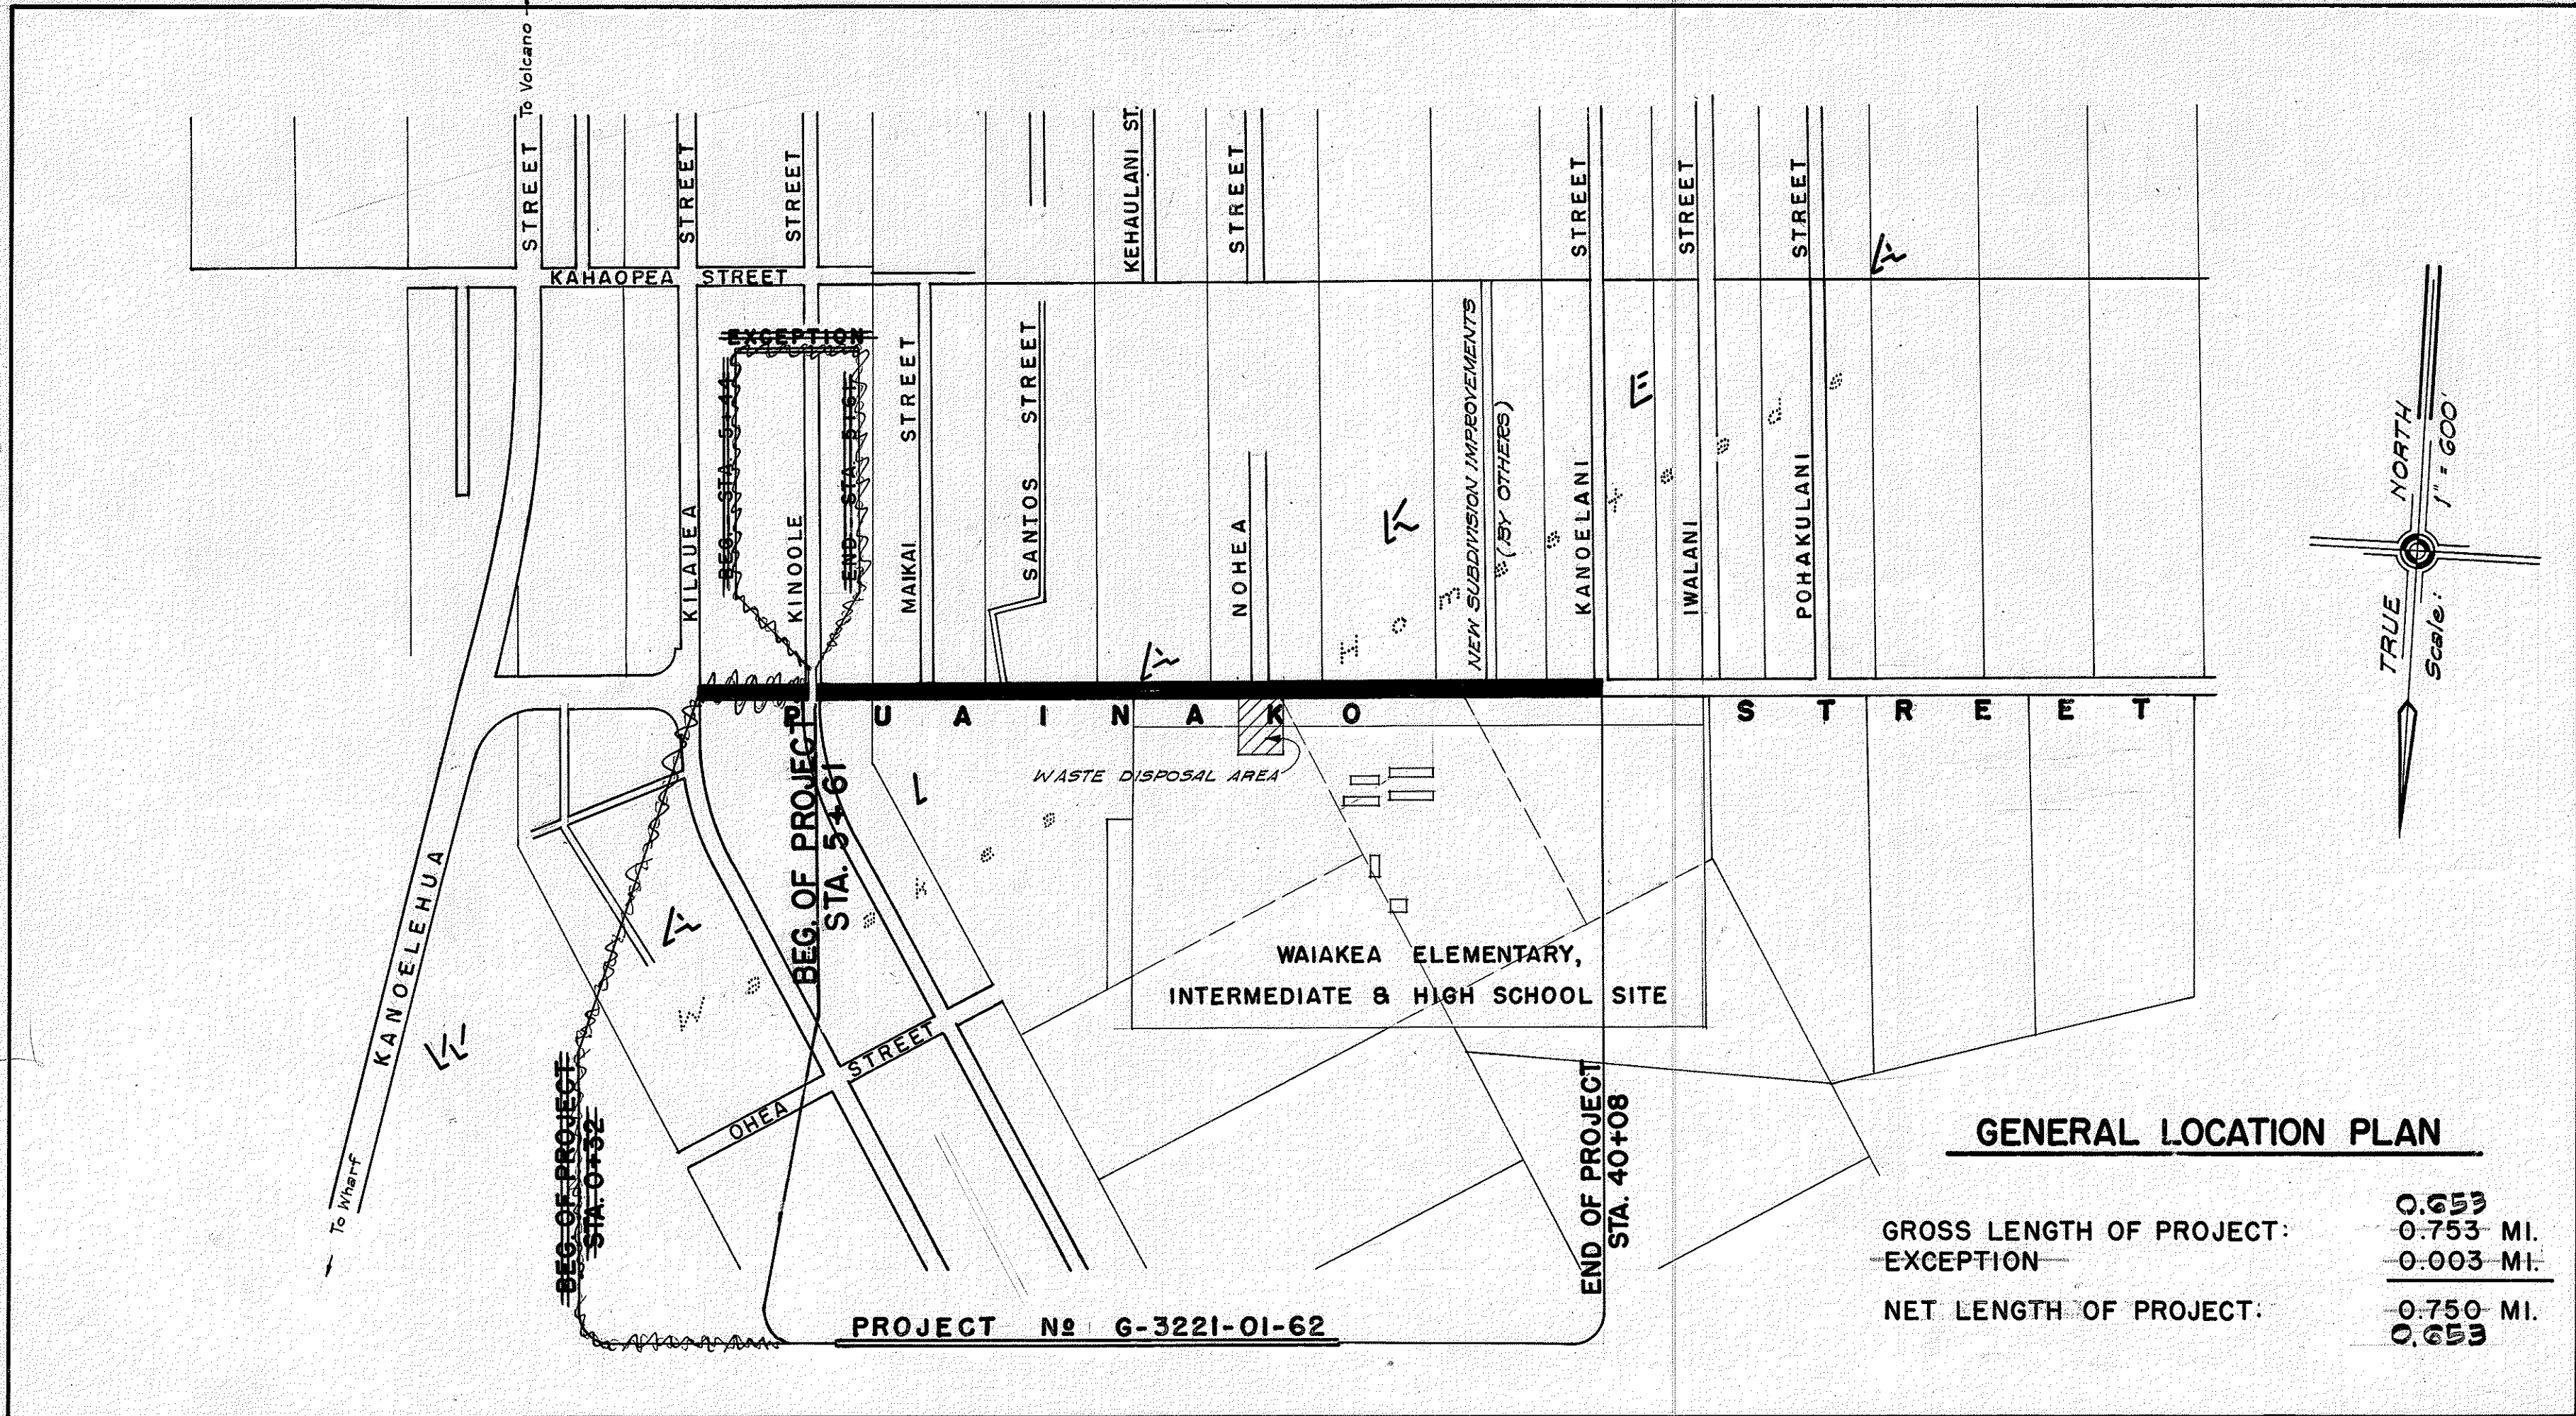

GENERAL LOCATION PLAN

GROSS LENGTH OF PROJECT:	0.653
EXCEPTION	-0.753 MI.
	-0.003 MI.
NET LENGTH OF PROJECT:	-0.750 MI.
	0.653

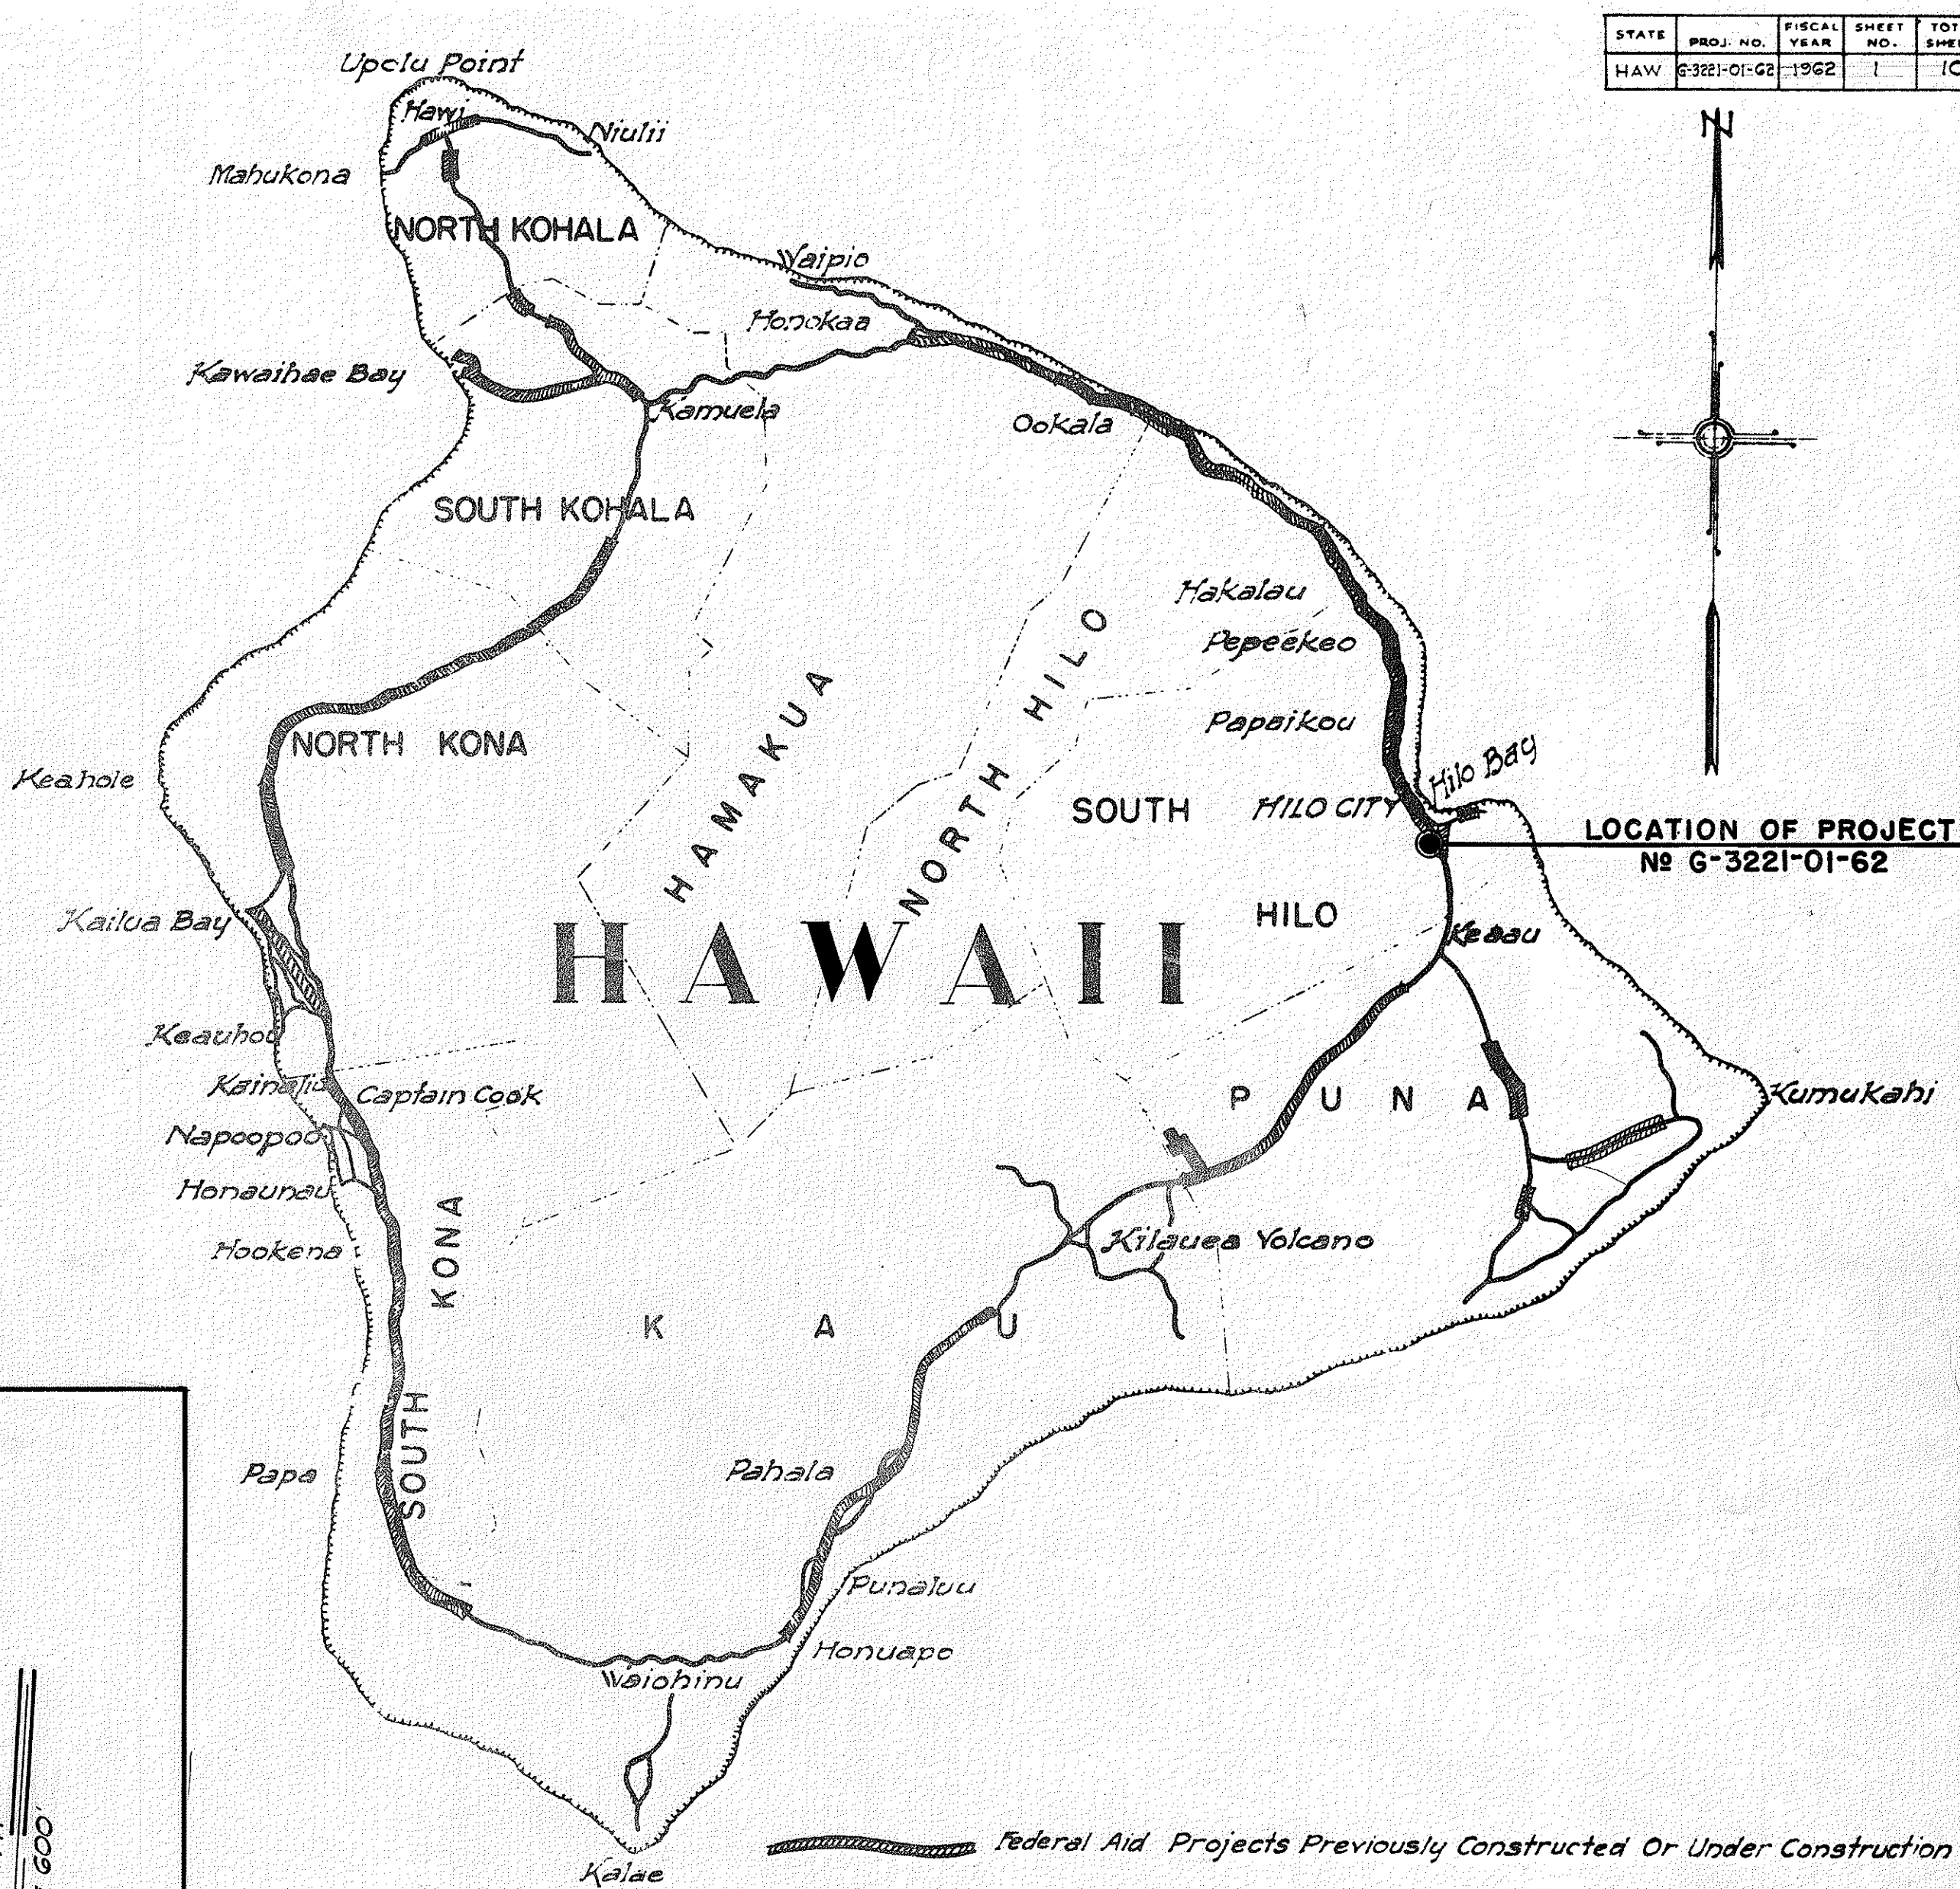

NOTE

ALL CHANGES MADE DURING CONSTRUCTION HAVE BEEN NOTED IN RED ON THESE TRACINGS AND CHECKED BY:

Samuel Kumukahi
PROJECT ENGINEER

May 27, 1962
DATE

AUTHORIZED BY ACT 195, S.L.H., 1961

APPROVED: DATE 1-18-62
Sam O. Hirota
for DIRECTOR OF TRANSPORTATION