

C.O. 3 S-1



V.B. & M.H. RECOVERY SCHEDULE				
STATION	OFFSET FROM ϕ			REMARKS
	LT.	ϕ .	RT.	
-5+27	50 (+)			W.V.B. 15" X 17"
-8+20		0		SM.H. 10" dia.
-8+20	3.5 (+)			W.V.B. 24" dia.
-8+30			14.5 (+)	W.V.B. 14" dia.
0+34			14 (+)	W.V.B. 15" X 17"
2+00			15 (+)	W.V.B. 15" X 17"
4+00			11" (+)	V.B. (Gas) 11" dia
TOTALS			7- EA.	

STATE OF HAWAII
DEPARTMENT OF TRANSPORTATION
HIGHWAYS DIVISION

ROADWAY PLAN & SCHEDULES


PUAINAKO STREET RESURFACING
KANOELFHUA AVENUE TO KILAUEA AVENUE
PROJ. NO. 2000E-01-90M

Scale: 1"=50' Date: July. 1991

SHEET No. / OF / SHEETS

C.O. 3 S-1

FED. ROAD DIST. NO.	STATE	PROJ. NO.	FISCAL YEAR	SHEET NO.	TOTAL SHEETS
HAWAII	HAW.	2000E-01-30M	1990	4	8

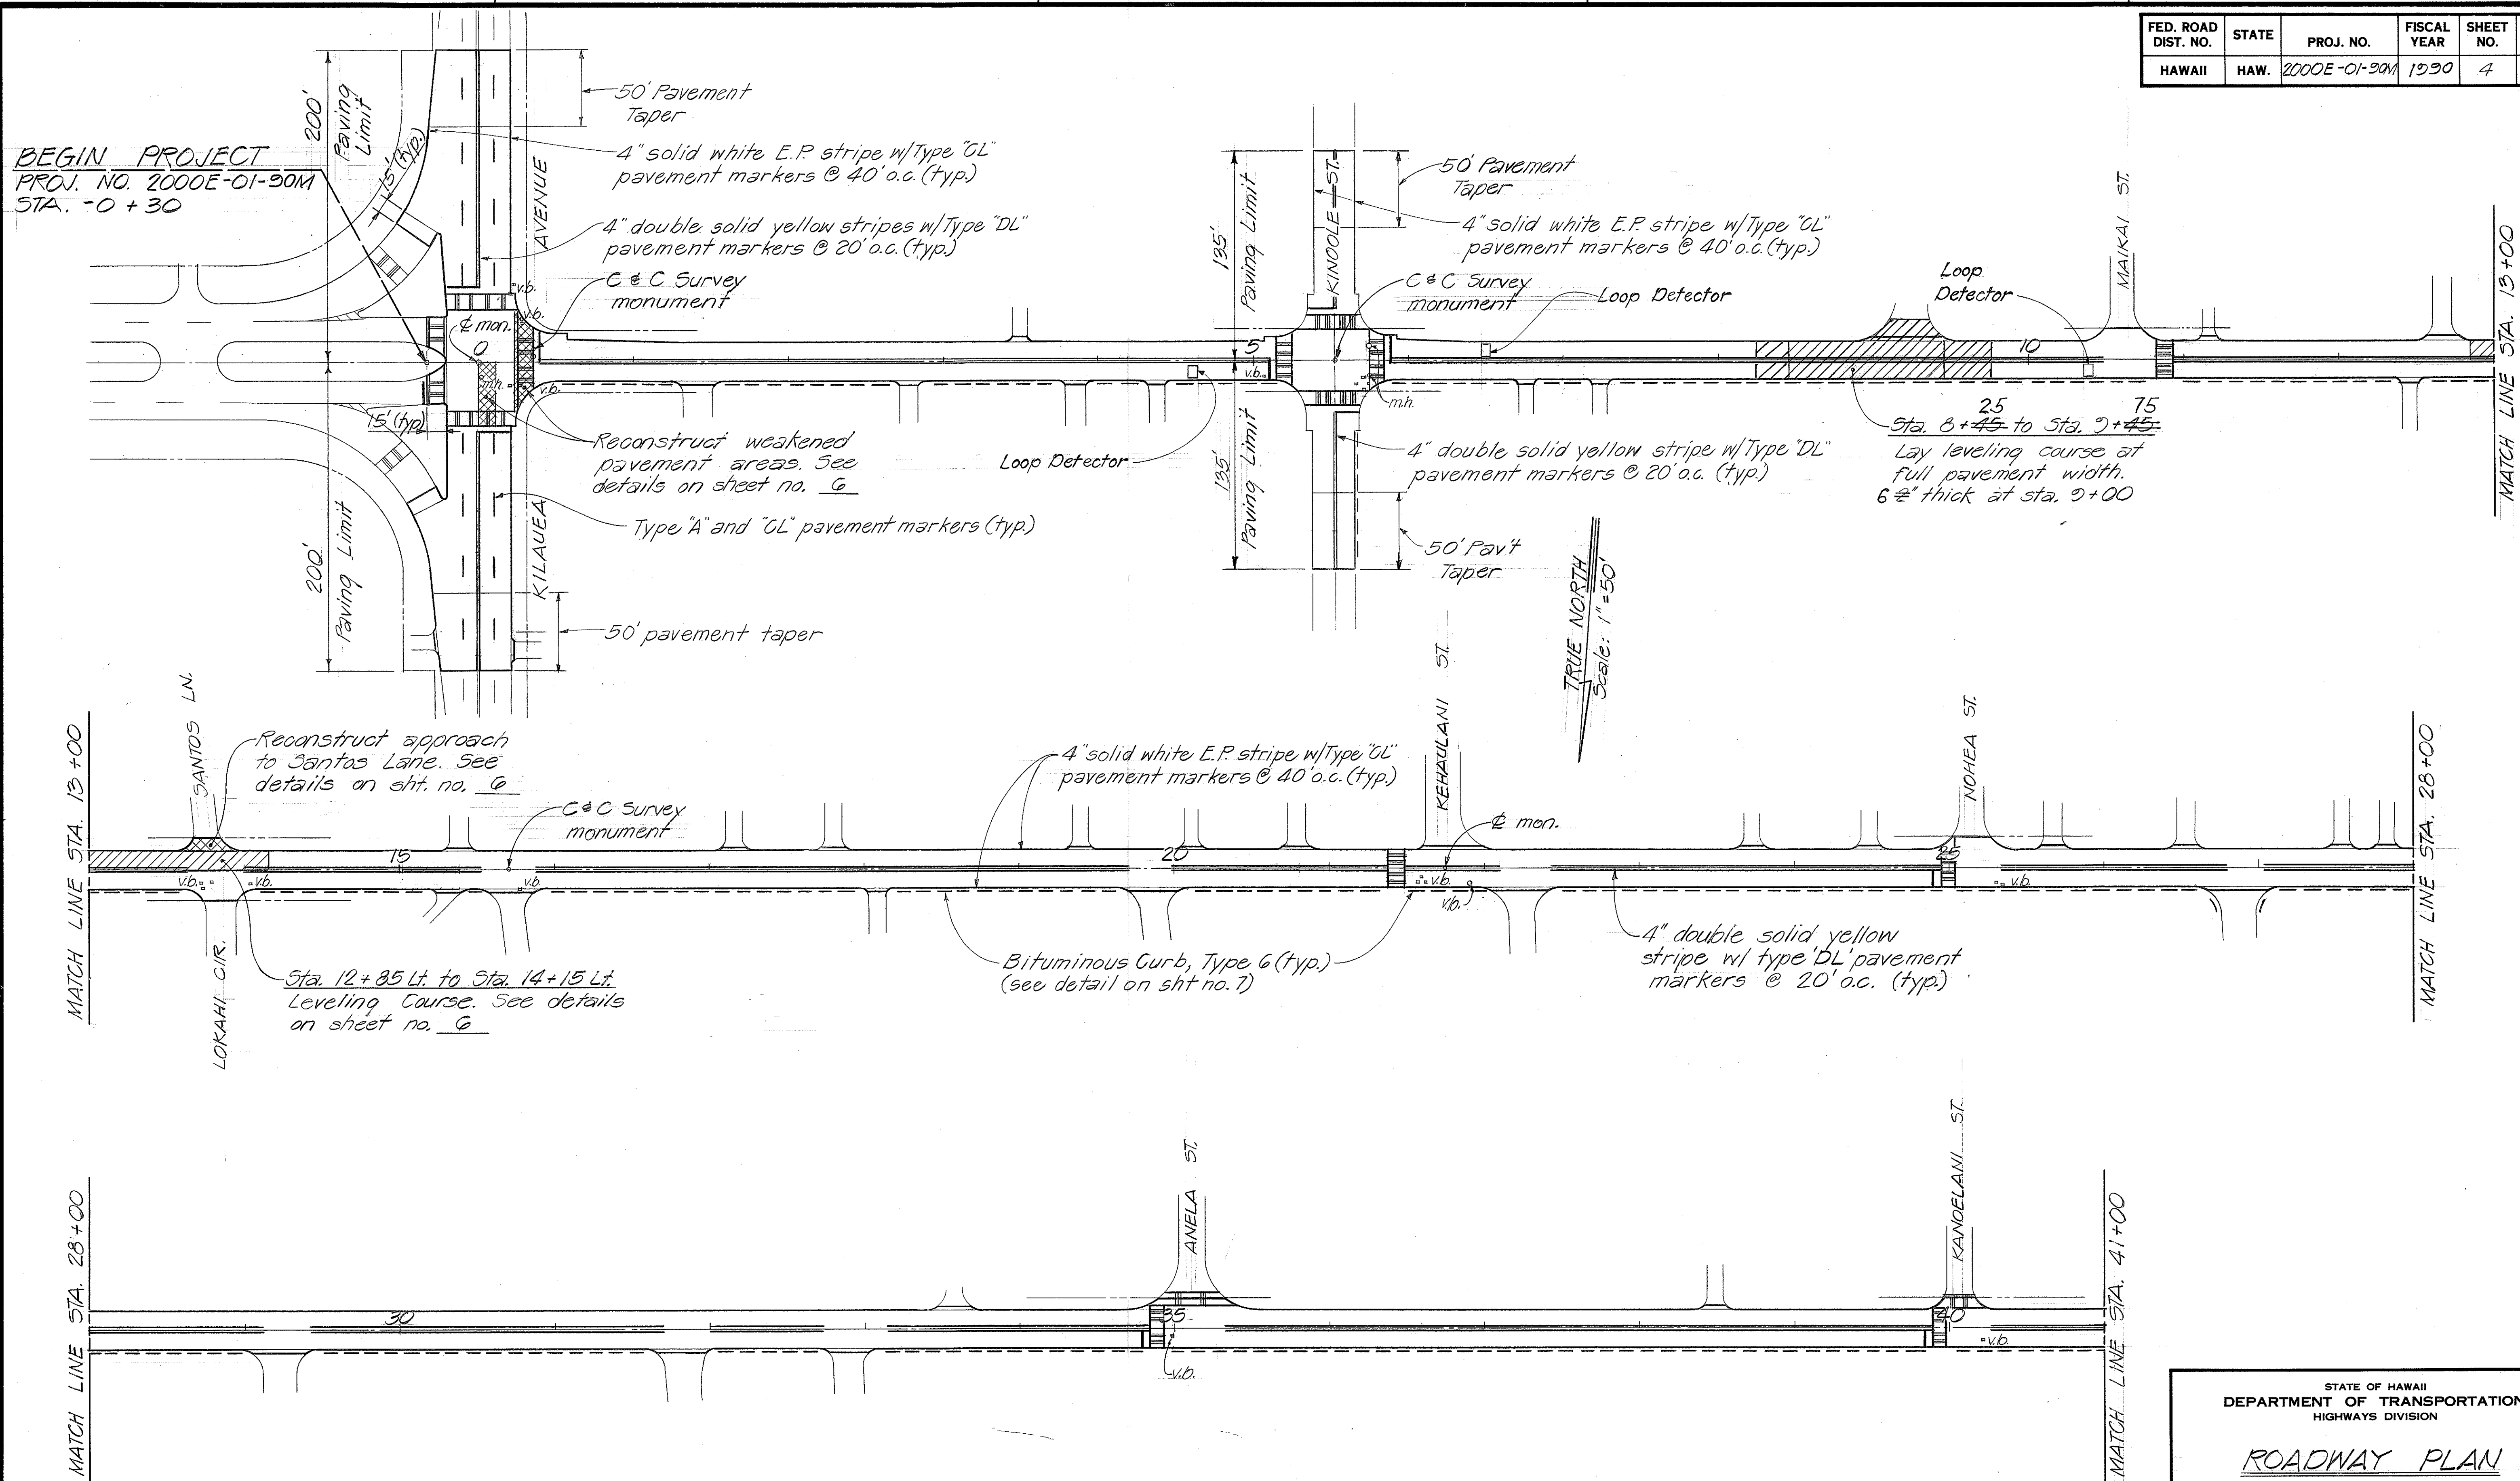

SURVEY PLOTTED BY	DATE
DRAWN BY	
DESIGNED BY	
QUANTITIES BY	
CHECKED BY	
ORIGINAL PLAN	
NOTE BOOK	
NO.	

STATE OF HAWAII
 DEPARTMENT OF TRANSPORTATION
 HIGHWAYS DIVISION


ROADWAY PLAN

PUAINAKO STREET RESURFACING
 KILAUEA AVENUE TO KOMOHANA STREET
 PROJ. NO. 2000E-01-30M

Scale: 1" = 50' Date: March 1990

SHEET No. 1 OF 2 SHEETS

FED. ROAD DIST. NO.	STATE	PROJ. NO.	FISCAL YEAR	SHEET NO.	TOTAL SHEETS
HAWAII	HAW.	2000E-01-90M	1990	5	8

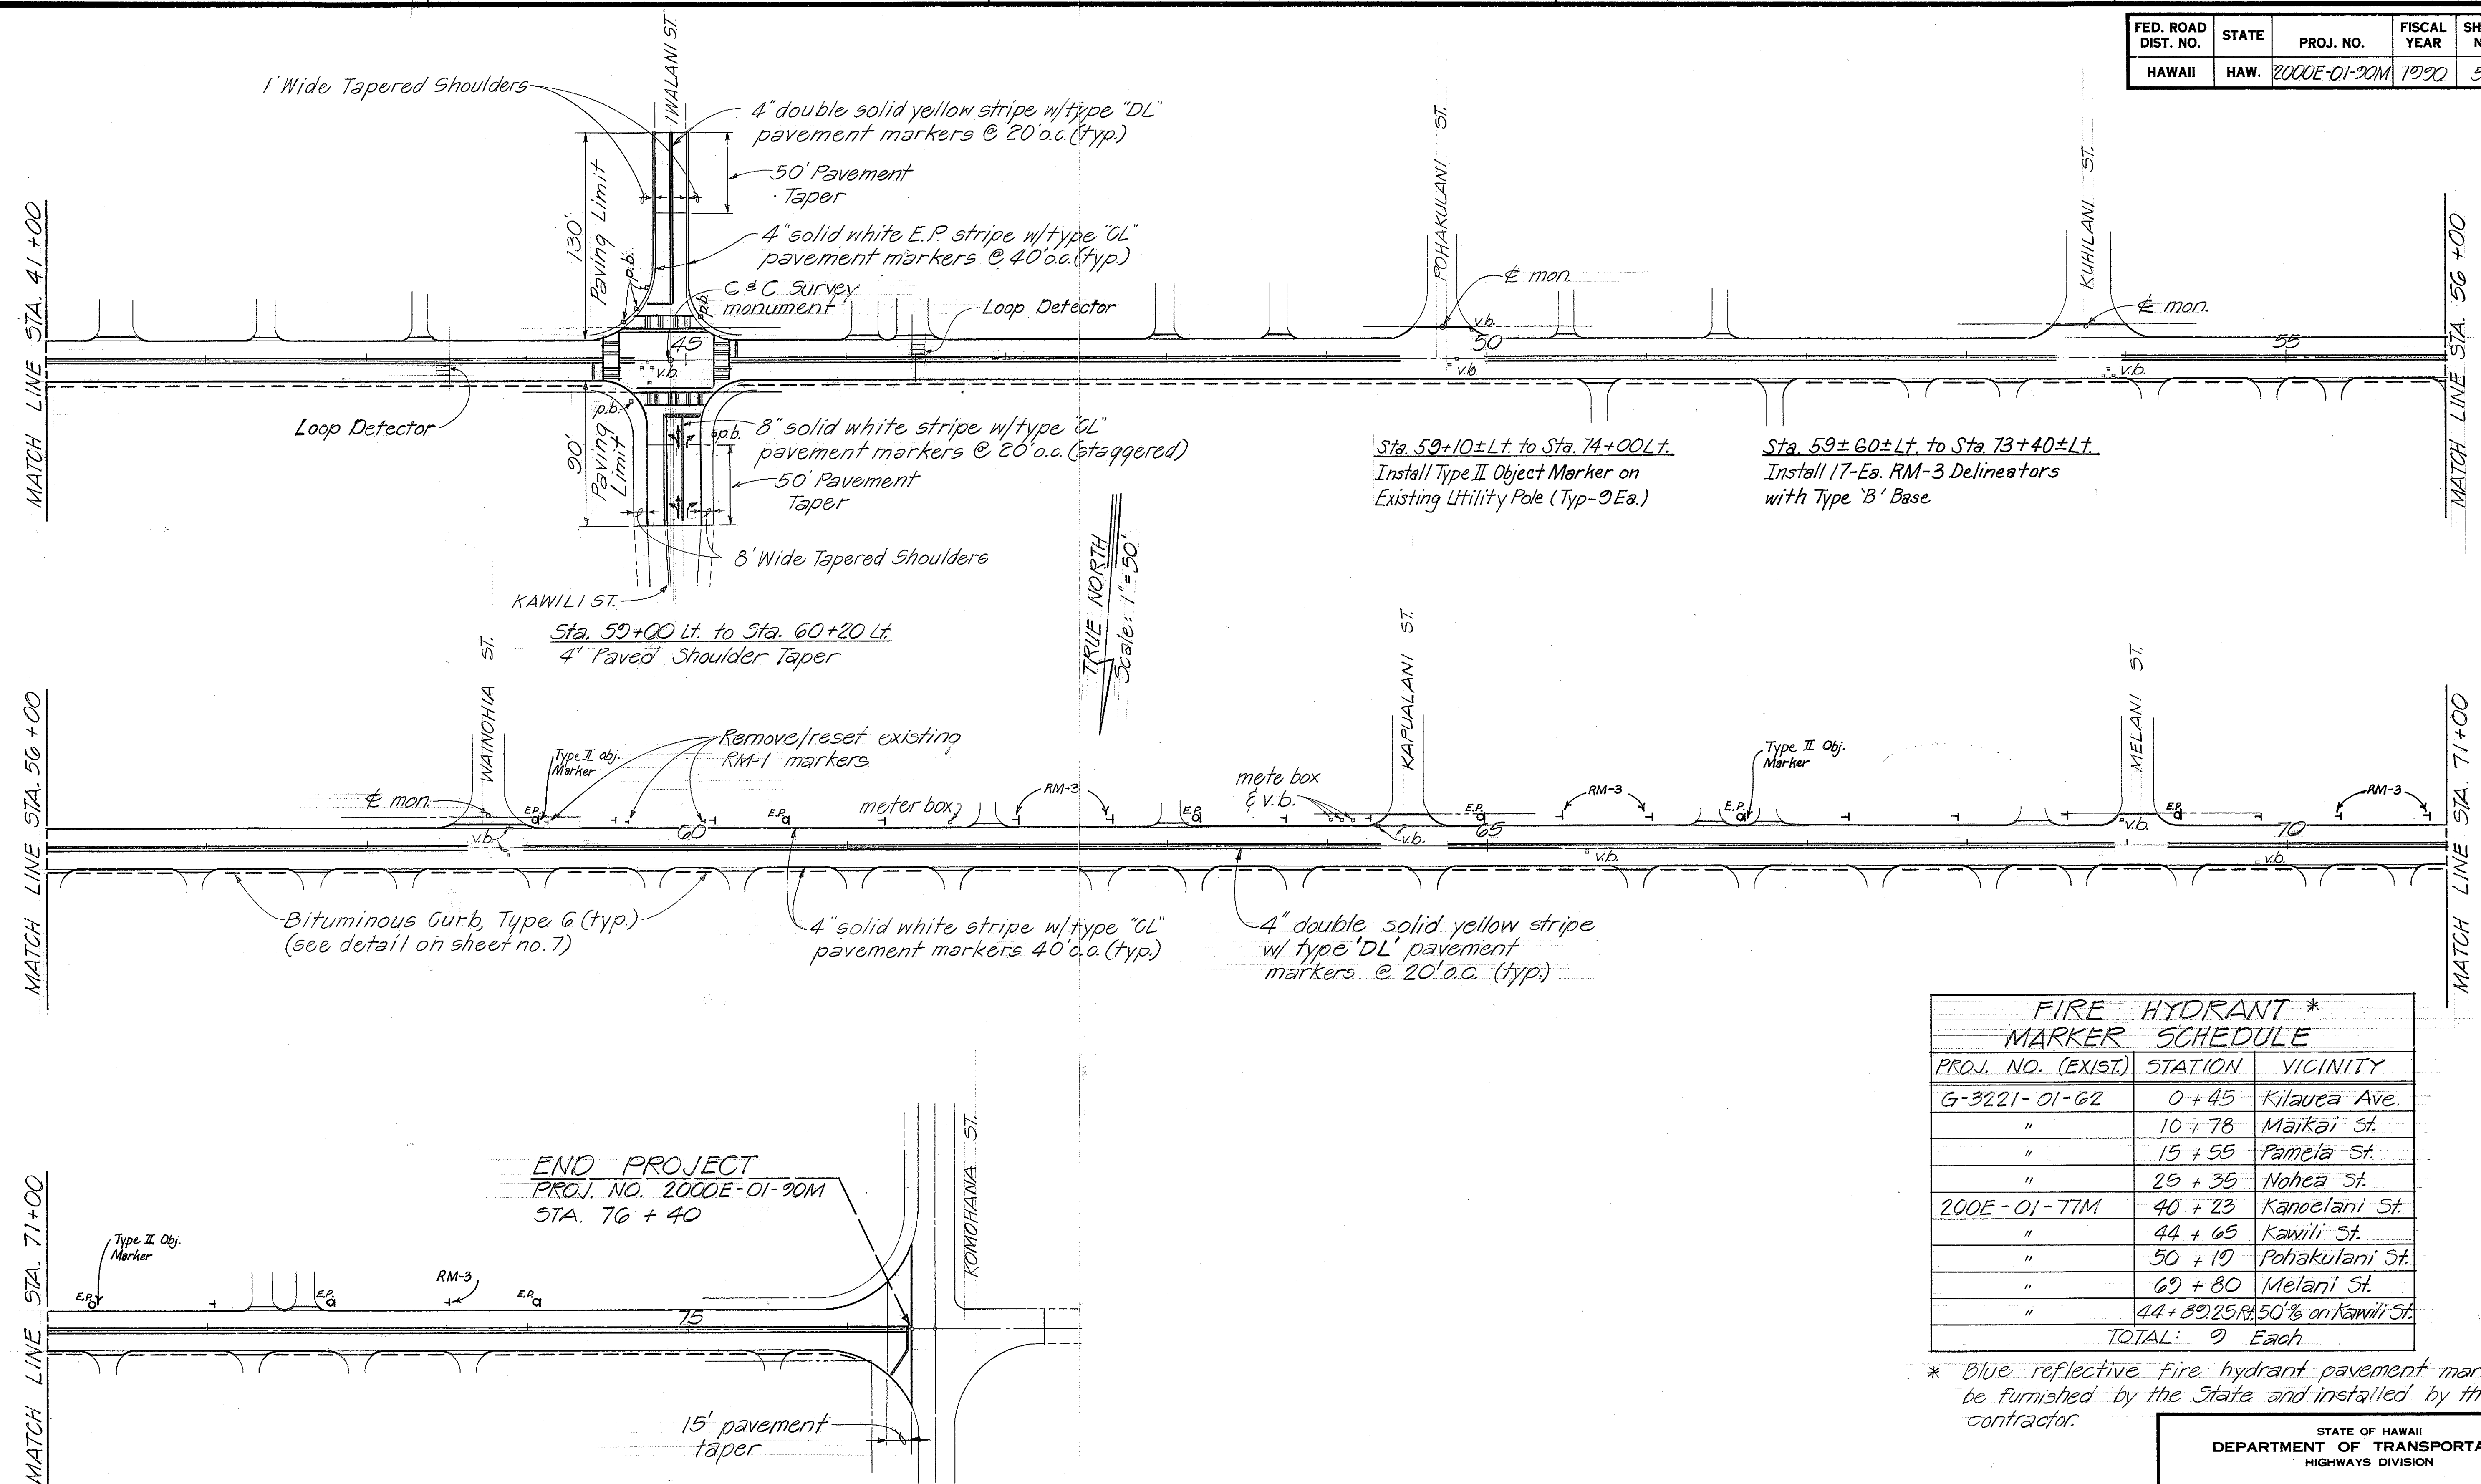

FIRE HYDRANT * MARKER SCHEDULE		
PROJ. NO. (EXIST)	STATION	VICINITY
G-3221-01-62	0 + 45	Kilauea Ave.
"	10 + 78	Maikai St.
"	15 + 55	Pamela St.
"	25 + 35	Nohea St.
200E-01-77M	40 + 23	Kanoelani St.
"	44 + 65	Kawili St.
"	50 + 19	Pohakulani St.
"	69 + 80	Melani St.
"	44 + 89.25	50' E on Kawili St.
TOTAL: 9 Each		

* Blue reflective fire hydrant pavement markers to be furnished by the State and installed by the contractor.

STATE OF HAWAII
DEPARTMENT OF TRANSPORTATION
HIGHWAYS DIVISION

ROADWAY PLAN
PUIAINAKO STREET RESURFACING
KILAUEA AVENUE TO KOMOHANA STREET
PROJ. NO. 2000E-01-90M
Scale: 1" = 50' Date: Aug. 1986
SHEET NO. 2 OF 2 SHEETS

SURVEY PLOTTED BY	DATE
DRAWN BY	
TRACED BY	
QUANTITIES BY	
CHECKED BY	
ORIGINAL PLAN	
NOTE BOOK	
NO.	