



[illegible]

STATE OF HAWAII
DEPARTMENT OF TRANSPORTATION
HIGHWAYS DIVISION
"AS-BUILT"
PLANS FOR
PUAINAKO STREET RESURFACING
KILAUEA AVENUE TO KOMOHANA STREET
PROJECT NO. 2000E-01-90M
DISTRICT OF SOUTH HILO
ISLAND OF HAWAII

FED. ROAD DIST. NO.	STATE	PROJ. NO.	FISCAL YEAR	SHEET NO.	TOTAL SHEETS
HAWAII	HAW.	2000E-01-90M	1990	1	8

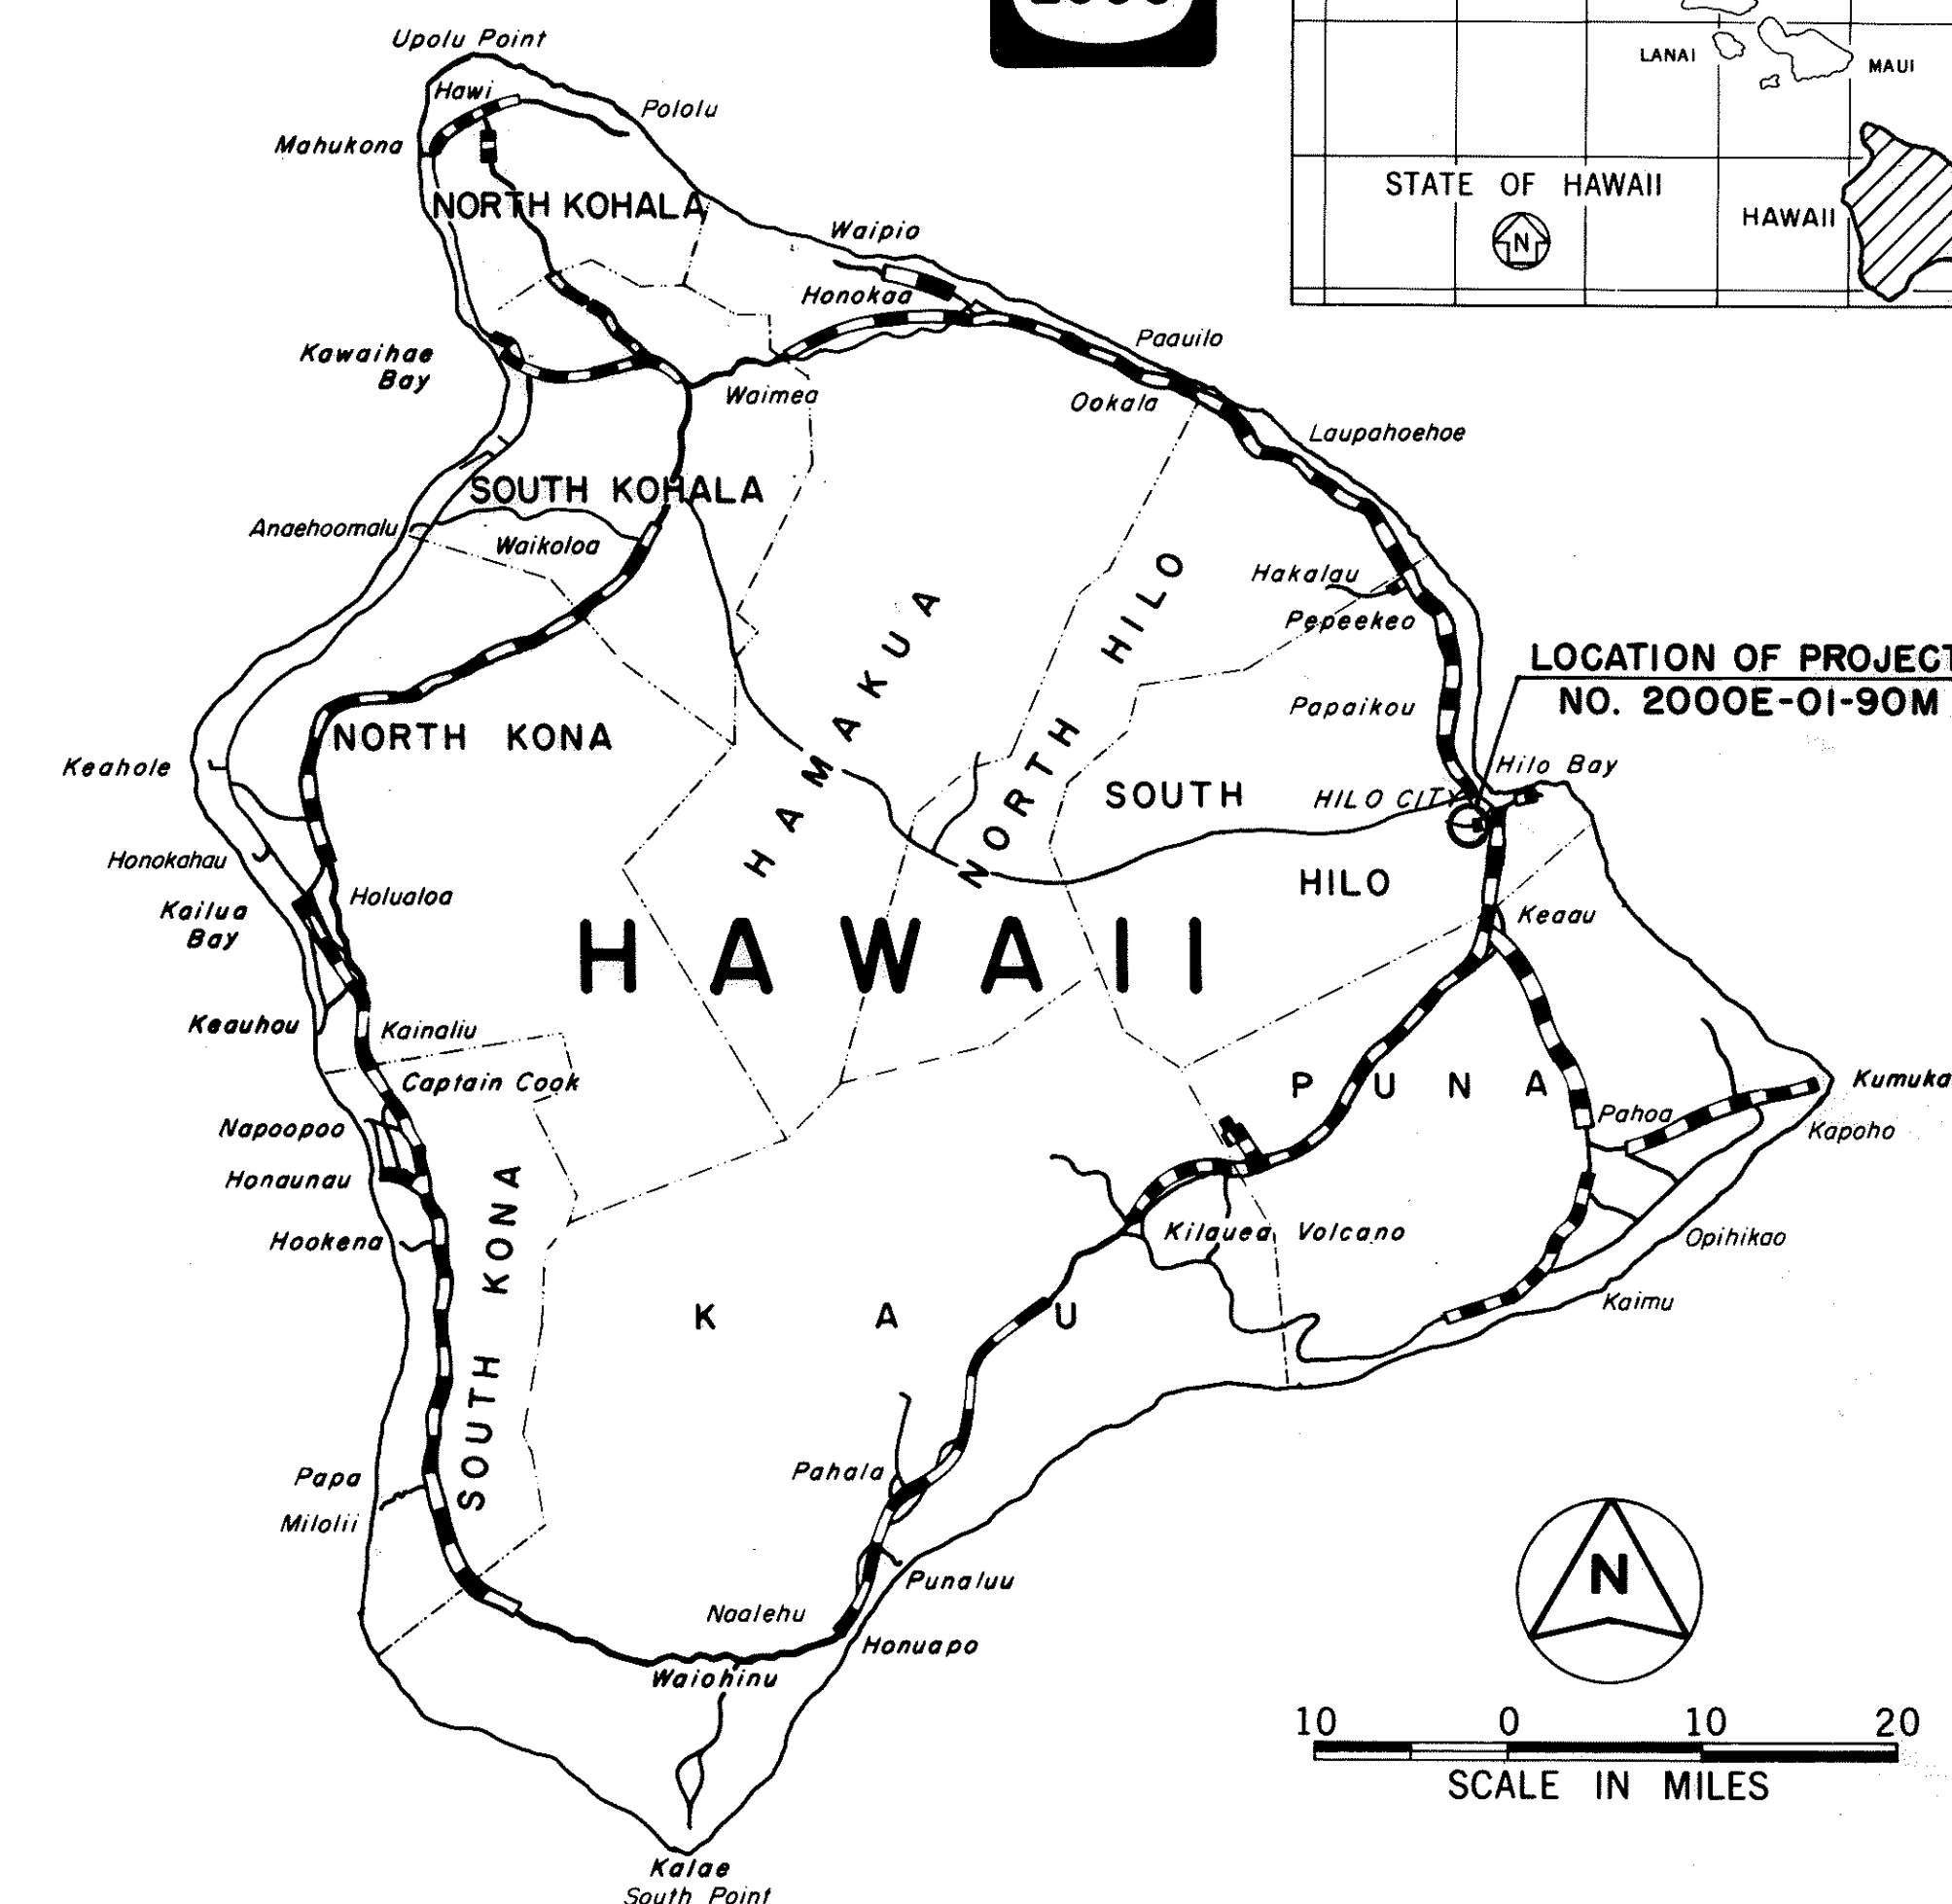

CHANGES MADE DURING CONSTRUCTION HAVE
BEEN INCORPORATED ON THESE PLANS EXCEPT
CHANGES IN THE ORIGINAL THEORETICAL
QUANTITIES. FOR ACTUAL QUANTITIES, REFER TO
PROJECT LEDGER AND/OR COMPUTATION BOOK.

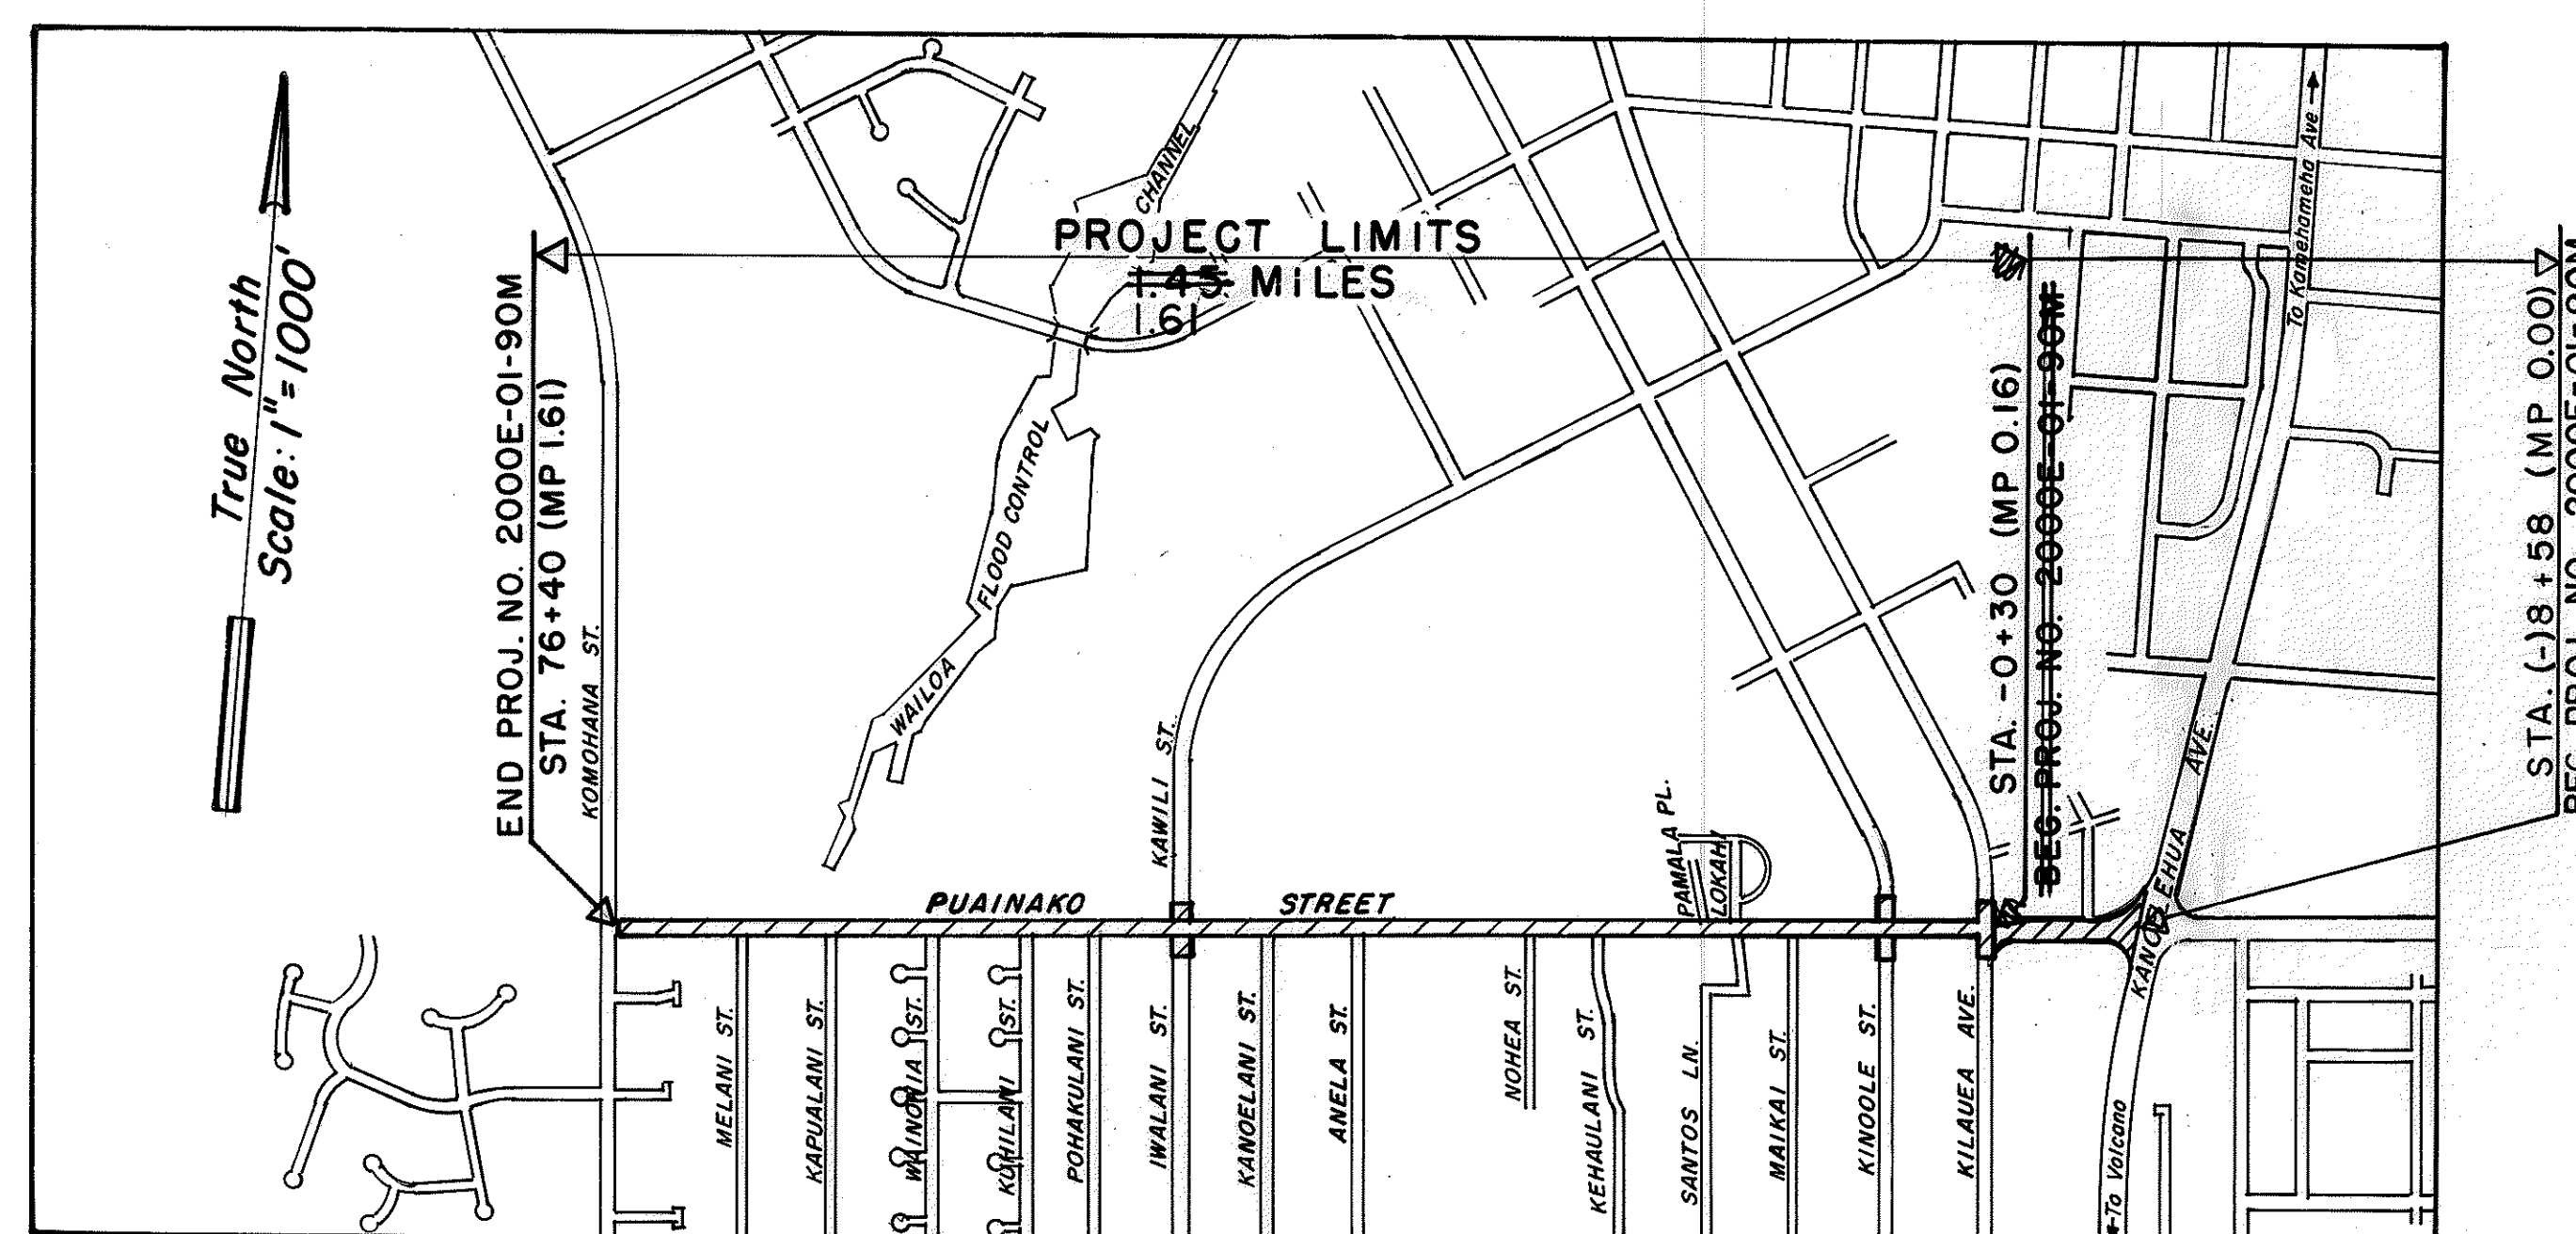

LAYOUT OF PROJECT

DEPARTMENT OF TRANSPORTATION STATE OF HAWAII	
APPROVED: <i>Edward J. Smith</i>	5/7/90
DIRECTOR OF TRANSPORTATION	DATE

HAWAII DISTRICT
DESIGNED BY
R. TAKAESU
P. S. & E. BY
548-4125
PHONE
04-30-90
DATE