




INDEX TO DRAWINGS	
SHEET NO.	DESCRIPTION
1	TITLE SHEET
2	STANDARD PLANS SUMMARY
3	GENERAL NOTES
4	TYPICAL SECTION AND DETAILS
5	ROADWAY PLAN
6	CONSTRUCTION SIGN PLAN & SCHEDULE

STATE OF HAWAII
DEPARTMENT OF TRANSPORTATION
HIGHWAYS DIVISION
HONOLULU, HAWAII
"AS-BUILT"
PLANS FOR
PUAINAKO STREET WHITE-TOPPING
VICINITY OF IWALANI STREET
PROJECT NO. 2000E-02-00M
DISTRICT OF SOUTH HILO
ISLAND OF HAWAII

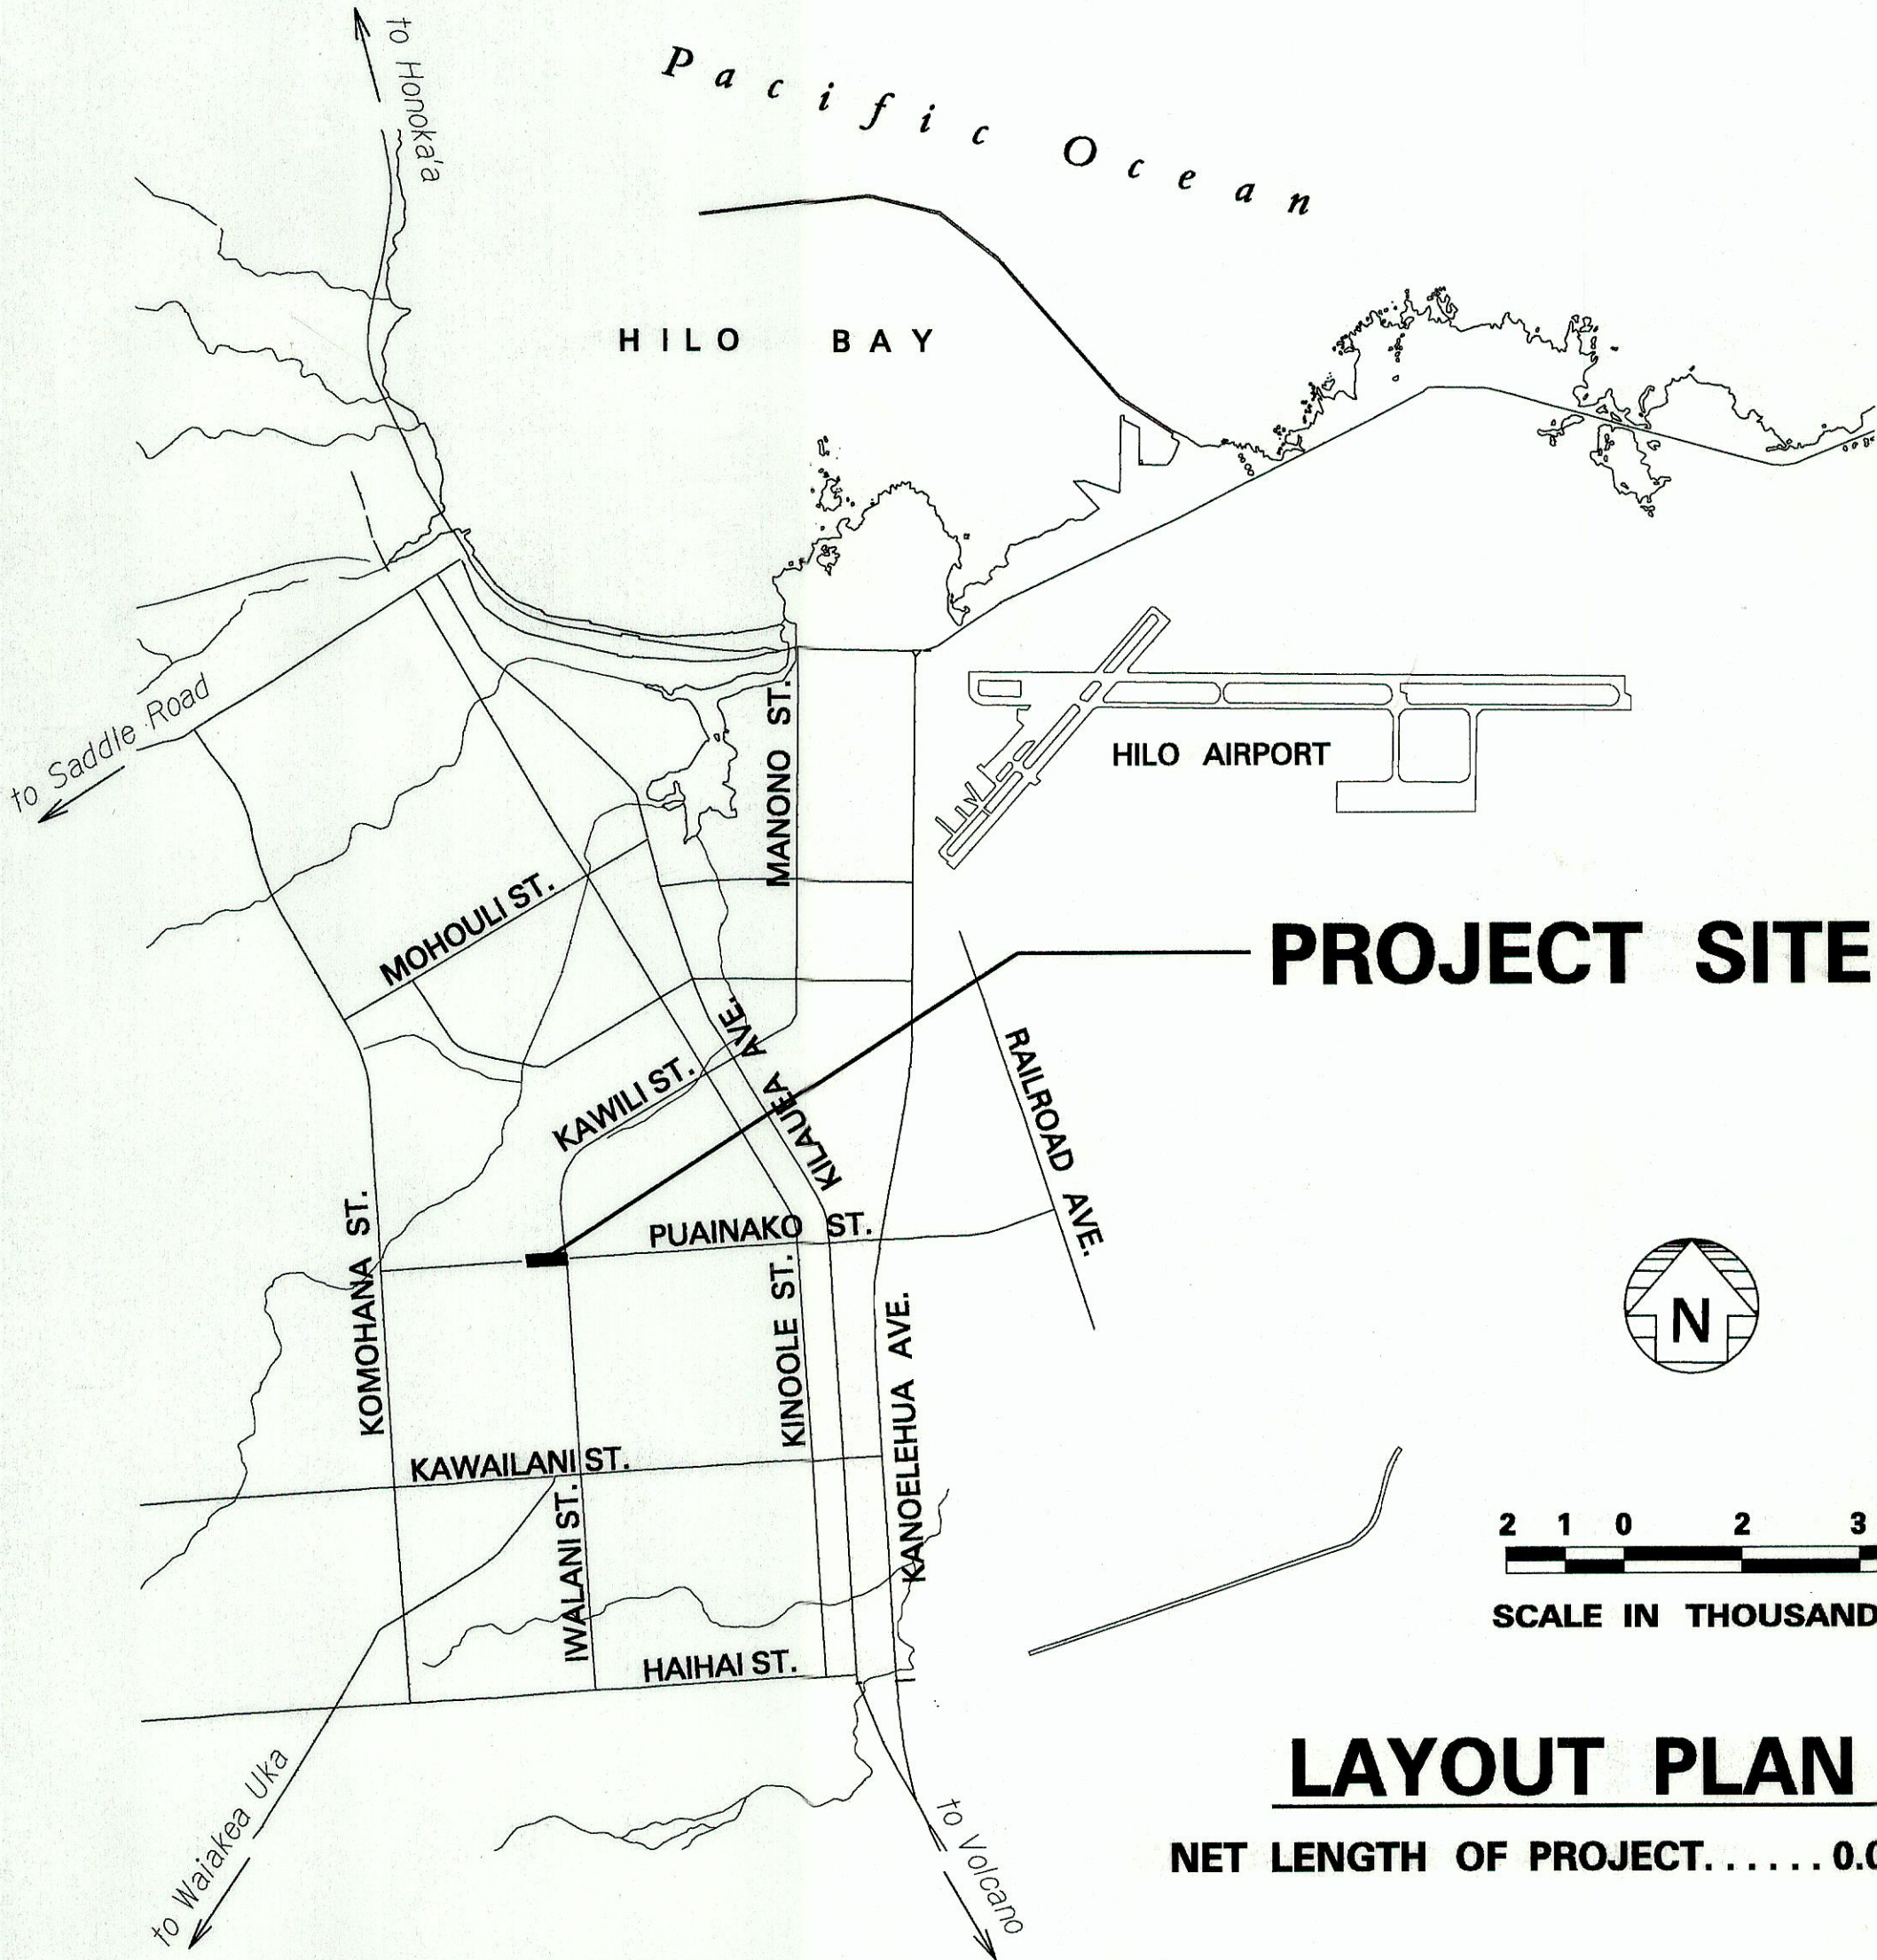

LAYOUT PLAN
NET LENGTH OF PROJECT..... 0.09 MILES

FED. ROAD DIST. NO.	STATE	PROJ. NO.	FISCAL YEAR	SHEET NO.	TOTAL SHEETS
HAWAII	HAW.	2000E-02-00M	2000	1	6

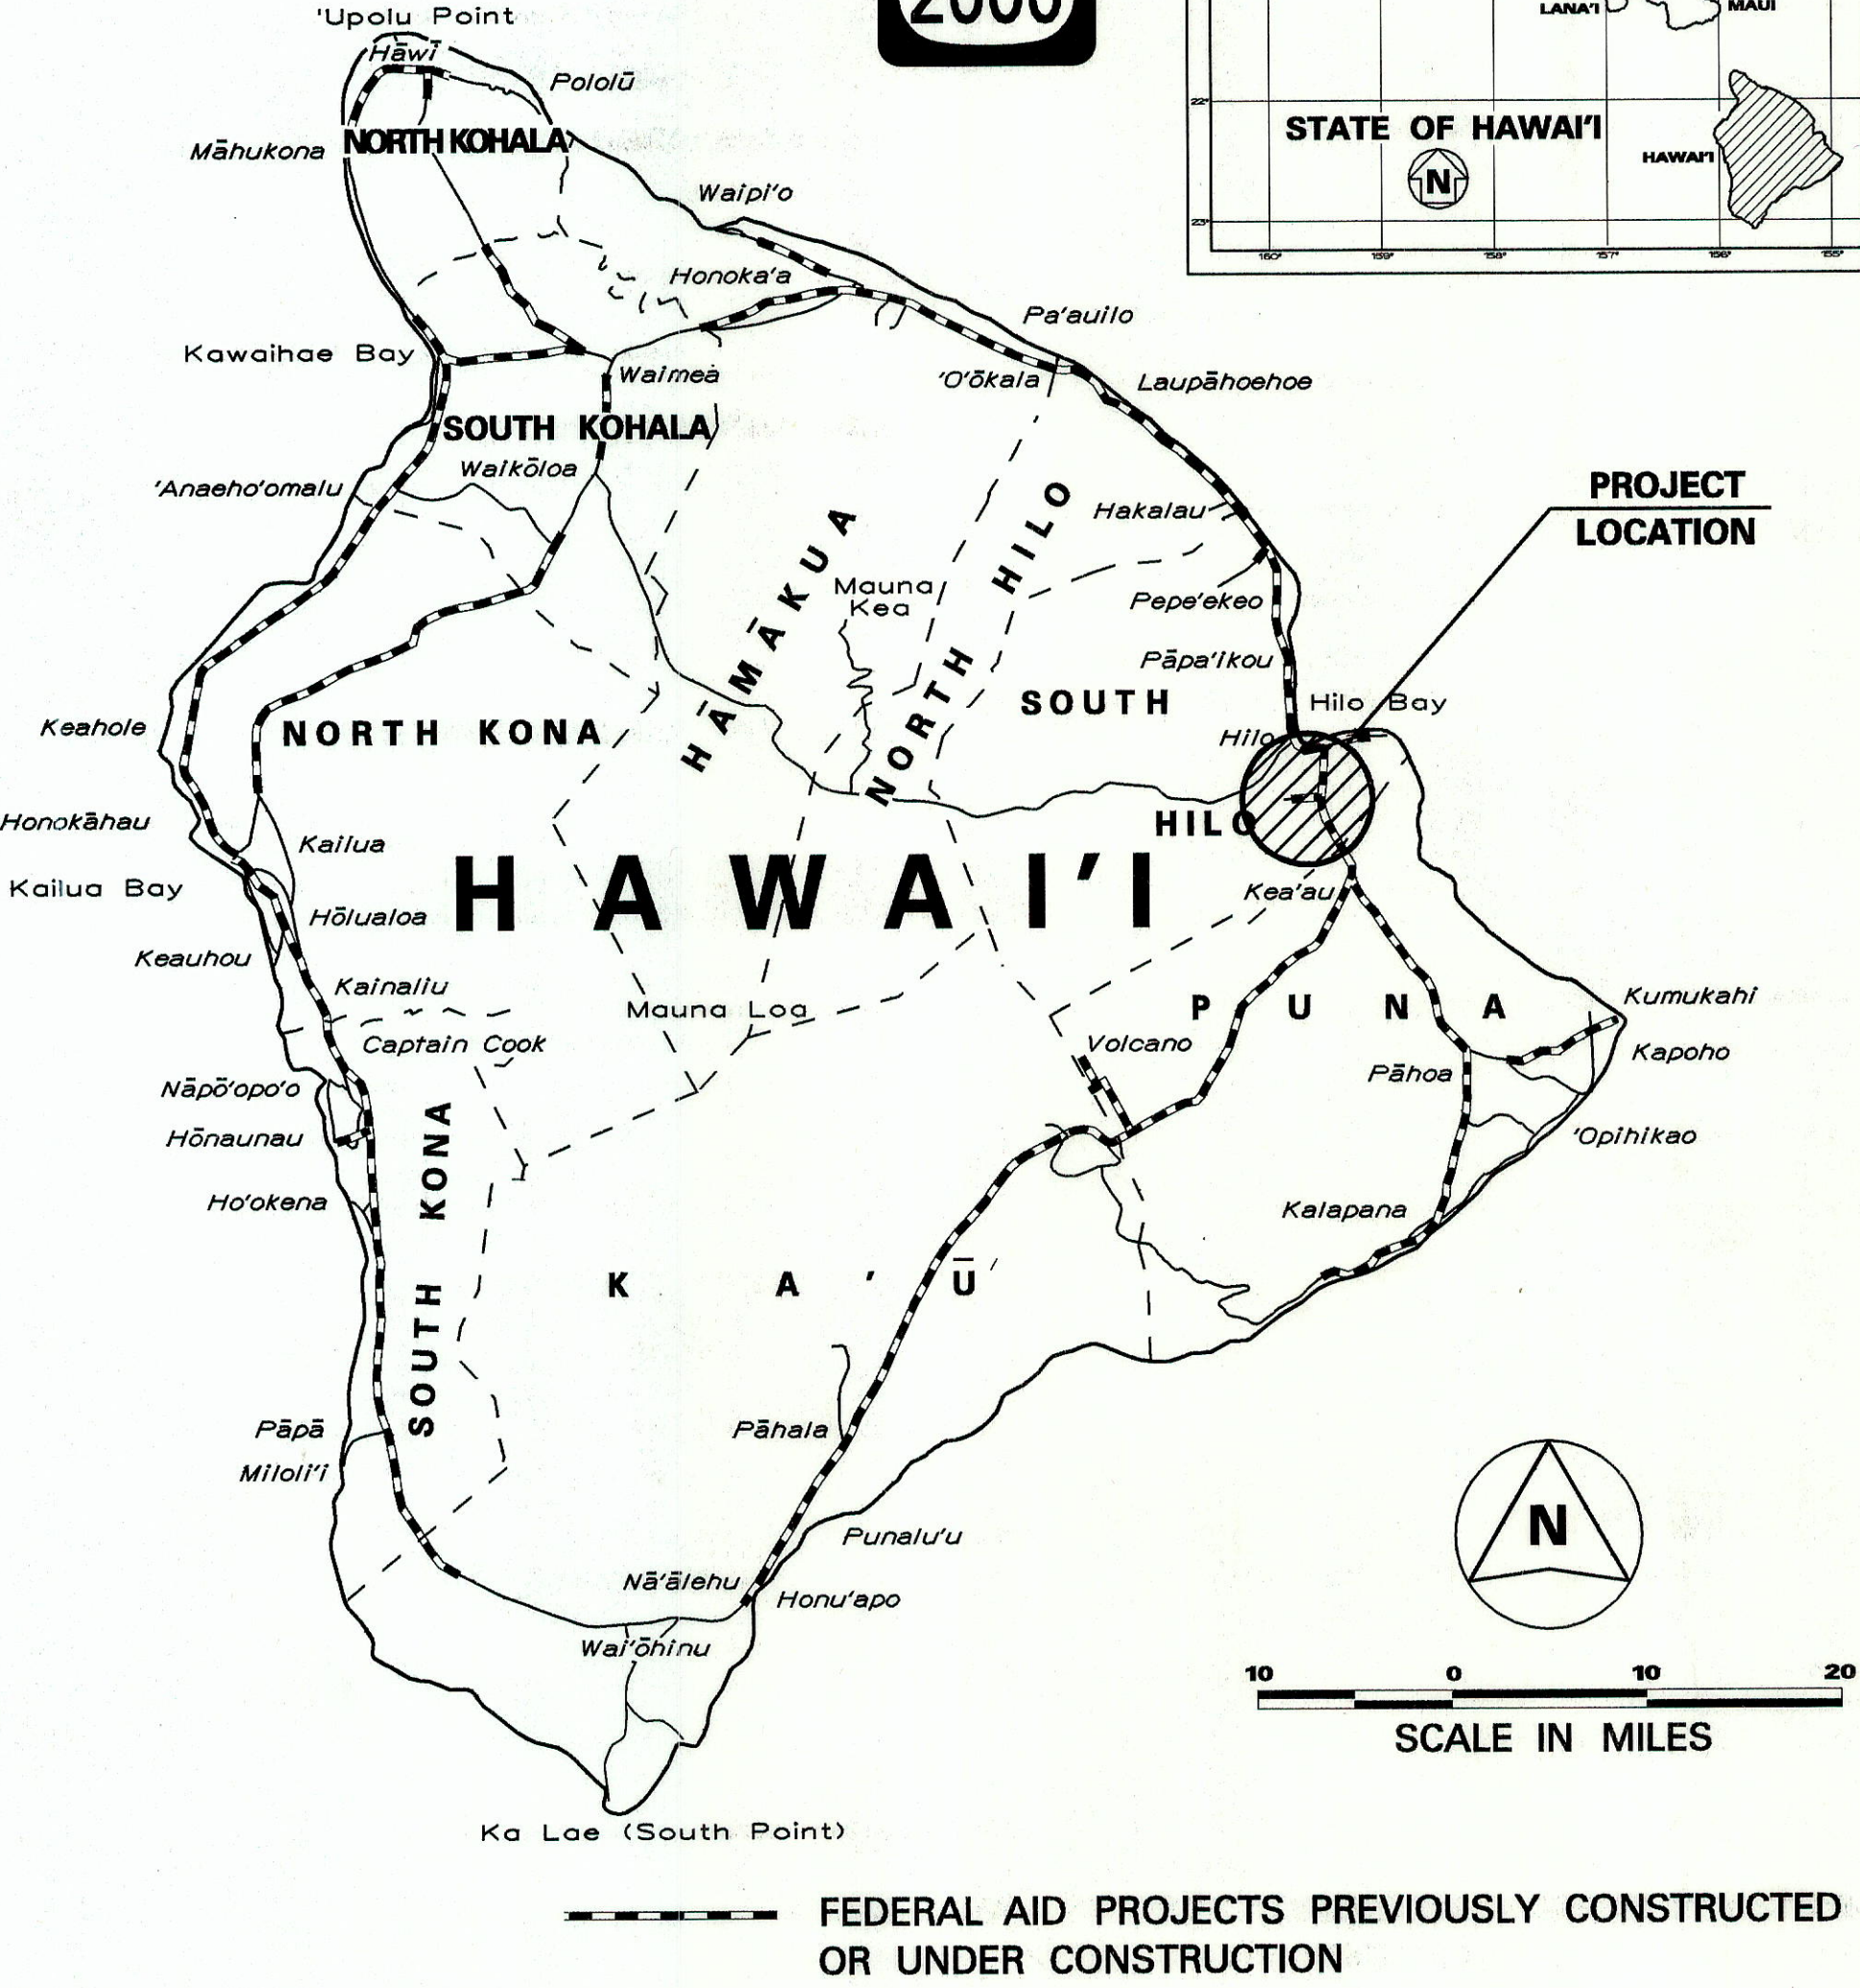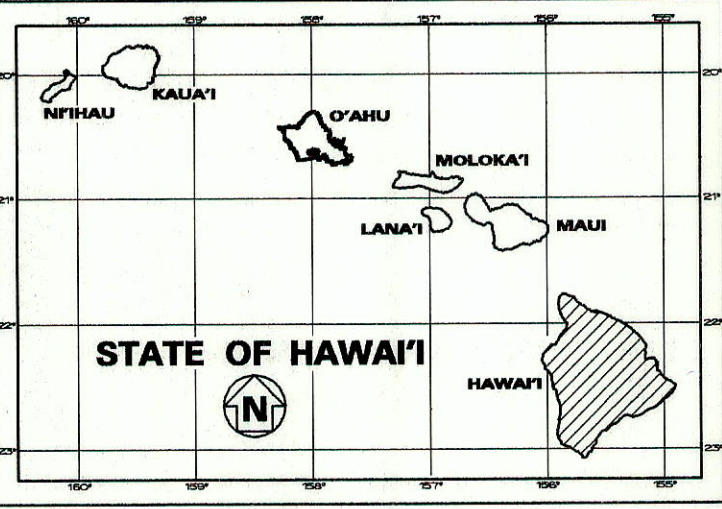

MILE POST 1.02

CHANGES MADE DURING CONSTRUCTION HAVE BEEN INCORPORATED ON THESE PLANS EXCEPT CHANGES IN THE ORIGINAL THEORETICAL QUANTITIES. FOR ACTUAL QUANTITIES, REFER TO PROJECT LEDGER AND/OR COMPUTATION BOOK.
3/14/02 2-14-02
RESIDENT ENGINEER DATE

DEPARTMENT OF TRANSPORTATION
STATE OF HAWAII
APPROVED: 5/14/02
DIR. OF TRANSPORTATION DATE

HAWAII DISTRICT DESIGNED BY ROBERT TAJRA P.S. & E. BY 933-8866 PHONE May 2000 DATE