	INDEX TO DRAWINGS					
SHEET NO.	DESCRIPTION					
1	TITLE SHEET					
2	SITE PLAN, ROOF PLAN AND					
	MISCELLANEOUS DETAILS					
-						

	` `					



STATE OF HAWAII

DEPARTMENT OF TRANSPORTATION
HIGHWAYS DIVISION
"AS-BUILT"


PLANS FOR

REROOFING BUILDINGS AT KAPAA BASEYARD

PROJECT NO. HWY-K-02-83M


DISTRICT OF KAWAIHAU

ISLAND OF KAUAI

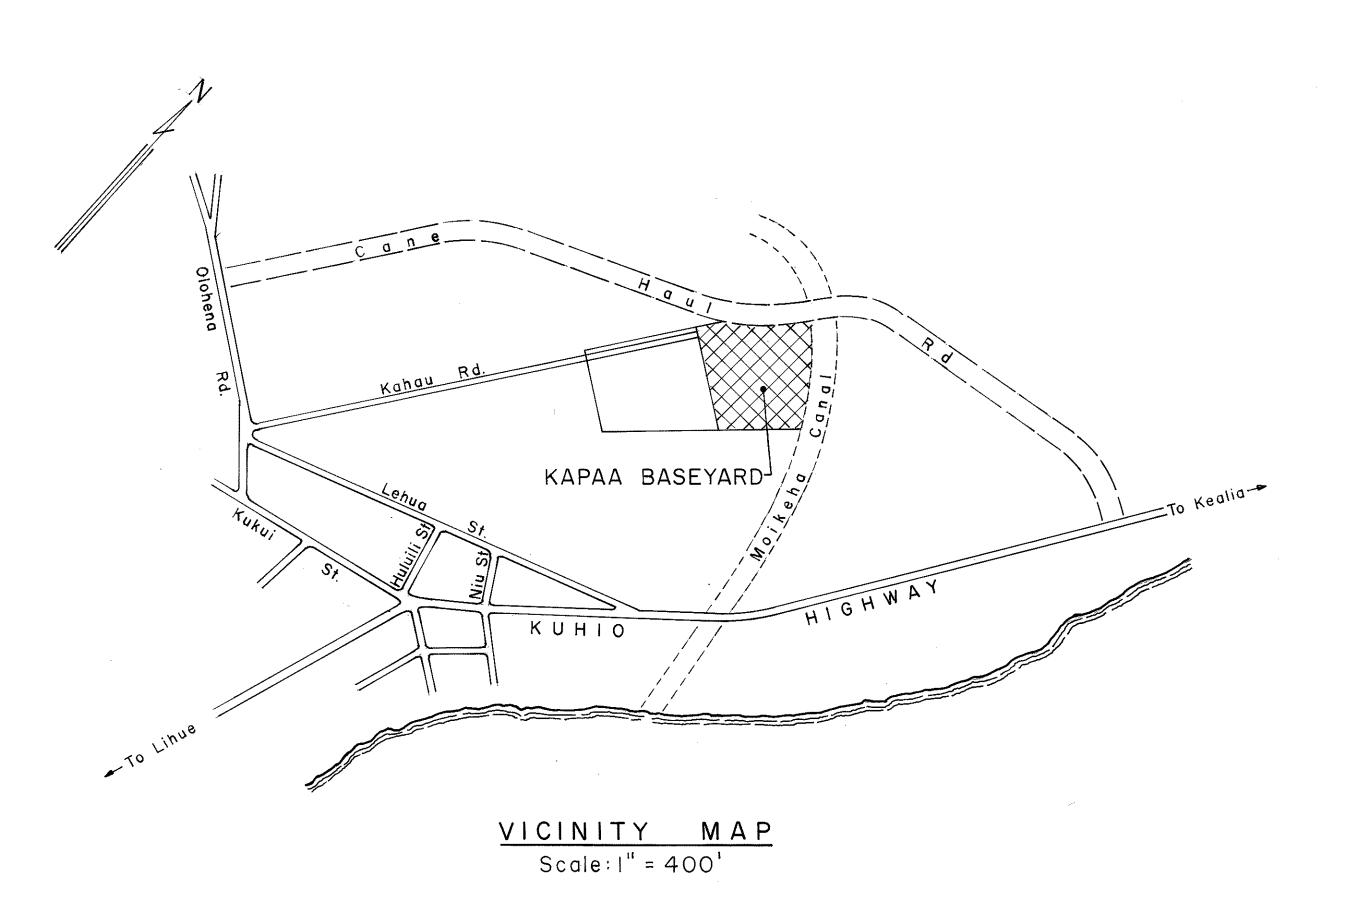


FED. ROAD DIST. NO. STATE PROJ. NO. FISCAL SHEET NO. SHEETS

HAWAII HAW. HWY-K-02-83M 1983 1 2

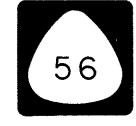

j (2				
NIHAU	KAUA	ا، کسہ	OAHU		with the state of
			~ ~ ~	MOLOKAI	
			LANAI	5	MAUI
				,	5
	STATE	OF H	AWAII	(<i>/</i>
				HAWAII	
		***************************************			トヘノ

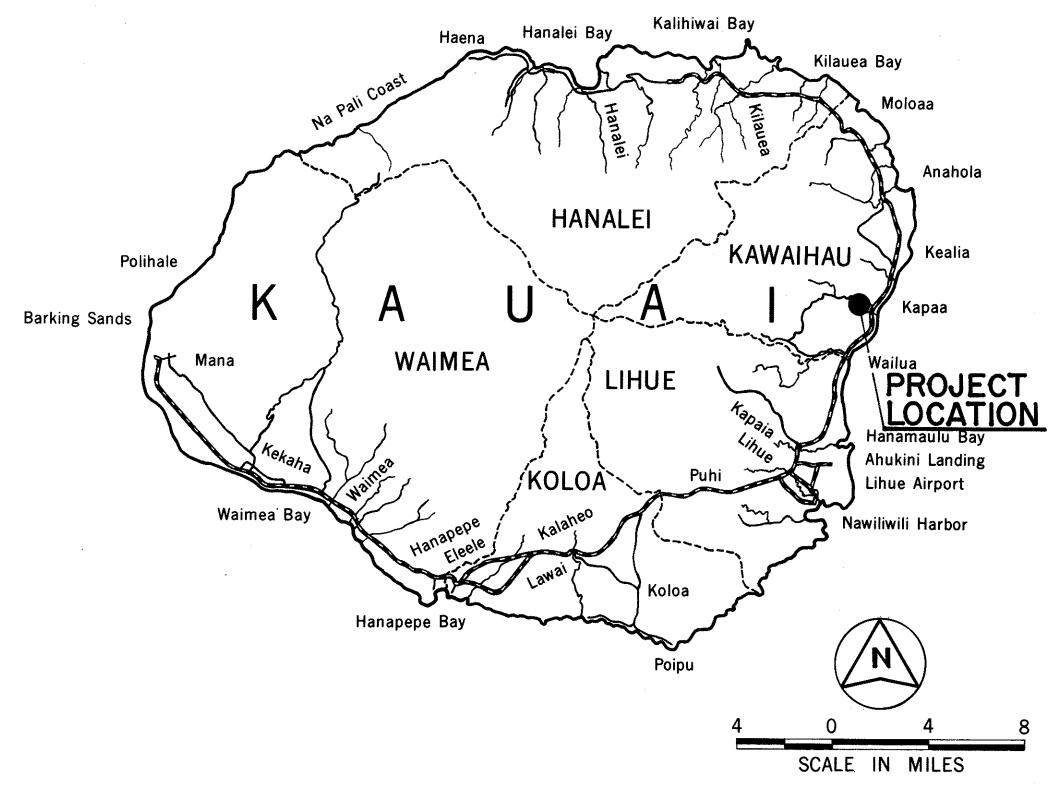

FEDERAL AID PROJECTS PREVIOUSLY CONSTRUCTED
OR UNDER CONSTRUCTION

CHANGES MADE DURING CONSTRUCTION HAVE BEEN NOTED ON THESE PLANS AND CHECKED BY:

Donald Magamine RESIDENT ENGINEER

3-6-84 DATE

DEPARTMENT OF TRANSPORTATION
STATE OF HAWAII

APPROVED:

Argorhion 3/29/83

DIR. OF TRANSPORTATION DATE

KAUAI DISTRICT A. Nishimura 548-7490
DESIGNED BY P. S. & E. BY PHONE

Apr., 1983 DATE