




FED. ROAD DIST. NO.	STATE	PROJ. NO.	FISCAL YEAR	SHEET NO.	TOTAL SHEETS
HAWAII	HAW.	HWY-K-01-94M	1994	8	10

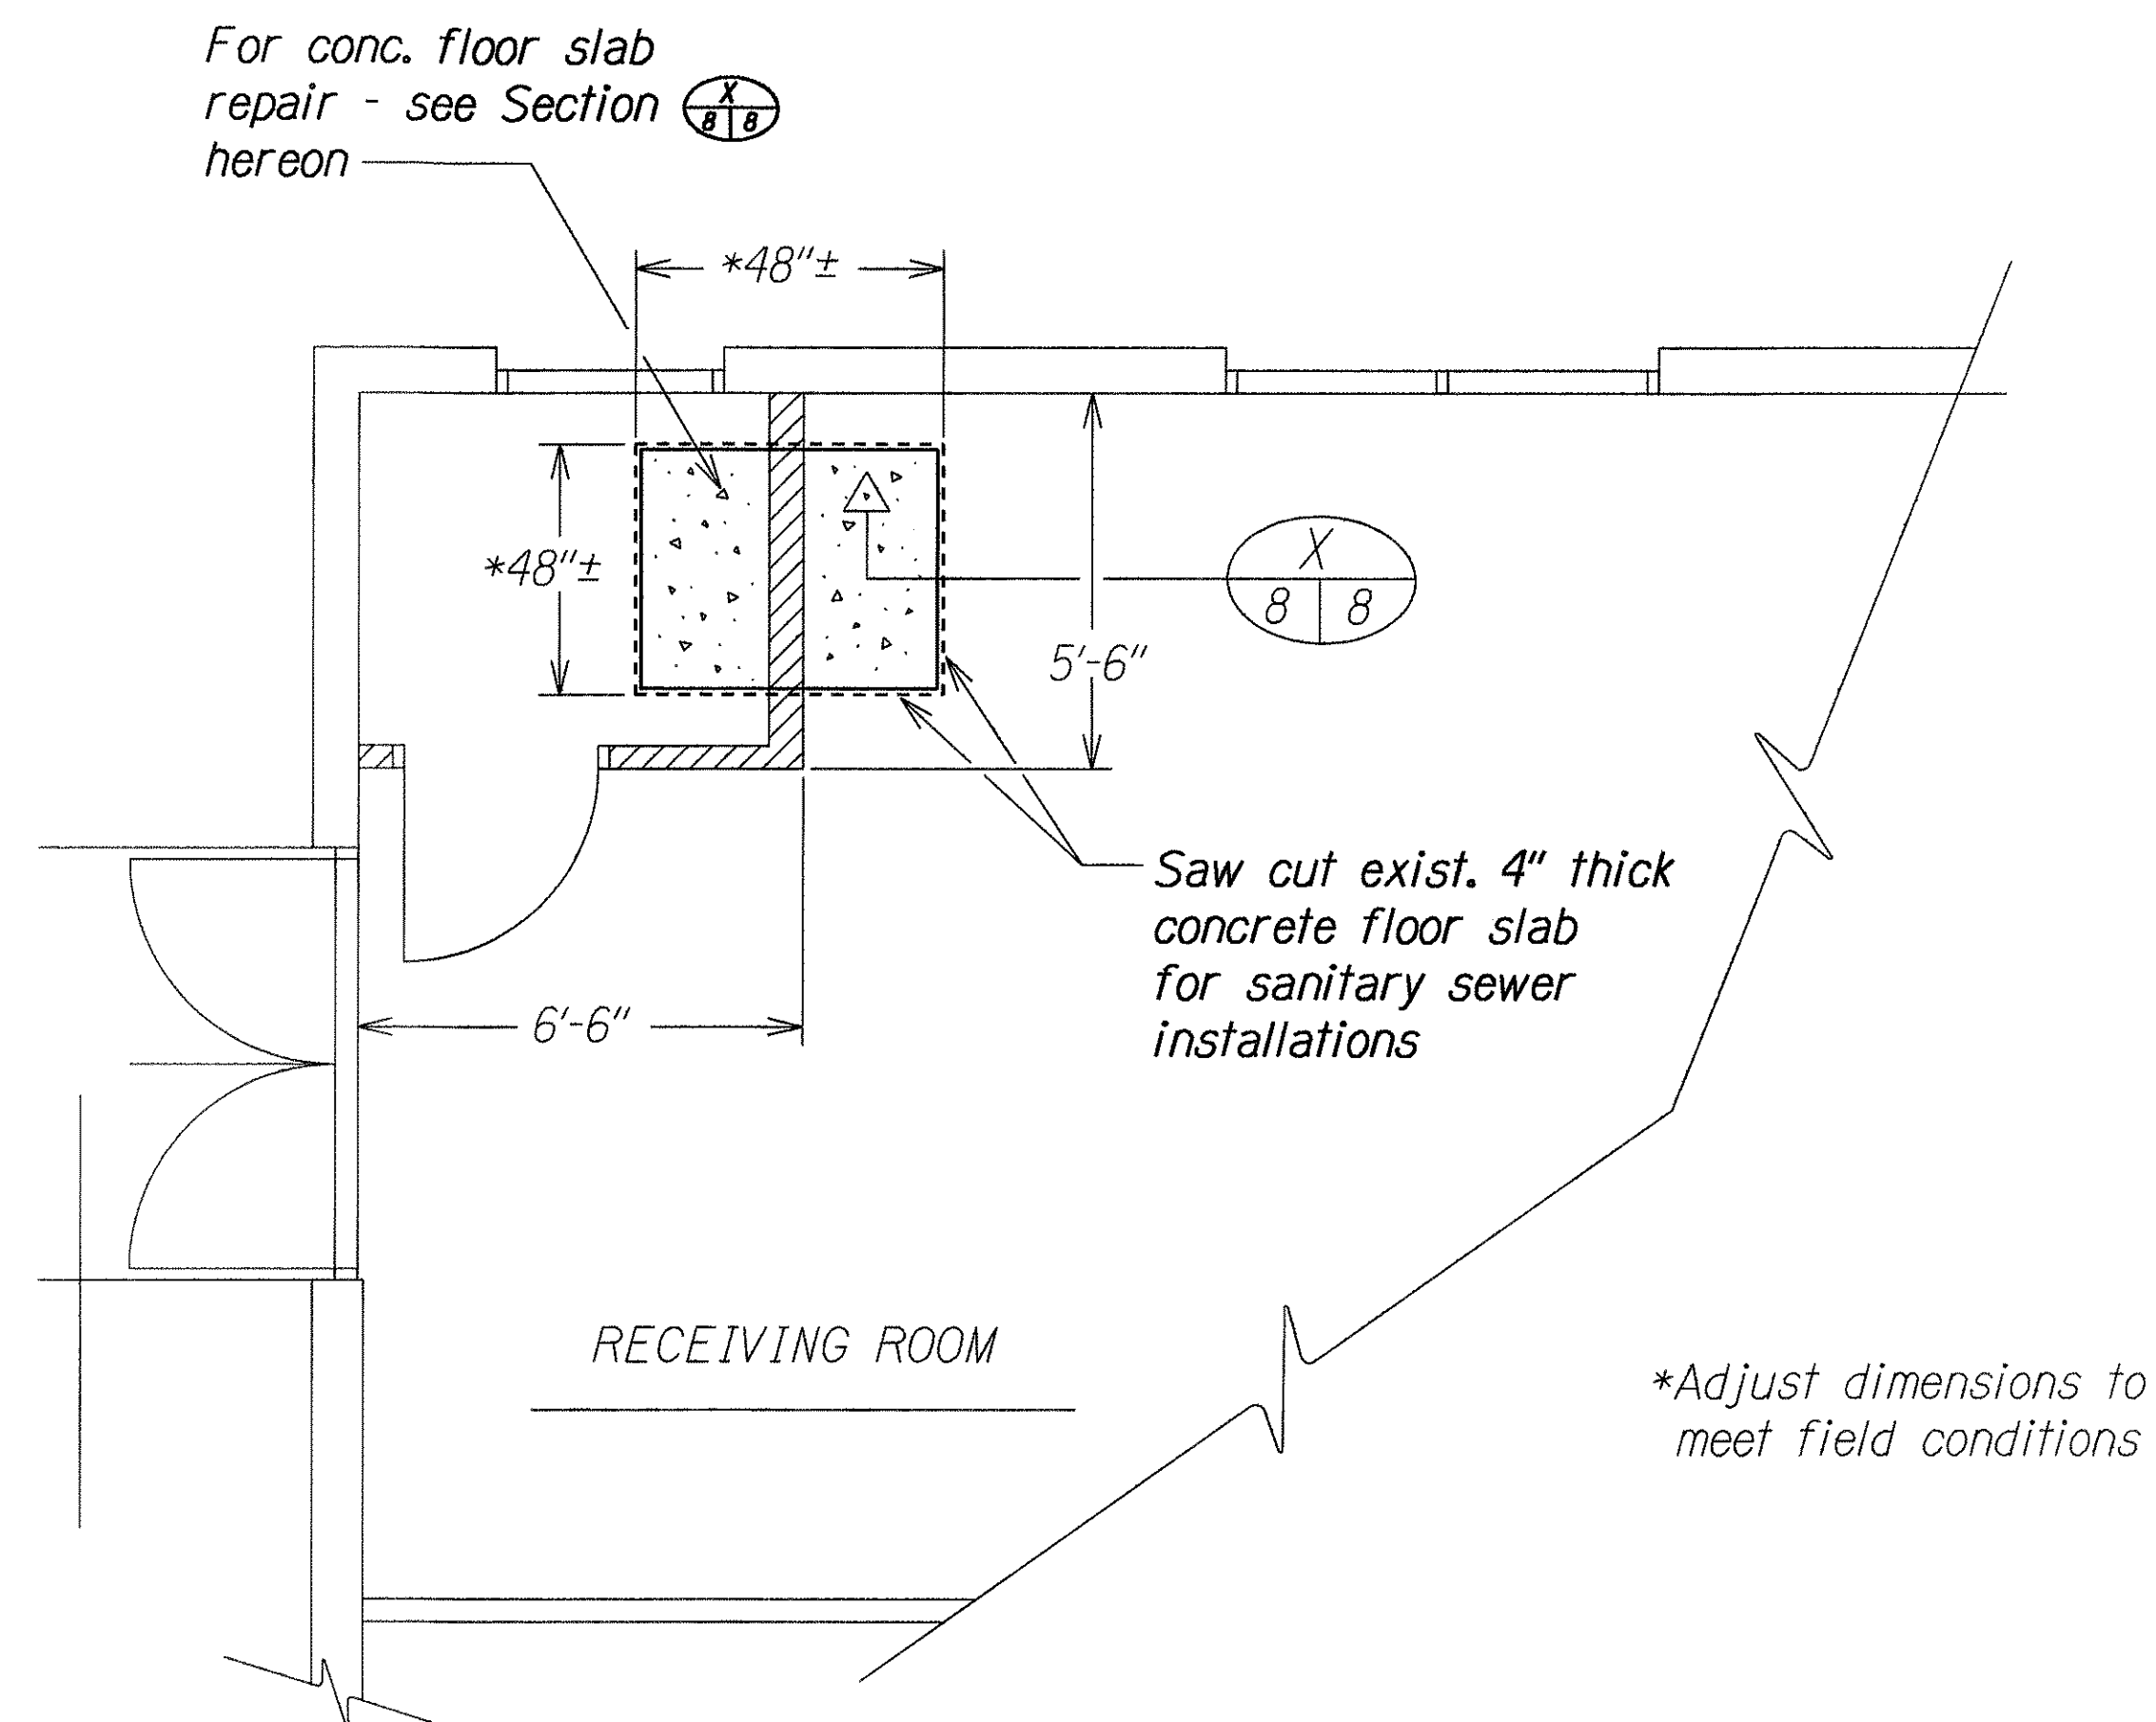


CONCRETE SLAB REPAIR DETAIL
Scale: $\frac{3}{8}"=1'$

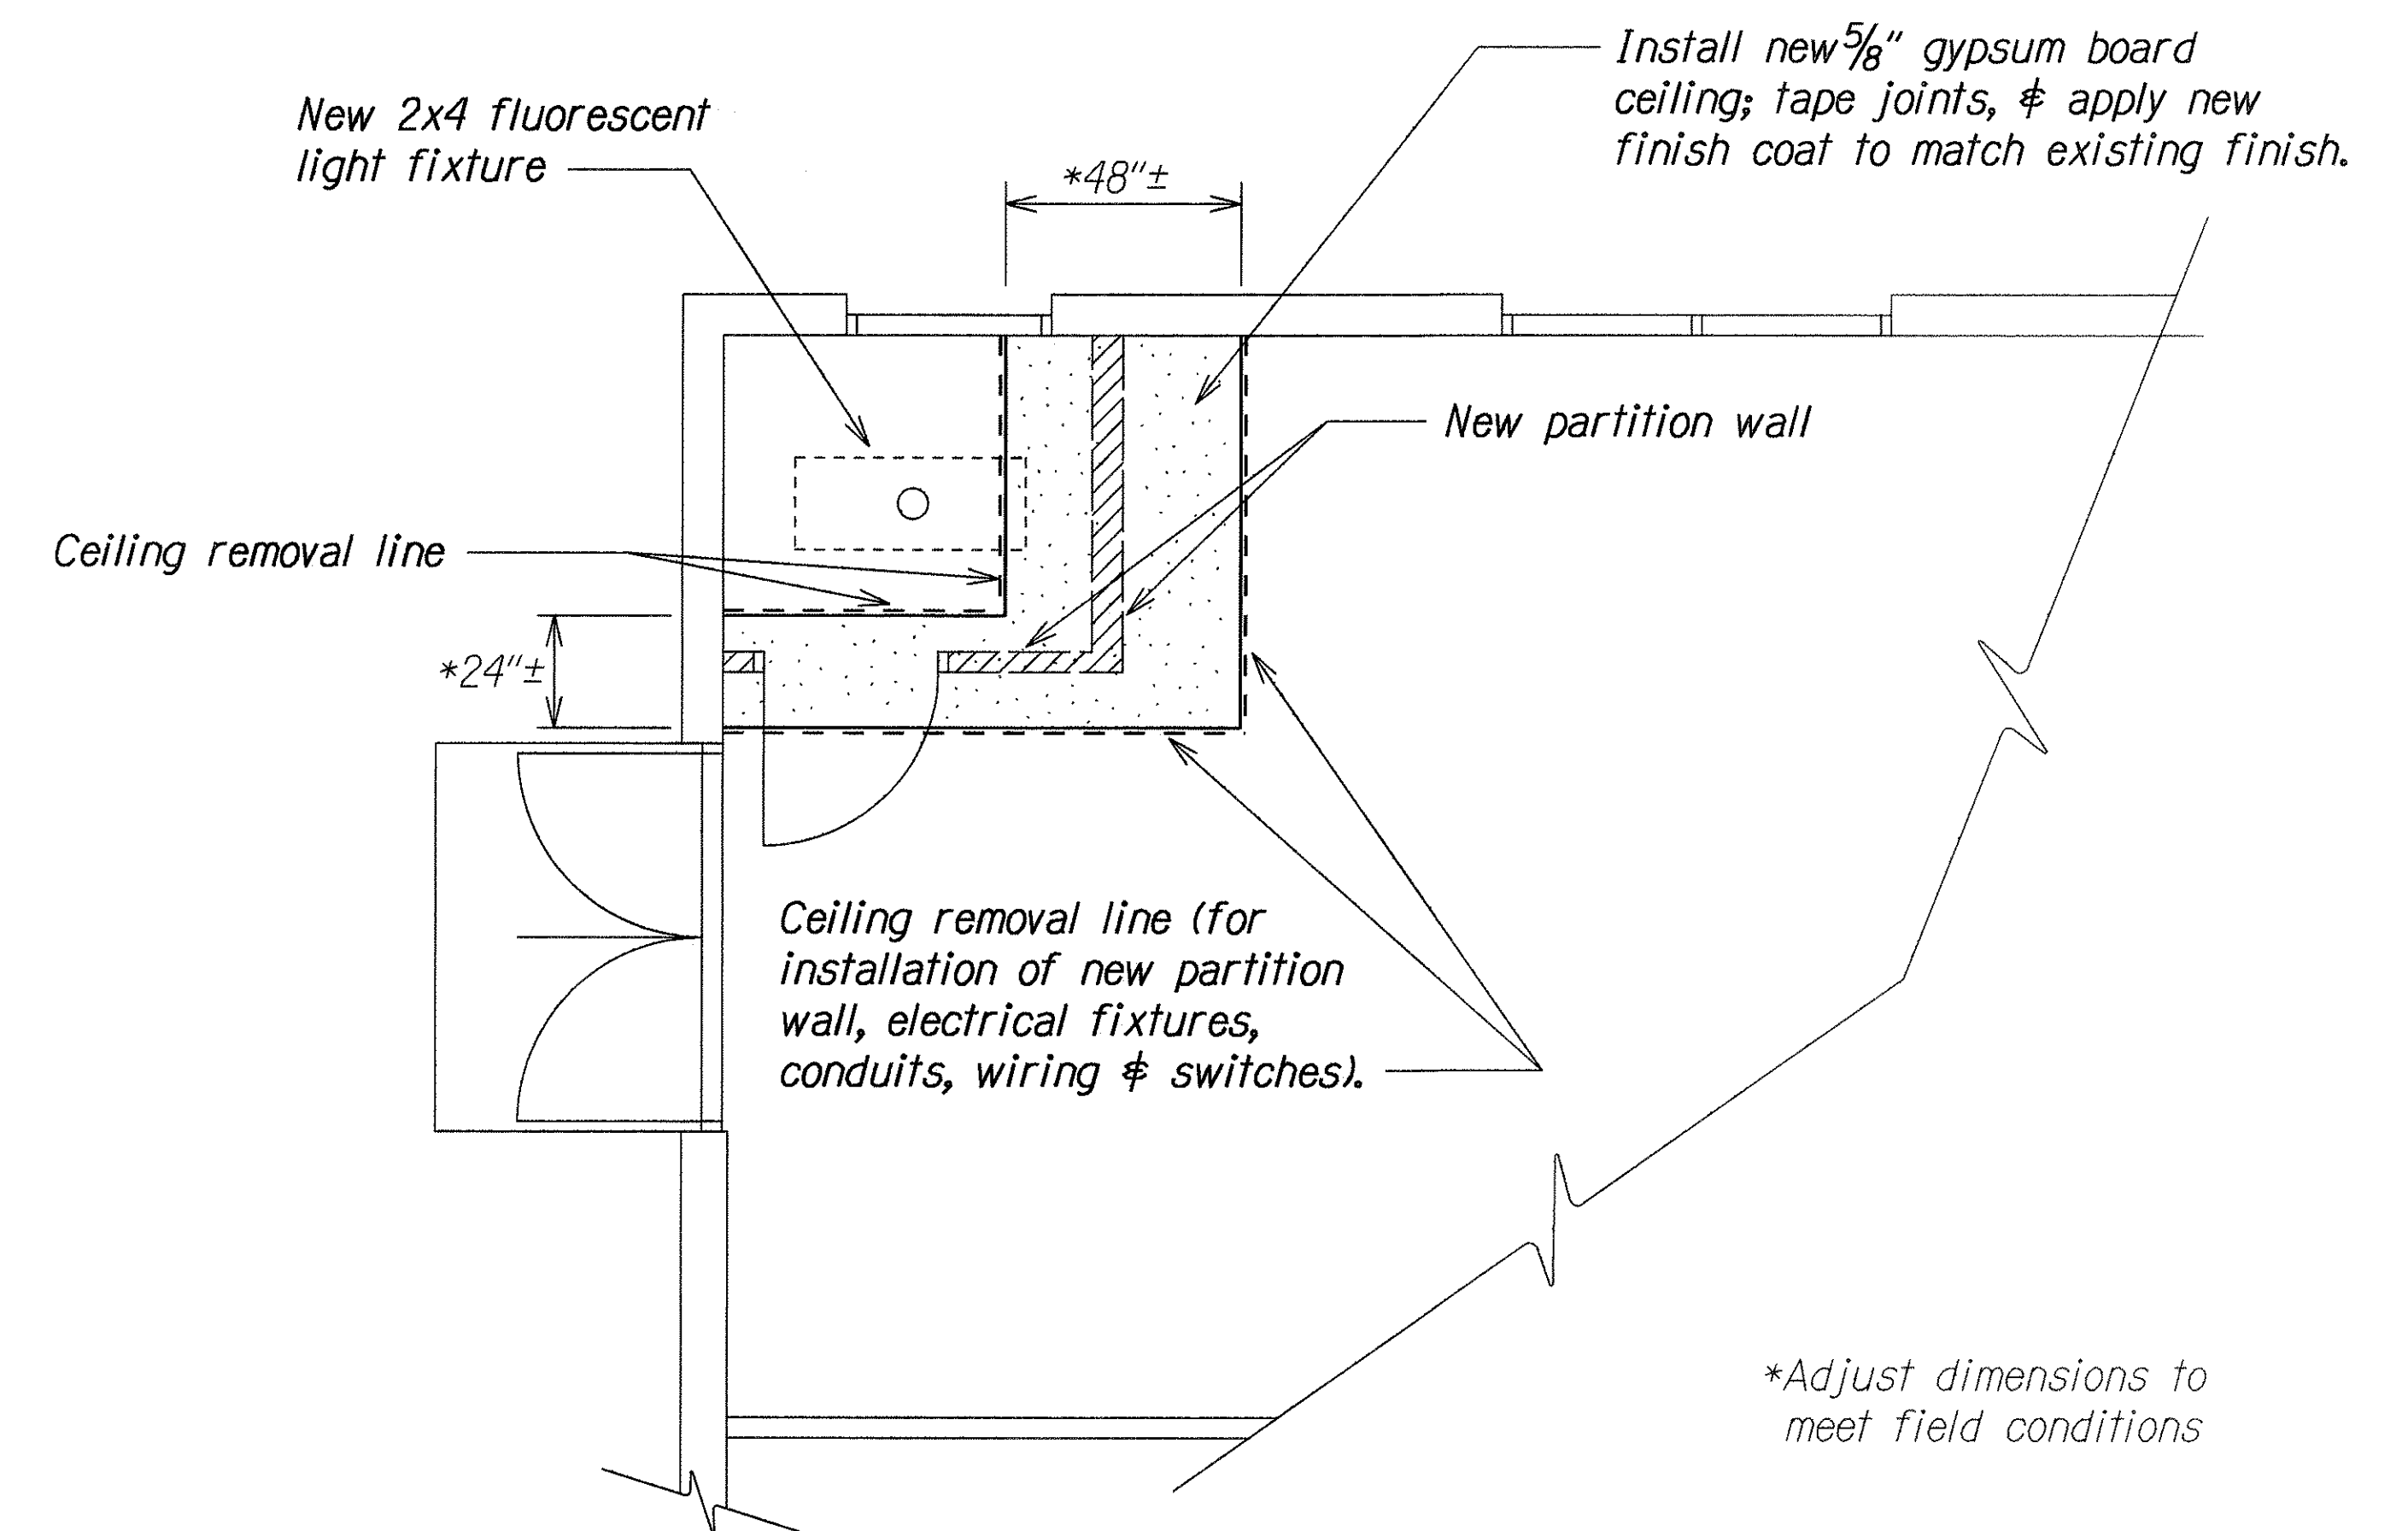

CEILING REPAIR PLAN
Scale: $\frac{3}{8}"=1'$

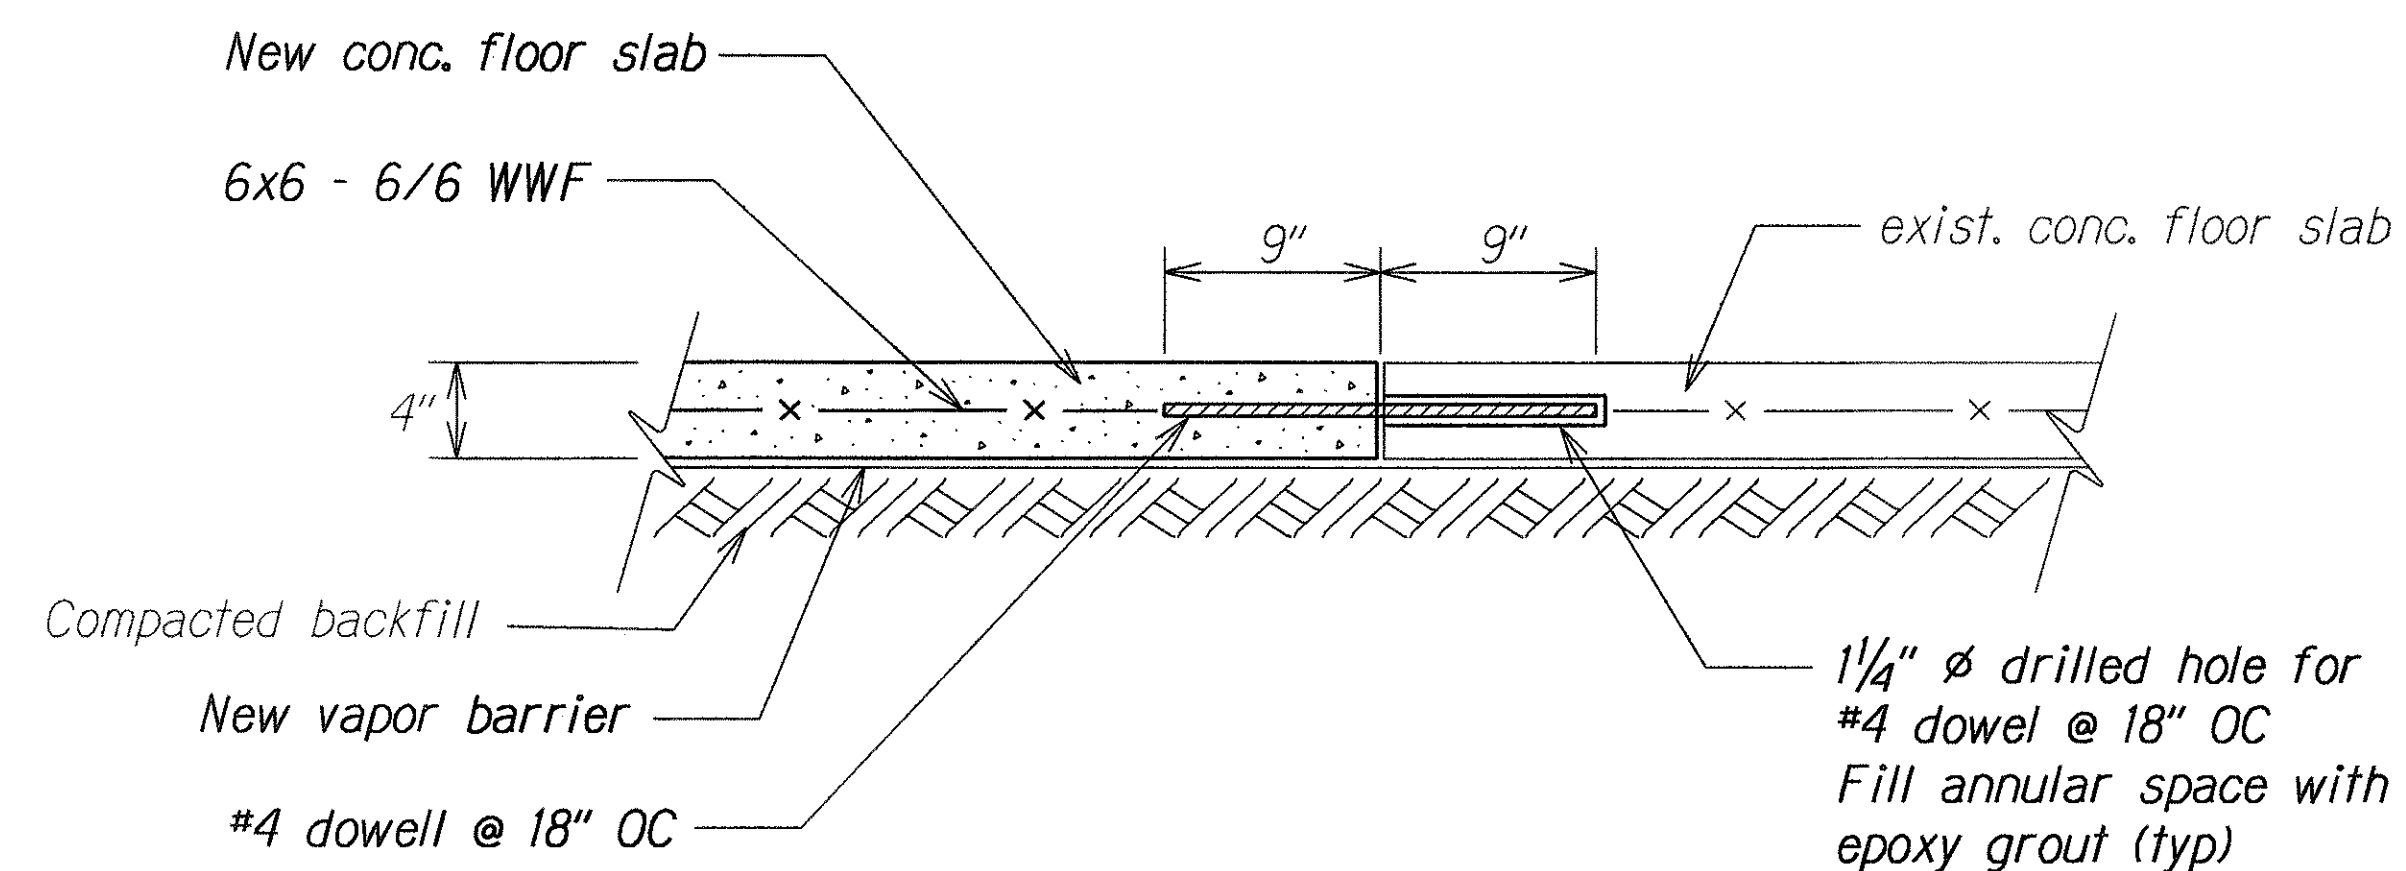

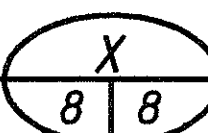SECTION
Scale: $1-\frac{1}{2}"=1'$ 

SURVEY PLOTTED BY	DATE
DRAWN BY	
TRACED BY	
NOTE BOOK	
CHECKED BY	
N.	

STATE OF HAWAII
DEPARTMENT OF TRANSPORTATION
HIGHWAYS DIVISION

FLOOR AND CEILING REPAIR
NEW RESTROOM

KAPAA BASEYARD RENOVATIONS
Project No. HWY-K-01-94M

Scale: As Shown Date: Sept., 1993

SHEET No. 4 OF 6 SHEETS