[illegible]

STATE OF HAWAII

DEPARTMENT OF TRANSPORTATION

HIGHWAYS DIVISION

HONOLULU, HAWAII

"AS-BUILT"


PLANS FOR

**KAPAA BASEYARD RENOVATIONS**

**HWY-K-01-94M**

DISTRICT OF KAWAIHAU

ISLAND OF KAUAI

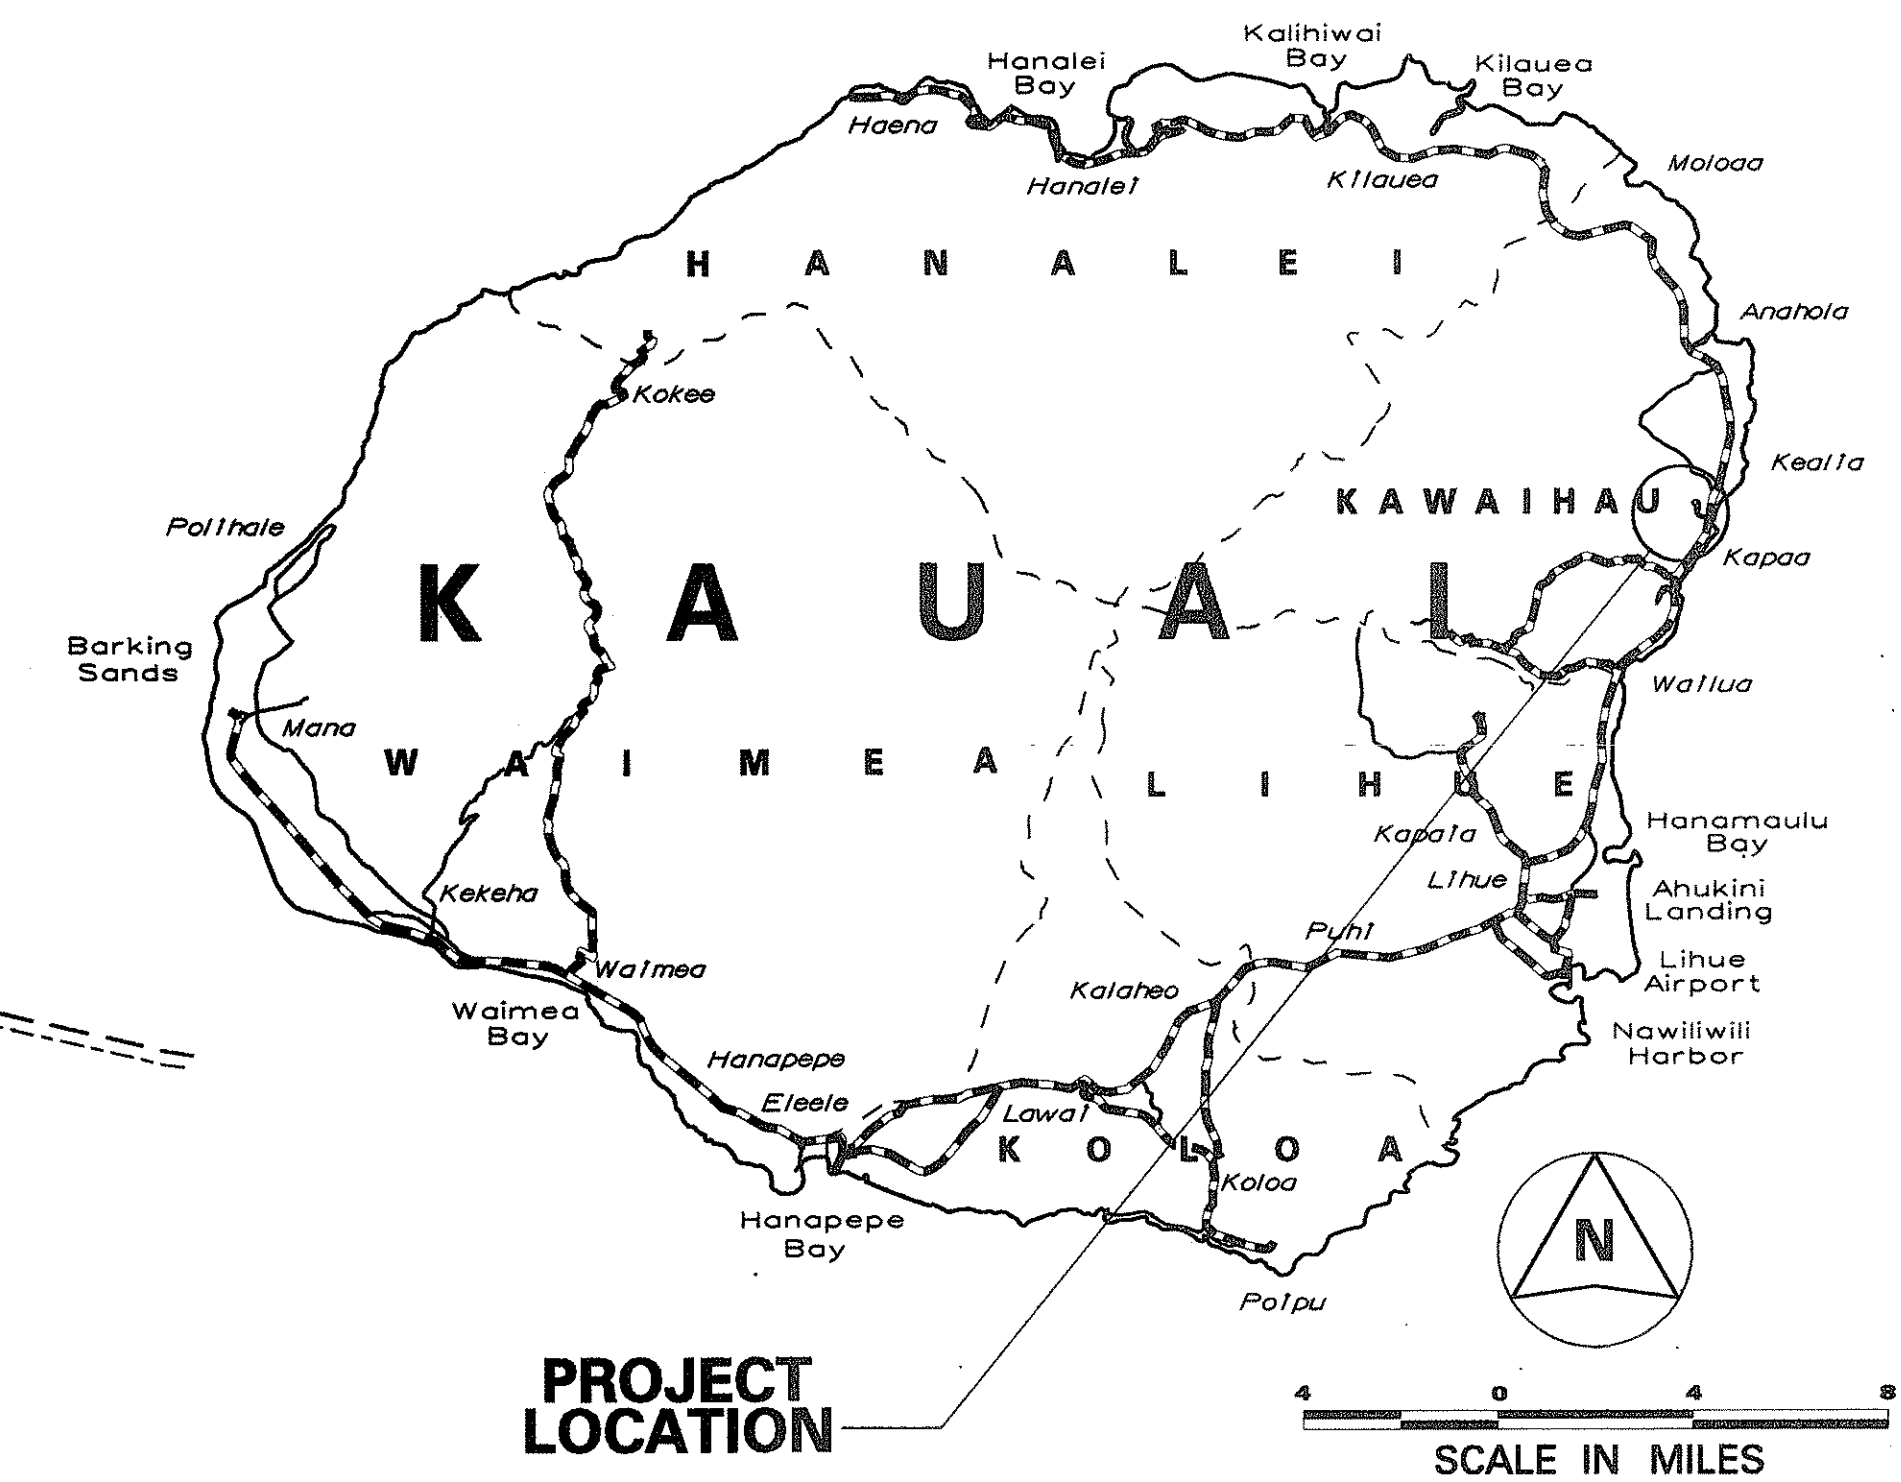




FEDERAL AID PROJECTS PREVIOUSLY CONSTRUCTED  
OR UNDER CONSTRUCTION

CHANGES MADE DURING CONSTRUCTION HAVE BEEN INCORPORATED ON THESE PLANS EXCEPT CHANGES IN THE ORIGINAL THEORETICAL QUANTITIES. FOR ACTUAL QUANTITIES, REFER TO PROJECT LEDGER AND/OR COMPUTATION BOOK.


Leonard Antinis  
RESIDENT ENGINEER

3/11/99  
DATE

<b>DEPARTMENT OF TRANSPORTATION STATE OF HAWAII</b>	
<b>APPROVED:</b> 	<u>4/7/94</u> <b>DATE</b>
<div style="display: flex; justify-content: space-between;"> <span> <b>DIR. OF TRANSPORTATION</b></span> </div>	

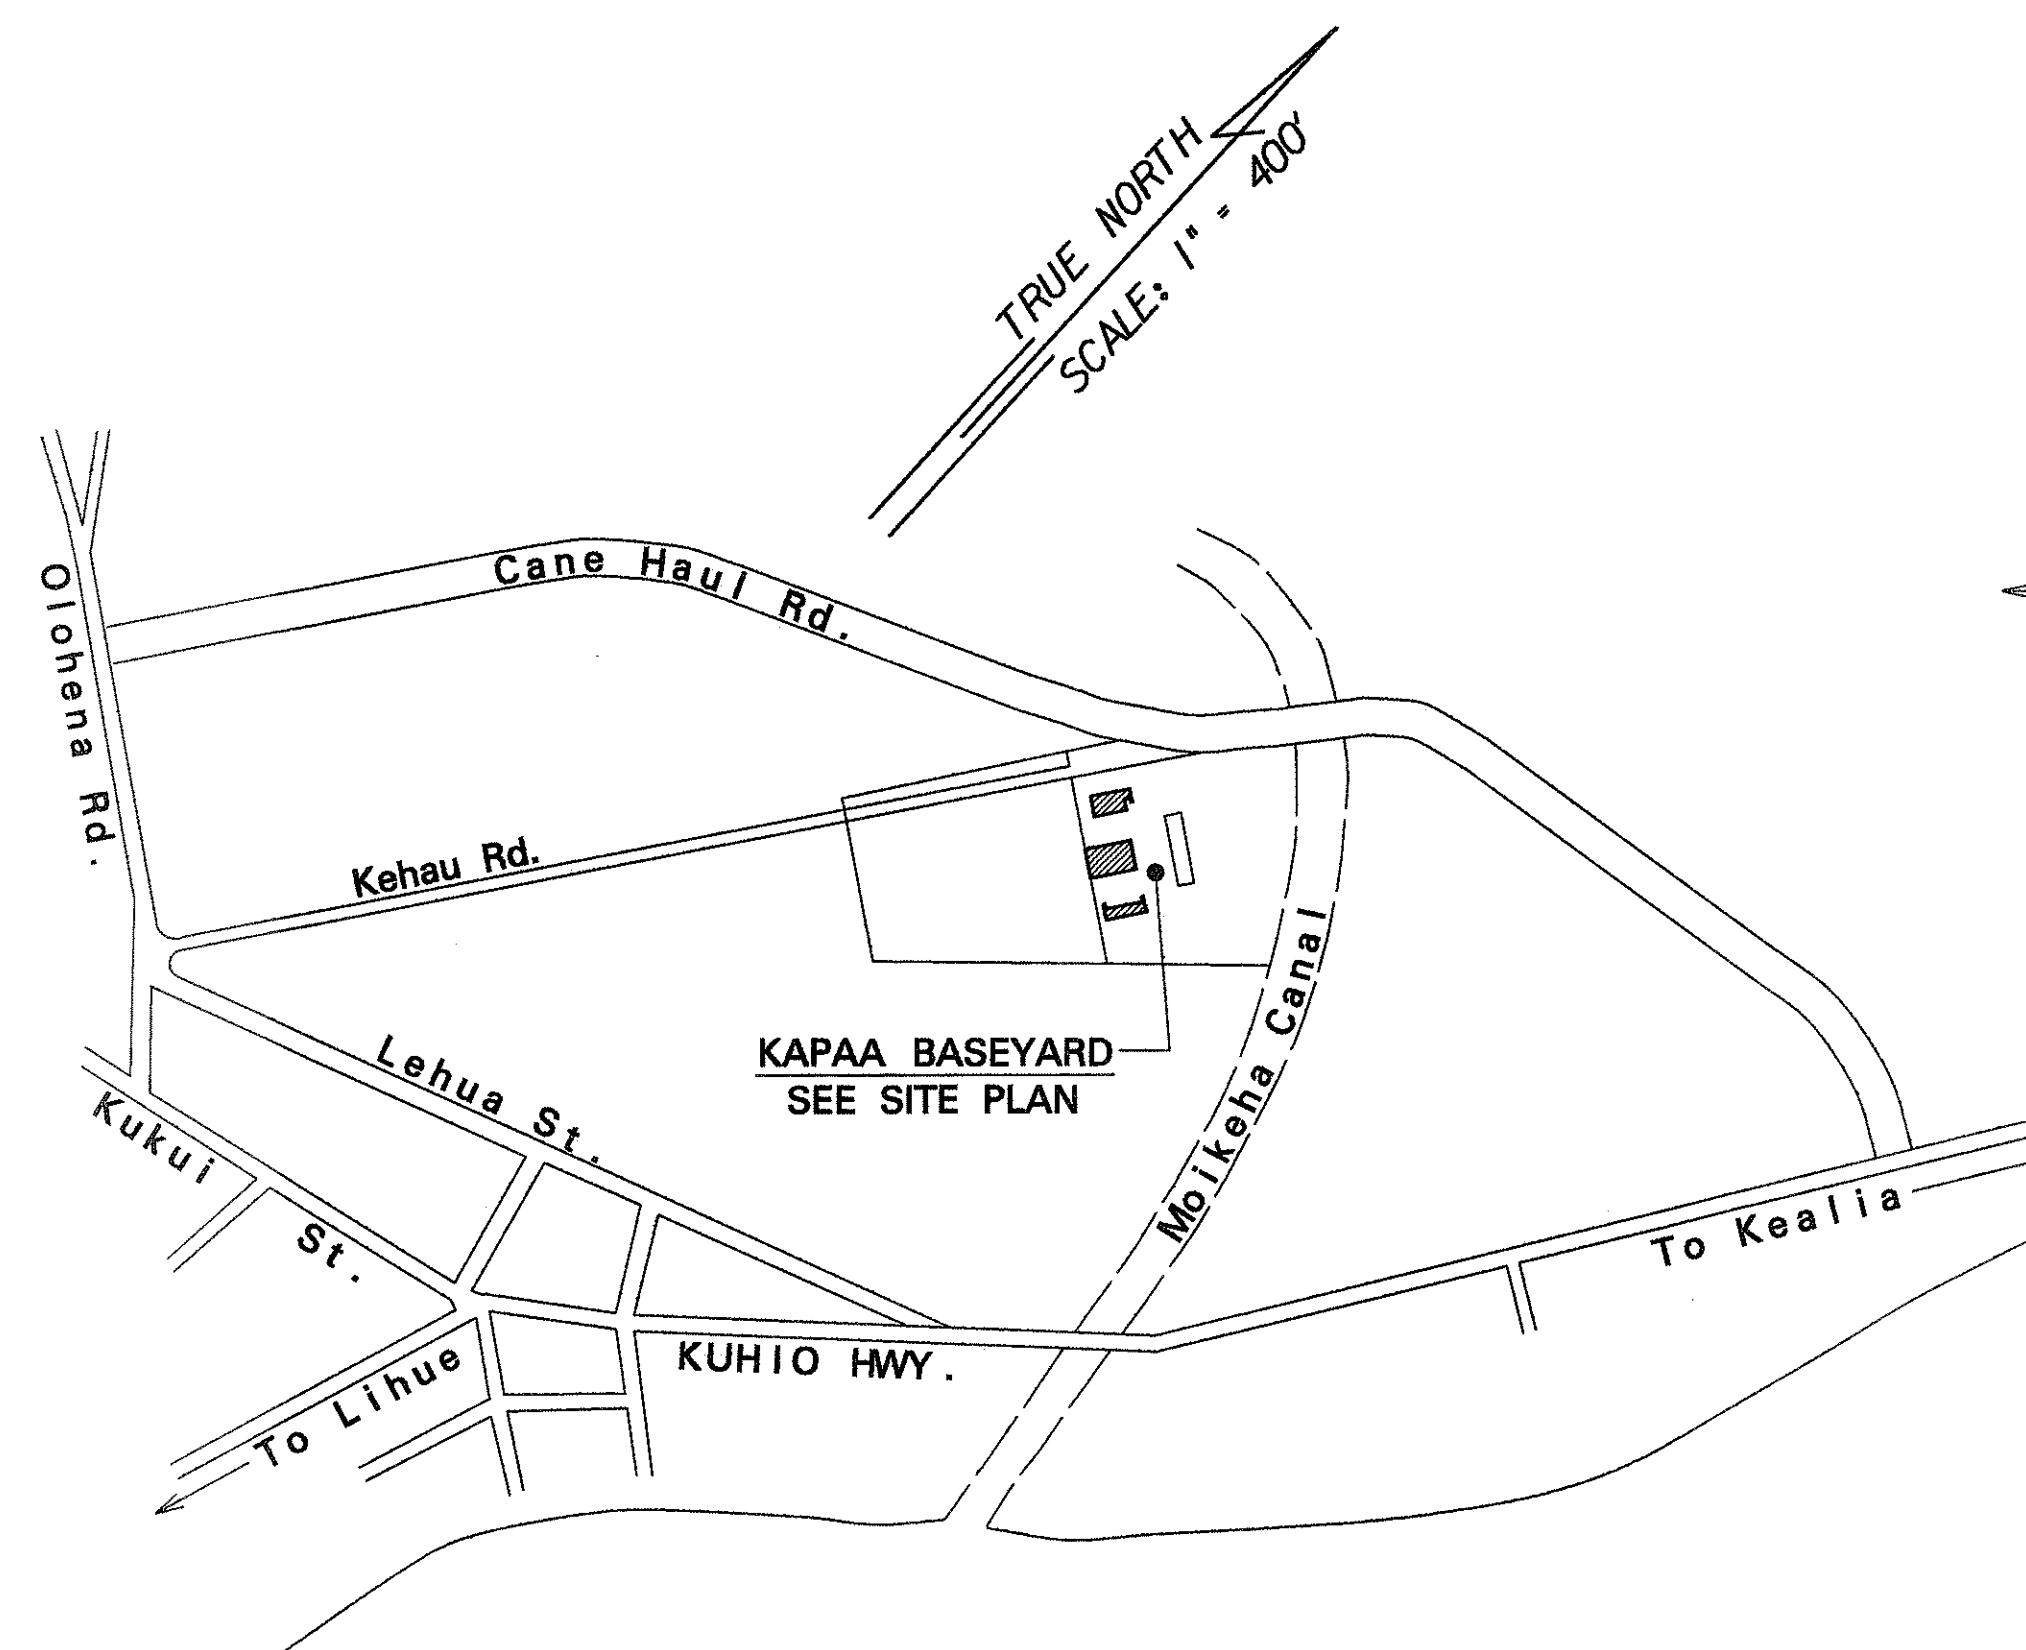

### VICINITY MAP

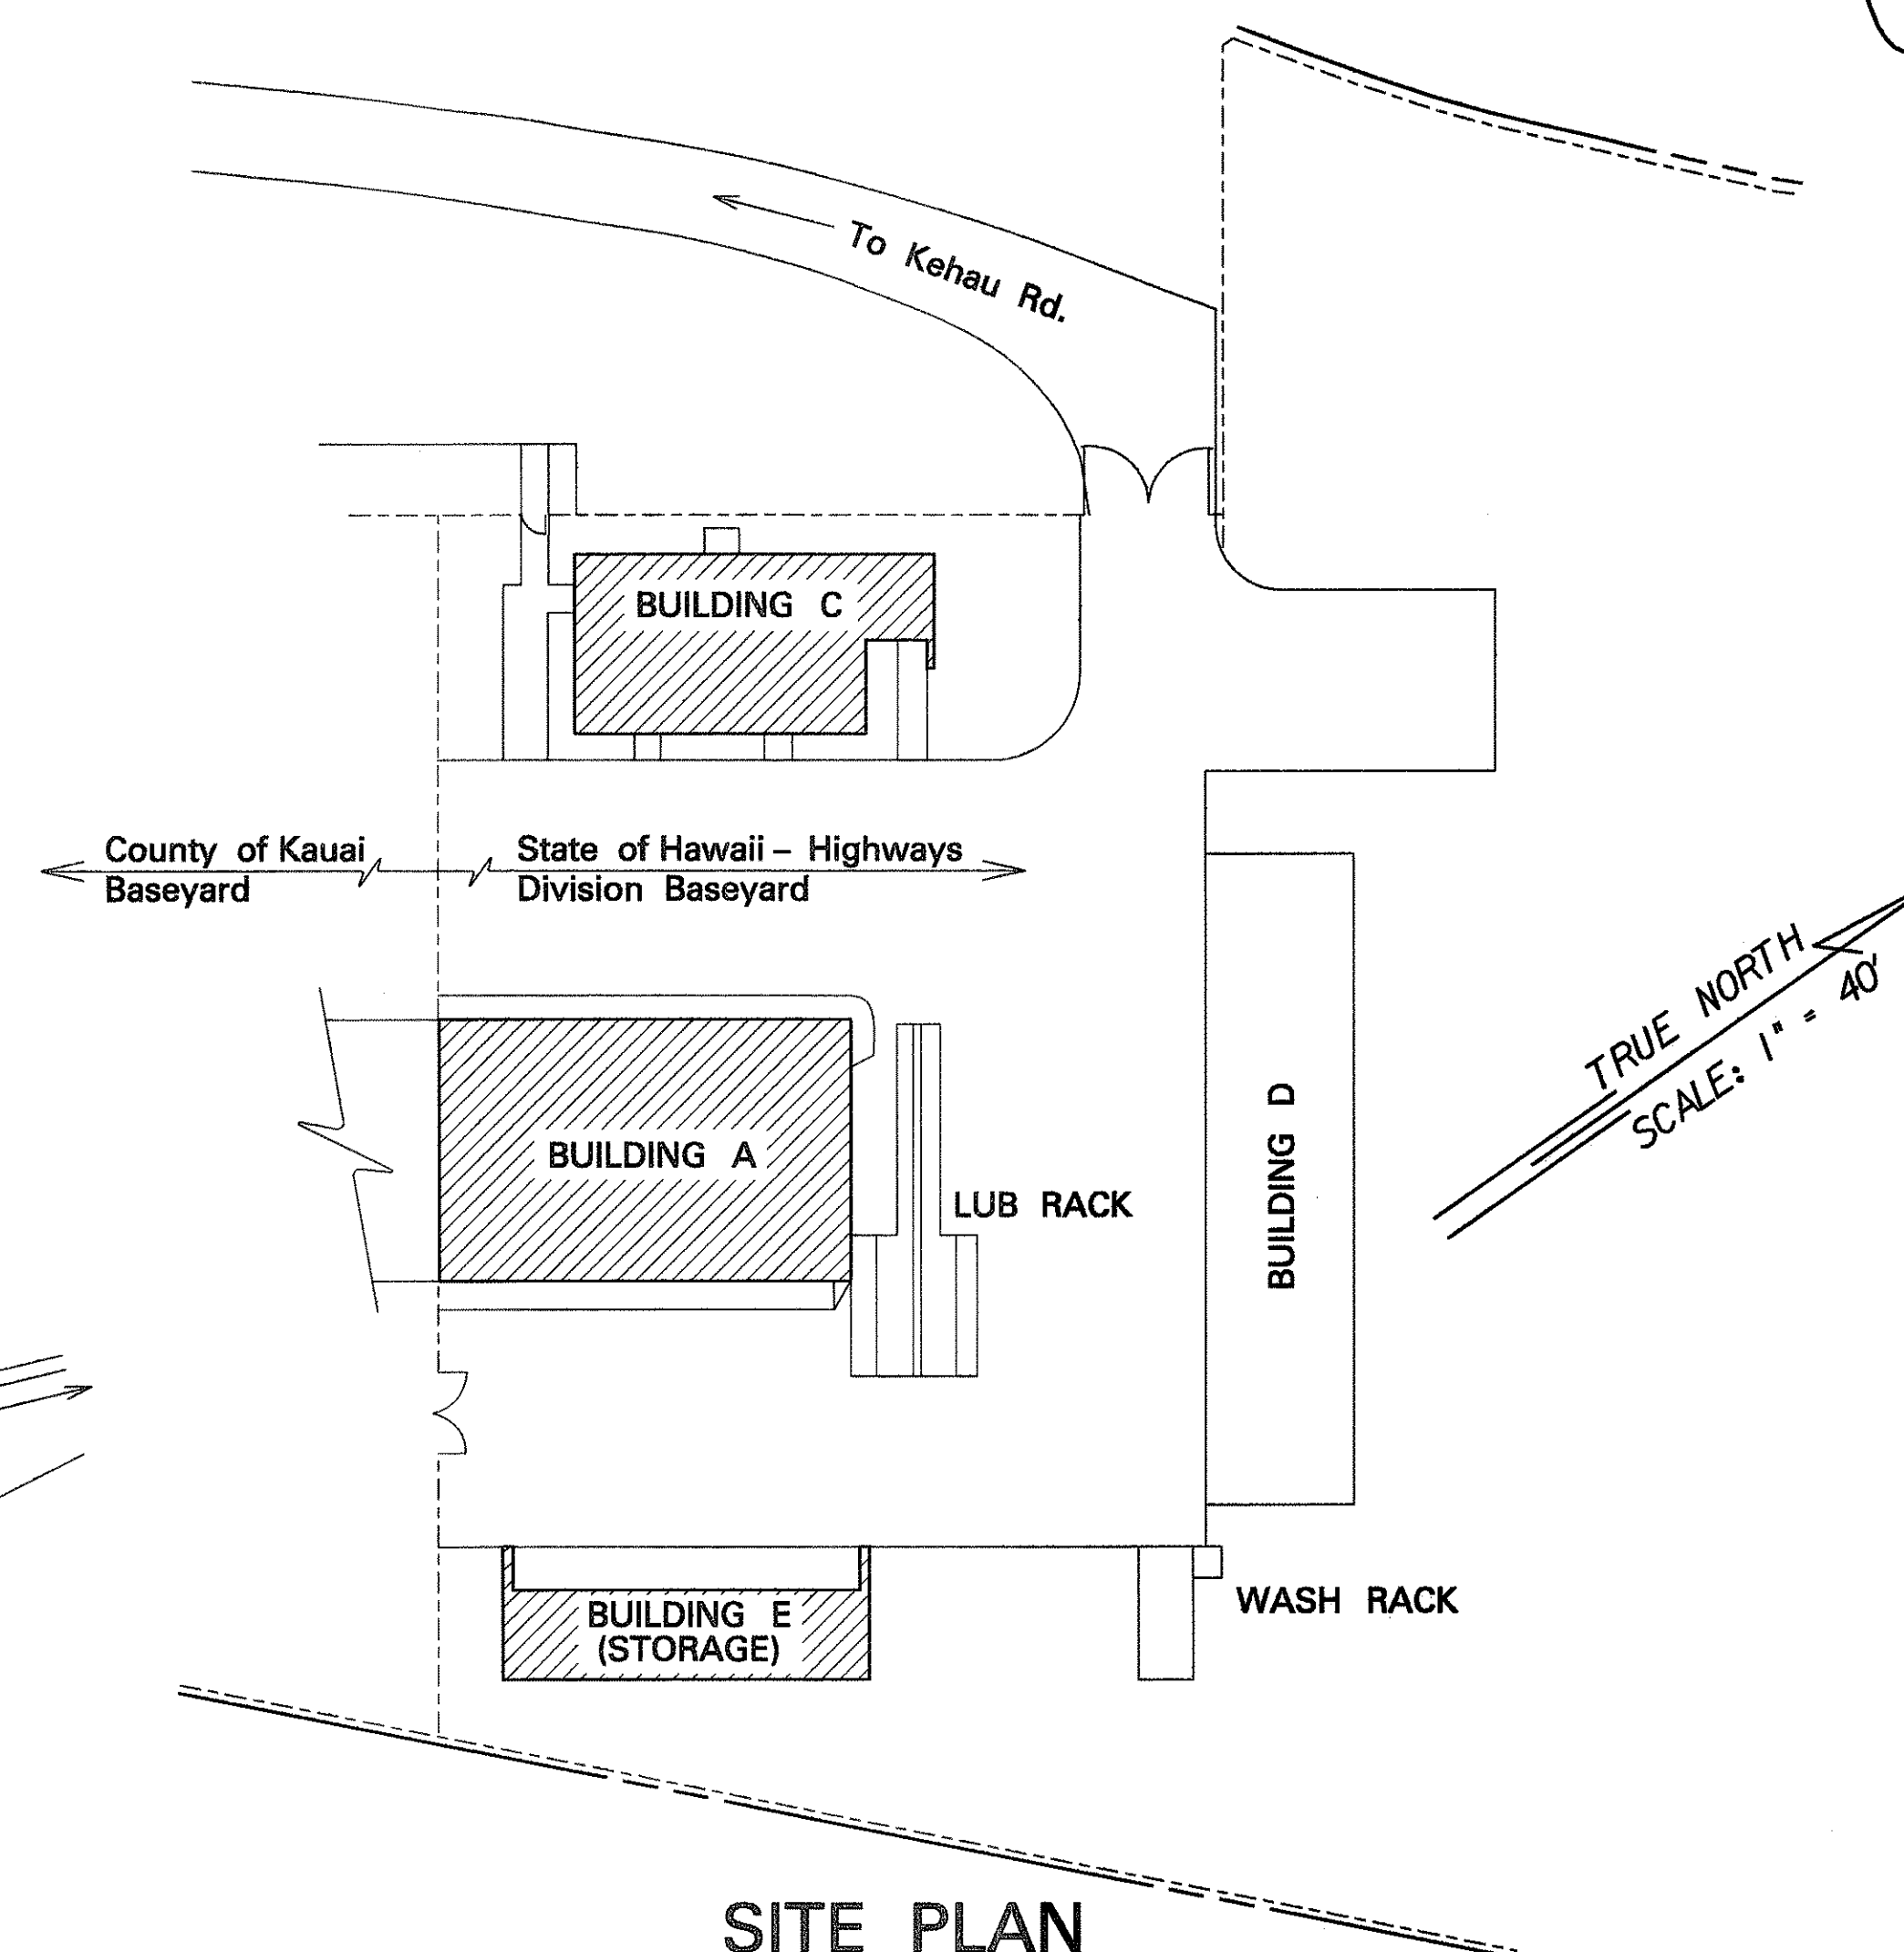

# SITE PLAN

DESIGNED BY	UNIT E	241-3461	APRIL 1994
HWY-K	P. S. & E. BY	PHONE	DATE