



FED. ROAD DIST. NO.	STATE	PROJ. NO.	FISCAL YEAR	SHEET NO.	TOTAL SHEETS
HAWAII	HAW.	HWY-K-01-97	1998	5	12

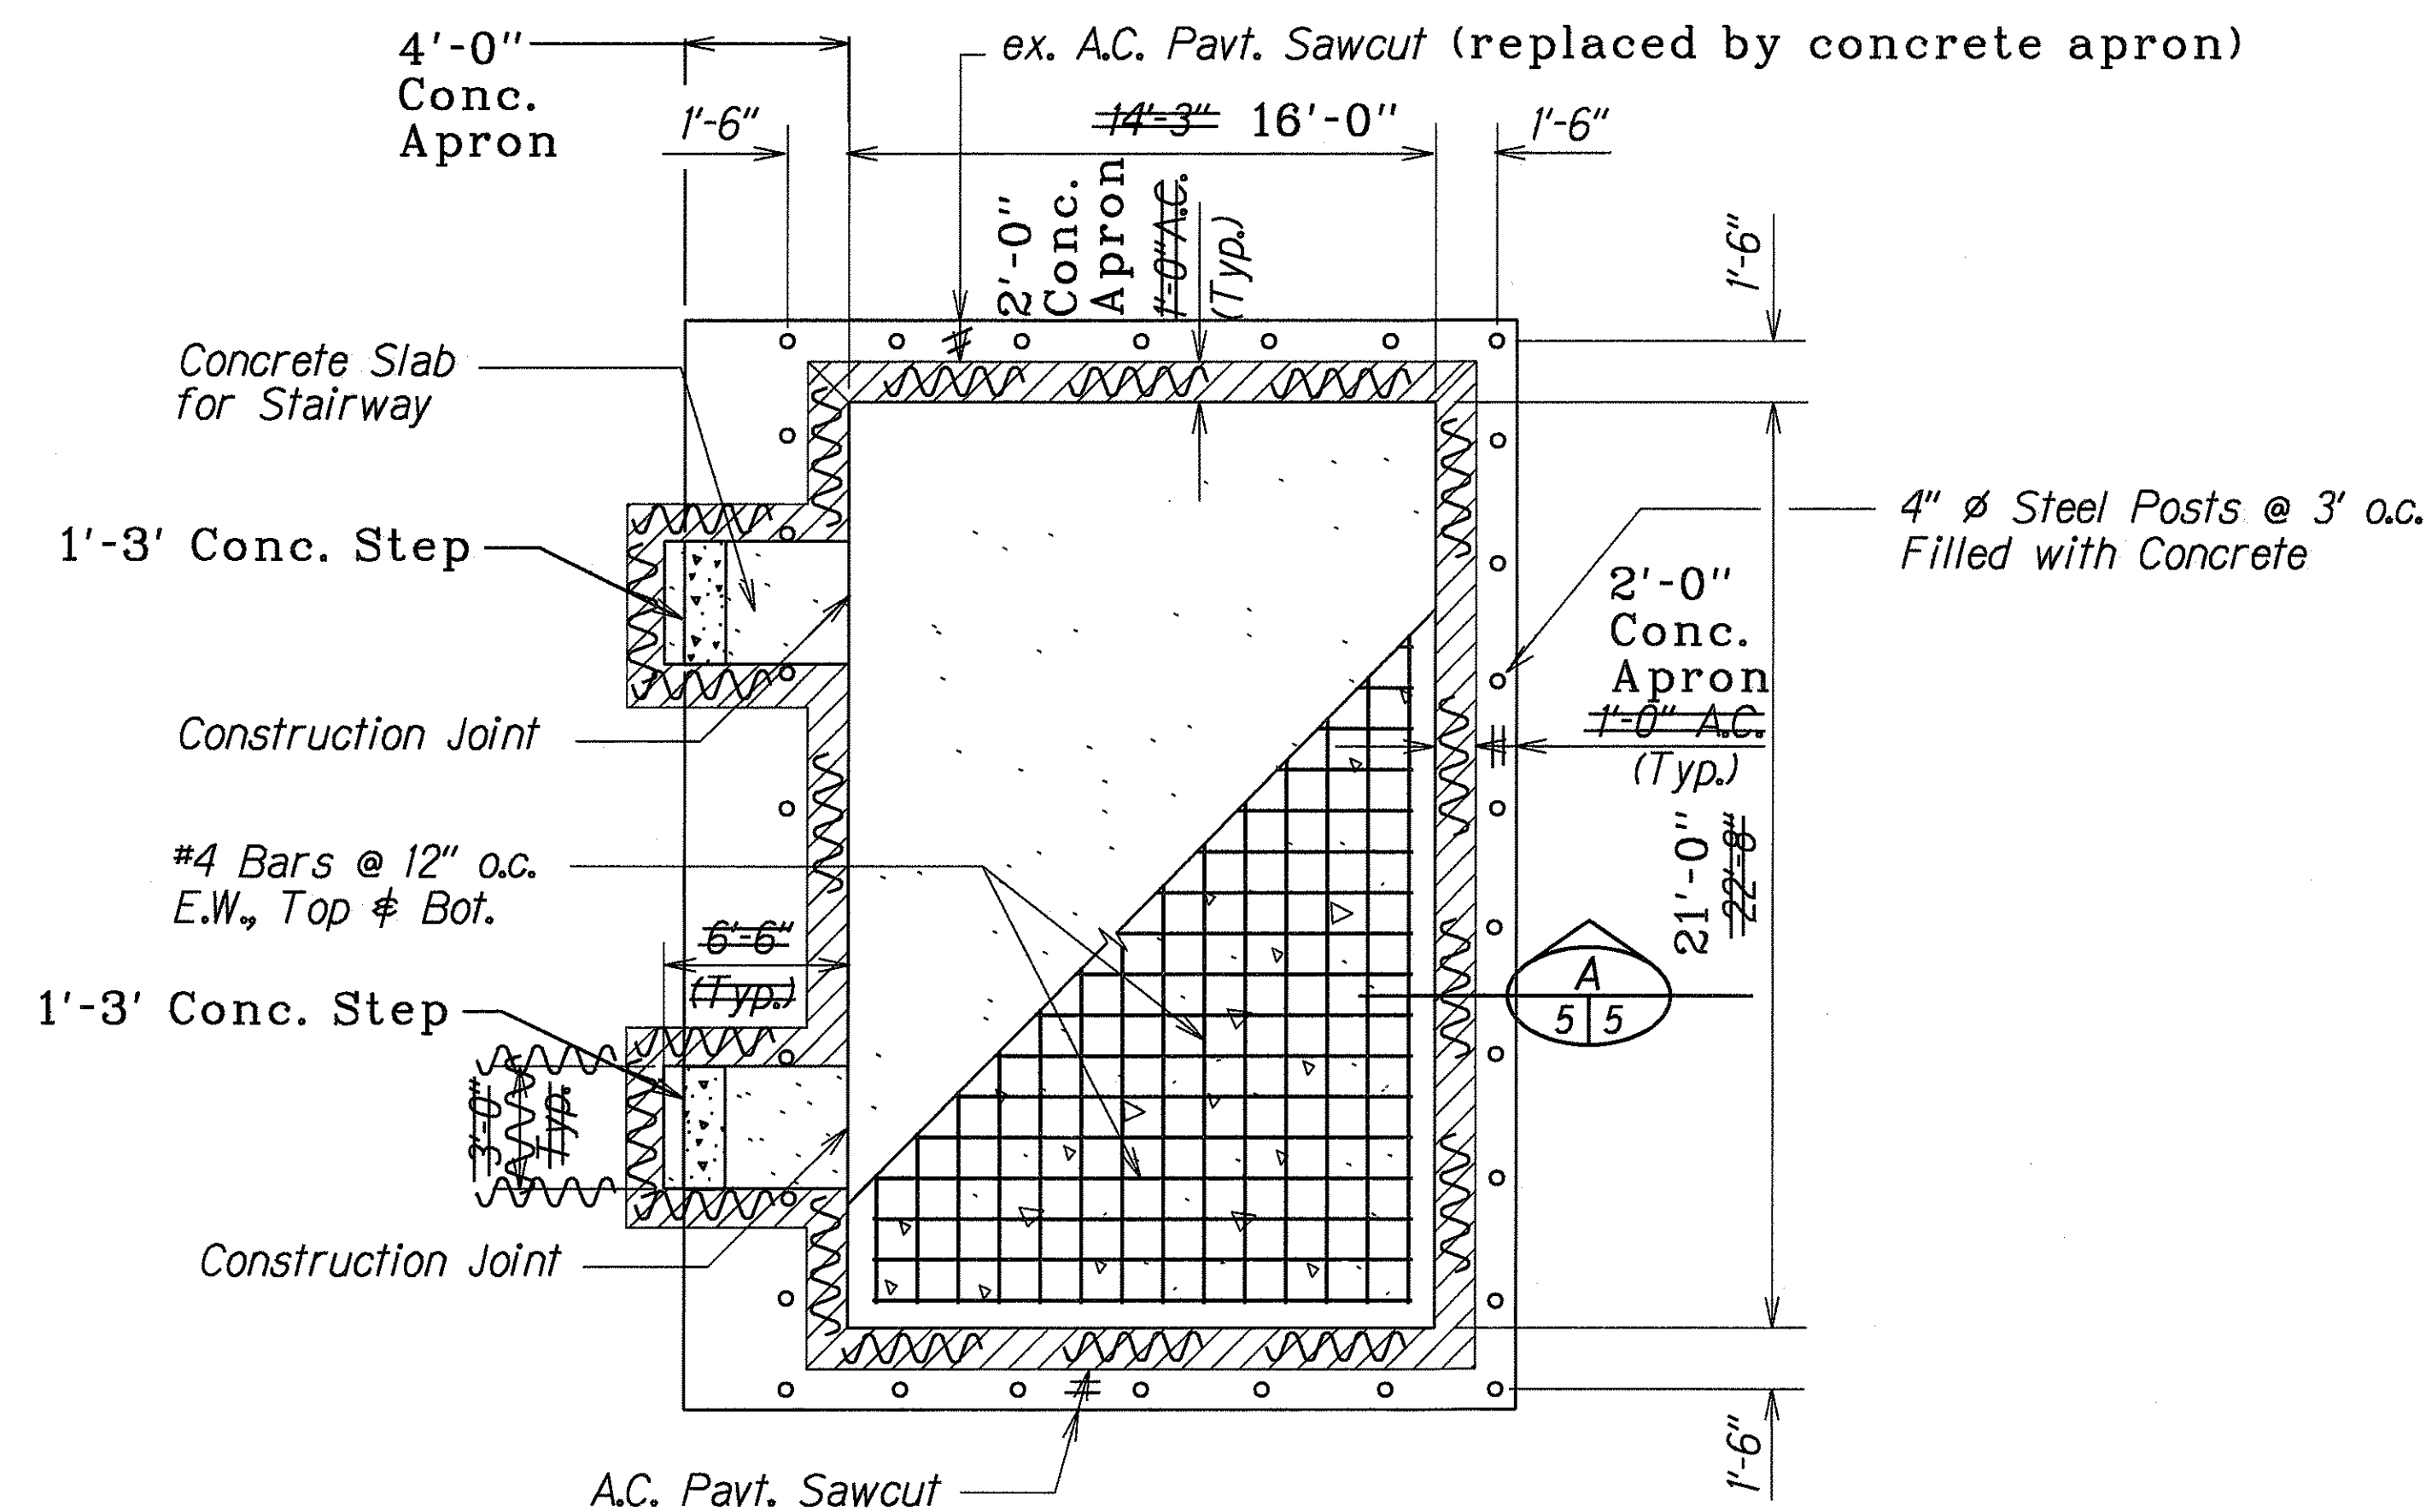


PLAN - CONCRETE SLAB FOR FUEL TANKS

Scale: 1/4" = 1'-0"

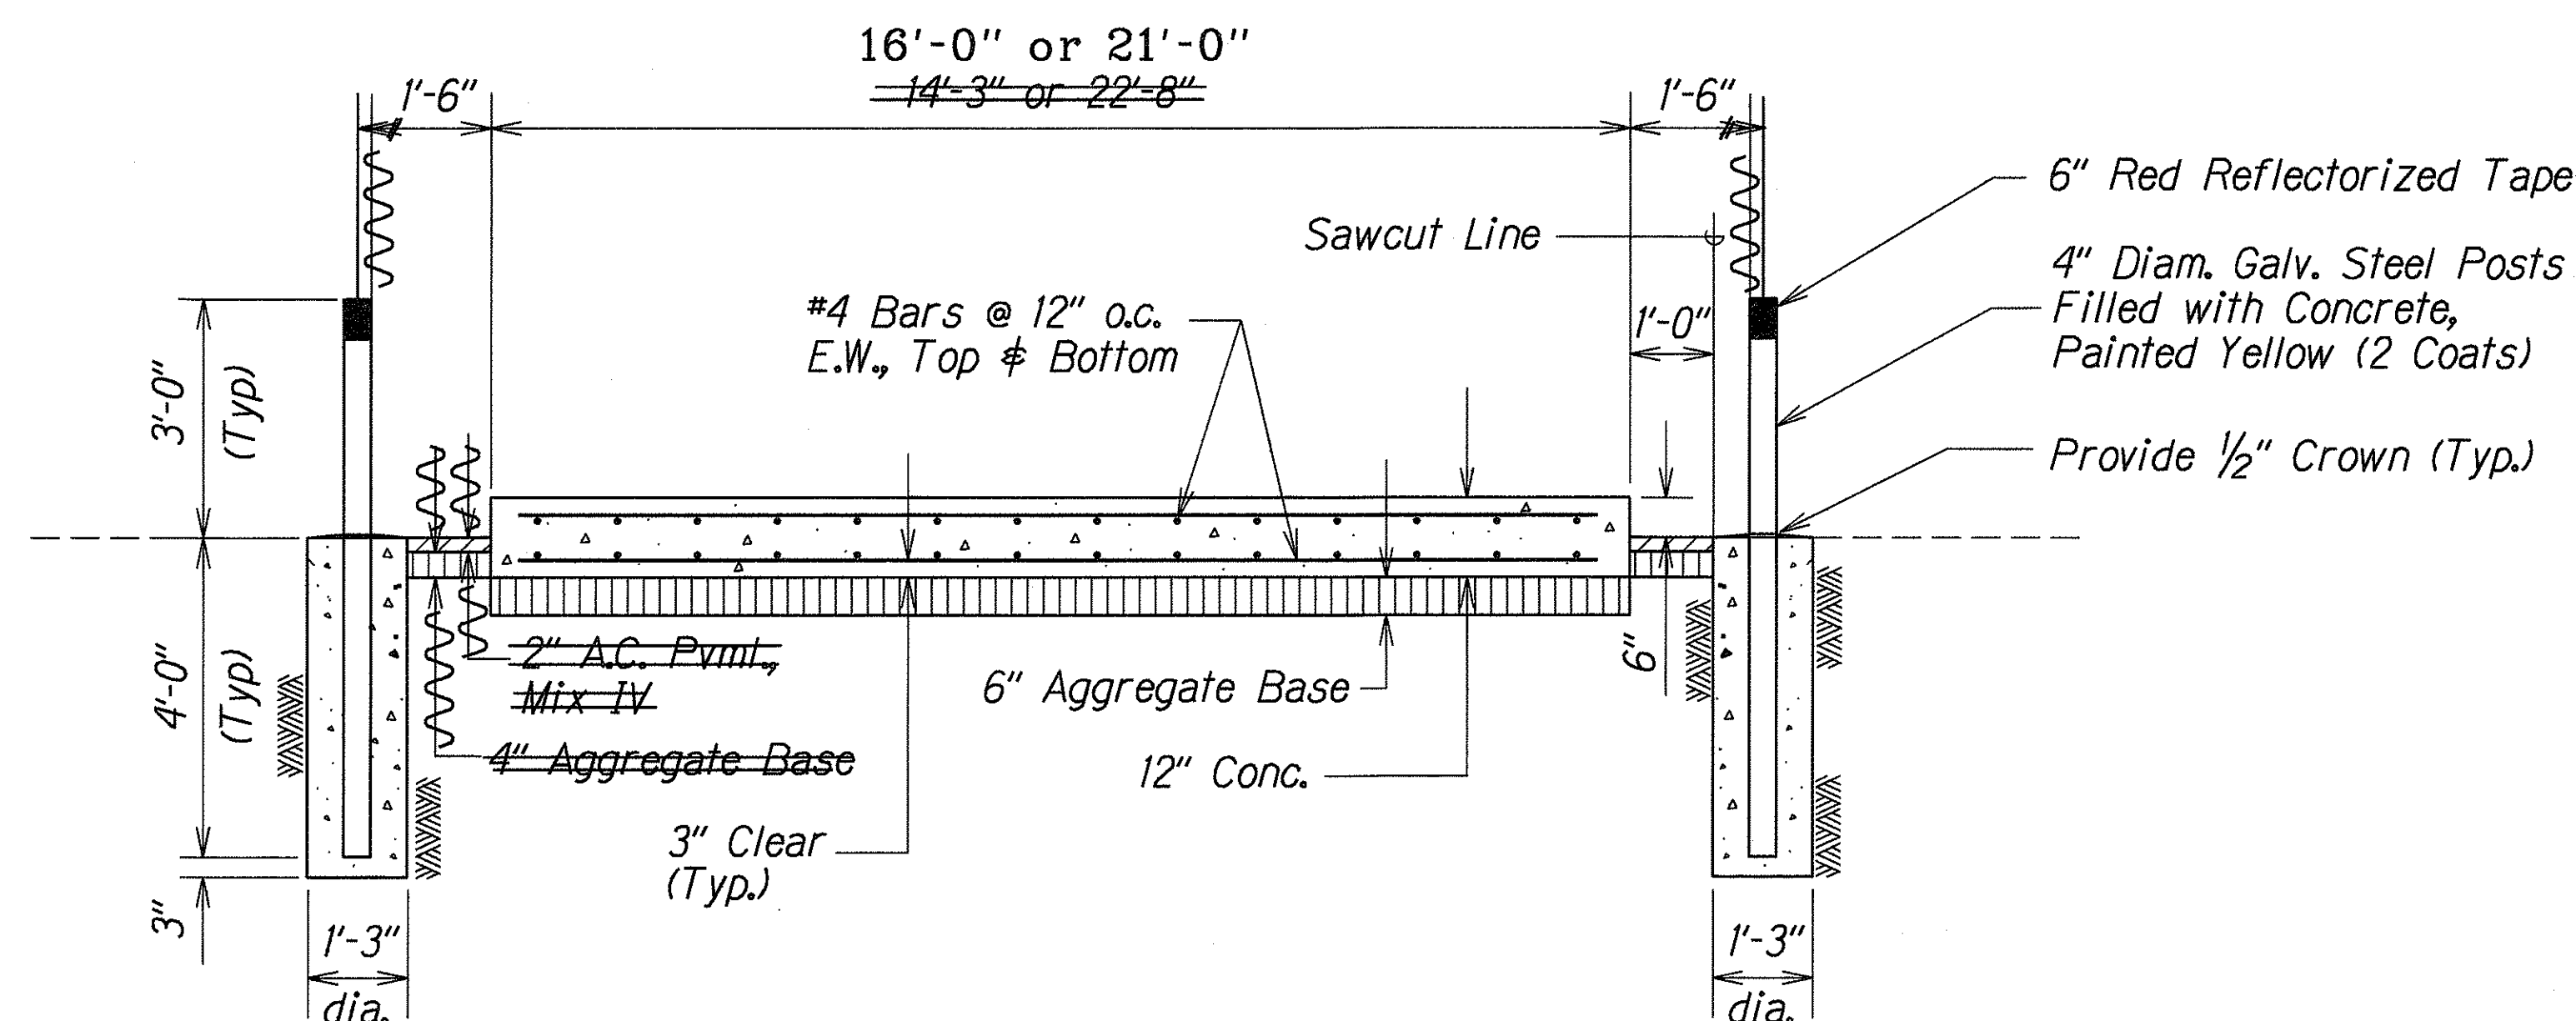

TYPICAL SLAB SECTION


Scale: 1/2" = 1'-0"

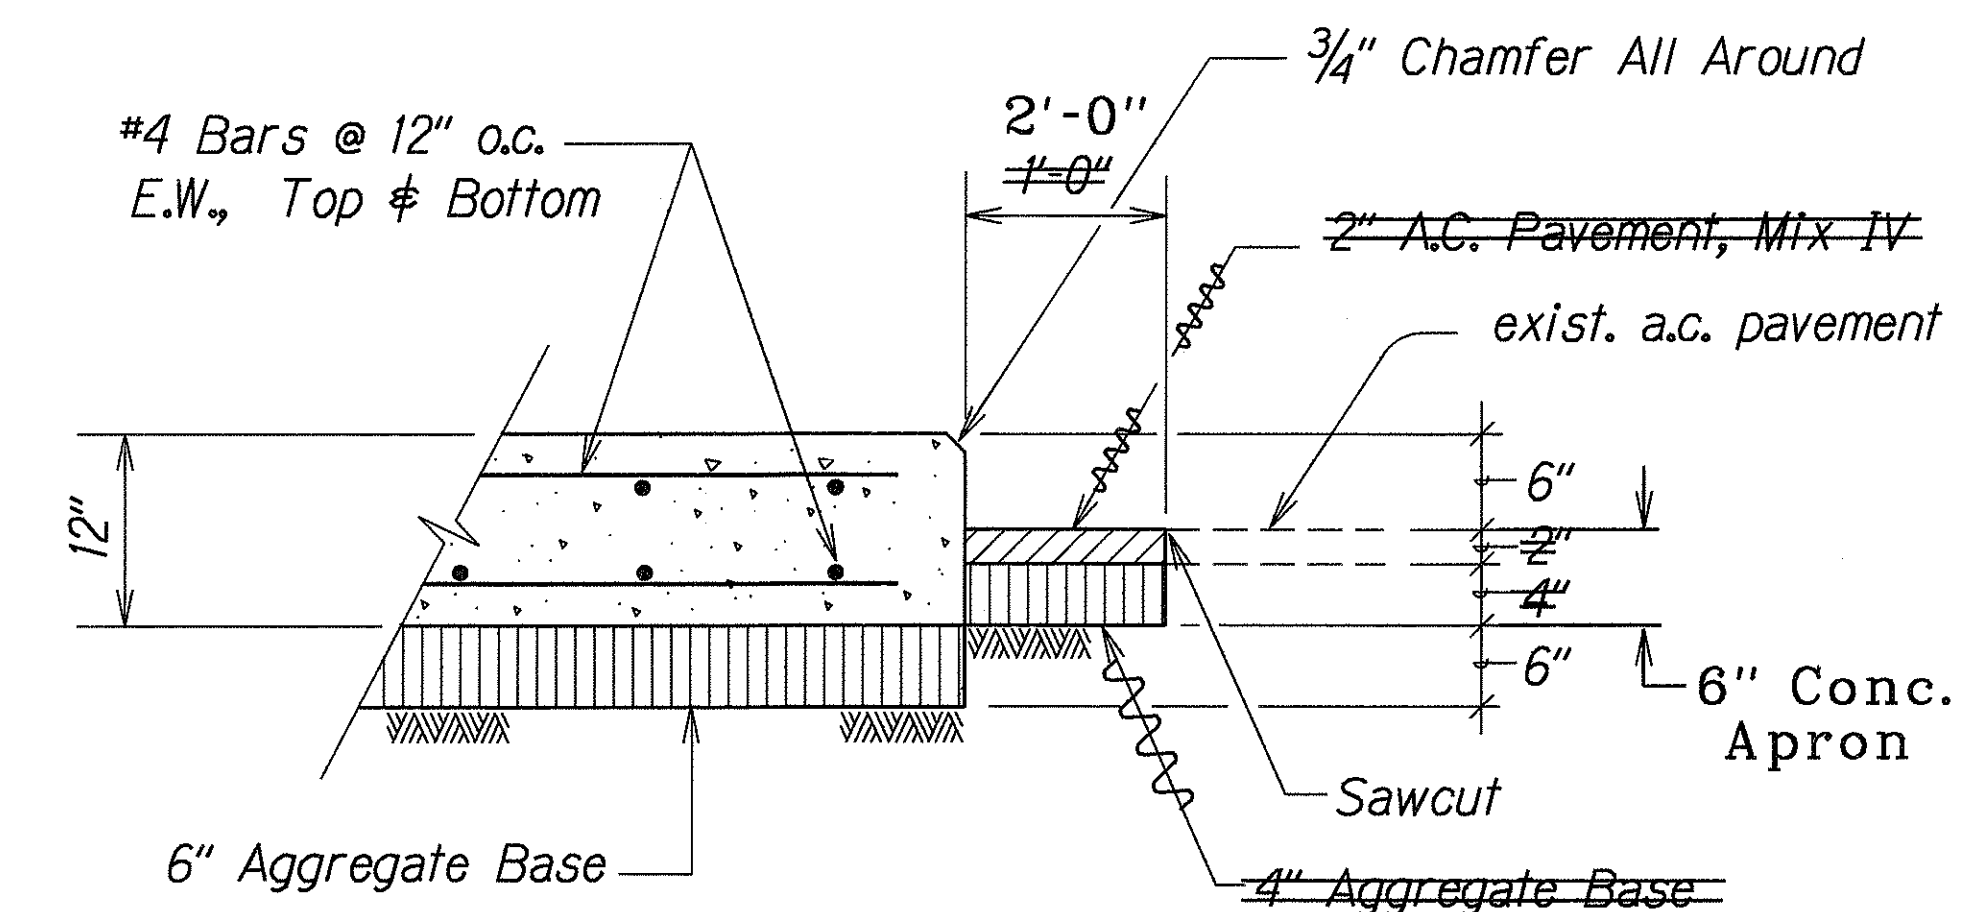

SECTION

Scale: 1" = 1'-0"

A 5 5

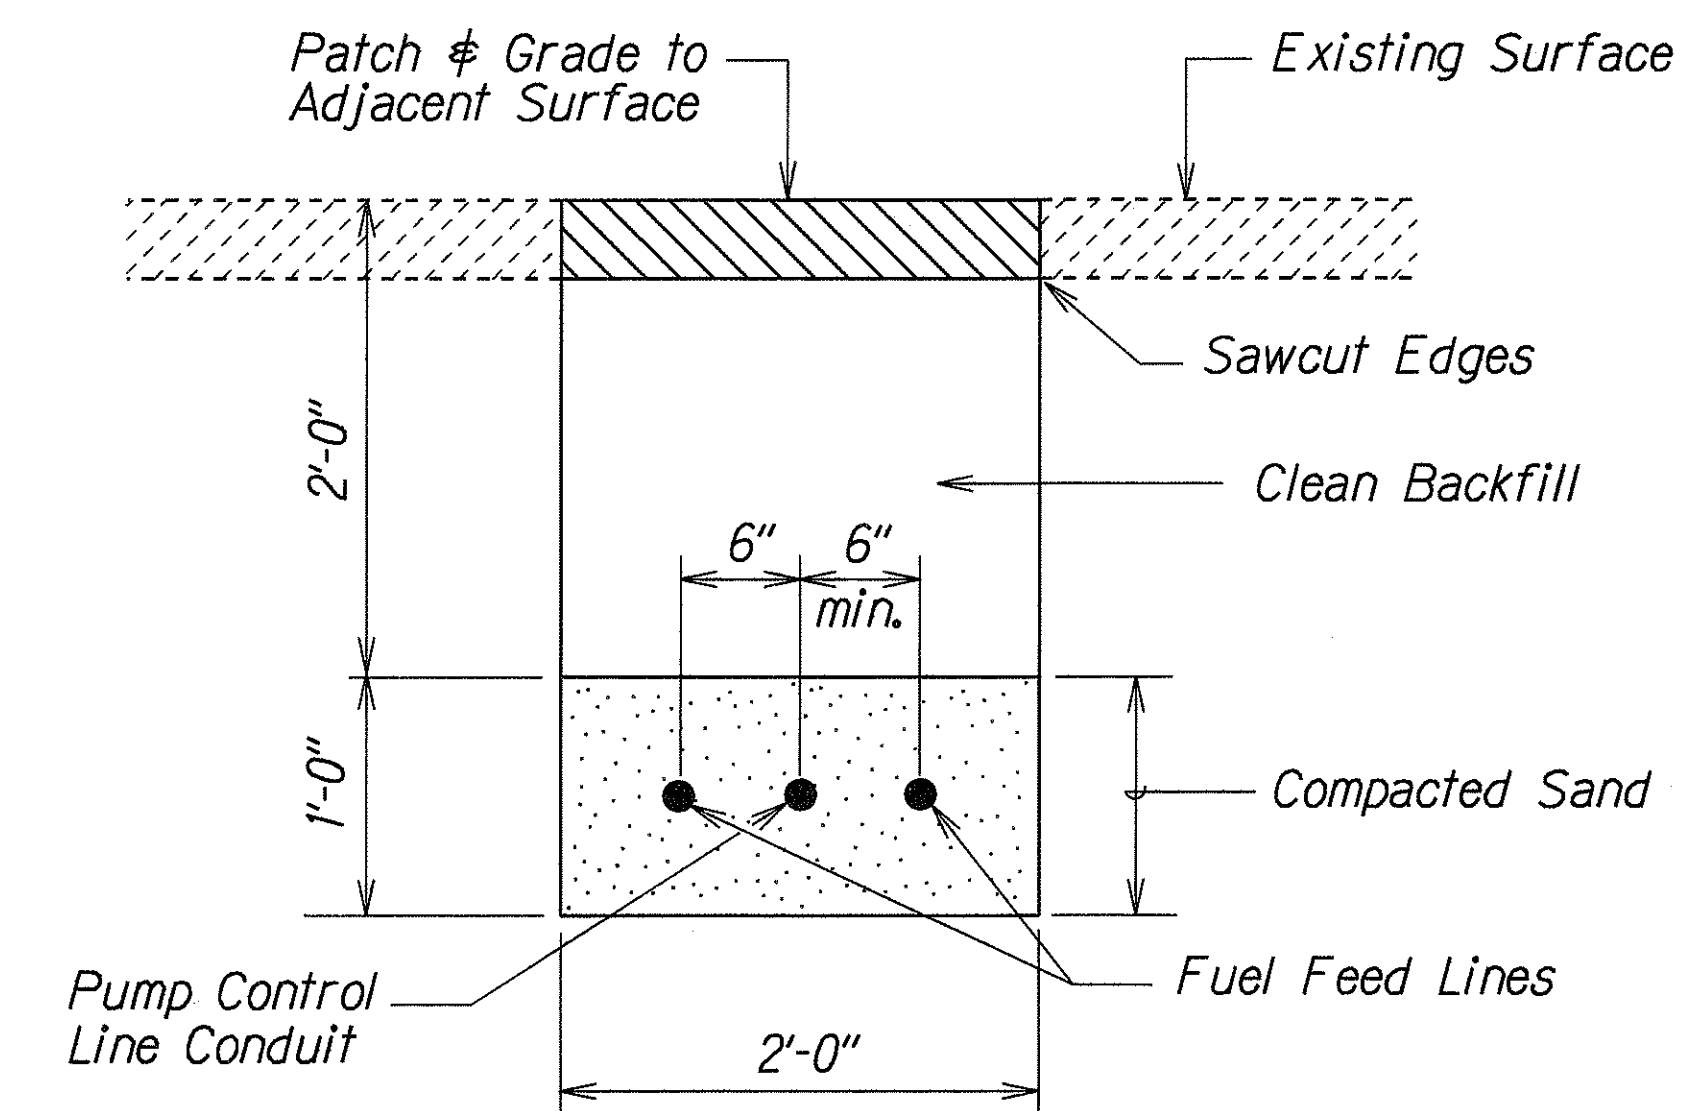

FUEL PIPE TRENCH DETAIL

Not to Scale

TRENCH NOTES:

1. Trench excavation and backfilling shall be considered incidental to Item No. 678.1006 - Fuel Tank, Dispensing and Ticketing System.
2. Trench to be excavated with sawcutting of existing surface.

LEGEND FOR AS-BUILT POSTINGS	
	Squiggly line for as-built deletion
	Double line for as-built deletion
Roadway	Text for as-built posting

STATE OF HAWAII
DEPARTMENT OF TRANSPORTATION
HIGHWAYS DIVISION

CONCRETE SLAB & FUEL PIPE TRENCH DETAILS
KAPAA BASEYARD FUEL STORAGE TANK
AND FUEL DISPENSING SYSTEM
PROJECT NO. HWY-K-01-97
Scale: As Shown Date: November, 1997
SHEET No. 2 OF 8 SHEETS

ORIGINAL PLAN	DATE
SURVEY PLOTTED BY	11-12-91
DRAWN BY	
TRACED BY	
NOTED BY	
CHECKED BY	
APPROVED BY	

"AS-BUILT"