


FED. ROAD DIST. NO.	STATE	PROJ. NO.	FISCAL YEAR	SHEET NO.	TOTAL SHEETS
HAWAII	HAW.	HWY-K-01-97	1998	3	12

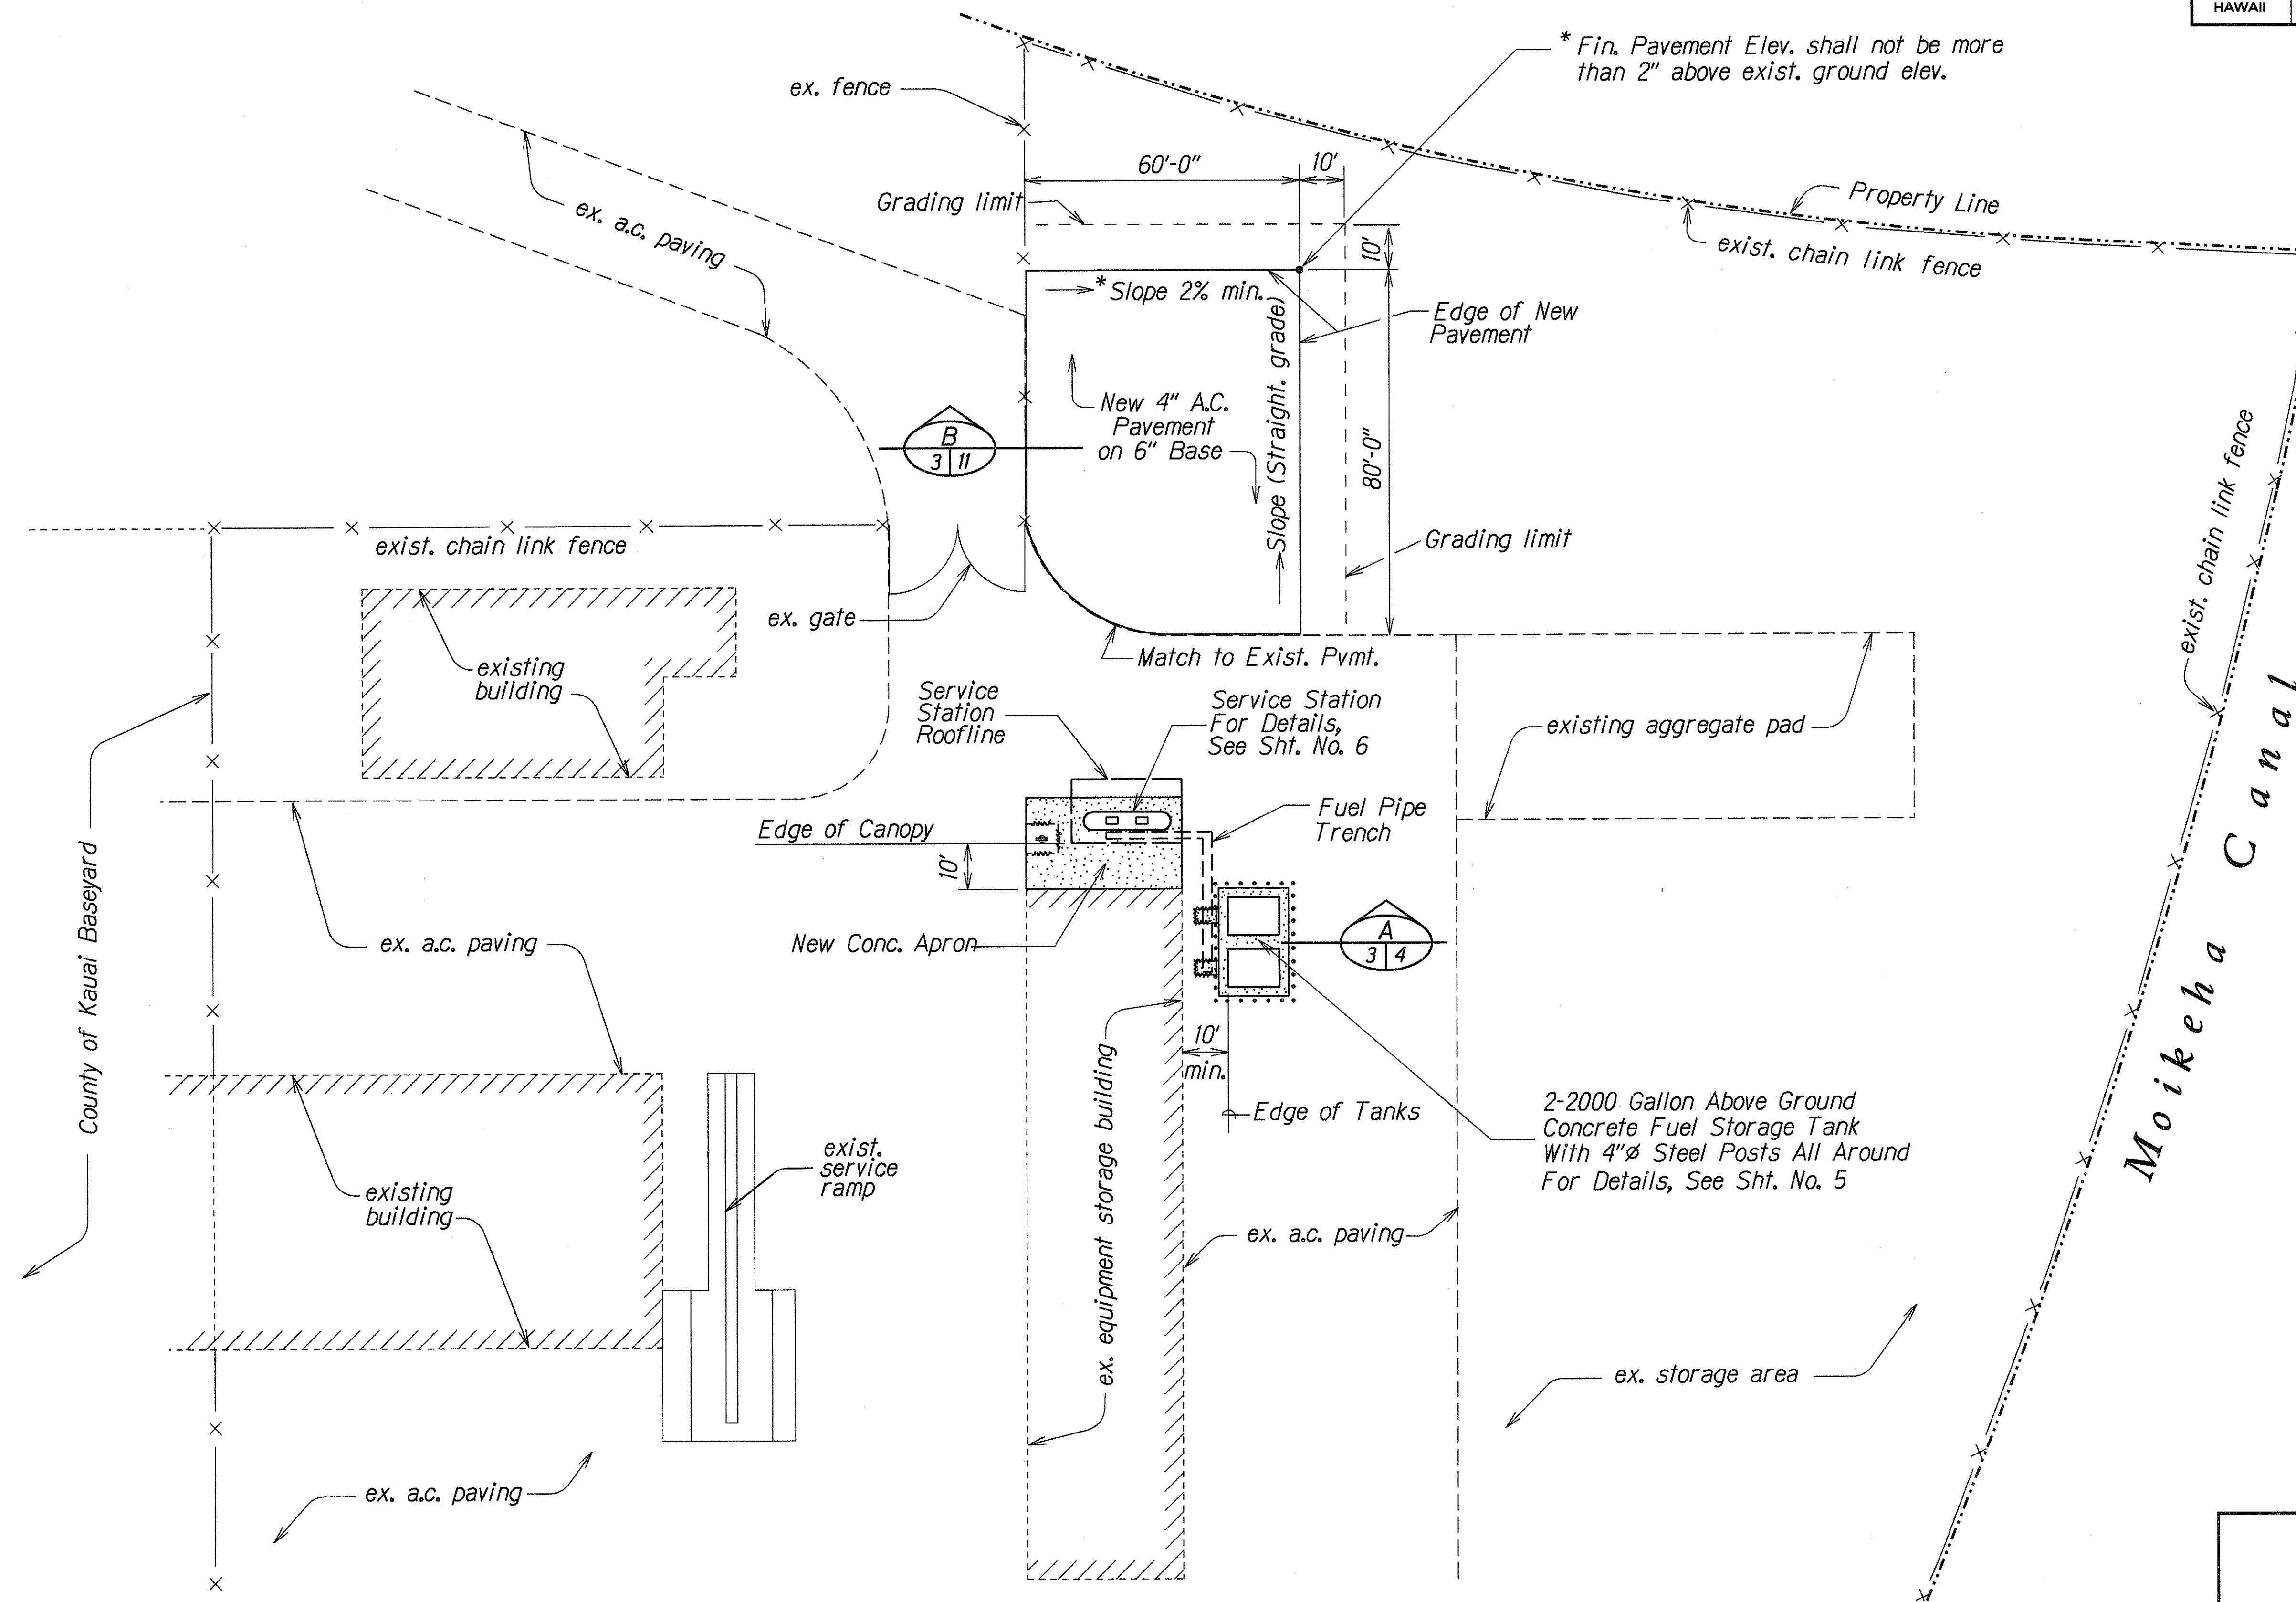

LOCATION PLAN - FUEL STORAGE TANK & FUEL DISPENSING SYSTEM

Scale: 1" = 20'

LEGEND FOR AS-BUILT POSTINGS	
	Squiggly line for as-built deletion
	Double line for as-built deletion
Roadway	Text for as-built posting

STATE OF HAWAII DEPARTMENT OF TRANSPORTATION HIGHWAYS DIVISION	
LOCATION PLAN	
KAPAA BASEYARD FUEL STORAGE TANK AND FUEL DISPENSING SYSTEM	
PROJECT NO. HWY-K-01-97	
Scale: As Shown	Date: November, 1997
SHEET No. 1 OF 1 SHEETS	

"AS-BUILT"