

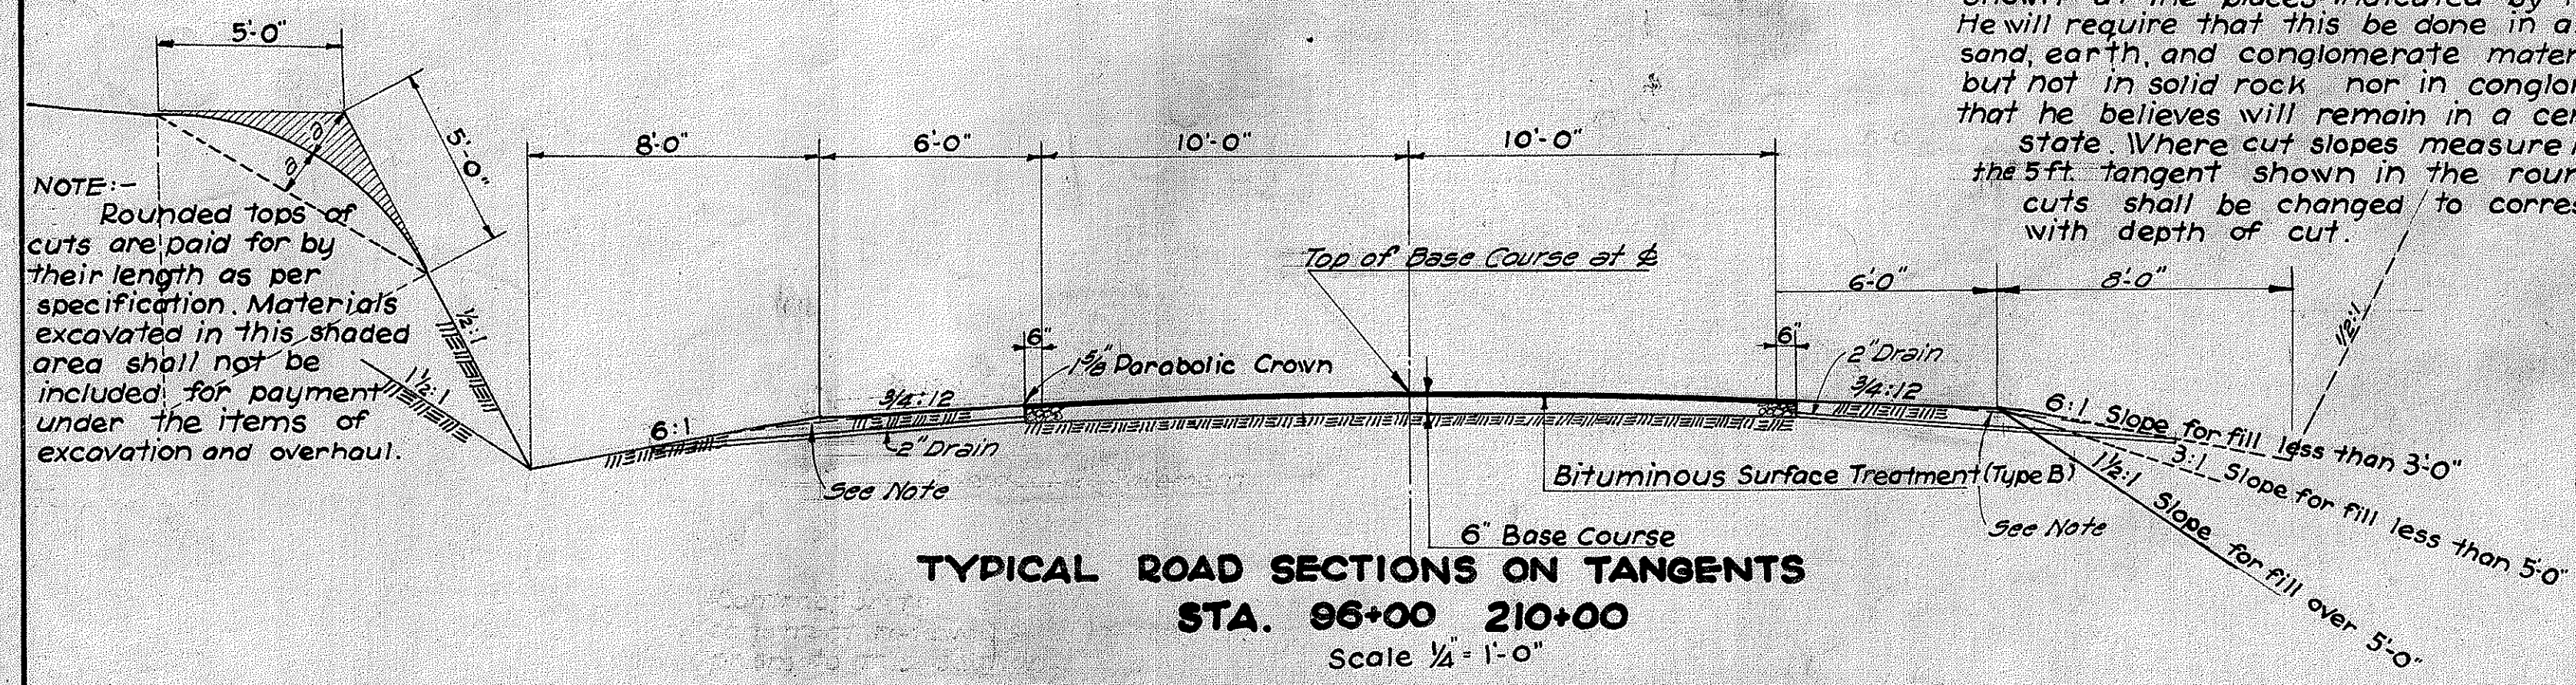
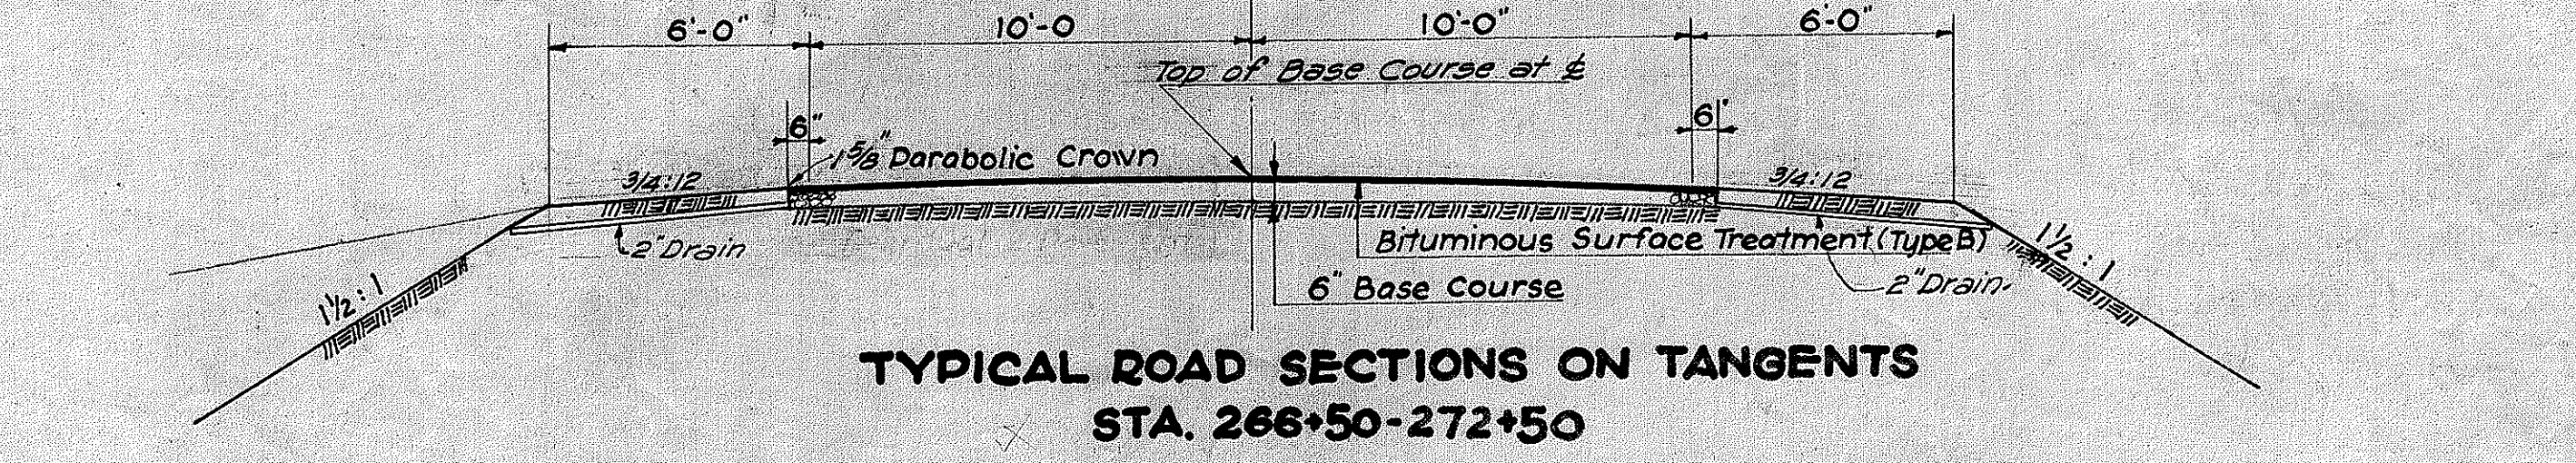
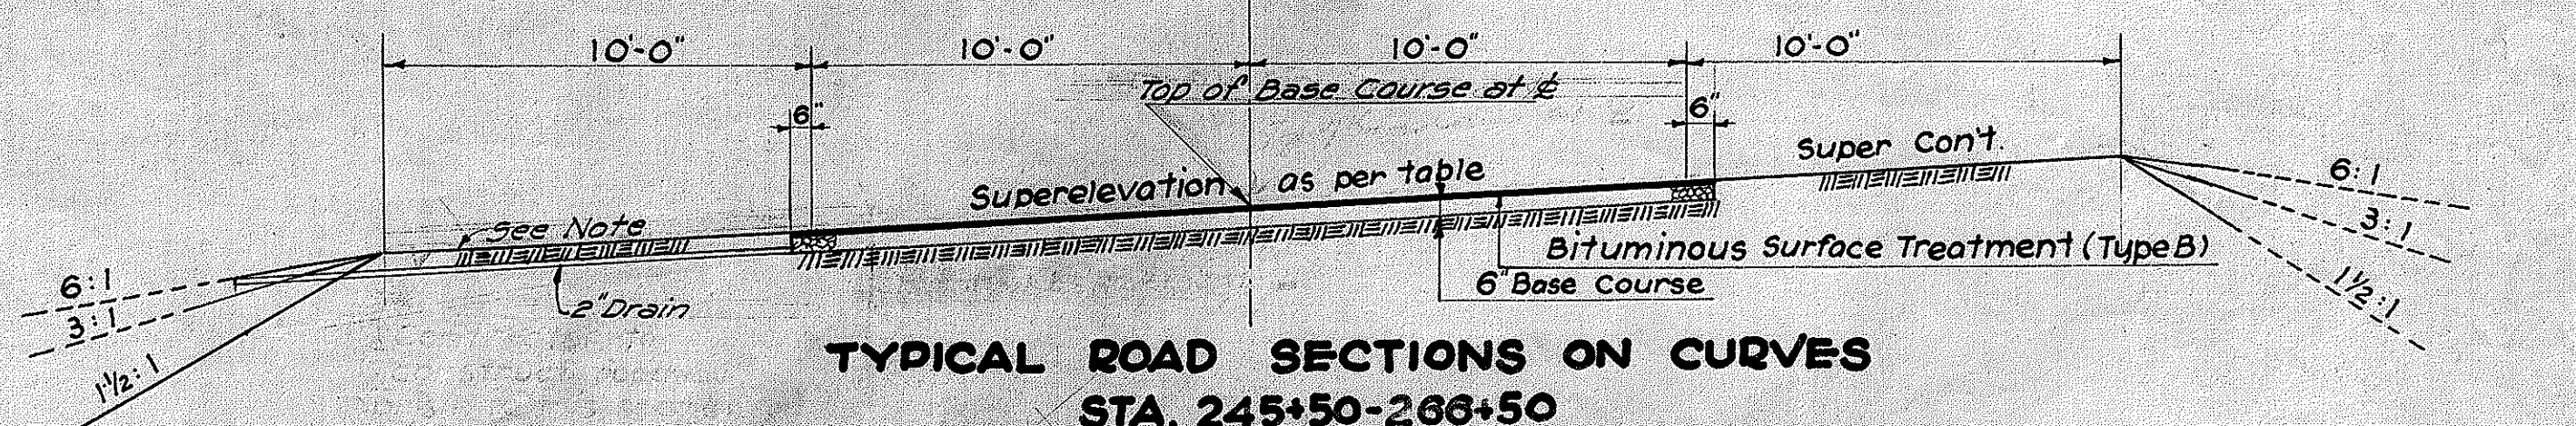
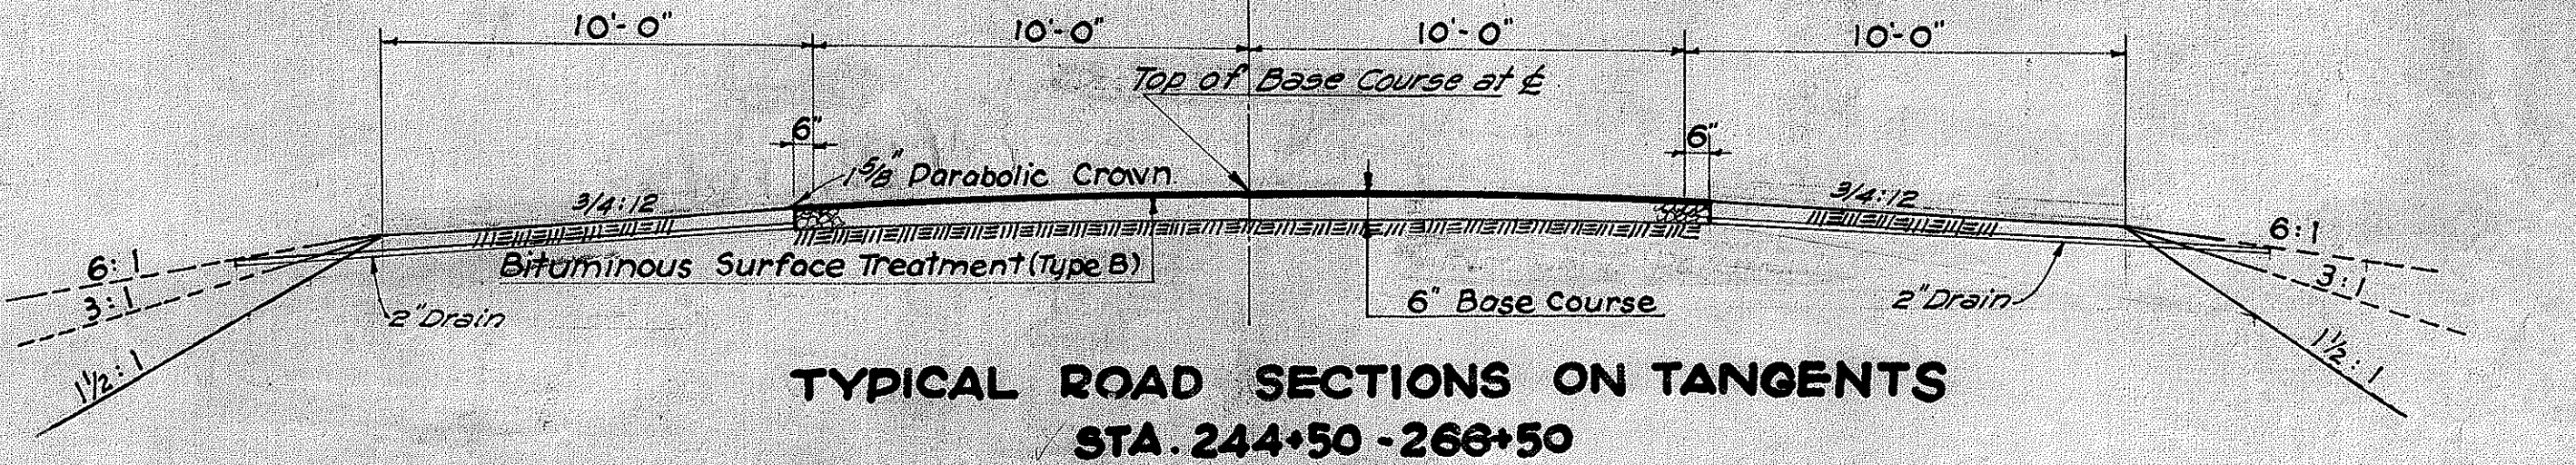


FED. ROAD DIST. NO.	STATE	FED. AID PROJ. NO.	FISCAL YEAR	SHEET NO.	TOTAL SHEETS
HAWAII	HAW.	12-U	1938	2	60

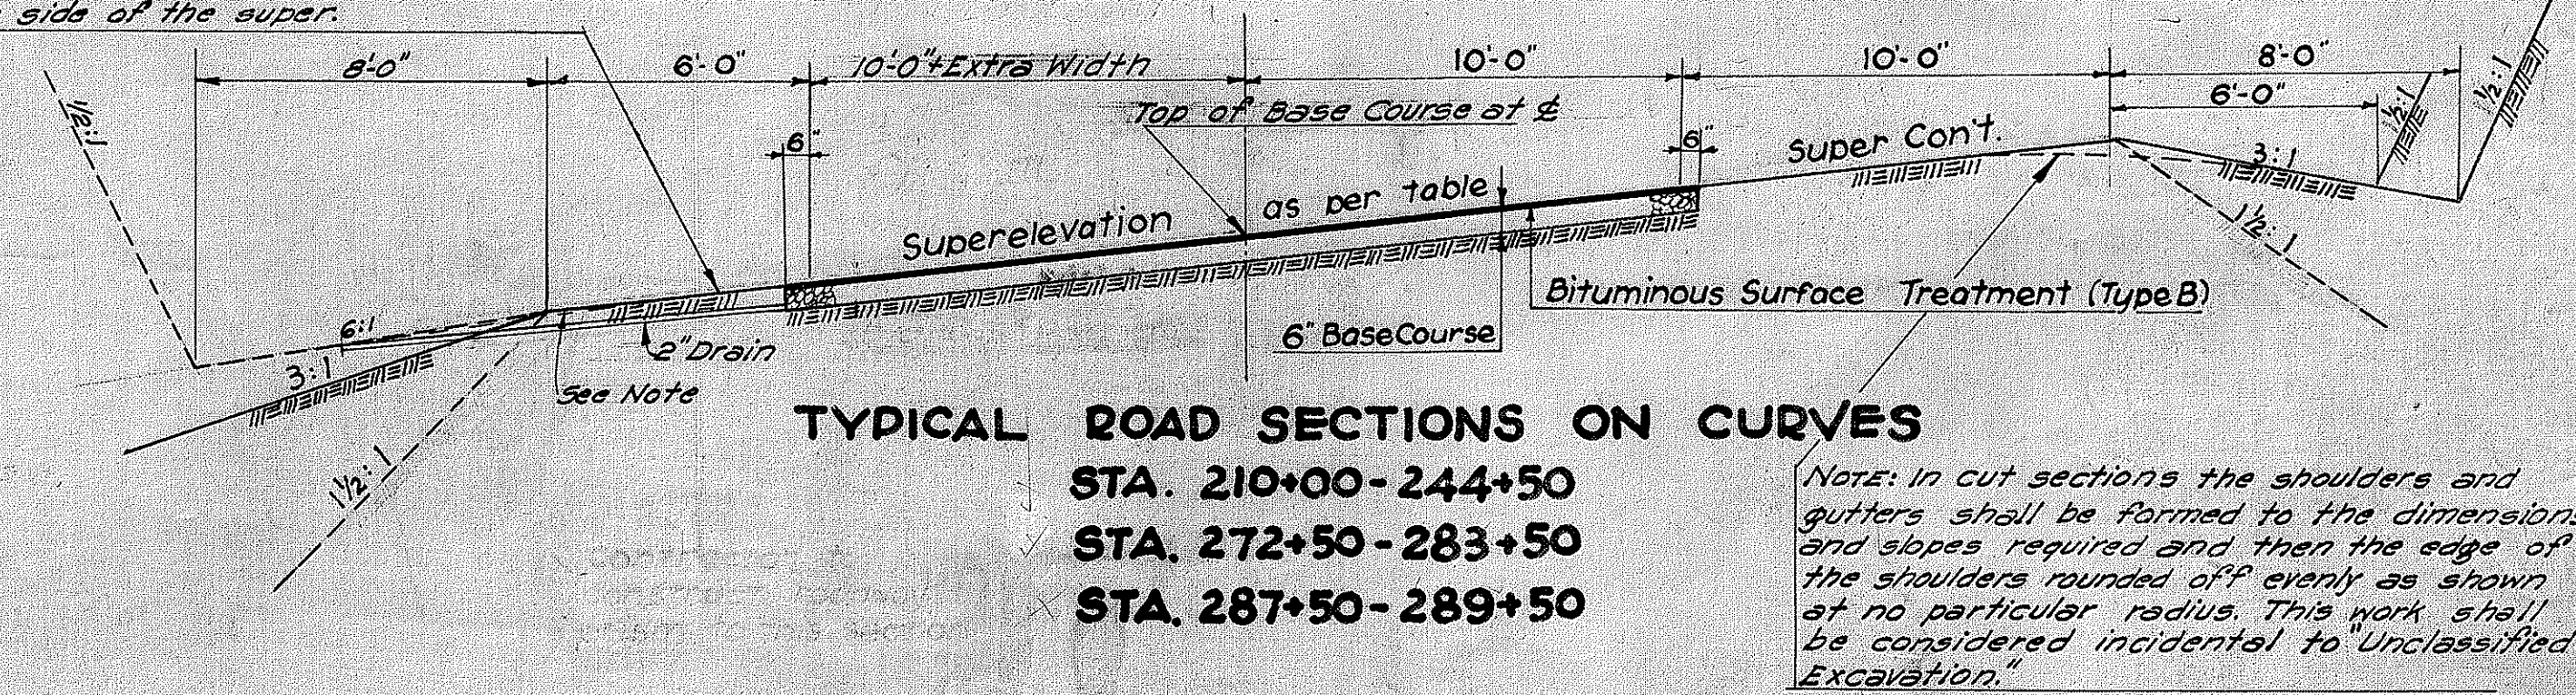

NOTE: When super is less than 0.063 ft. per ft. shoulder slope is 3/4:12. When super is equal to, or greater than 0.063 ft. per ft. shoulder slope is the same as the rate of super. This note applies only to the shoulder on the lower side of the super.

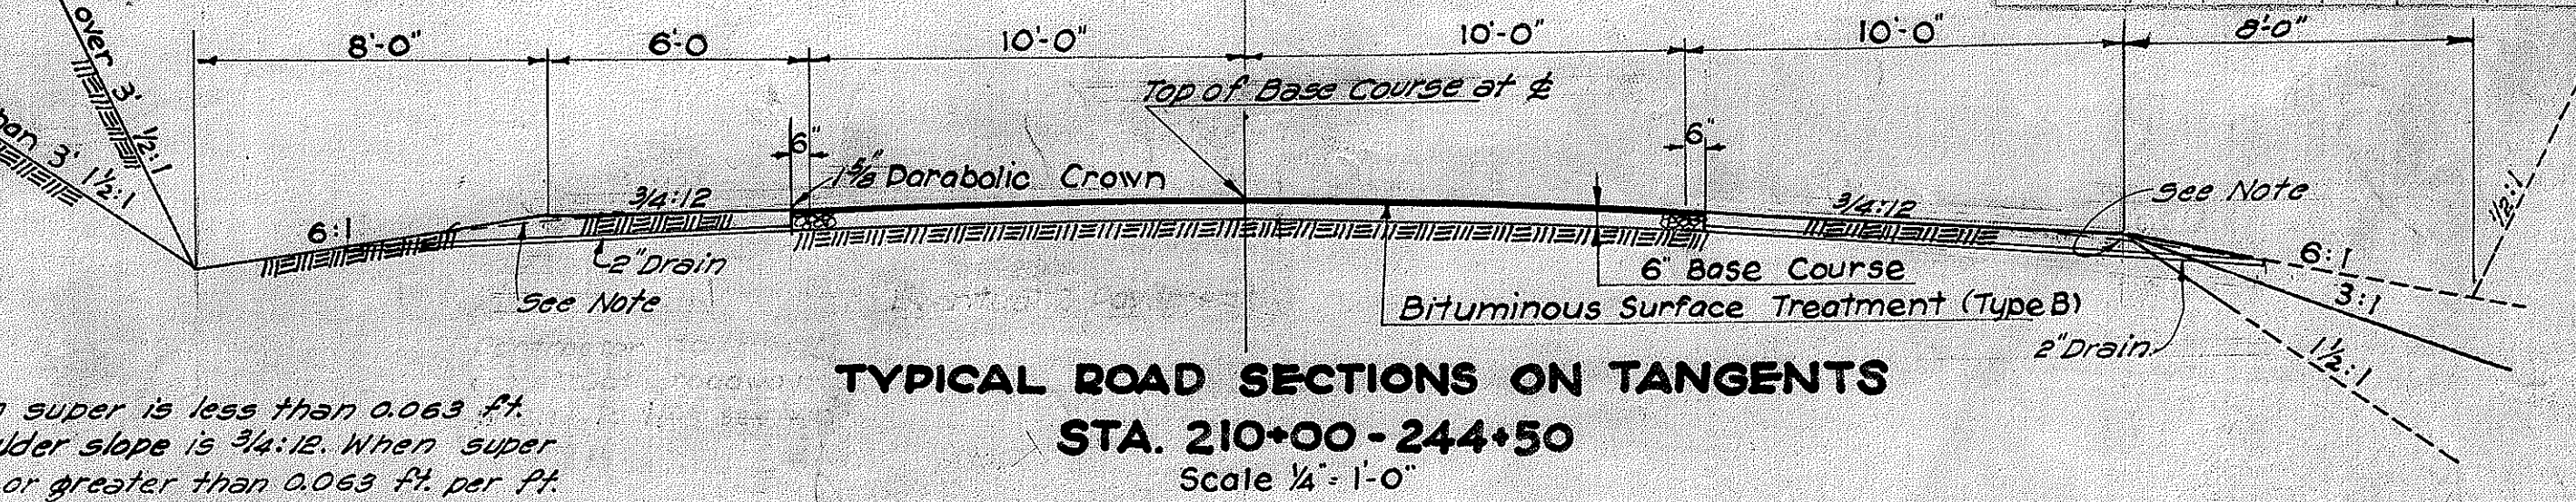

NOTES ON BASE COURSE & SURFACE TREATMENT

BASE COURSE:-- Waterbound Macadam 6" Compacted Thickness

BITUMINOUS SURFACE TREATMENT:-- Type B

TERRITORIAL HIGHWAY DEPARTMENT
TERRITORY OF HAWAII

TYPICAL ROAD SECTIONS
KAUAI BELT ROAD F.A.P. 12-U


SHEET NO. 1 OF 2 SHEETS.

ORIGINAL PLAN	DATE
NOTED BY	DATE
DESIGNED BY	DATE
CHECKED BY	DATE
APPROVED BY	DATE


4438.2

FED. ROAD DIST. NO.	STATE	FED. AID PROJ. NO.	FISCAL YEAR	SHEET NO.	TOTAL SHEETS
HAWAII	HAW.	12-U	1938	3	60


REVISED 3/30/38

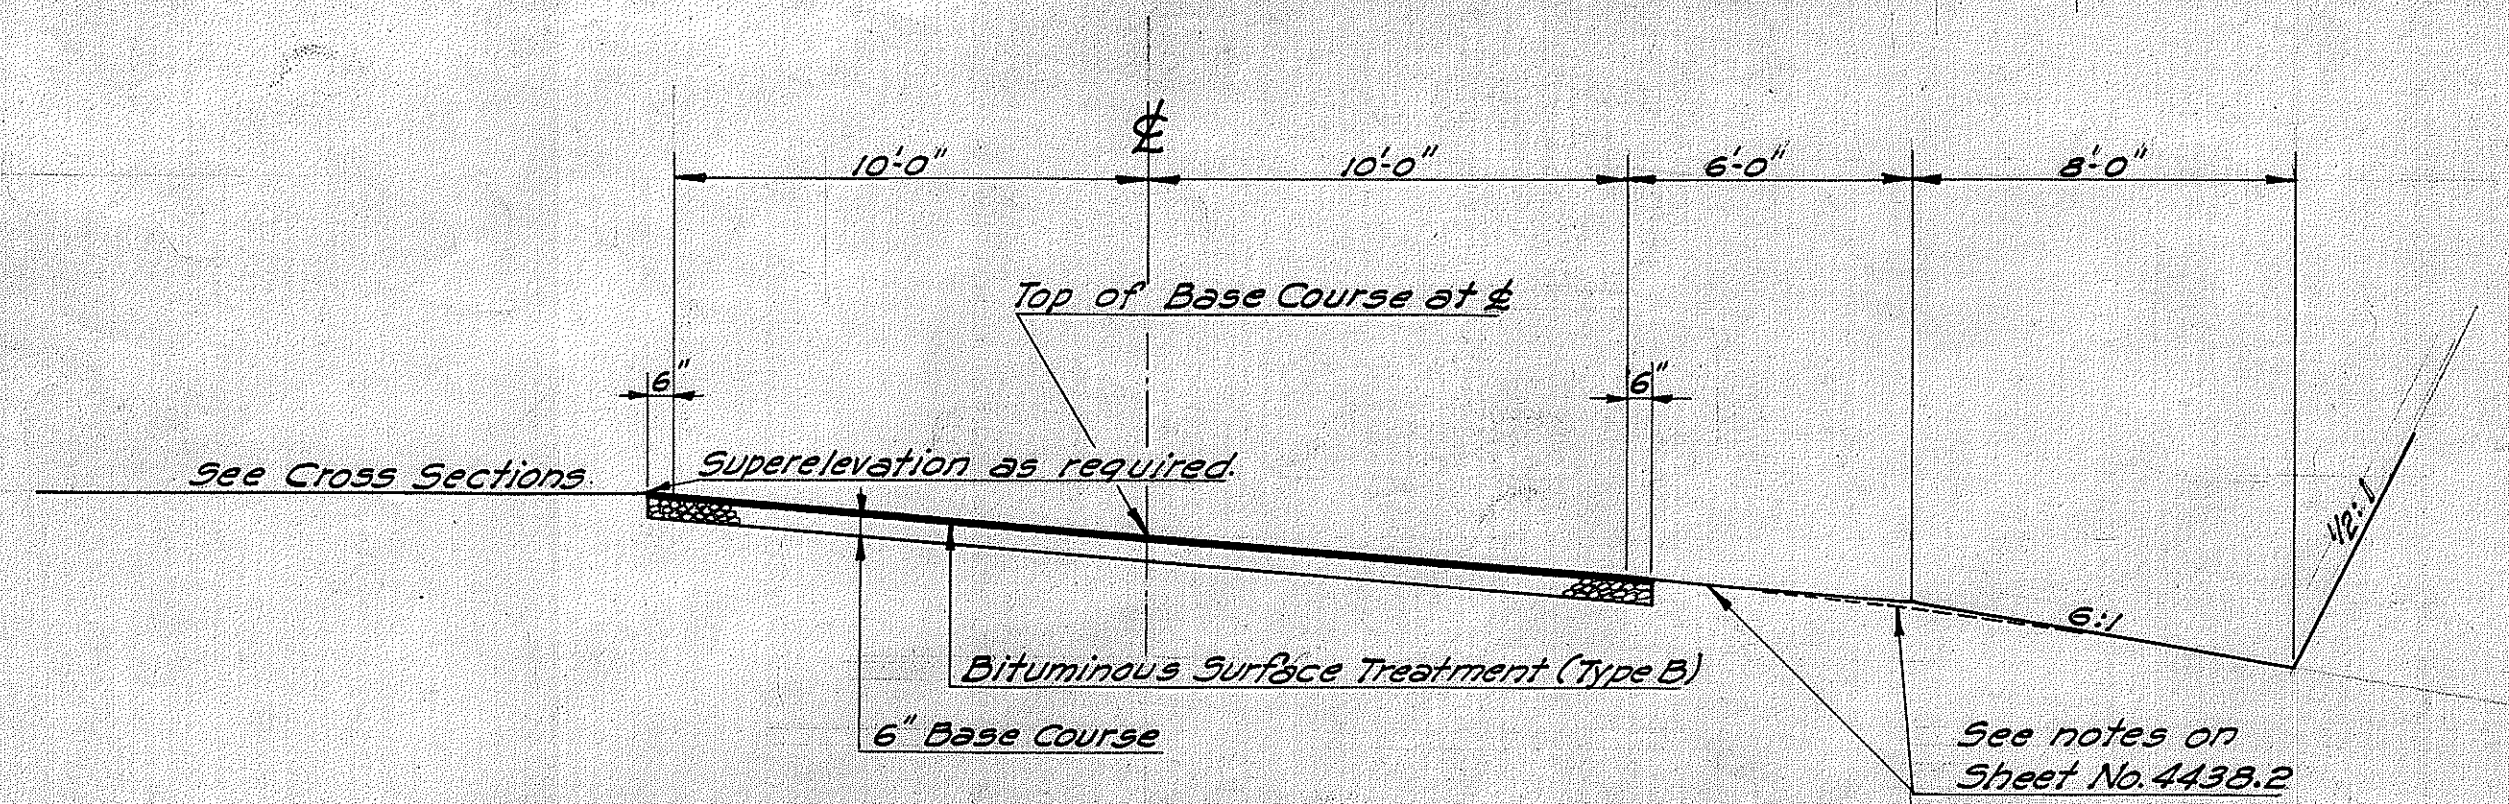


TYPICAL ROAD SECTION ON CURVES
PORT ALLEN SPUR
Scale: 1/4"=1'-0"

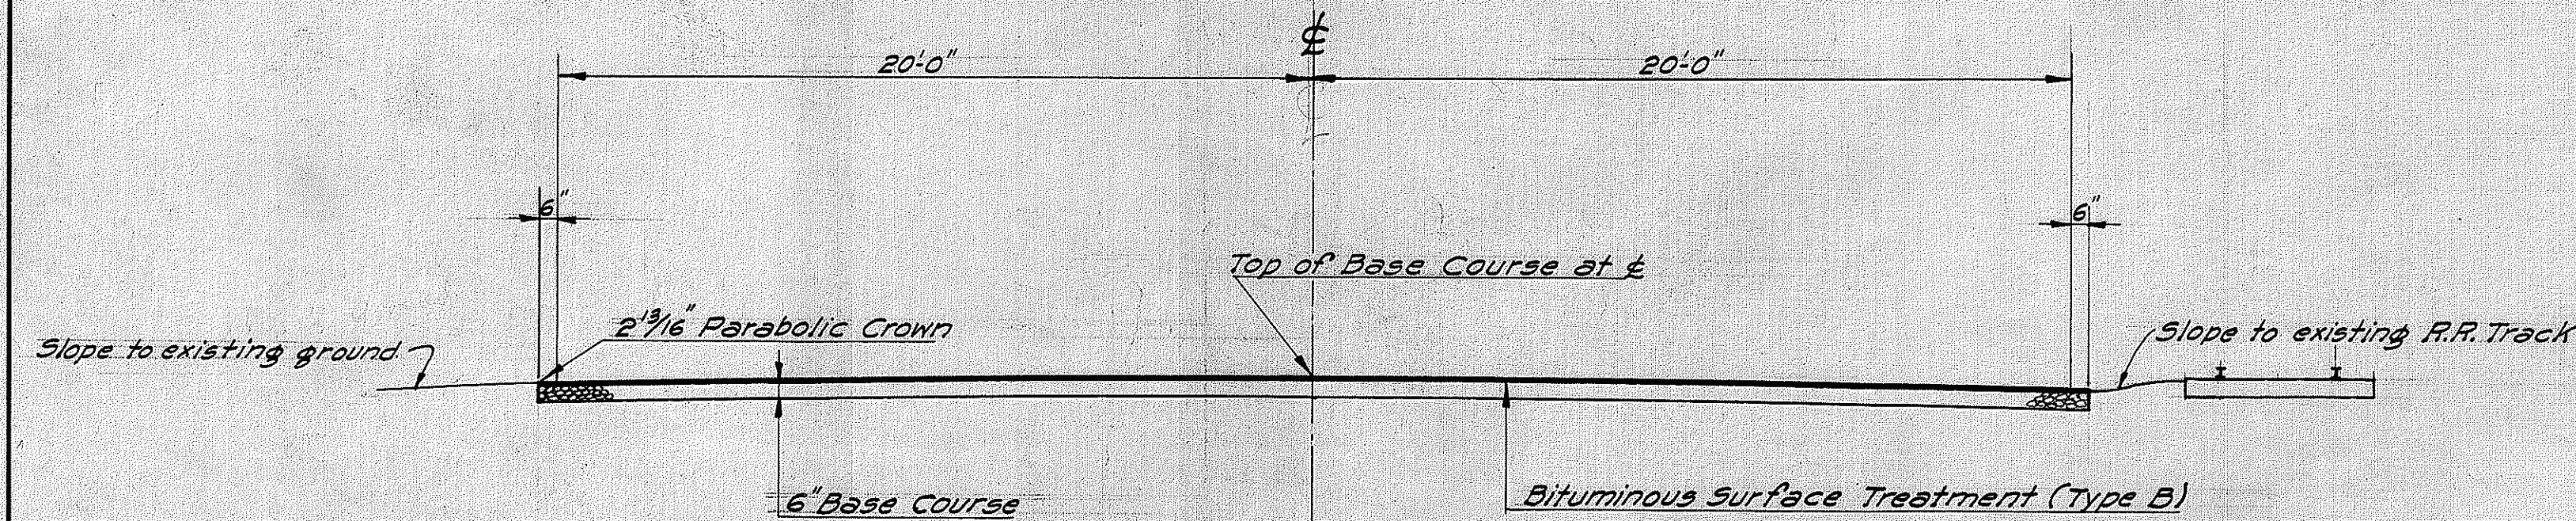


TYPICAL ROAD SECTION STA. 0+00 TO 5+50
PORT ALLEN SPUR
Scale: 1/4"=1'-0"

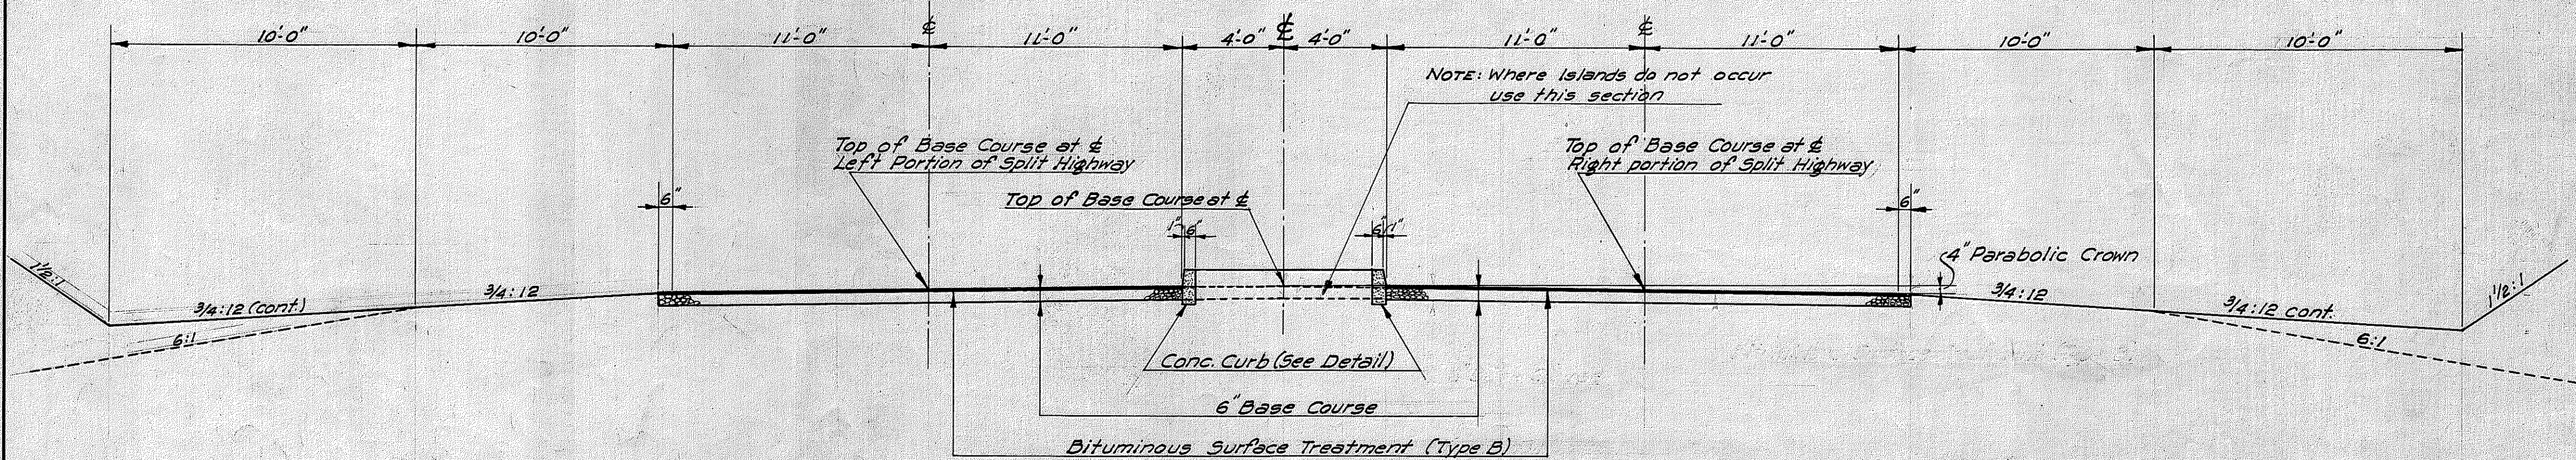


TYPICAL ROAD SECTION ON SPLIT HIGHWAY
PORT ALLEN SPUR
Scale: 1/4"=1'-0"

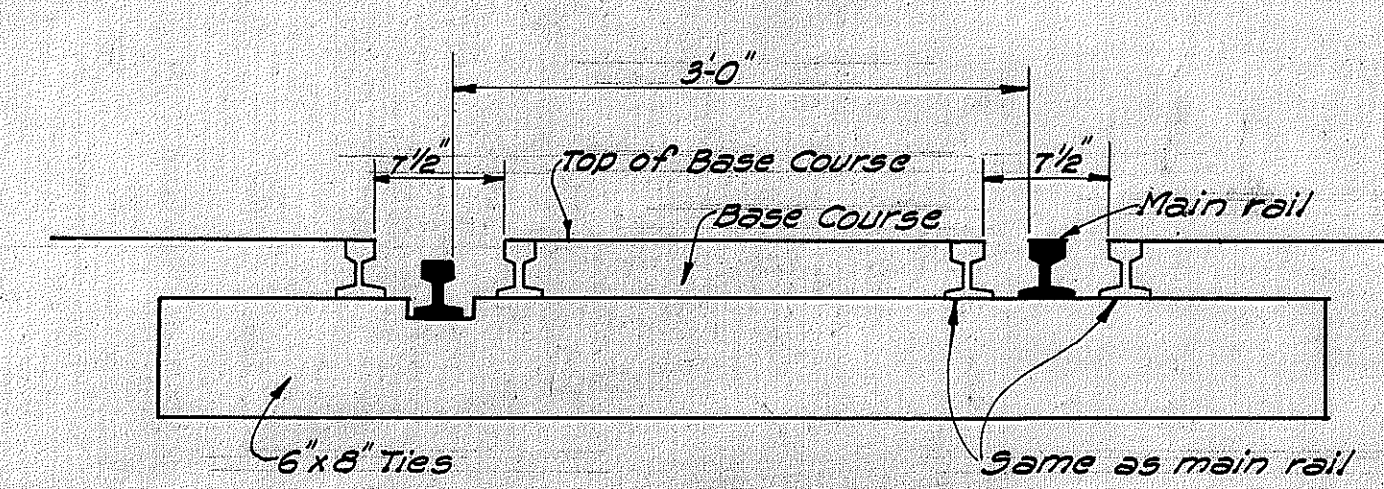


SECTION
Scale: 1 1/2"=1'-0"

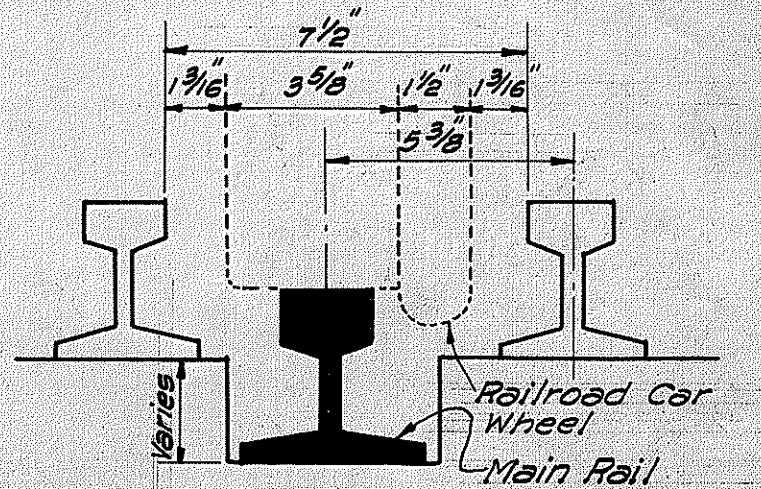


DETAIL OF RAIL SLOT
Scale: 3"=1'-0"

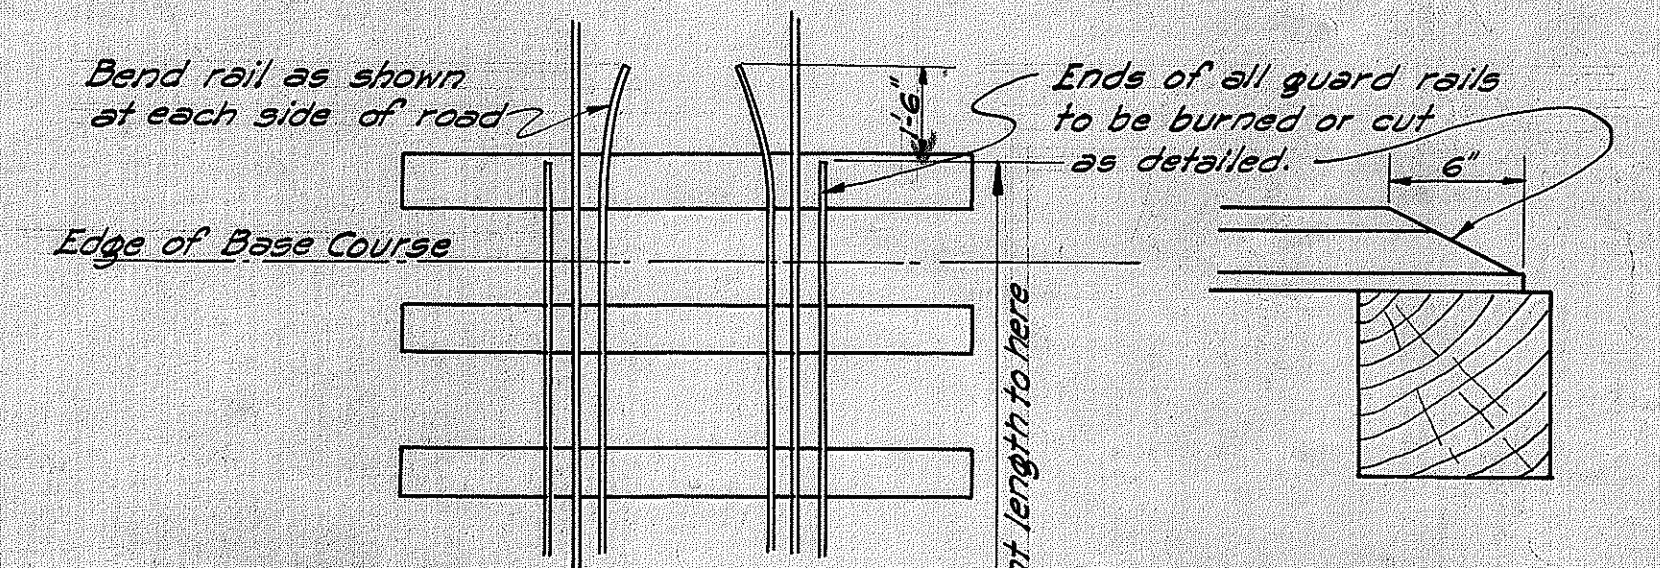


PART PLAN
Scale: 3/8"=1'-0"
DETAIL OF INDUSTRIAL TRACK CROSSING

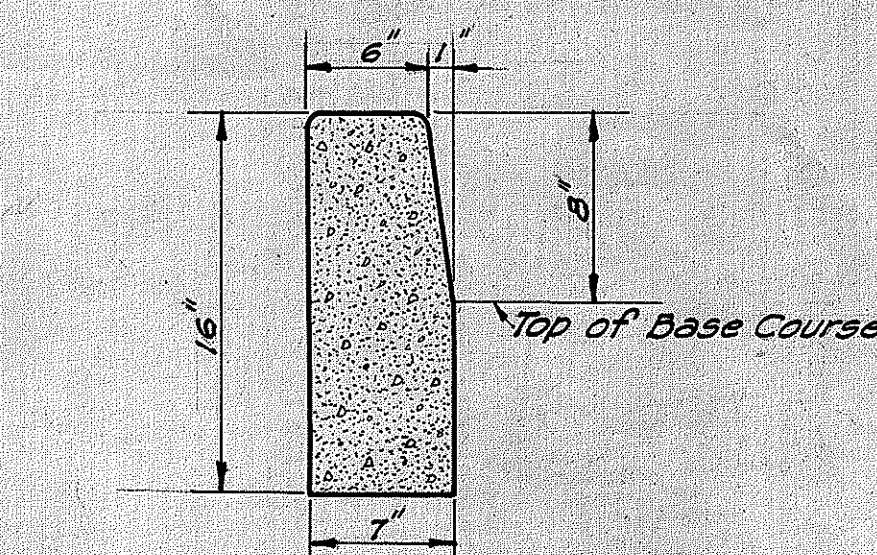

DETAIL OF CONC. CURB
Scale: 1 1/2"=1'-0"

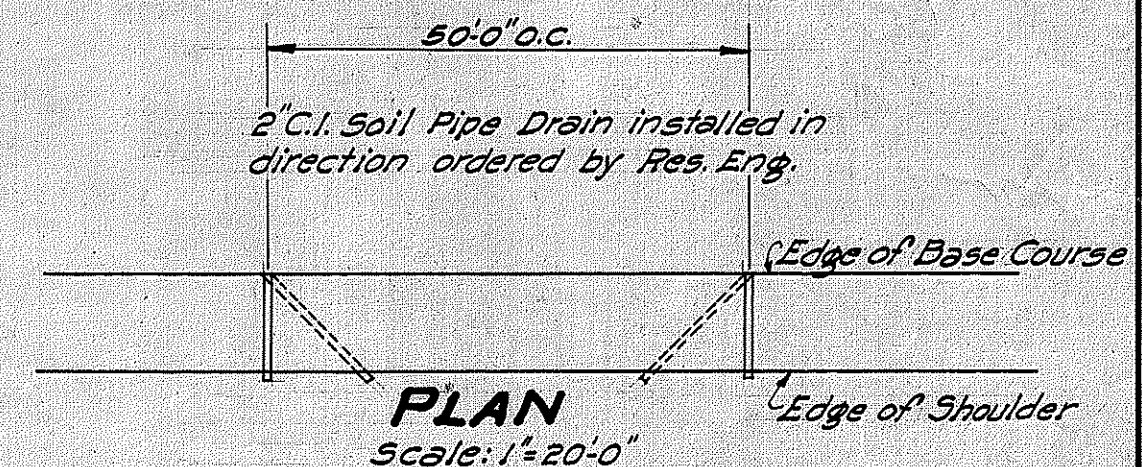

PLAN
Scale: 1"=20'-0"

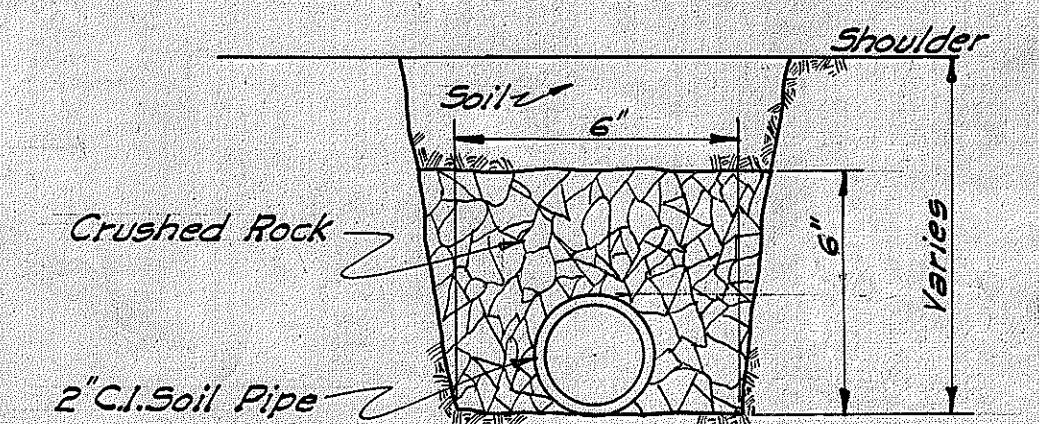

SECTION
Scale: 3"=1'-0"

DETAIL C.I. SOIL PIPE DRAIN

TERRITORIAL HIGHWAY DEPARTMENT
TERRITORY OF HAWAII

**TYPICAL ROAD SECTIONS
AND DETAILS**
KAUAI BELT ROAD F.A.P. 12-U

SHEET NO 2 OF 2 SHEETS

4438.3

SURVEY PLOTTED BY	DATE
DRAWN BY	2/25
NOTED BY	L.F.
CHECKED BY	L.F.
QUANTITIES CHECKED BY	L.F.
NO.	2