



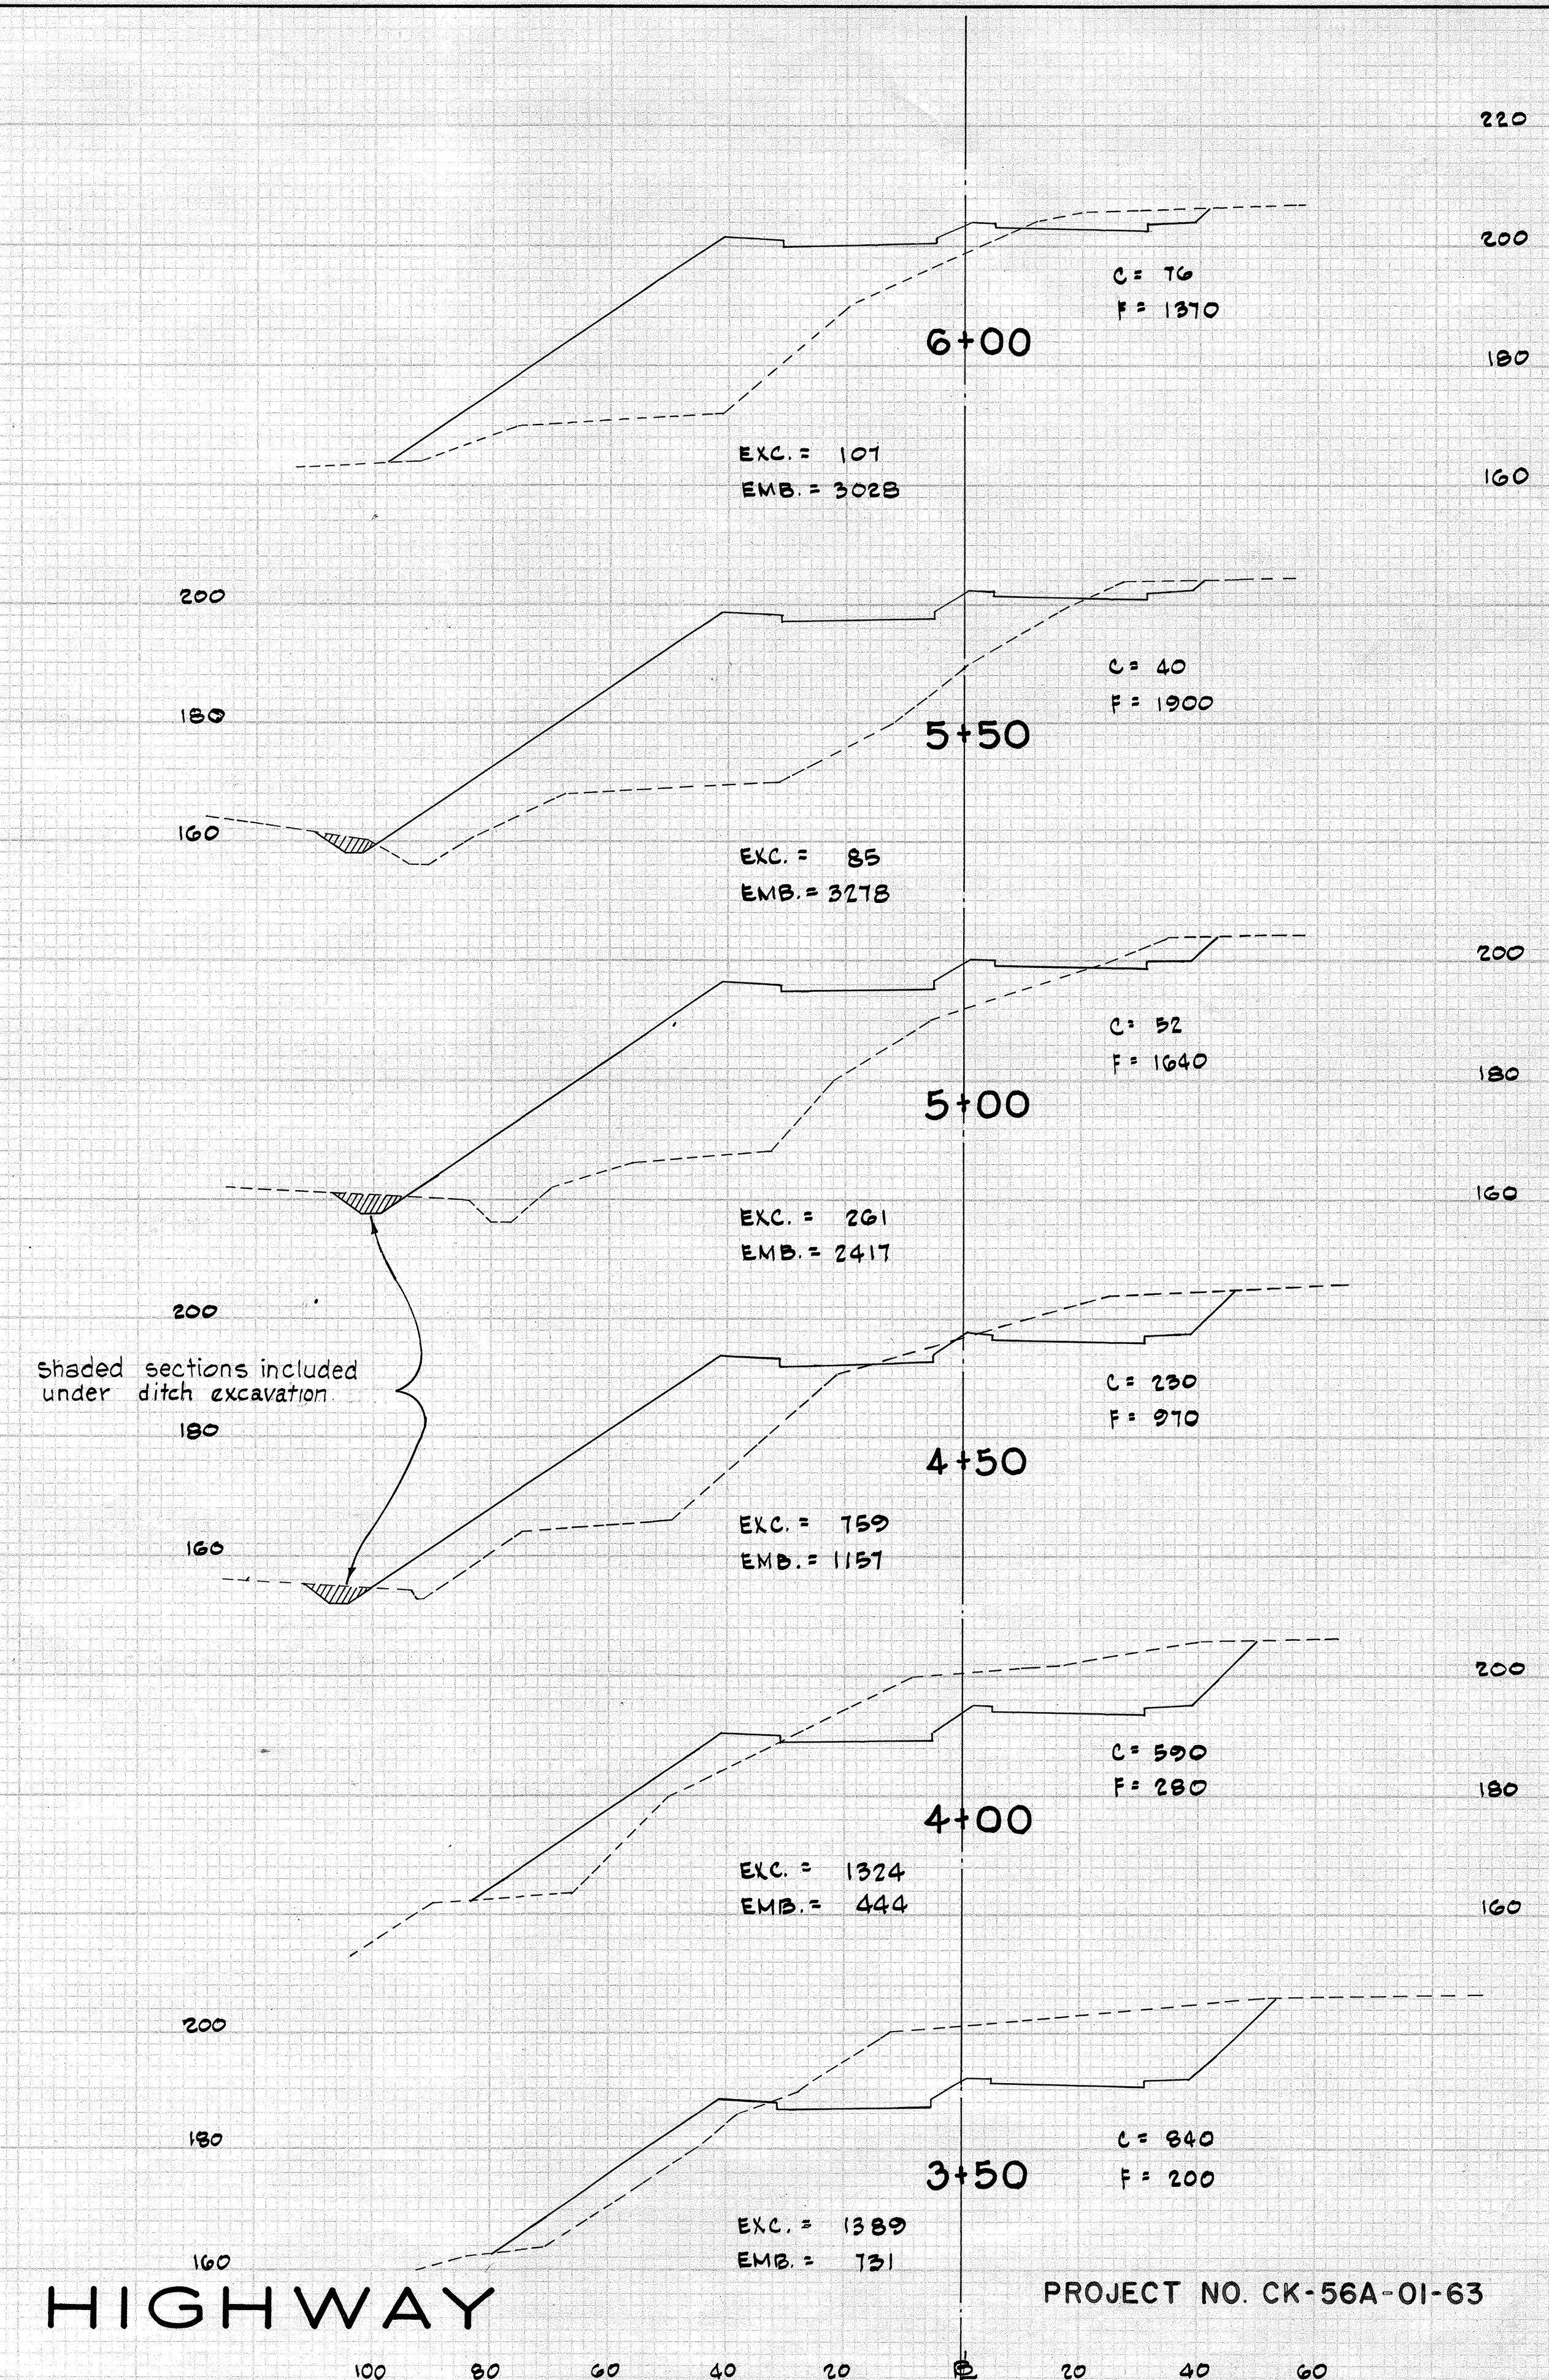

KUHIO HIGHWAY

PROJECT NO. CK-56A-01-63

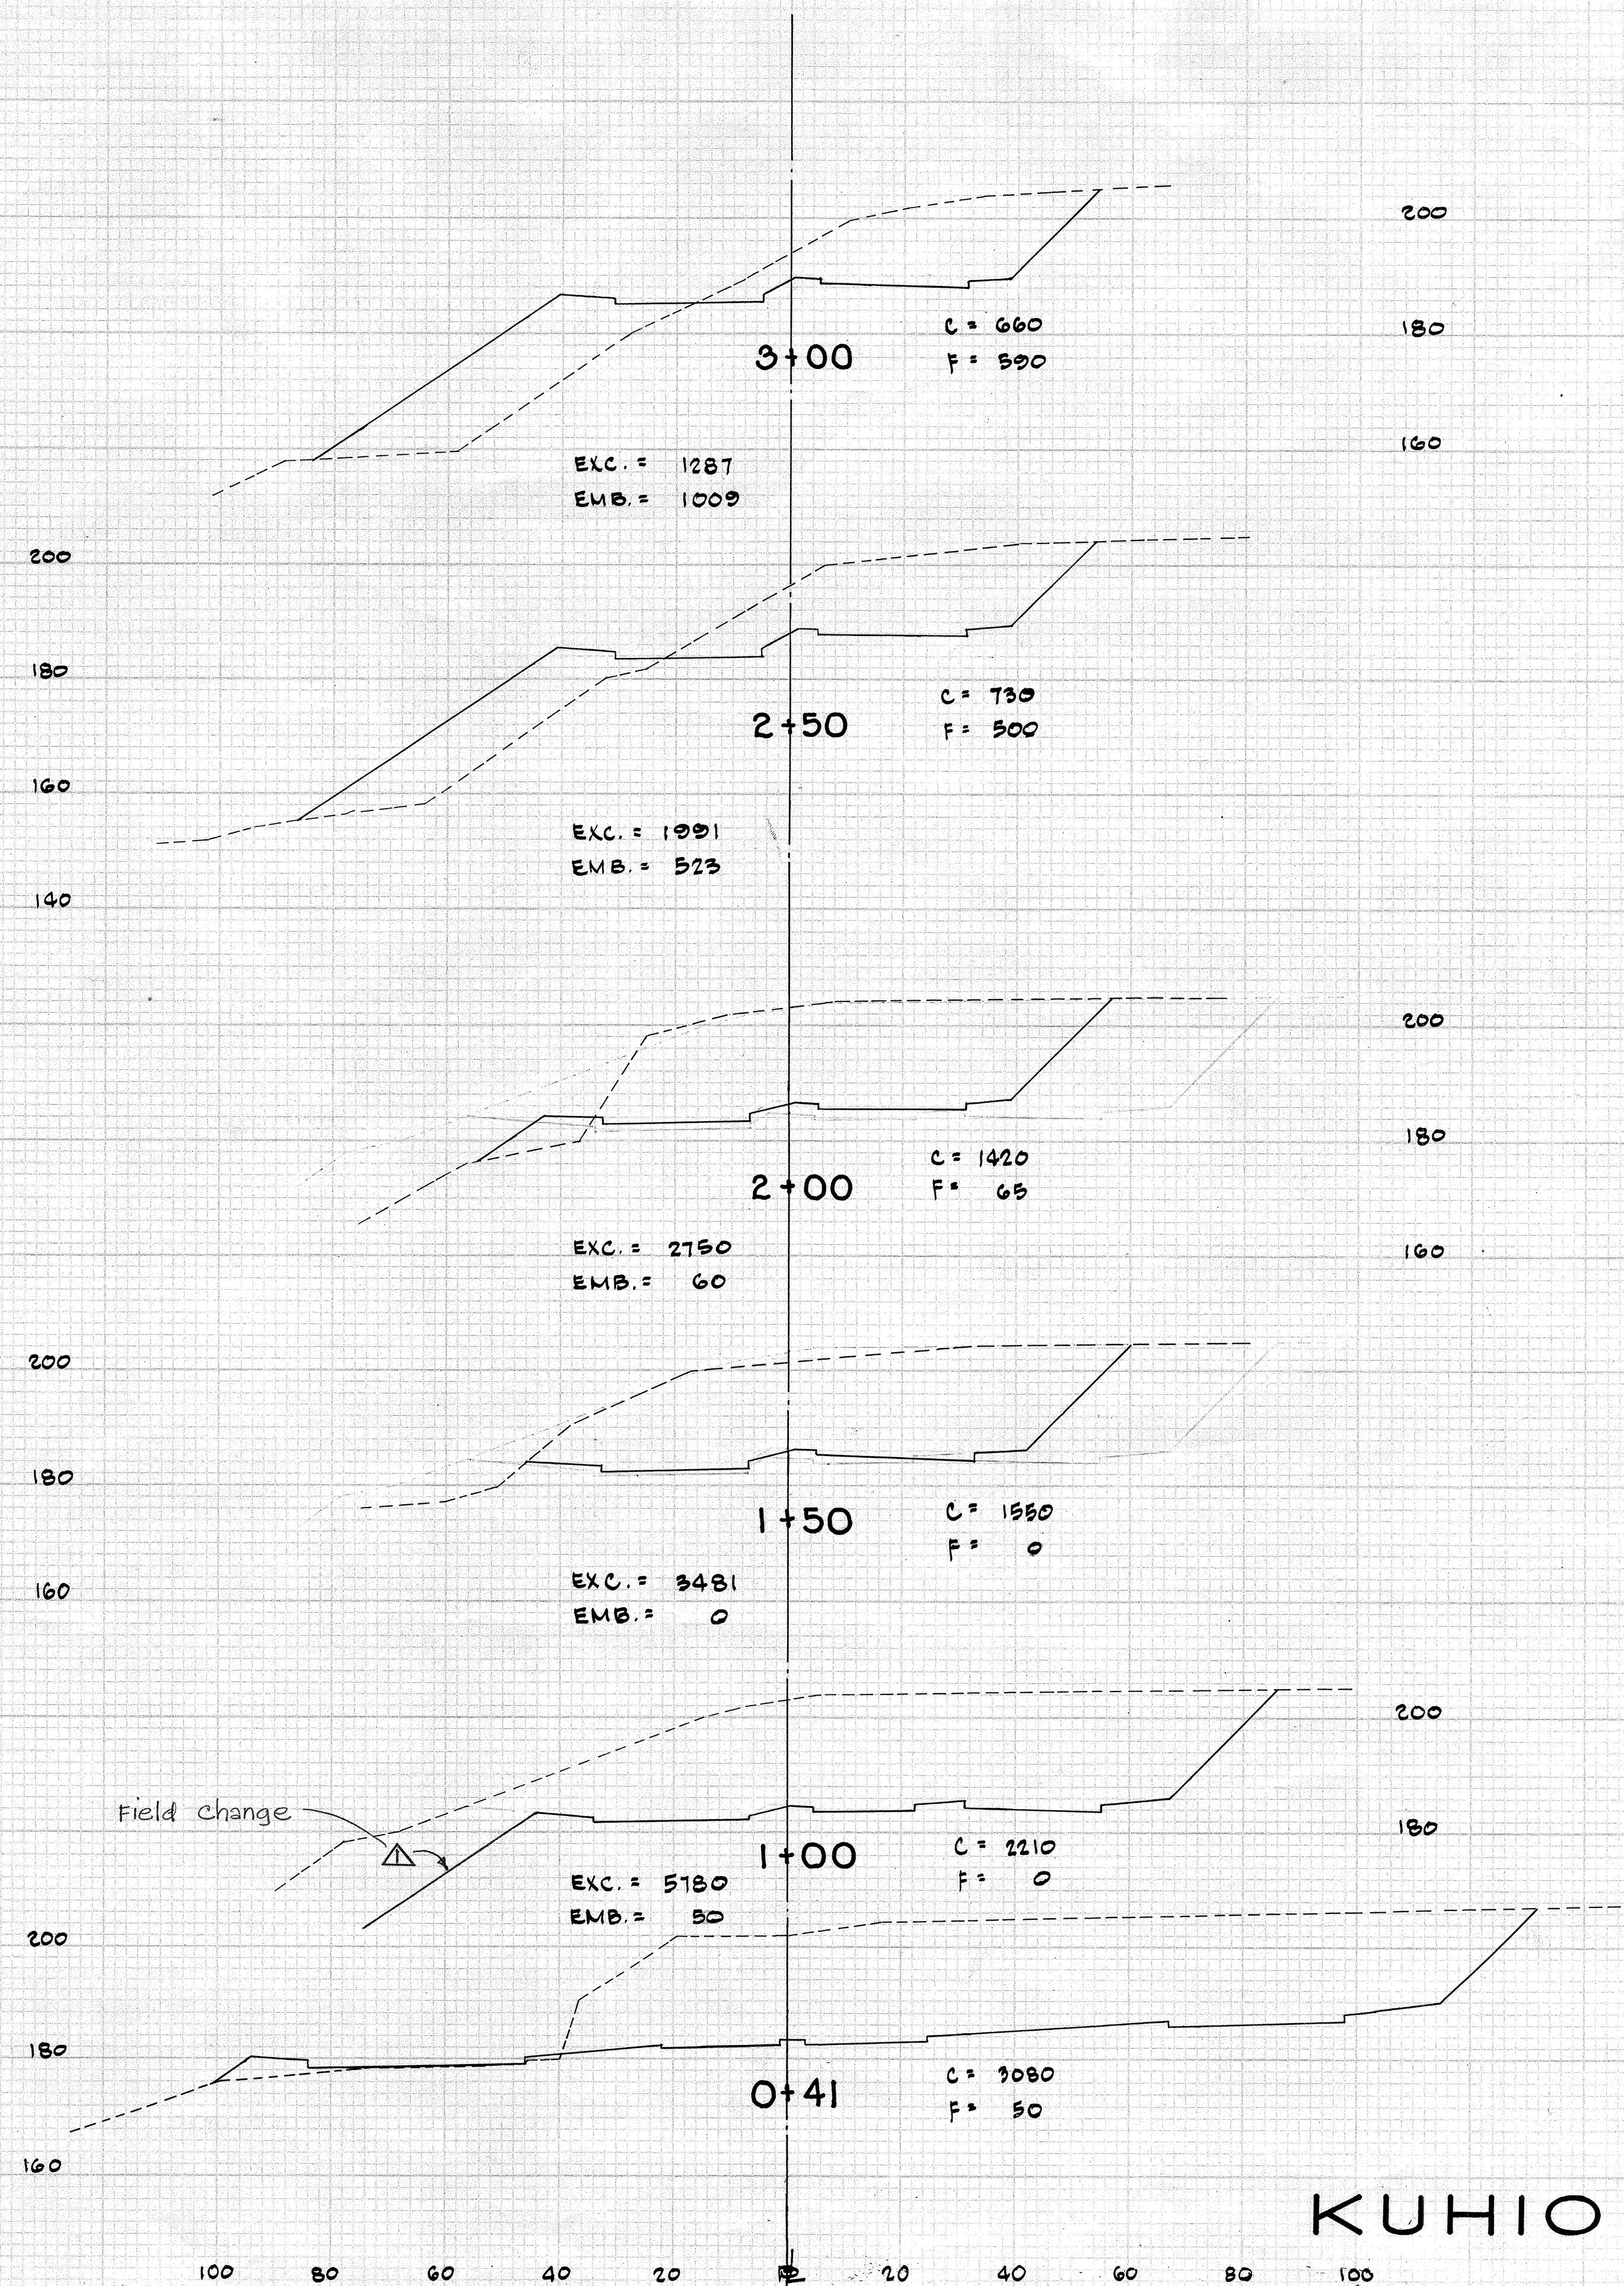