

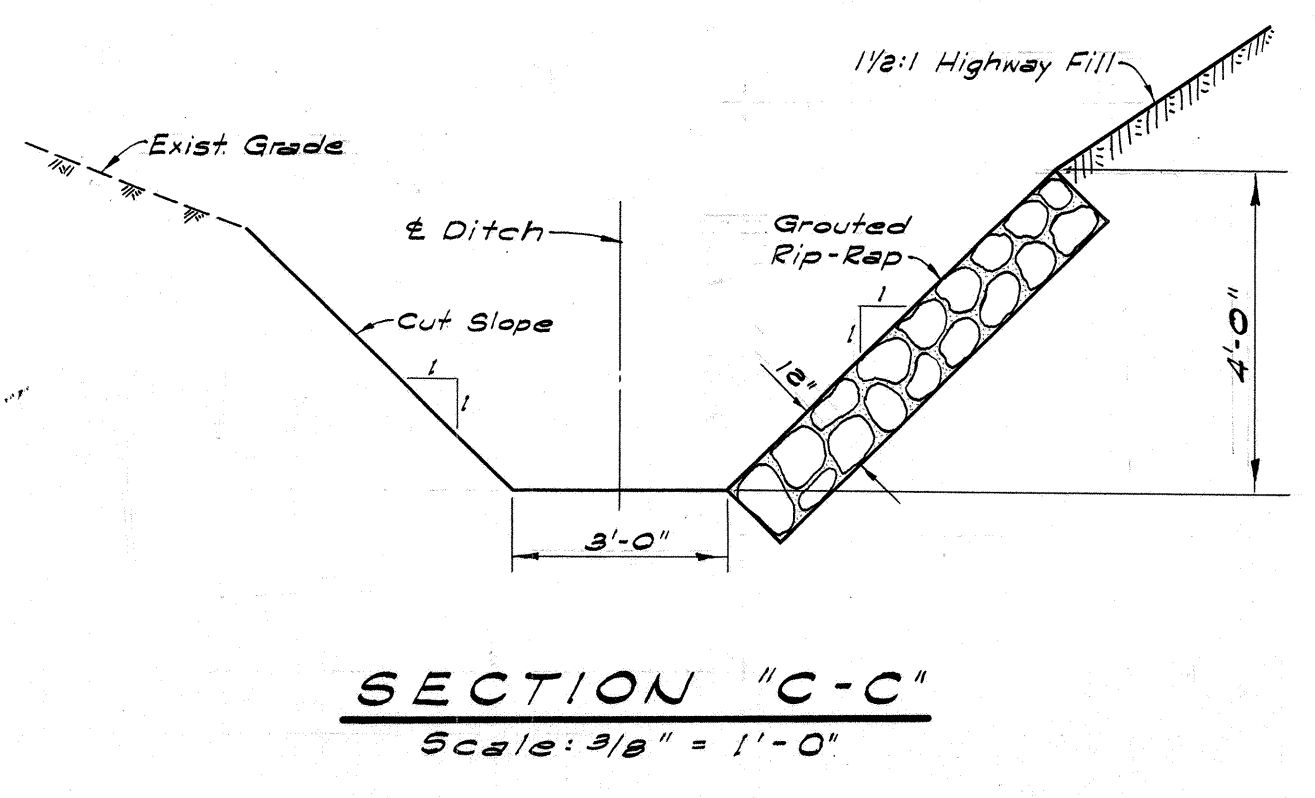
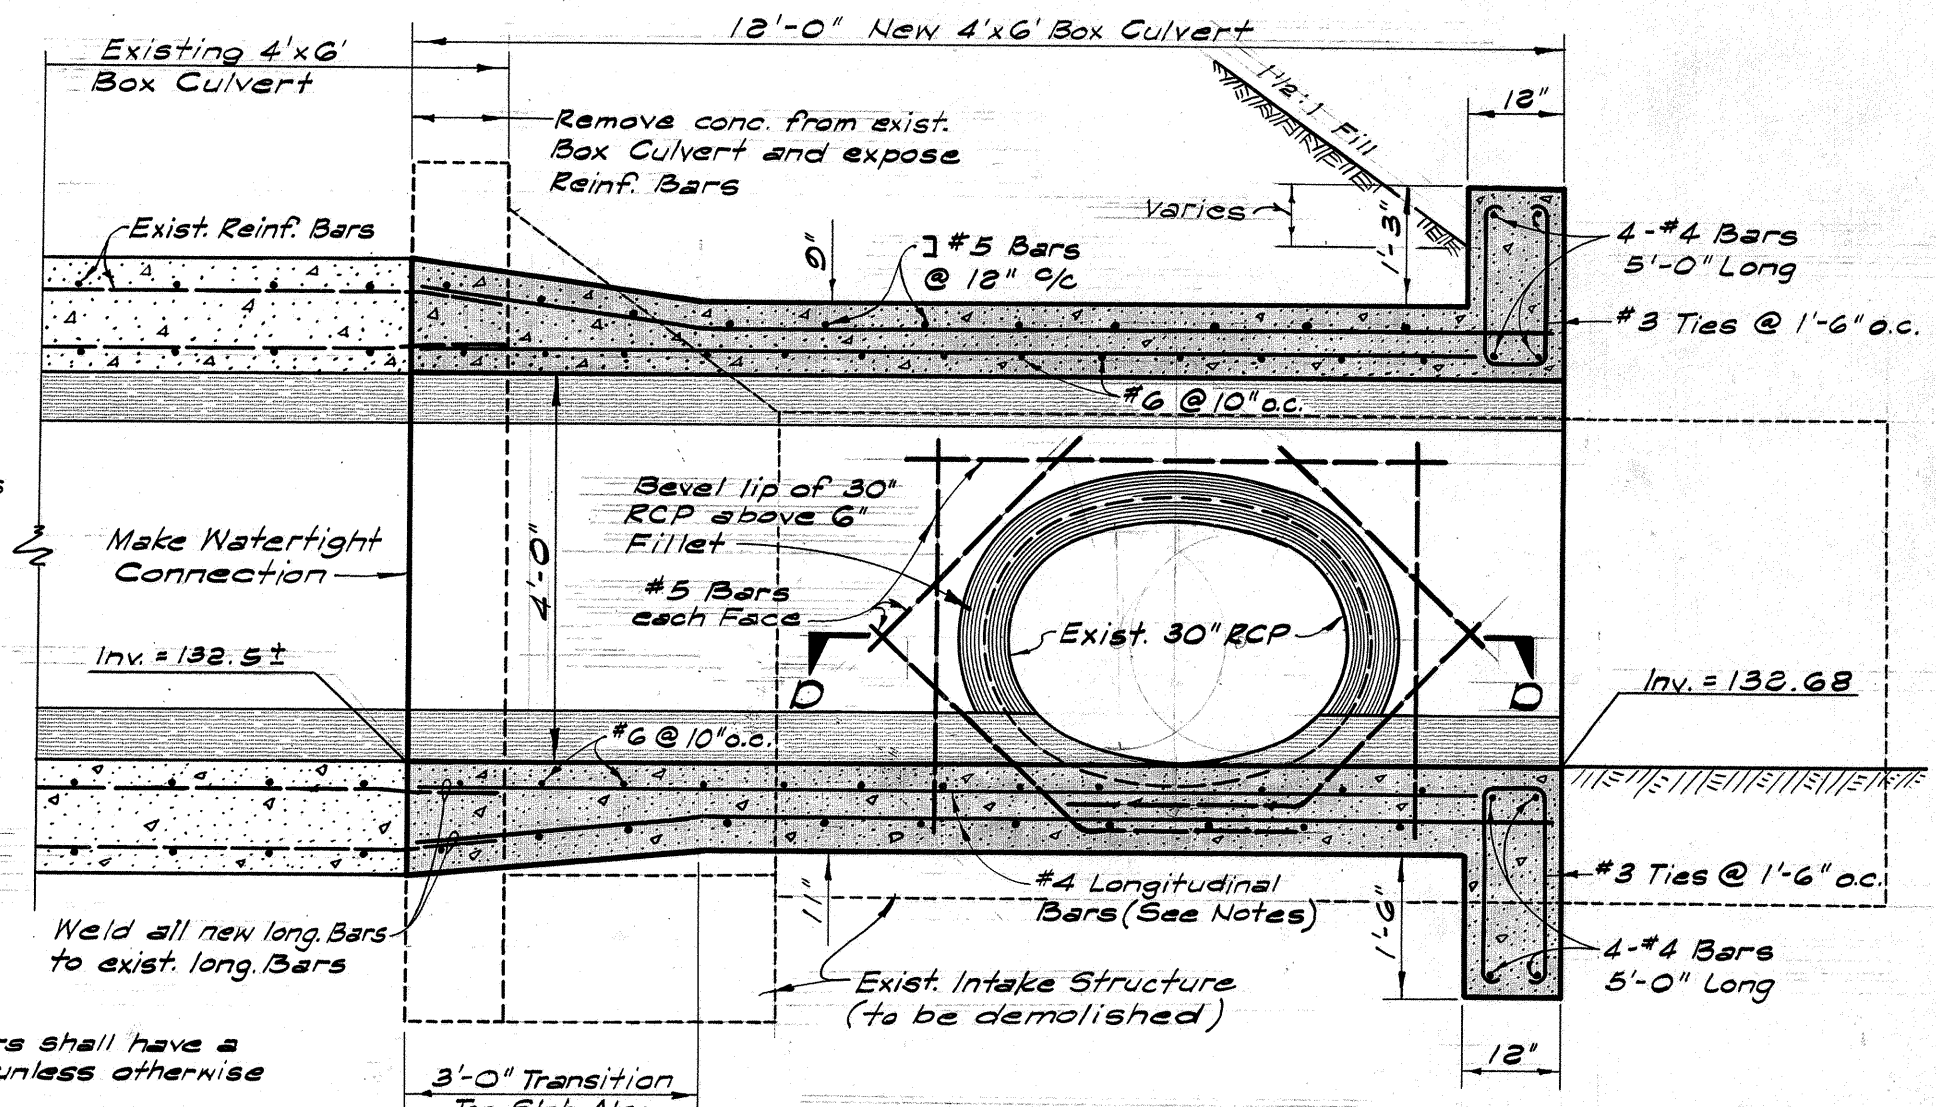
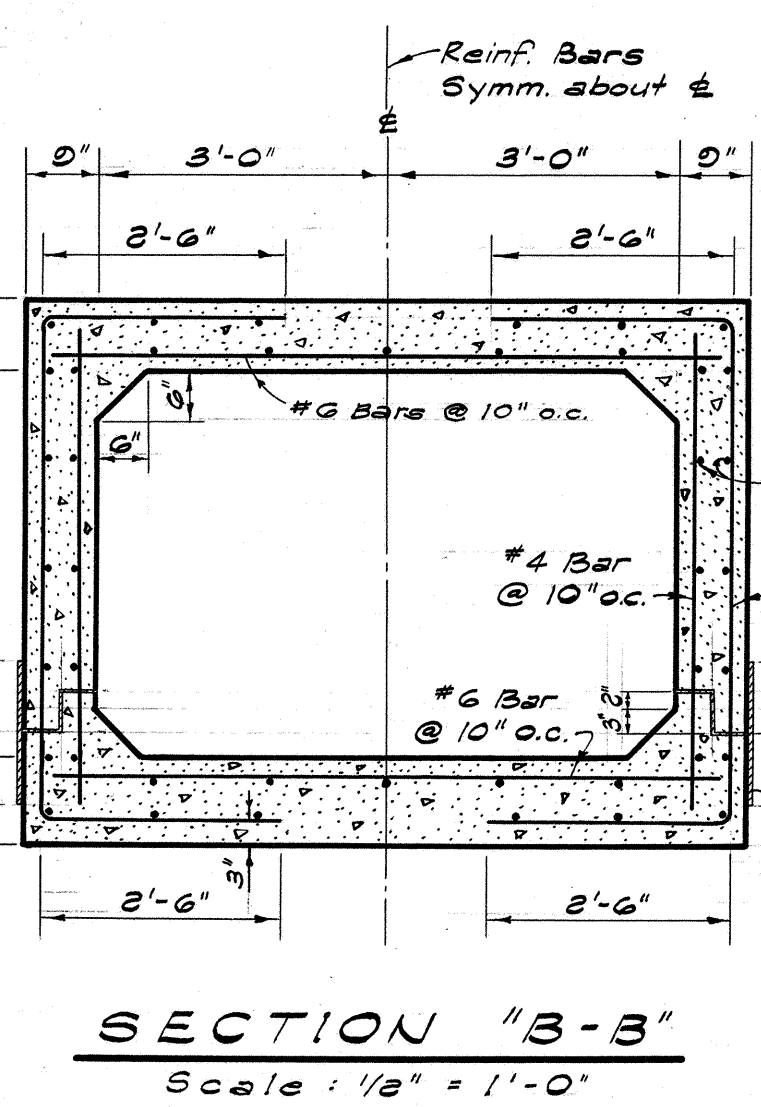
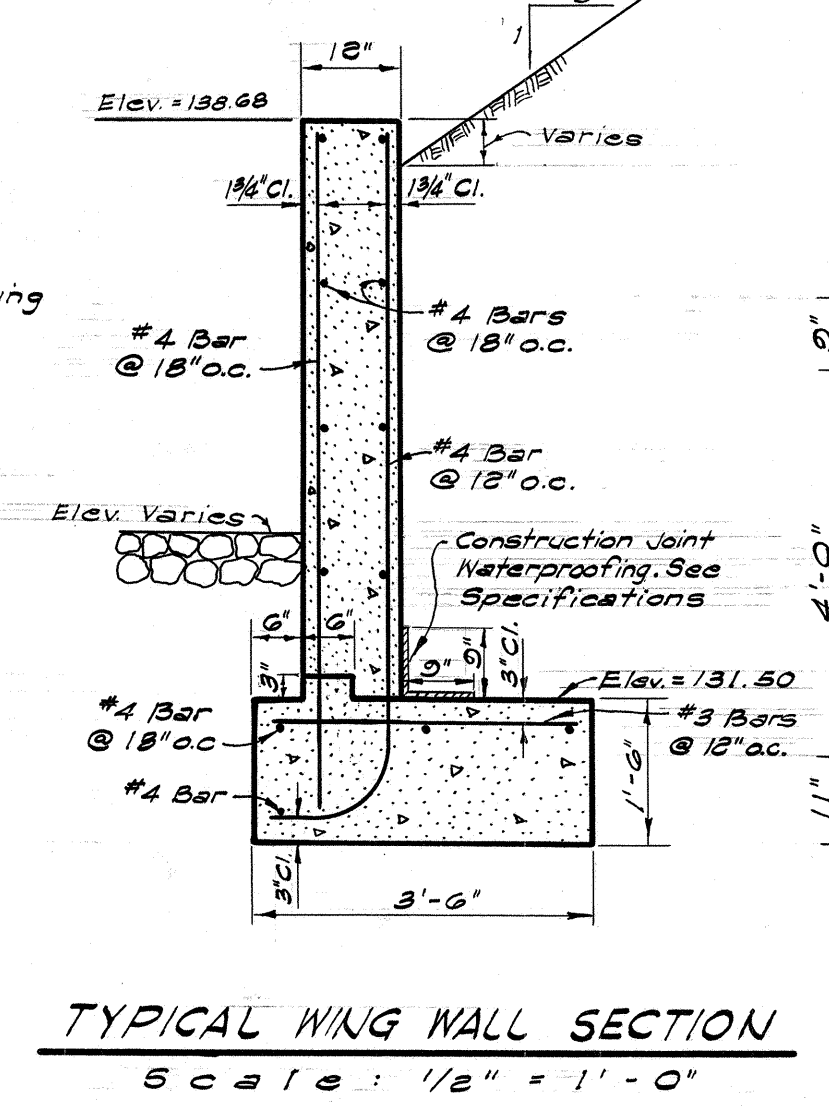
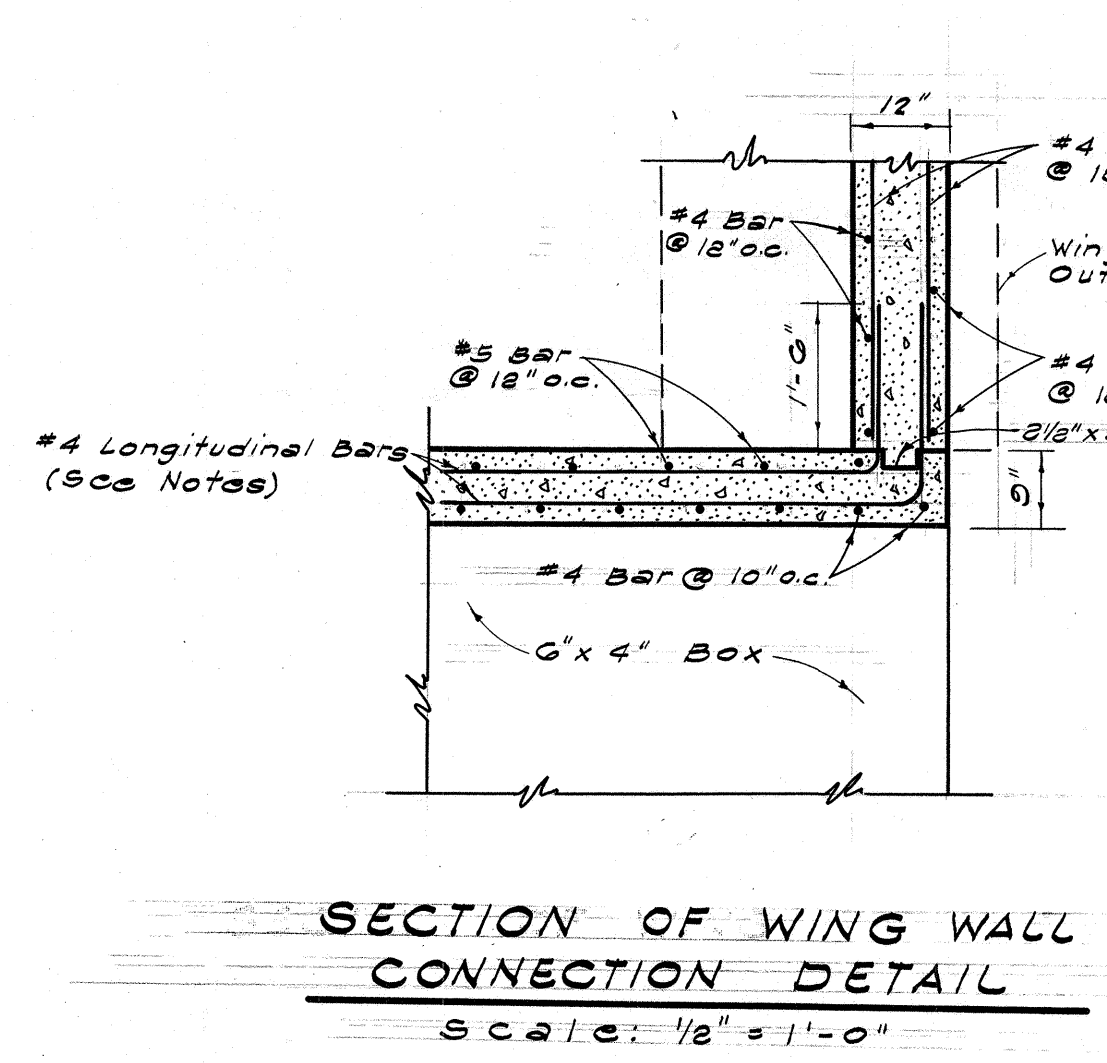
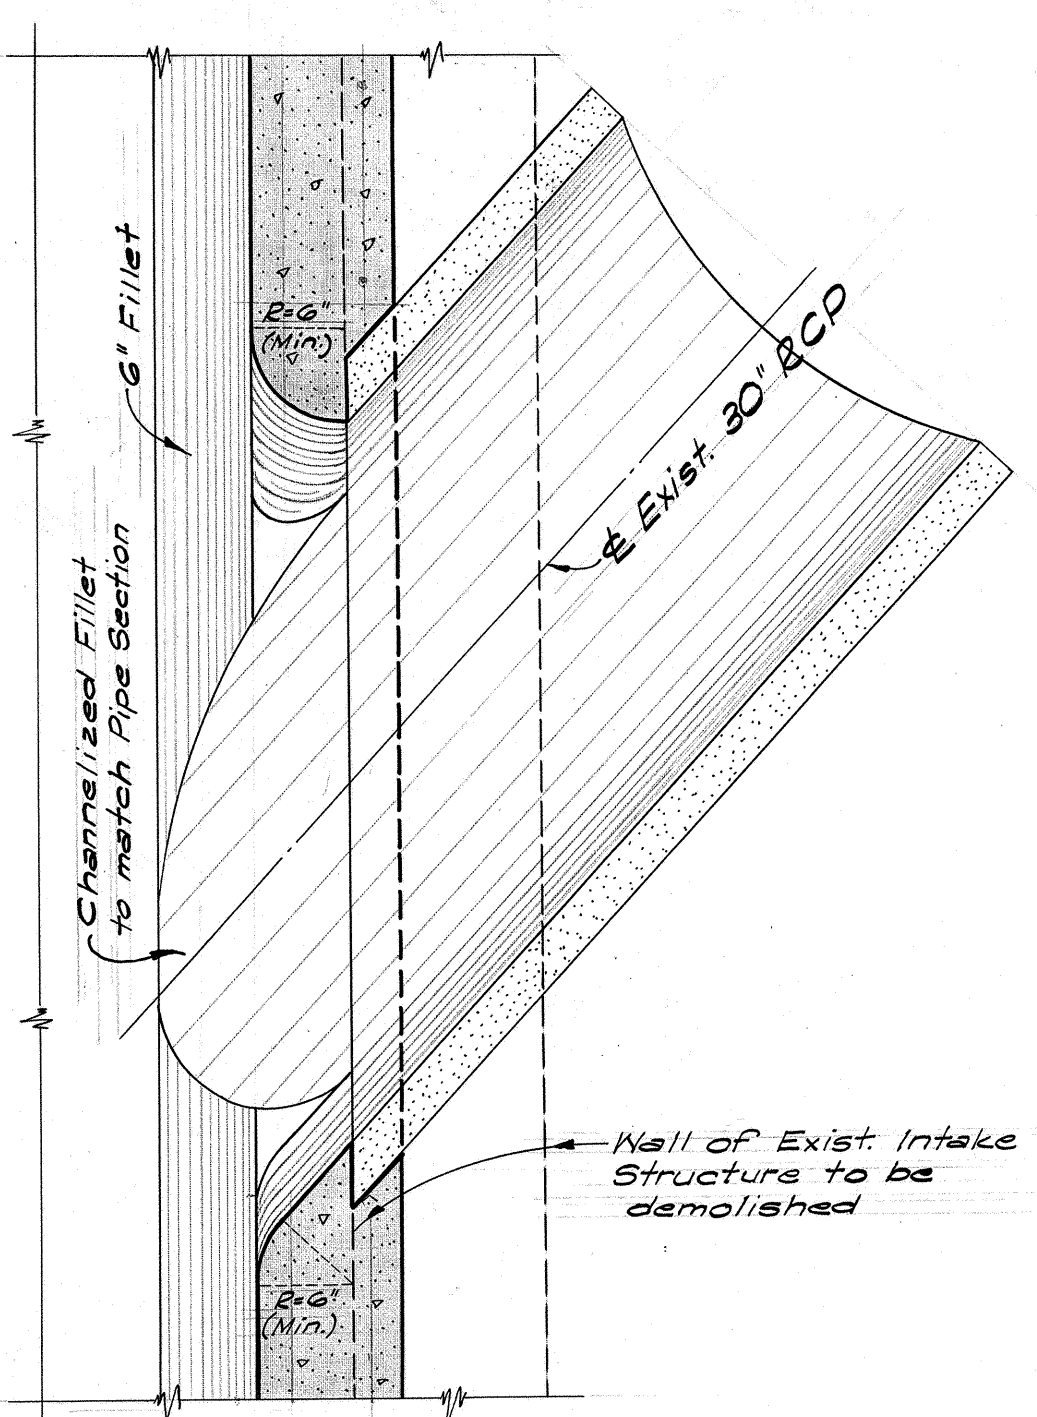
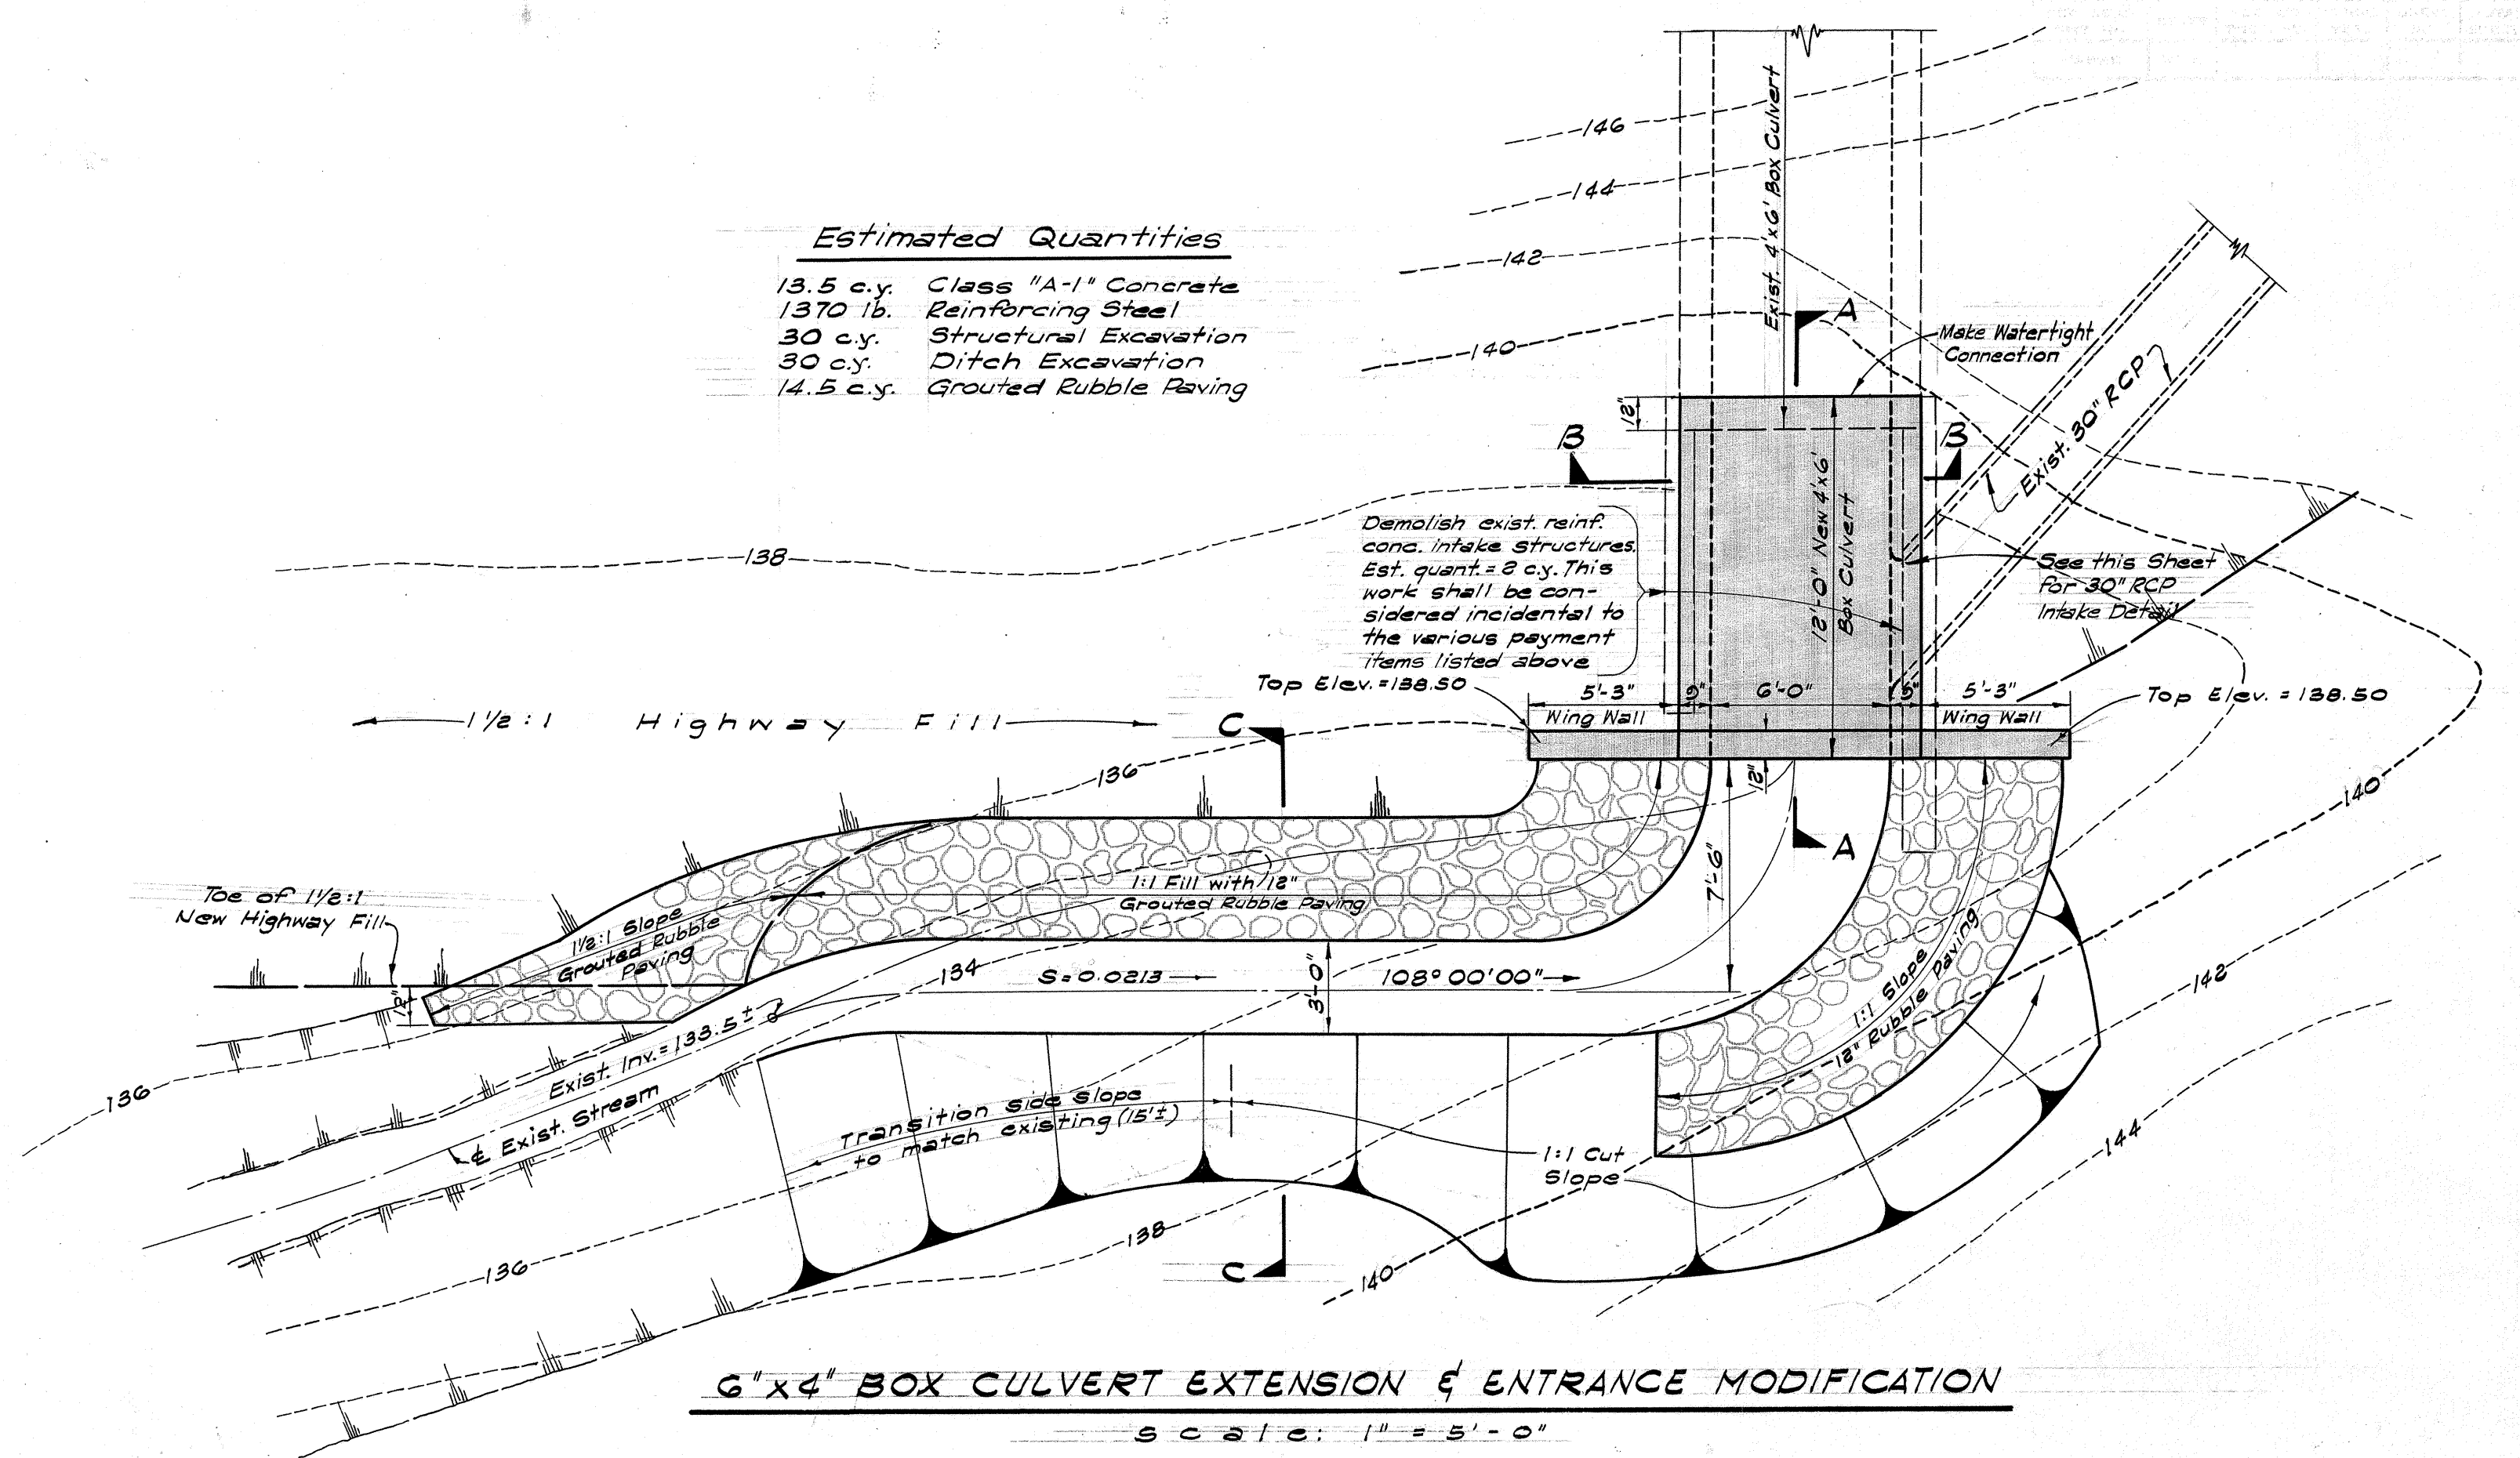


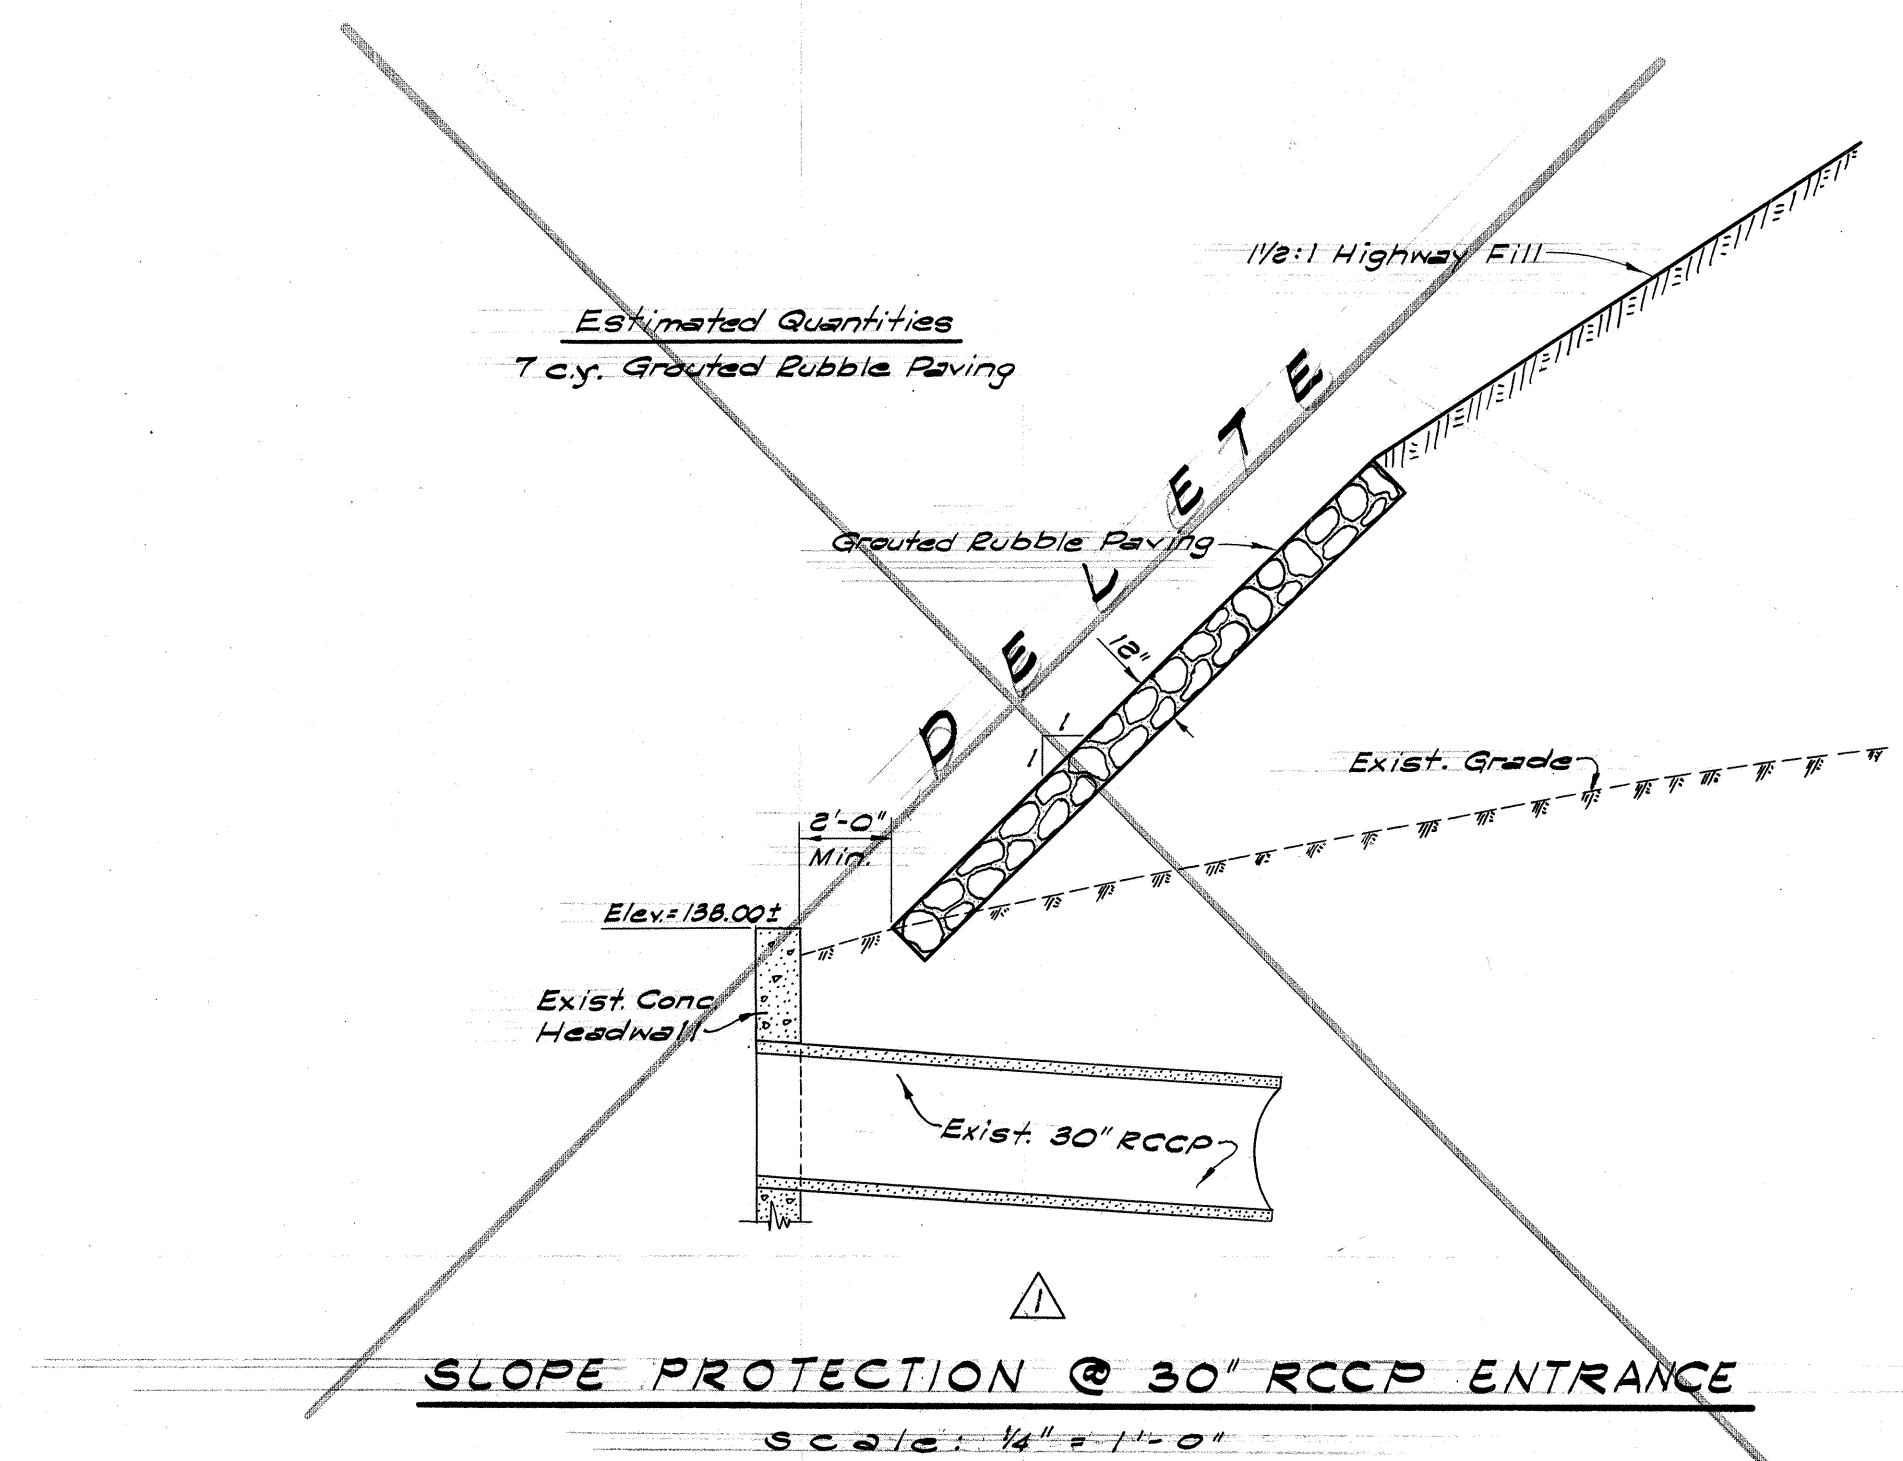

- Notes:**
1. All reinforcing bars shall have a minimum 2" cover unless otherwise noted.
 2. #4 longitudinal bars shall be spaced to meet existing reinforcing bars.
 3. Contractor to verify all existing inverts, grades and dimensions in the field.

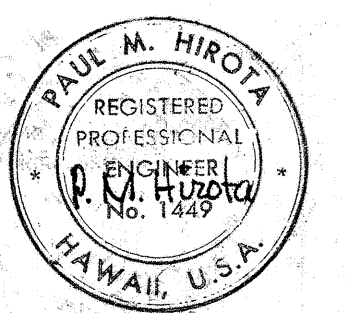

REV.	DATE	BY	APPROVED
1	6/10/03	Paul M. Hirota	Paul M. Hirota
LIHUE PLANTATION COMPANY LIHUE, KAUAI			
KUHIO HIGHWAY REALIGNMENT LIHUE, KAUAI, HAWAII			
MISC. DRAINAGE DETAILS			
APPROVED: <i>Paul M. Hirota</i> CHIEF ENGINEER			
APPROVED: <i>Paul M. Hirota</i> REGISTERED ENGINEER			
BELT, COLLINS & ASSOCIATES, LTD.-CIVIL ENGINEERS			

PROJECT NO. CK-56A-01-63