




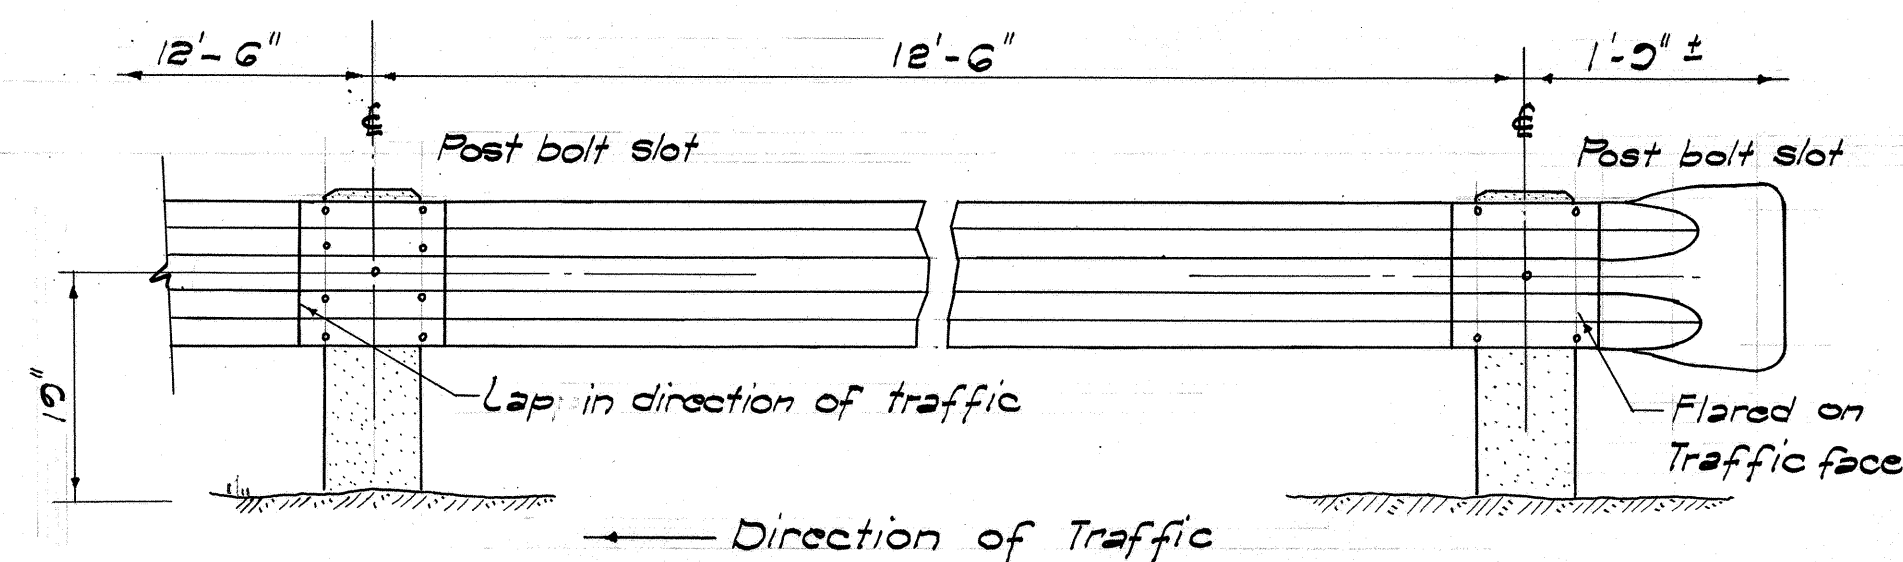


METAL GUARDRAIL
Scale: $\frac{3}{4}'' = 1'-0''$

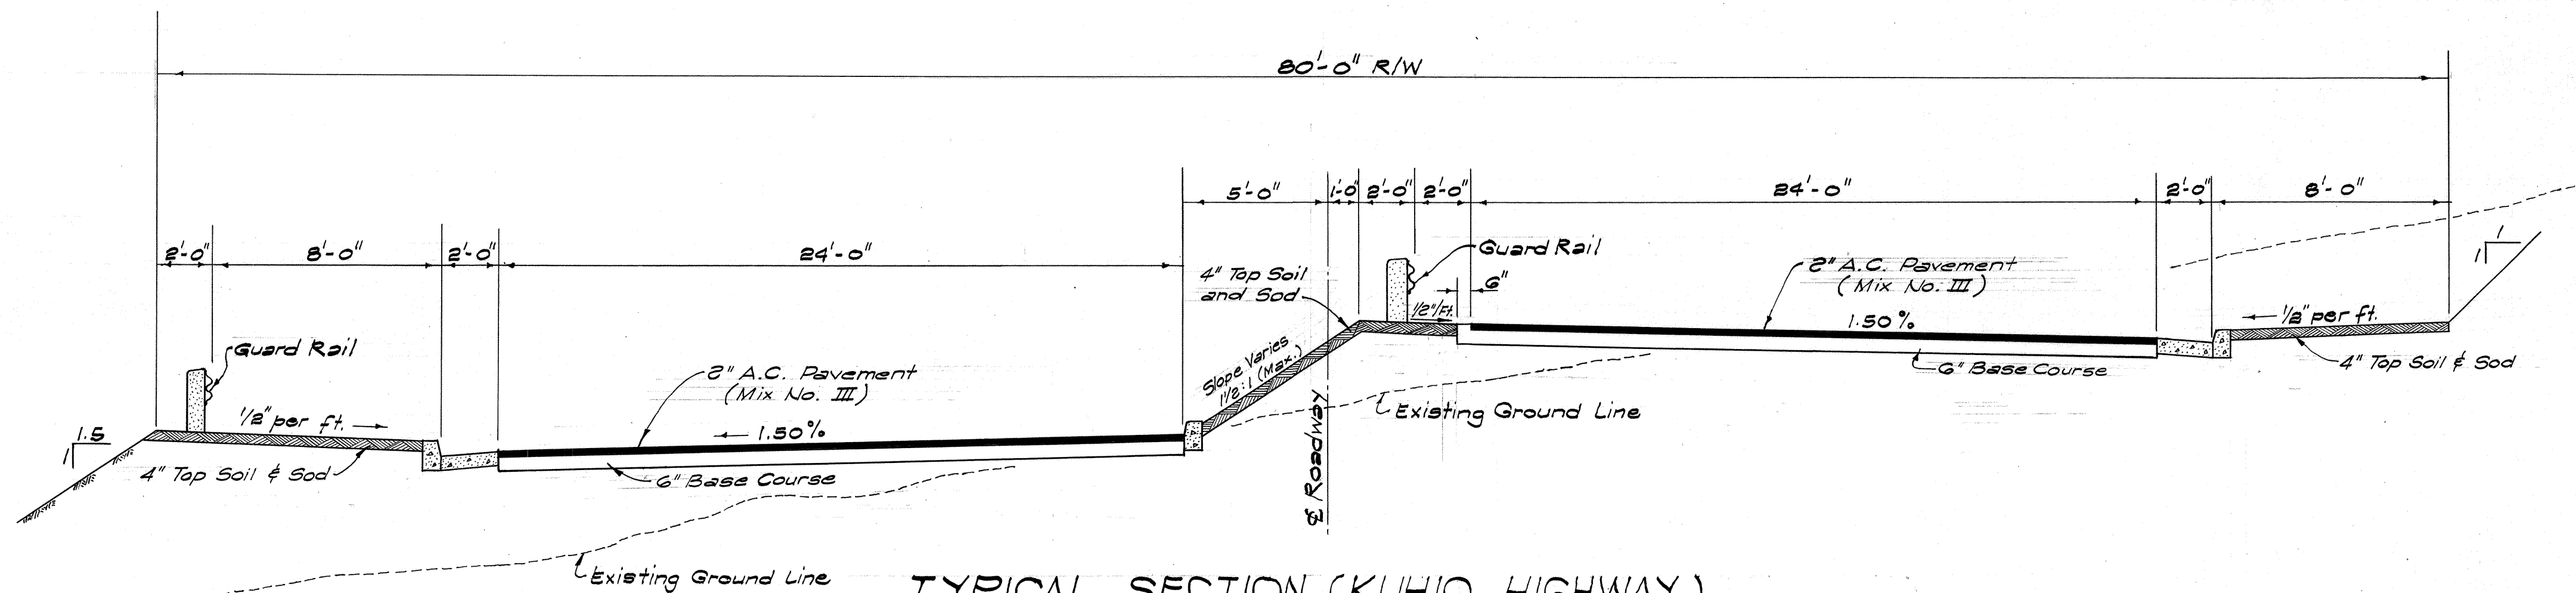


TYPICAL SECTION (KUHIO HIGHWAY)
Scale: $\frac{1}{4}'' = 1'-0''$

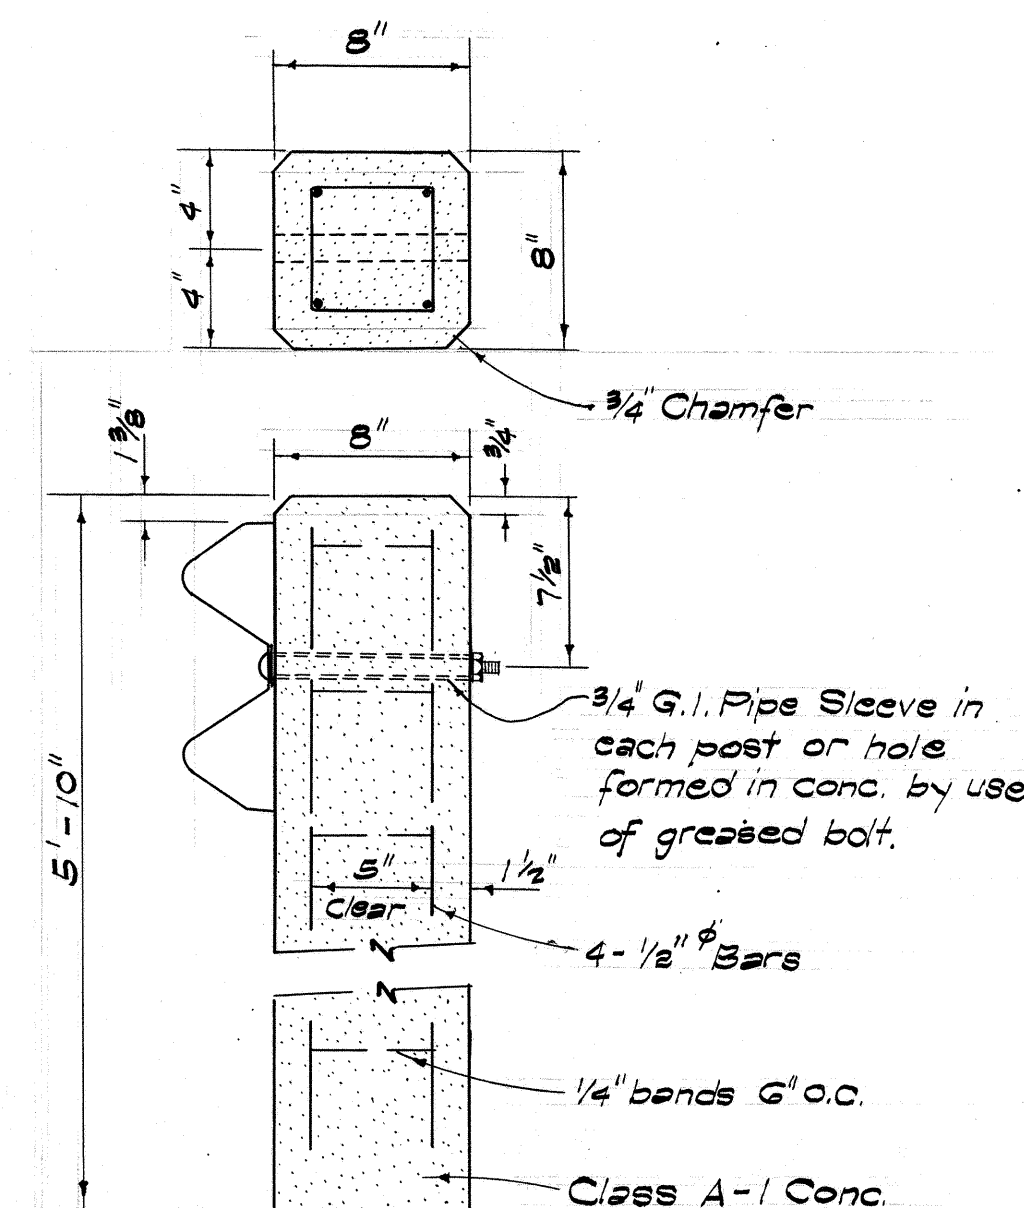


DETAIL OF PRECAST CONC. POST
Scale: $\frac{1}{2}'' = 1'-0''$

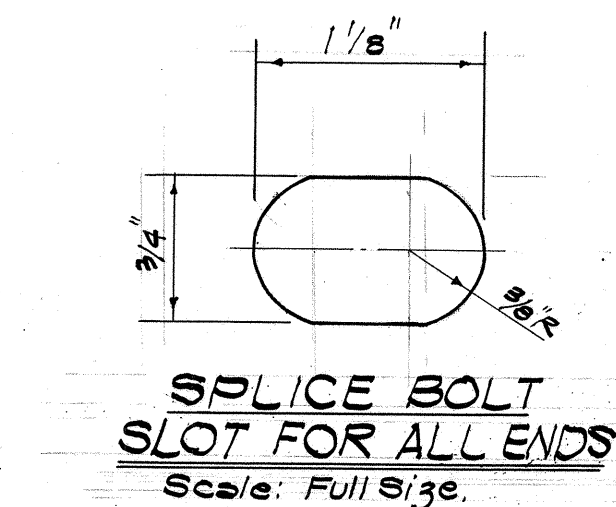


POST BOLT SLOT
Scale: Full Size

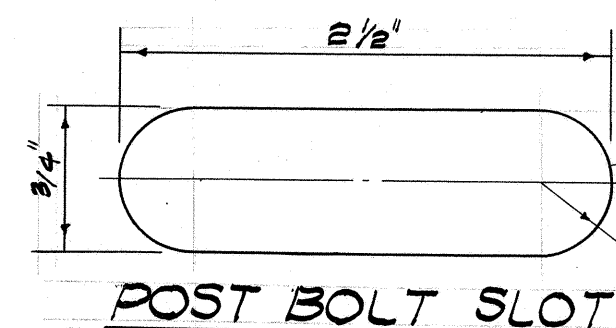


SPICE BOLT SLOT
Scale: Full Size

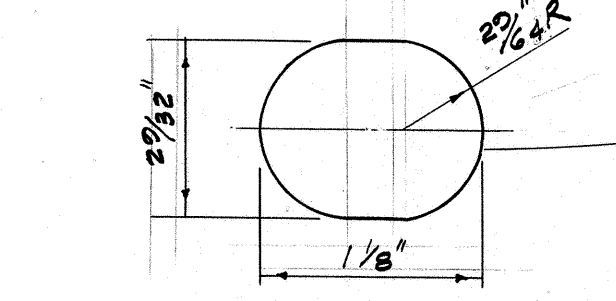


RAIL SPLICE
Scale: $3'' = 1'-0''$

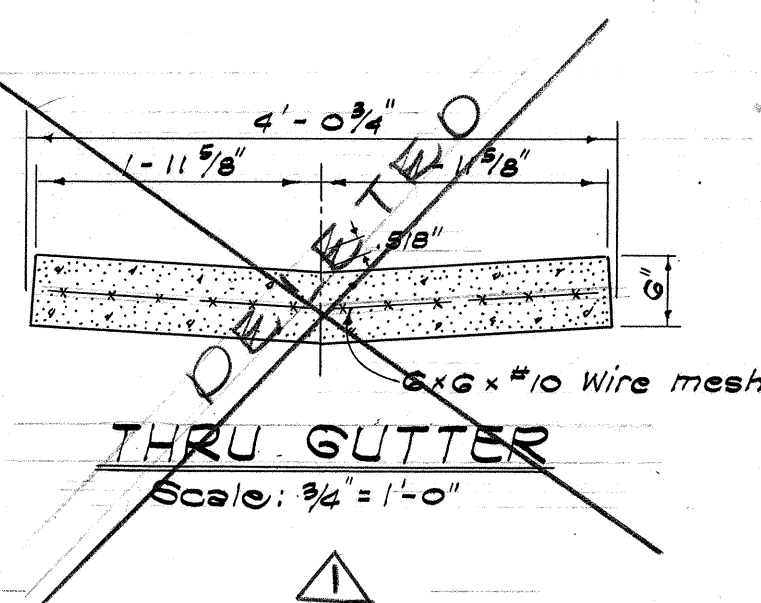


THRU GUTTER
Scale: $\frac{3}{4}'' = 1'-0''$

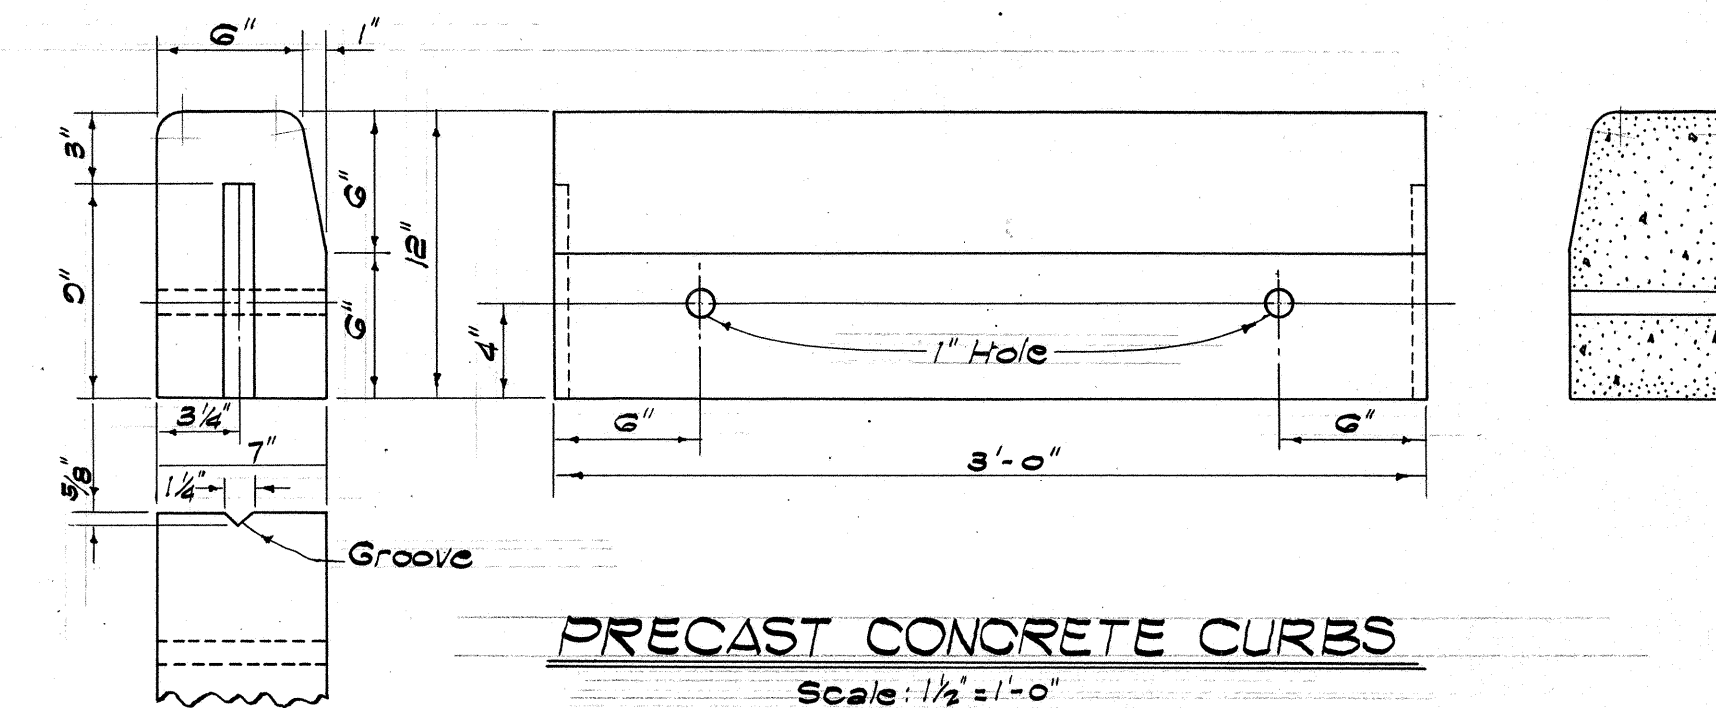


PRECAST CONCRETE CURBS
Scale: $1\frac{1}{2}'' = 1'-0''$

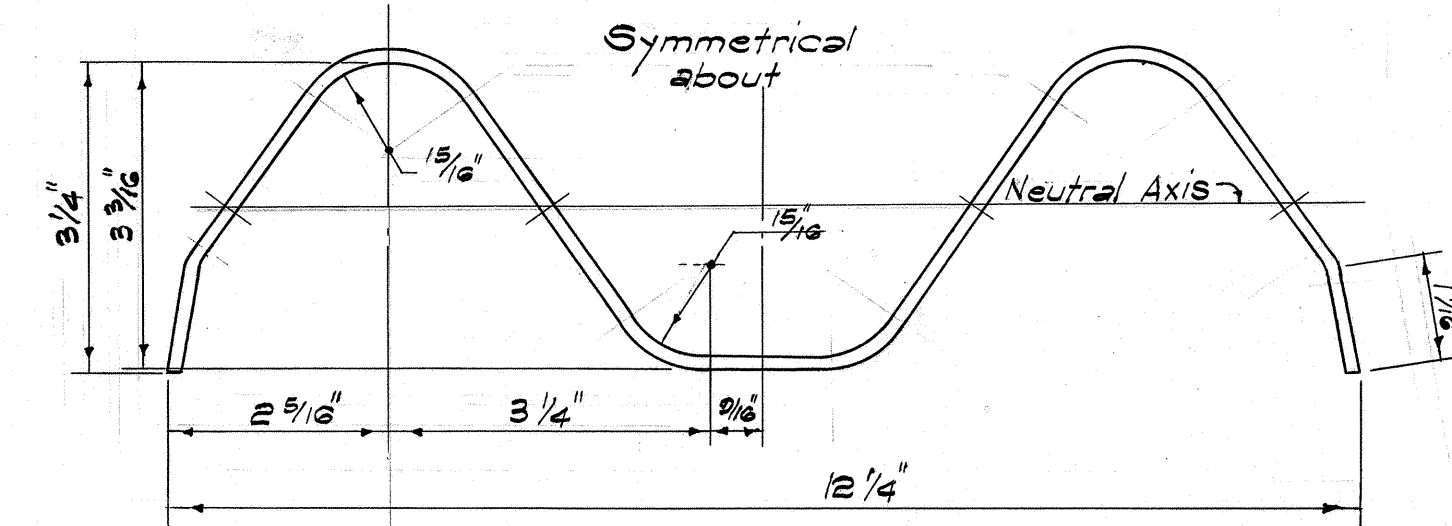


RAIL ELEMENT SECTION
Scale: Half Size

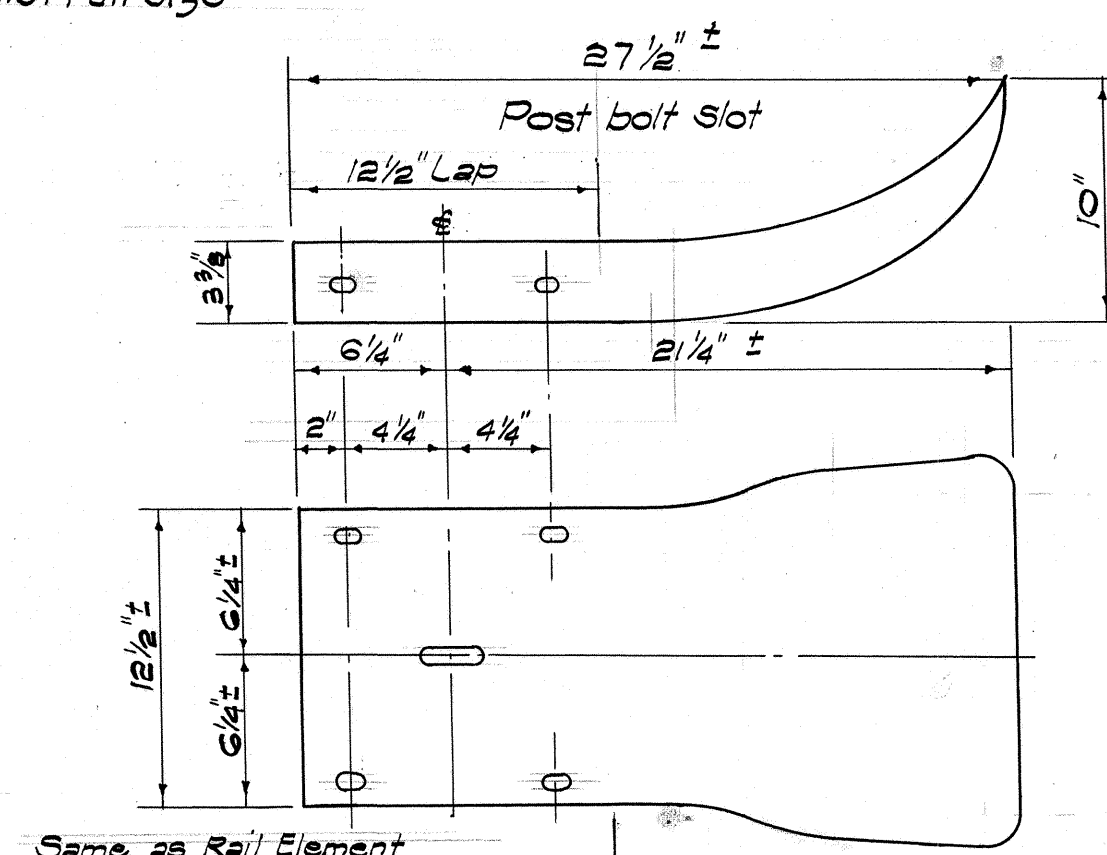


FLARED END
Scale: $1\frac{1}{2}'' = 1'-0''$

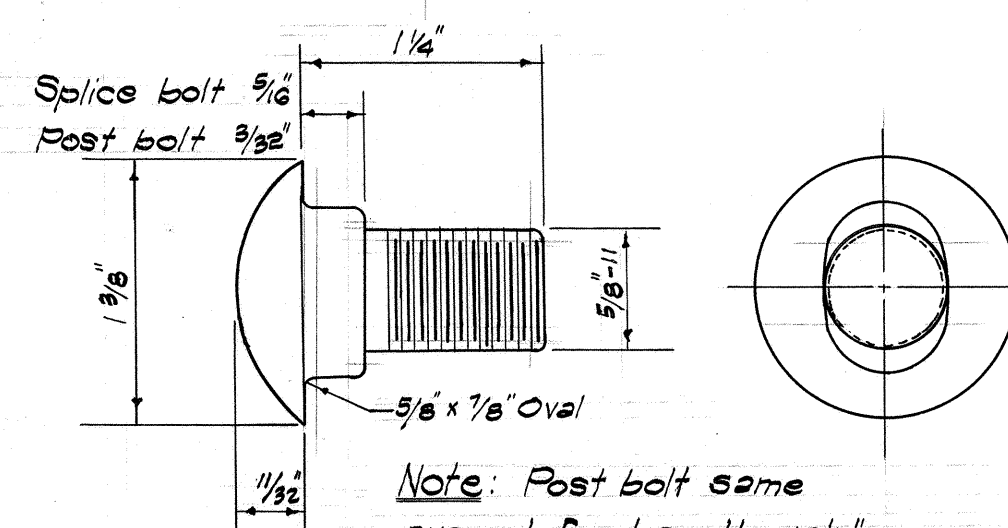


SPICE BOLT POST BOLT

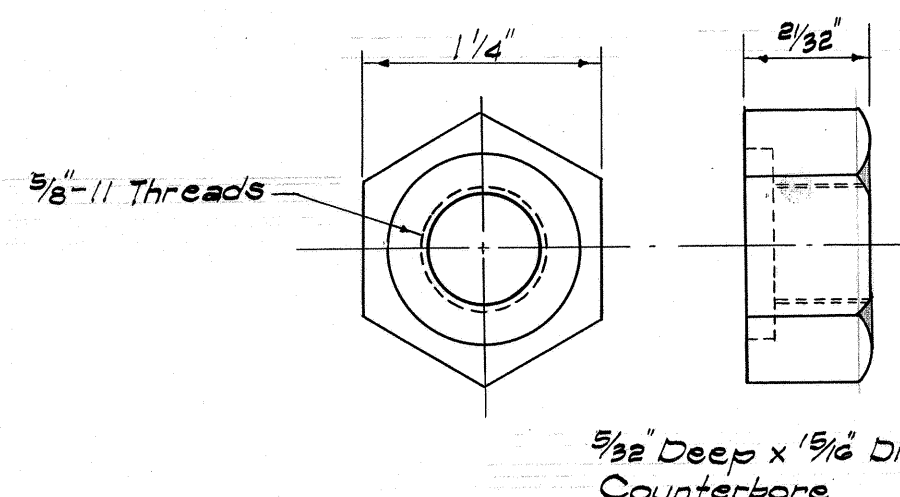


HEXAGON NUT
Scale: Full Size

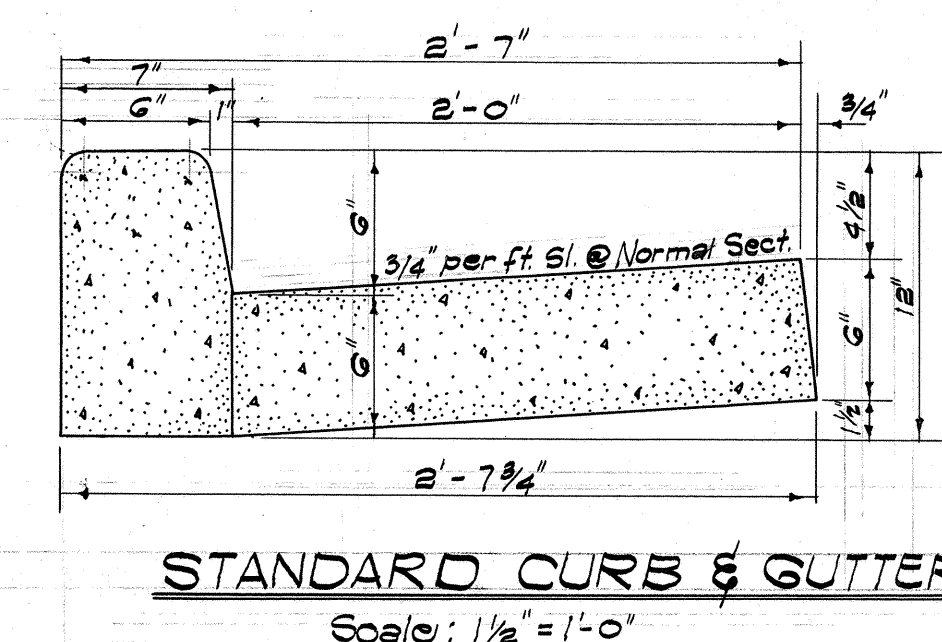

STANDARD CURB & GUTTER
Scale: $1\frac{1}{2}'' = 1'-0''$

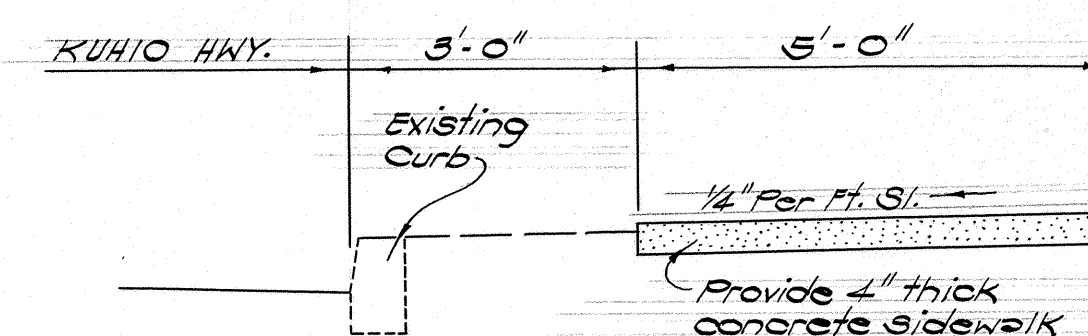

TYPICAL SIDEWALK SECTION
(SEE PLAN FOR LOCATION)
Scale: $\frac{1}{2}'' = 1'-0''$

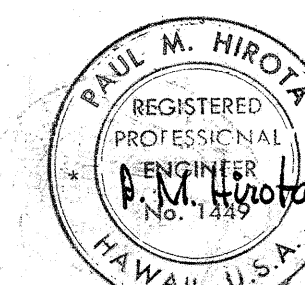



PROJECT NO. CK-56A-01-63

1				
	9/64	Deleted thru gutter	L.F.Co.	
REV.	DATE	BRIEF	BY	APPROVED

LIHUE PLANTATION COMPANY
LIHUE, KAUAI

KUHIO HIGHWAY REALIGNMENT
LIHUE, KAUAI, HAWAII

ROADWAY DETAILS

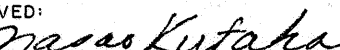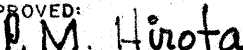APPROVED:  CHIEF ENGINEER	APPROVED:  REGISTERED ENGINEER
--	---

BELT, COLLINS & ASSOCIATES, LTD.-CIVIL ENGINEERS