


INDEX TO DRAWINGS	
SHEET NO.	DESCRIPTION
1	TITLE SHEET
2	TYPICAL SECTIONS & MISC. DETAILS
3	PLAN & PROFILE
4	ROADWAY DETAILS
5-6	STANDARD DETAILS
7-8	CROSS SECTIONS


FED. ROAD DIST. No.	STATE	PROJ. No.	FISCAL YEAR	SHEET No.	TOTAL SHEETS
HAWAII	HAW.	A-501-01-65	1965	1	8

STATE OF HAWAII
DEPARTMENT OF TRANSPORTATION
HIGHWAYS DIVISION
"AS BUILT" PLANS FOR
REVAMPING OF PORT ALLEN HARBOR SPUR
JUNCTION OF KAUMUALII HIGHWAY
PROJECT NO. A-501-01-65

DISTRICT OF KOLOA
ISLAND OF KAUAI

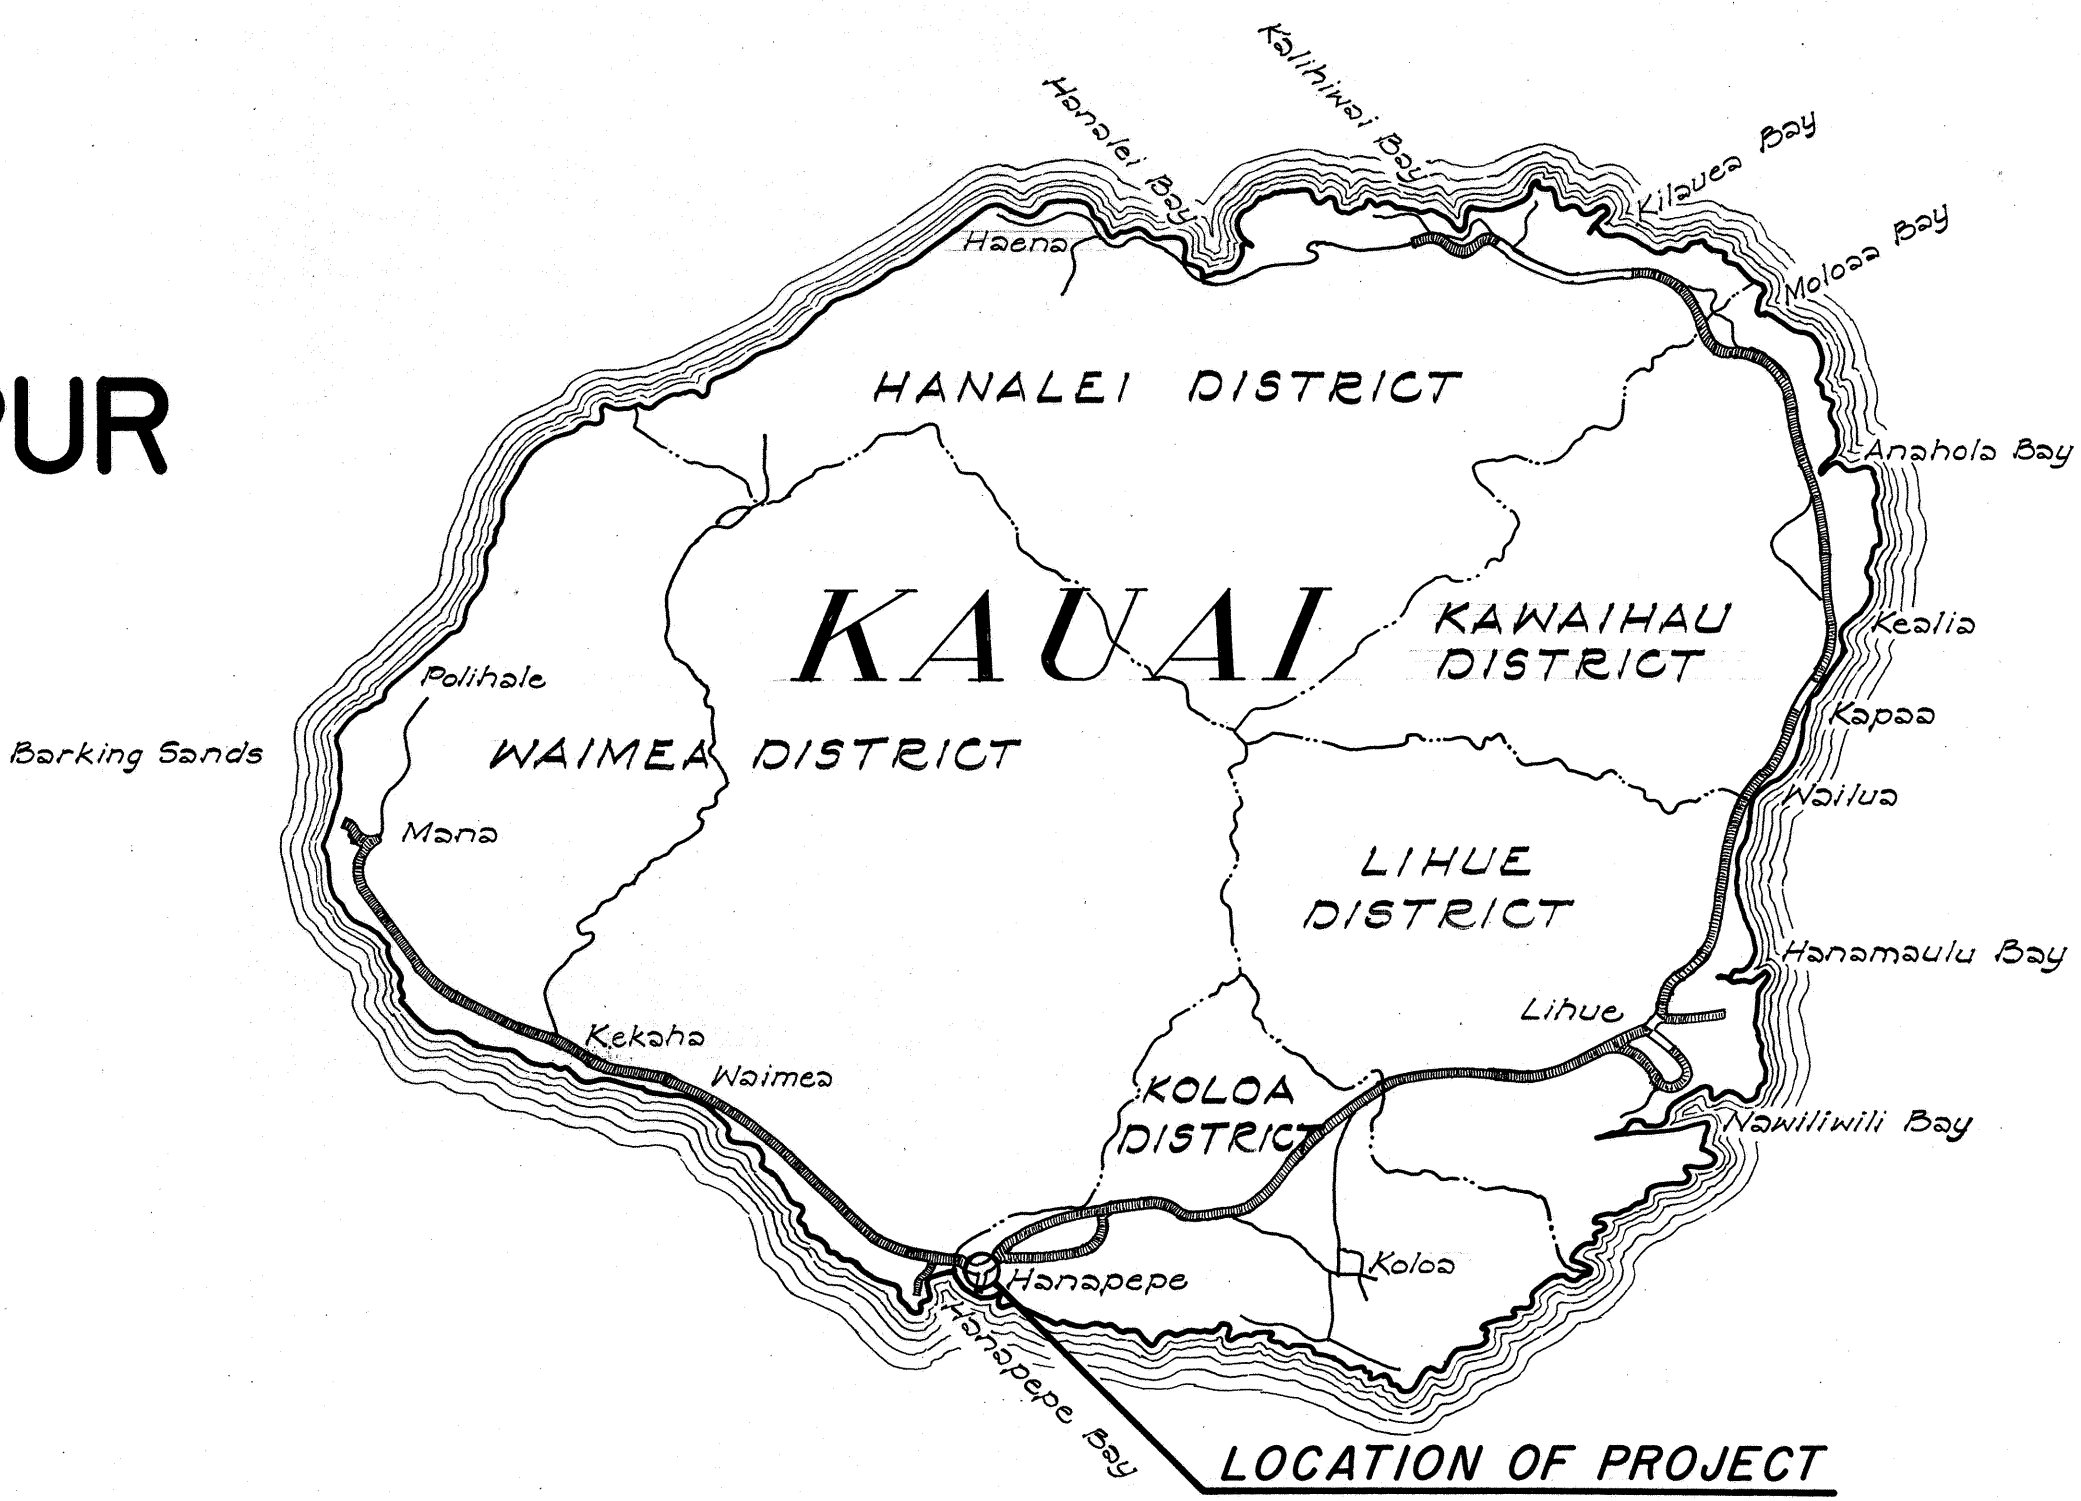

CONVENTIONAL	SIGNS
Baseline	75
Boundary Line	
Fences (Named)	
Existing Roadway	
Pipe Culvert	
Box Culvert	
Telephone Line & Pole	
Electric Line & Pole	
Water Main	

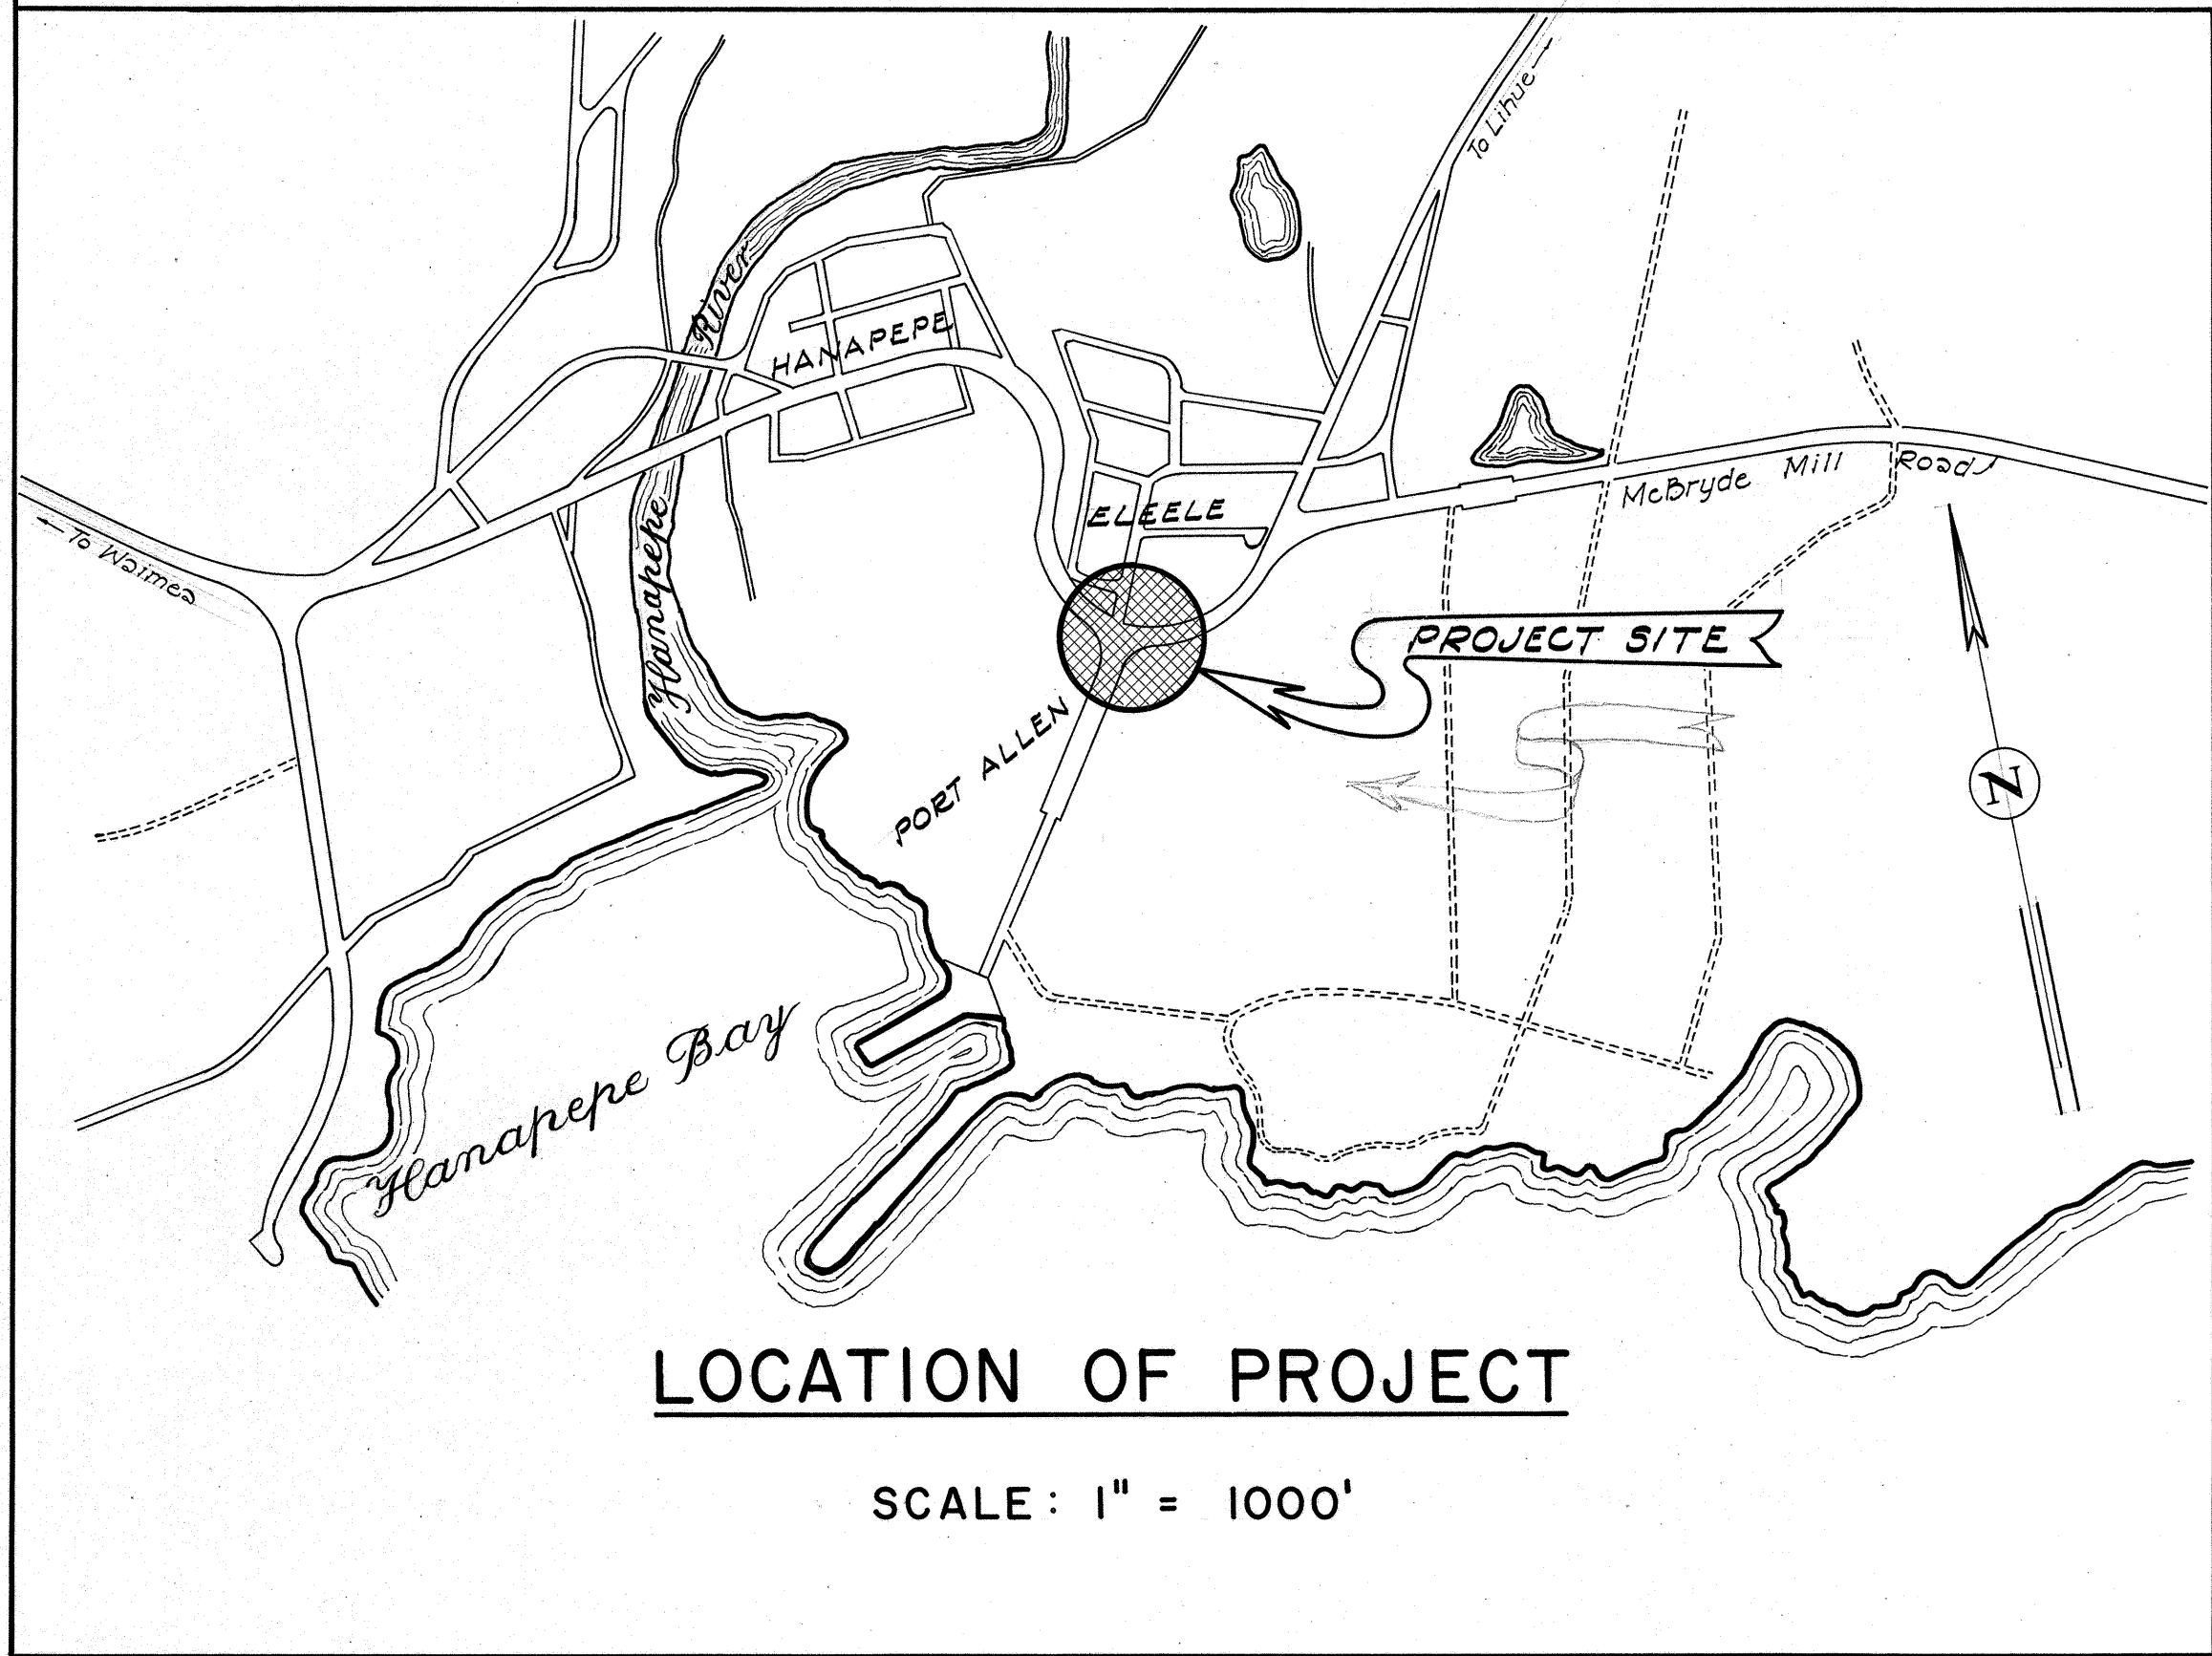

LOCATION OF PROJECT
SCALE: 1" = 1000'

LENGTH OF PROJECT - 0.166 MI.

NOTE:
ALL CHANGES MADE DURING CONSTRUCTION
HAVE BEEN NOTED IN RED ON THESE
TRACINGS AND CHECKED BY:
Hugh Yamaguchi
PROJECT ENGINEER
June 6, 1967
DATE

APPROVED: DATE 5-24-65
Kaipo S. Kaula
ACTING DIRECTOR OF TRANSPORTATION