
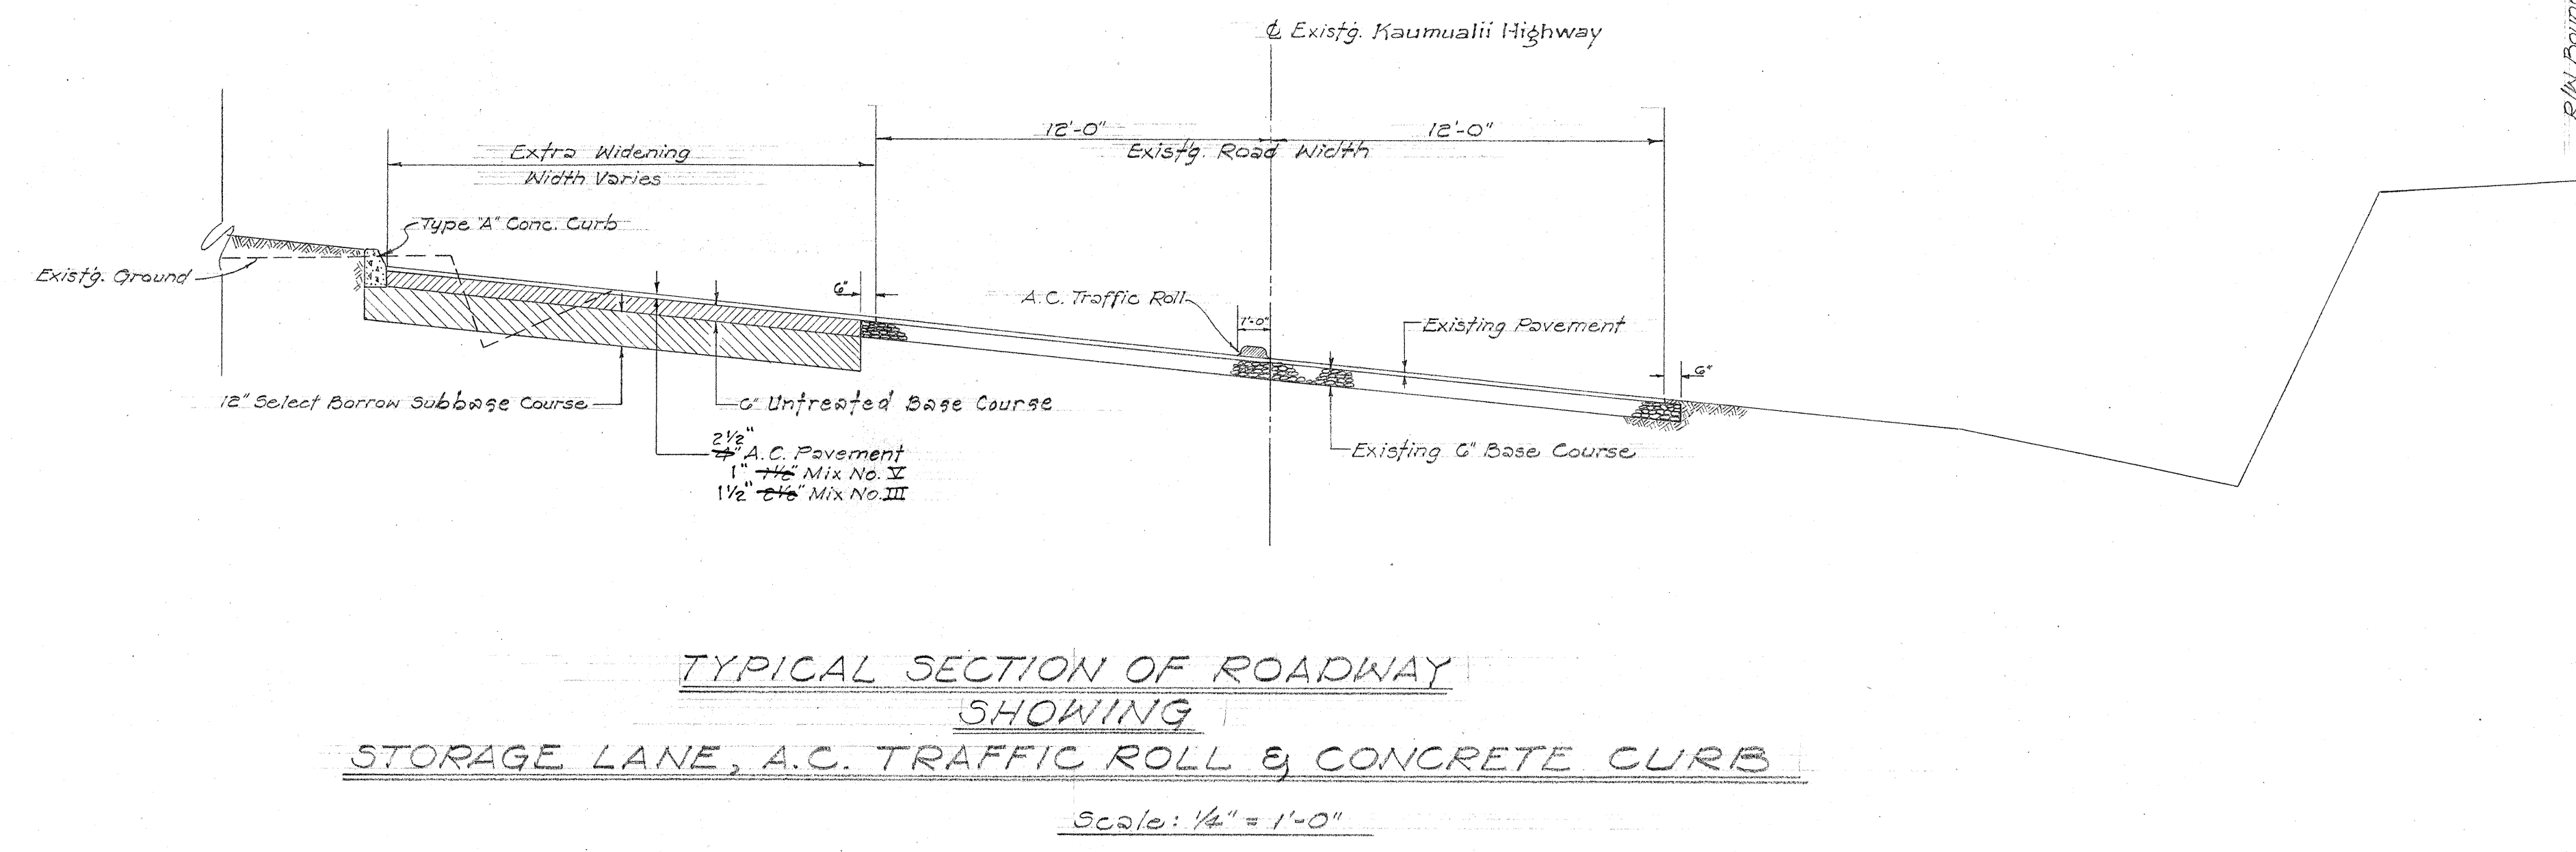
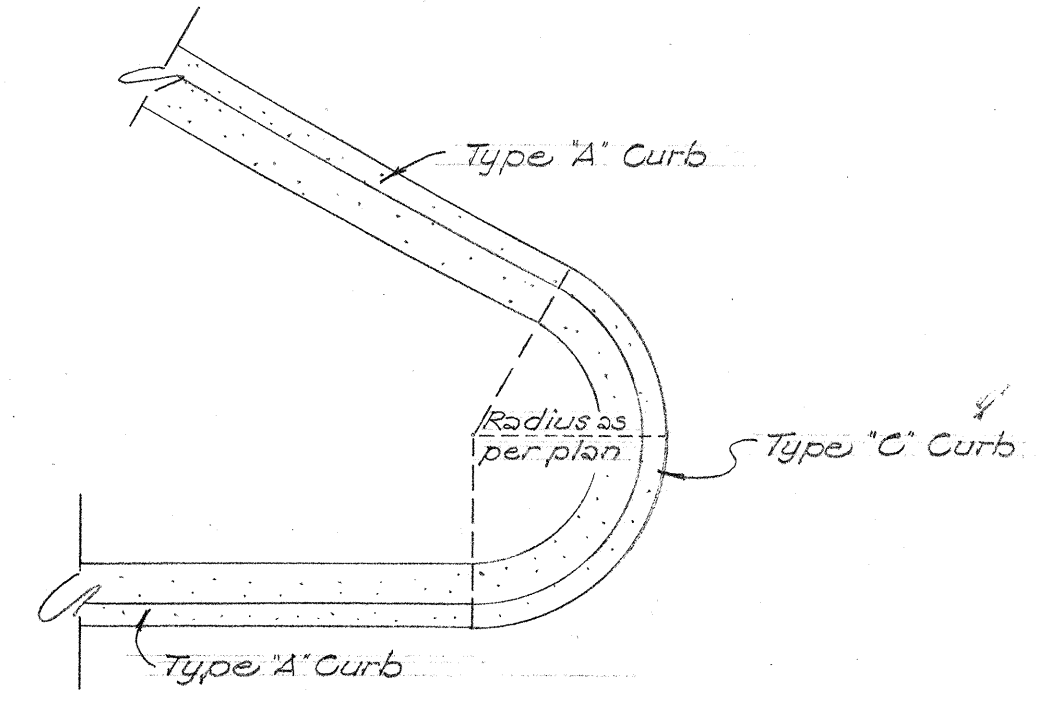


DIST. No.	STATE	PROJ. No.	FISCAL YEAR	SHEET No.	TOTAL SHEETS
HAWAII	HAW.	A-5010145	1965	2	3

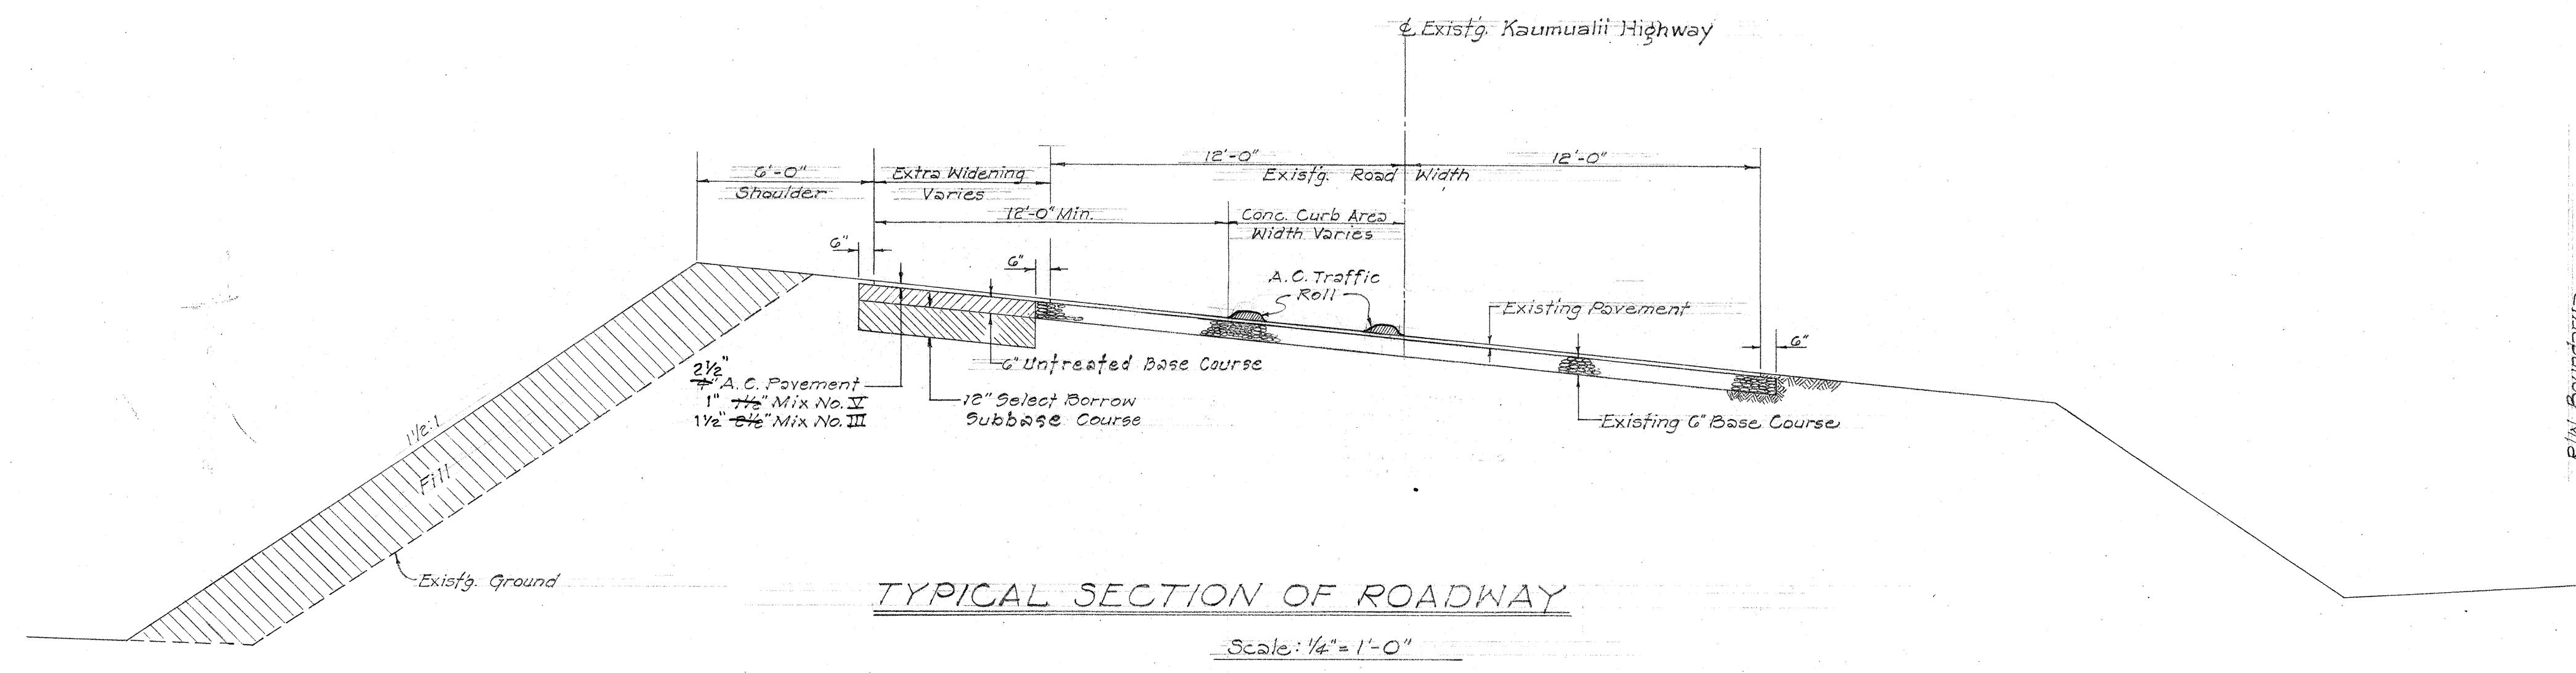

DEPARTMENT OF TRANSPORTATION
HIGHWAYS DIVISION
STATE OF HAWAII
TYPICAL SECTIONS
& MISCELL. DETAILS
REVAMPING OF PORT ALLEN HARBOR SPUR
SCALE: AS SHOWN DATE: APR. 1965