


FED. ROAD DIST. NO.	STATE	FED. AID PROJ. NO.	FISCAL YEAR	SHEET NO.	TOTAL SHEETS
HAWAII	HAW.	LSF-056-1(2)	1967	8	15

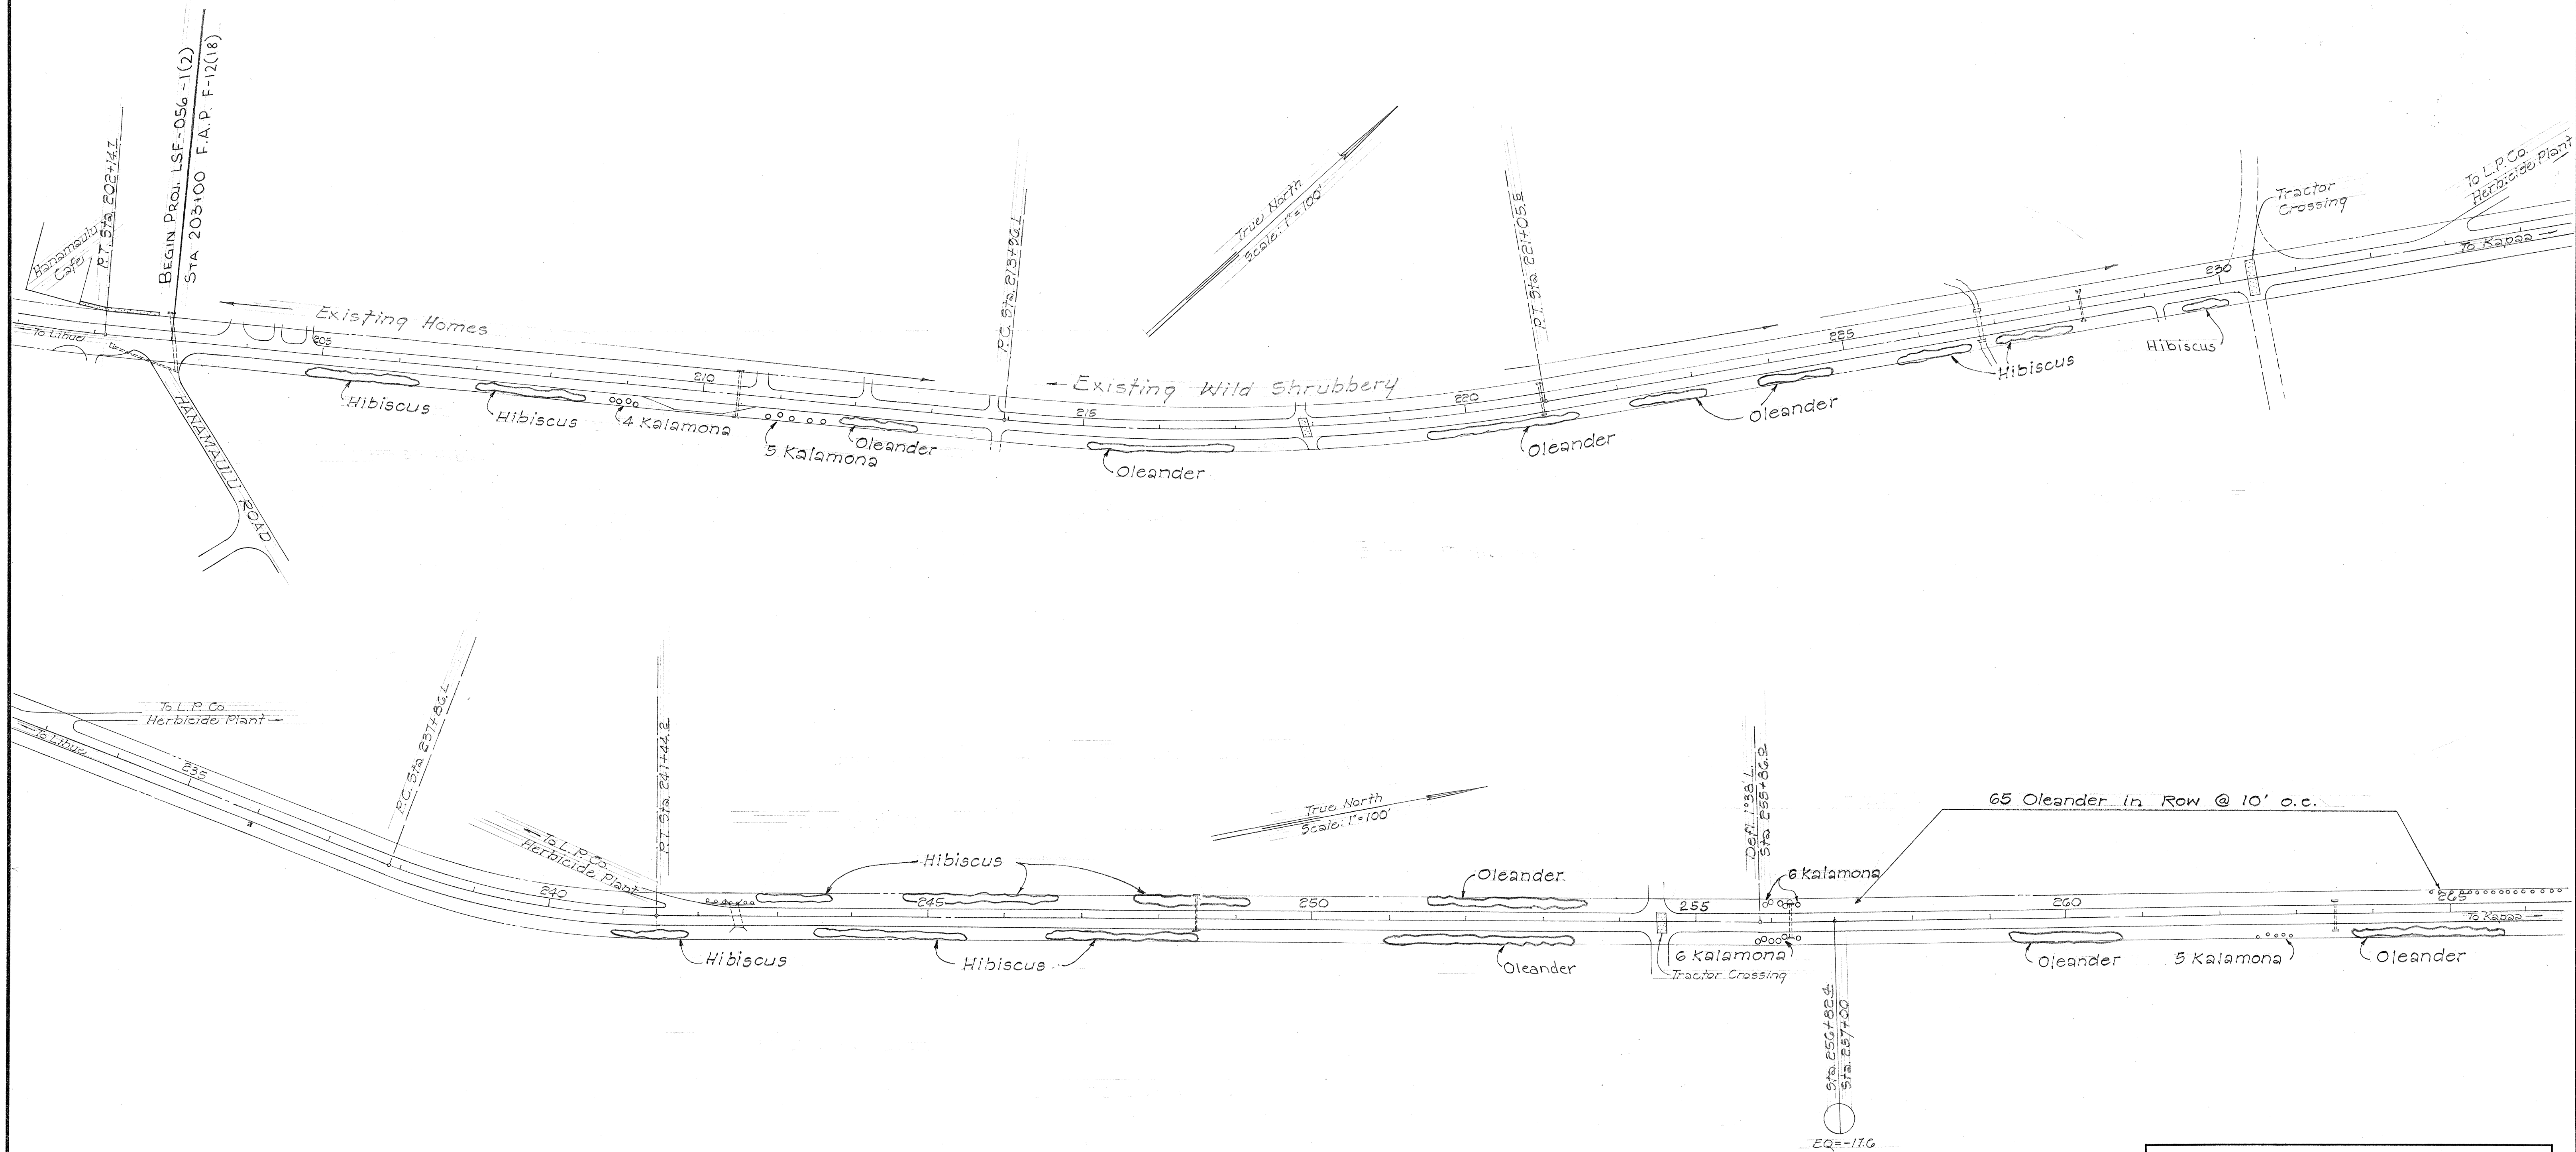

DATE	_____
DESIGNED BY	_____
DRAWN BY	_____
CHECKED BY	_____
NOTED BY	_____
NO.	_____

STATE OF HAWAII
DEPARTMENT OF TRANSPORTATION
HIGHWAYS DIVISION

HTGHWAY BEAUTIFICATION
HANAMAULU TO WAILUA GOLF COURSE
PROJ. NO LSF-056-1(2)
KAUAI DISTRICT

