

INDEX TO DRAWINGS	
SHEET NO.	DESCRIPTION
1	TITLE SHEET
2	TYPICAL SECTION AND MISC. DETAILS
3 - 7	PROJ. NO. LSF-050-1(1)
8 - 9	PROJ. NO. LSF-056-1(2)
10	PROJ. NO. LSF-056-1(4)
11	PROJ. NO. LSF-056-1(1)
12	PROJ. NO. LSF-056-1(3)
13-15	DIRECTIONAL SIGN AND STANDARD DETAILS

STATE OF HAWAII

DEPARTMENT OF TRANSPORTATION

HIGHWAYS DIVISION

PLANS FOR

HAWAII FEDERAL AID

LANDSCAPING AND SCENIC ENHANCEMENT PROGRAM

HANAPEPE TO WAIMEA PROJ. NO. LSF-050-1(1)

HANAMAULU TO WAILUA GOLF COURSE PROJ. NO. LSF-056-1(2)

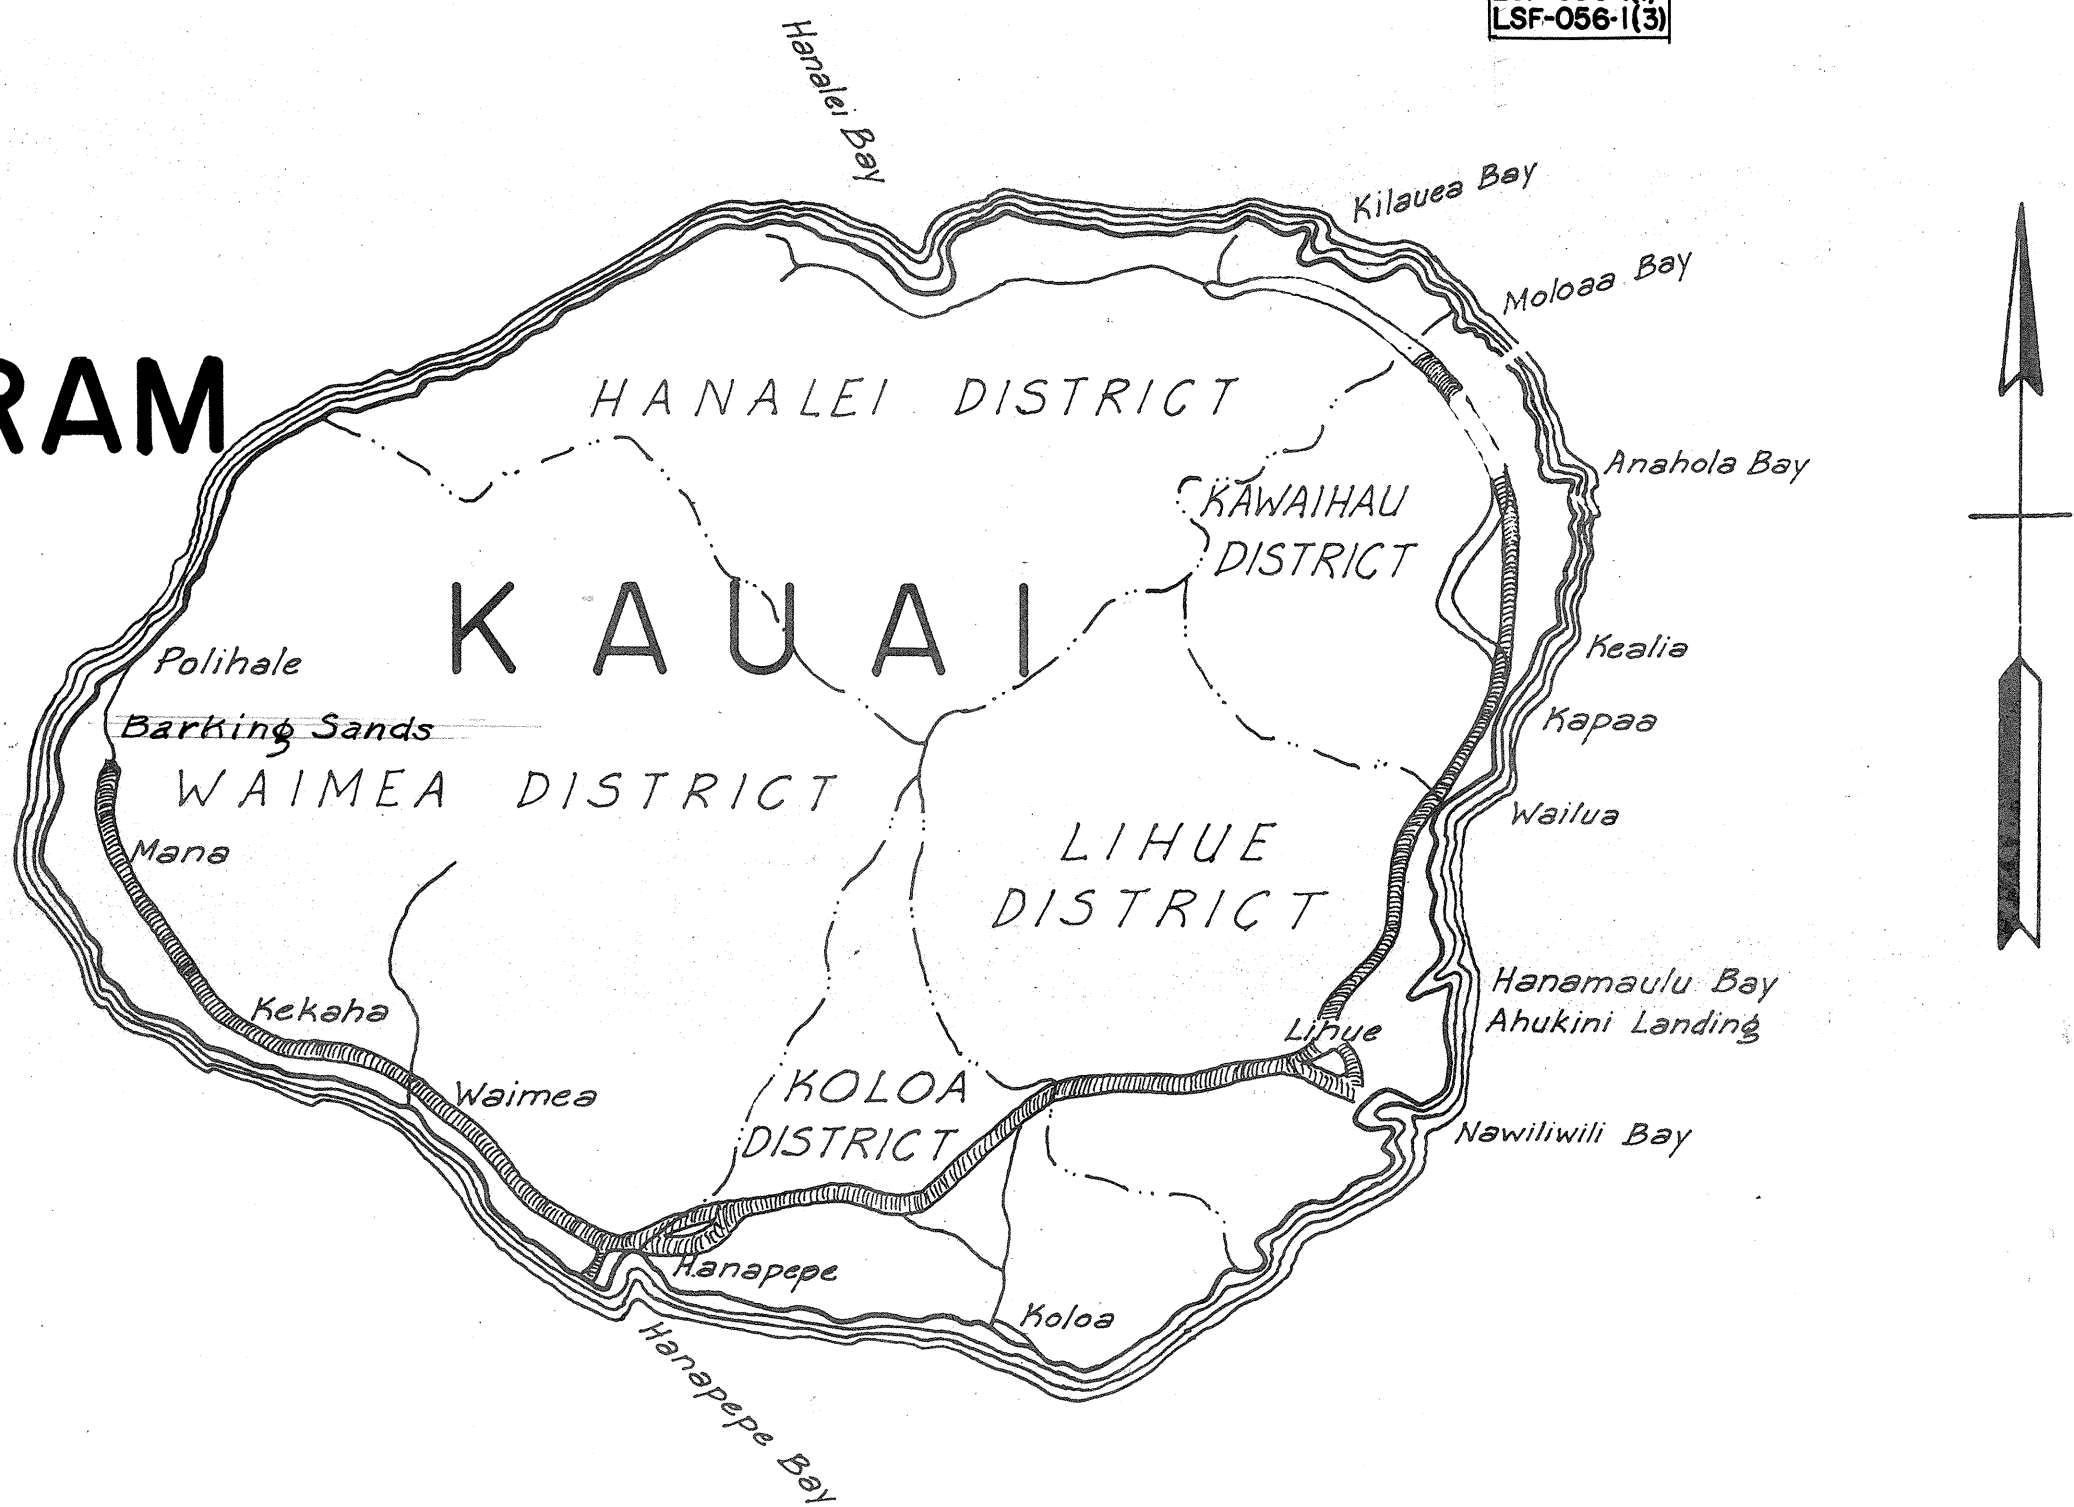
ALIOMANU STREAM TO PAPAA STREAM PROJ. NO. LSF-056-1(4)

KEALIA LOOKOUT PROJ. NO. LSF-056-1(1)

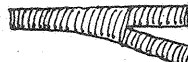
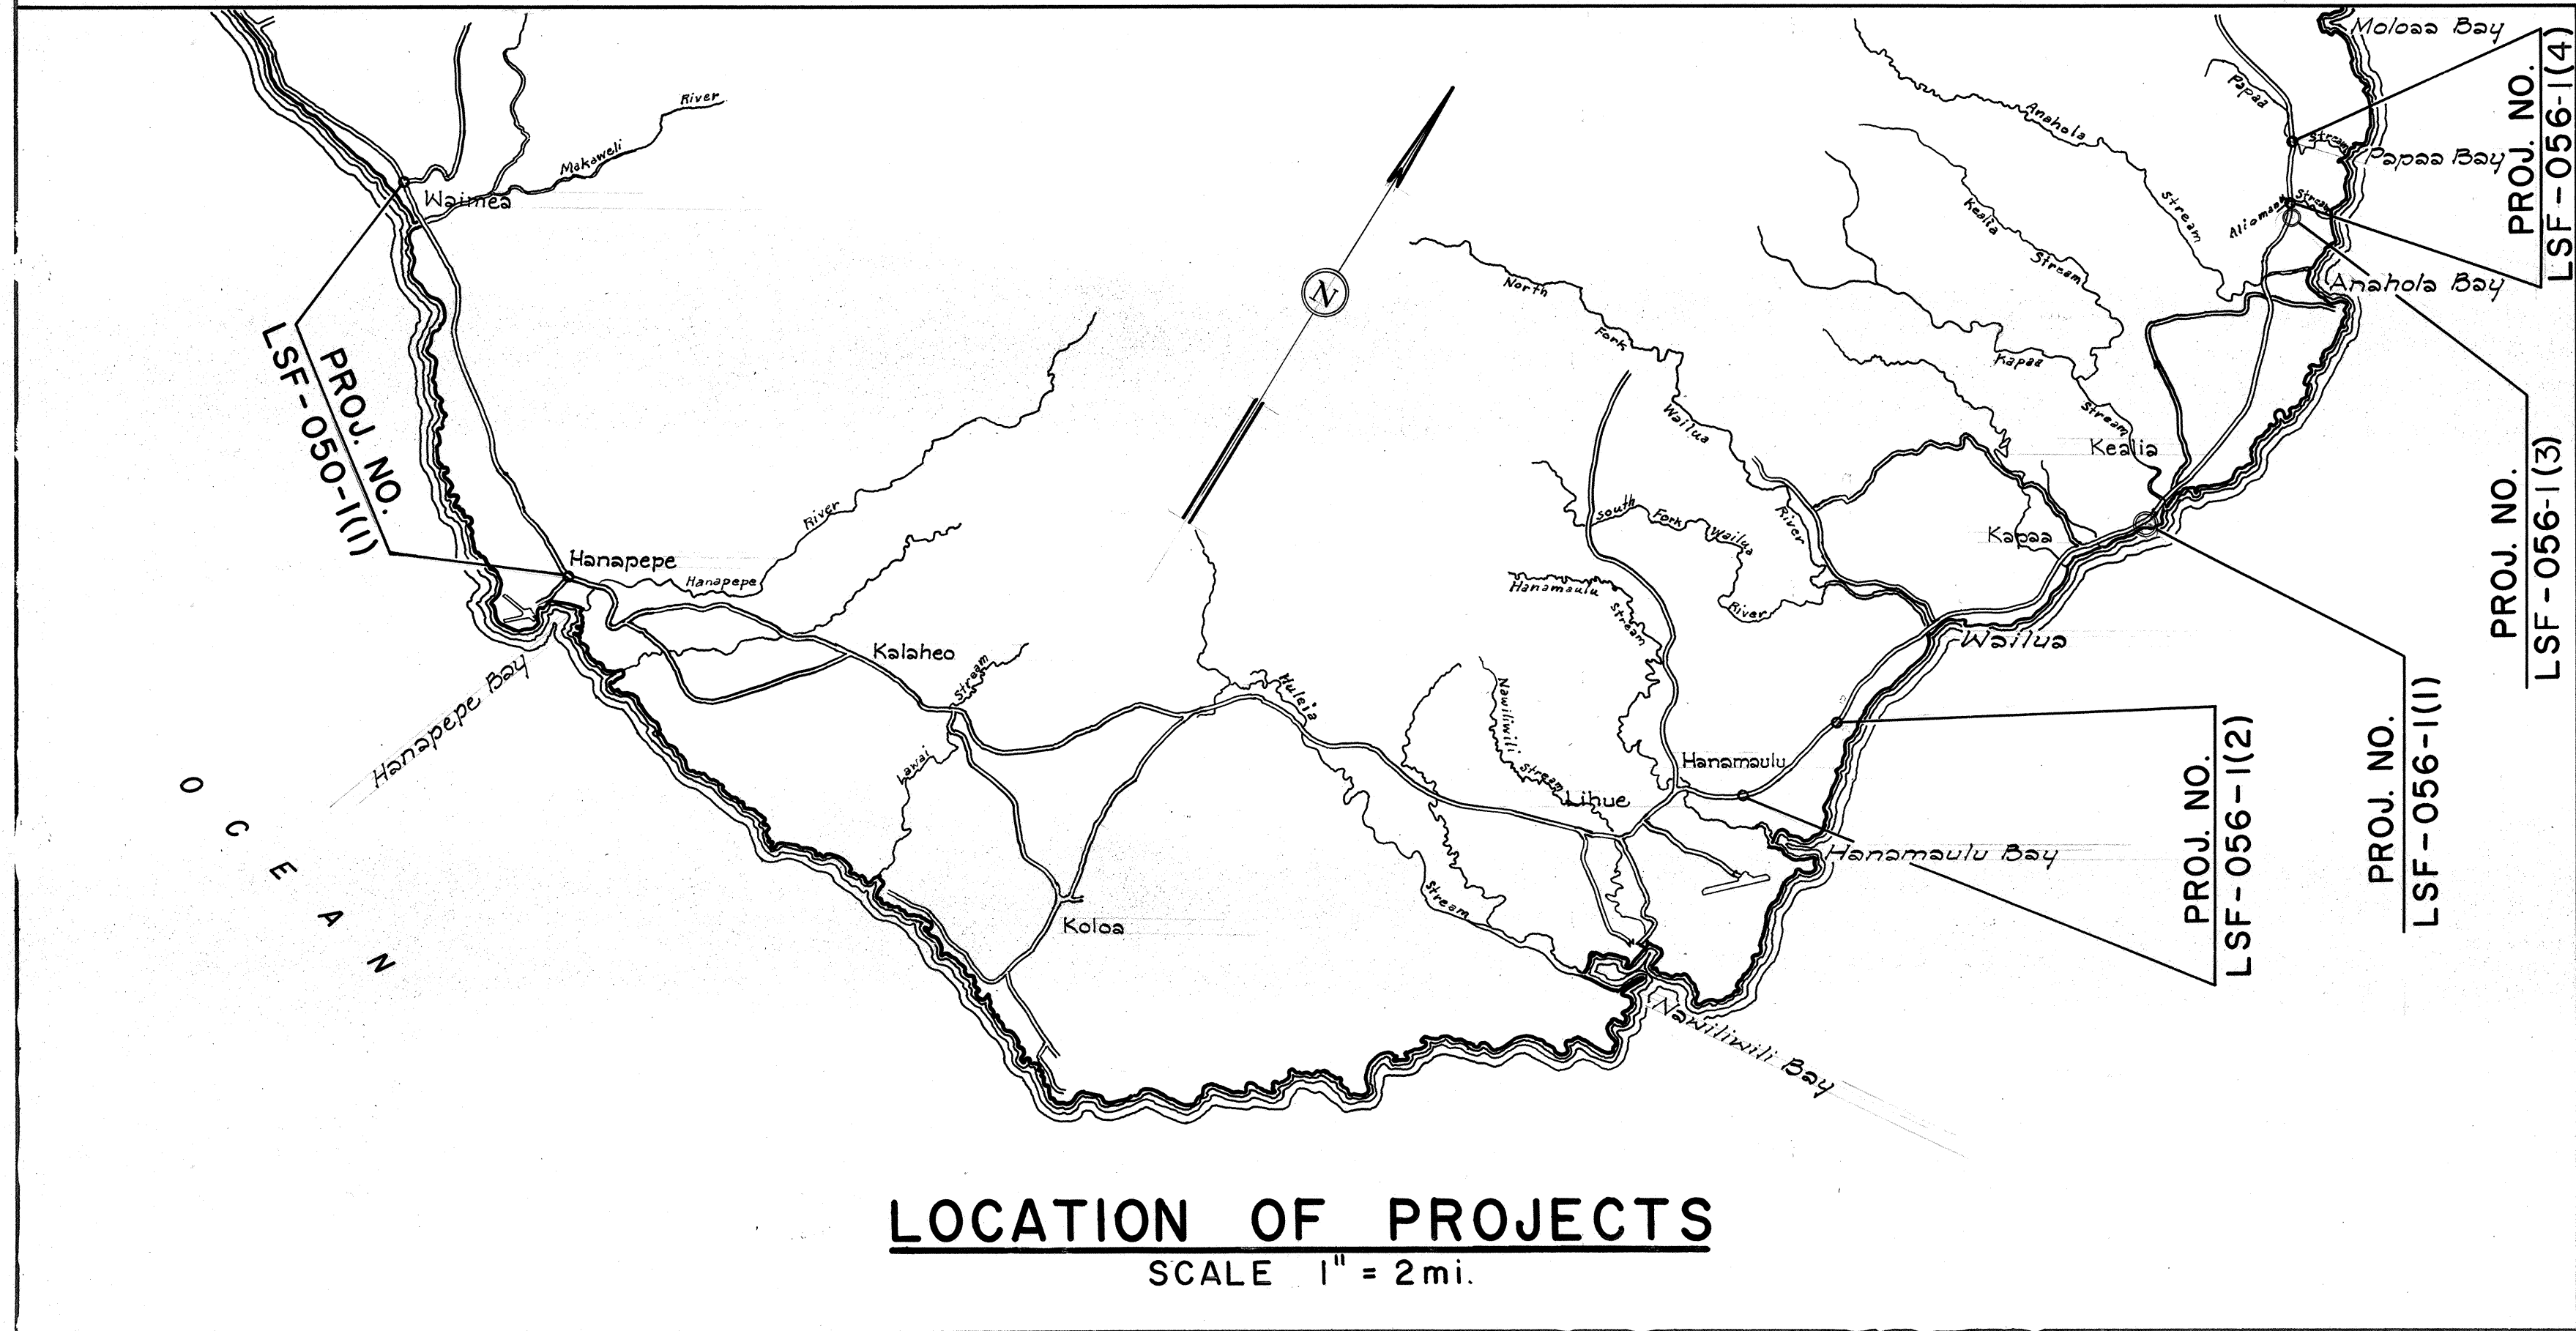
ANAHOLA REST STOP PROJ. NO. LSF-056-1(3)

ISLAND OF KAUAI

FED. ROAD DIST. NO.	STATE	FED. AID PROJ. NO.	FISCAL YEAR	SHEET NO.	TOTAL SHEETS
HAWAII	HAW.	LSF-050-1(1) LSF-056-1(2) LSF-056-1(4) LSF-056-1(1) LSF-056-1(3)	1967	1	15



FEDERAL AID PROJECTS PREVIOUSLY CONSTRUCTED OR UNDER CONSTRUCTION

NO AS-BUILT CHANGES MADE

DURING CONSTRUCTION.

Donald Nagamine

PROJECT ENGINEER

8-11-81

DATE

SURVEY PLOTTED BY	DATE
DESIGNED BY	DATE
TRACED BY	DATE
QUANTITIES BY	DATE
CHECKED BY	DATE
ORIGINAL PLAN	NO.
NOTE BOOK	NO.

APPROVED:

DATE 4/9/68

John H. C. [Signature]

DIRECTOR OF TRANSPORTATION

DEPARTMENT OF TRANSPORTATION

BUREAU OF PUBLIC ROADS

APPROVED:

Neil D. [Signature]

DIVISION ENGINEER

4-10-68

DATE