


FED. ROAD DIST. NO.	STATE	PROJ. NO.	FISCAL YEAR	SHEET NO.	TOTAL SHEETS
HAWAII	HAW.	50A-02-70 S.C. 8-01-70	1969	3	8

ORIGINAL PLAN	DATE
SURVEY PLOTTED BY	
DRAWN BY	
TRACED BY	
QUANTITIES BY	
CHECKED BY	
NOTE BOOK No.	



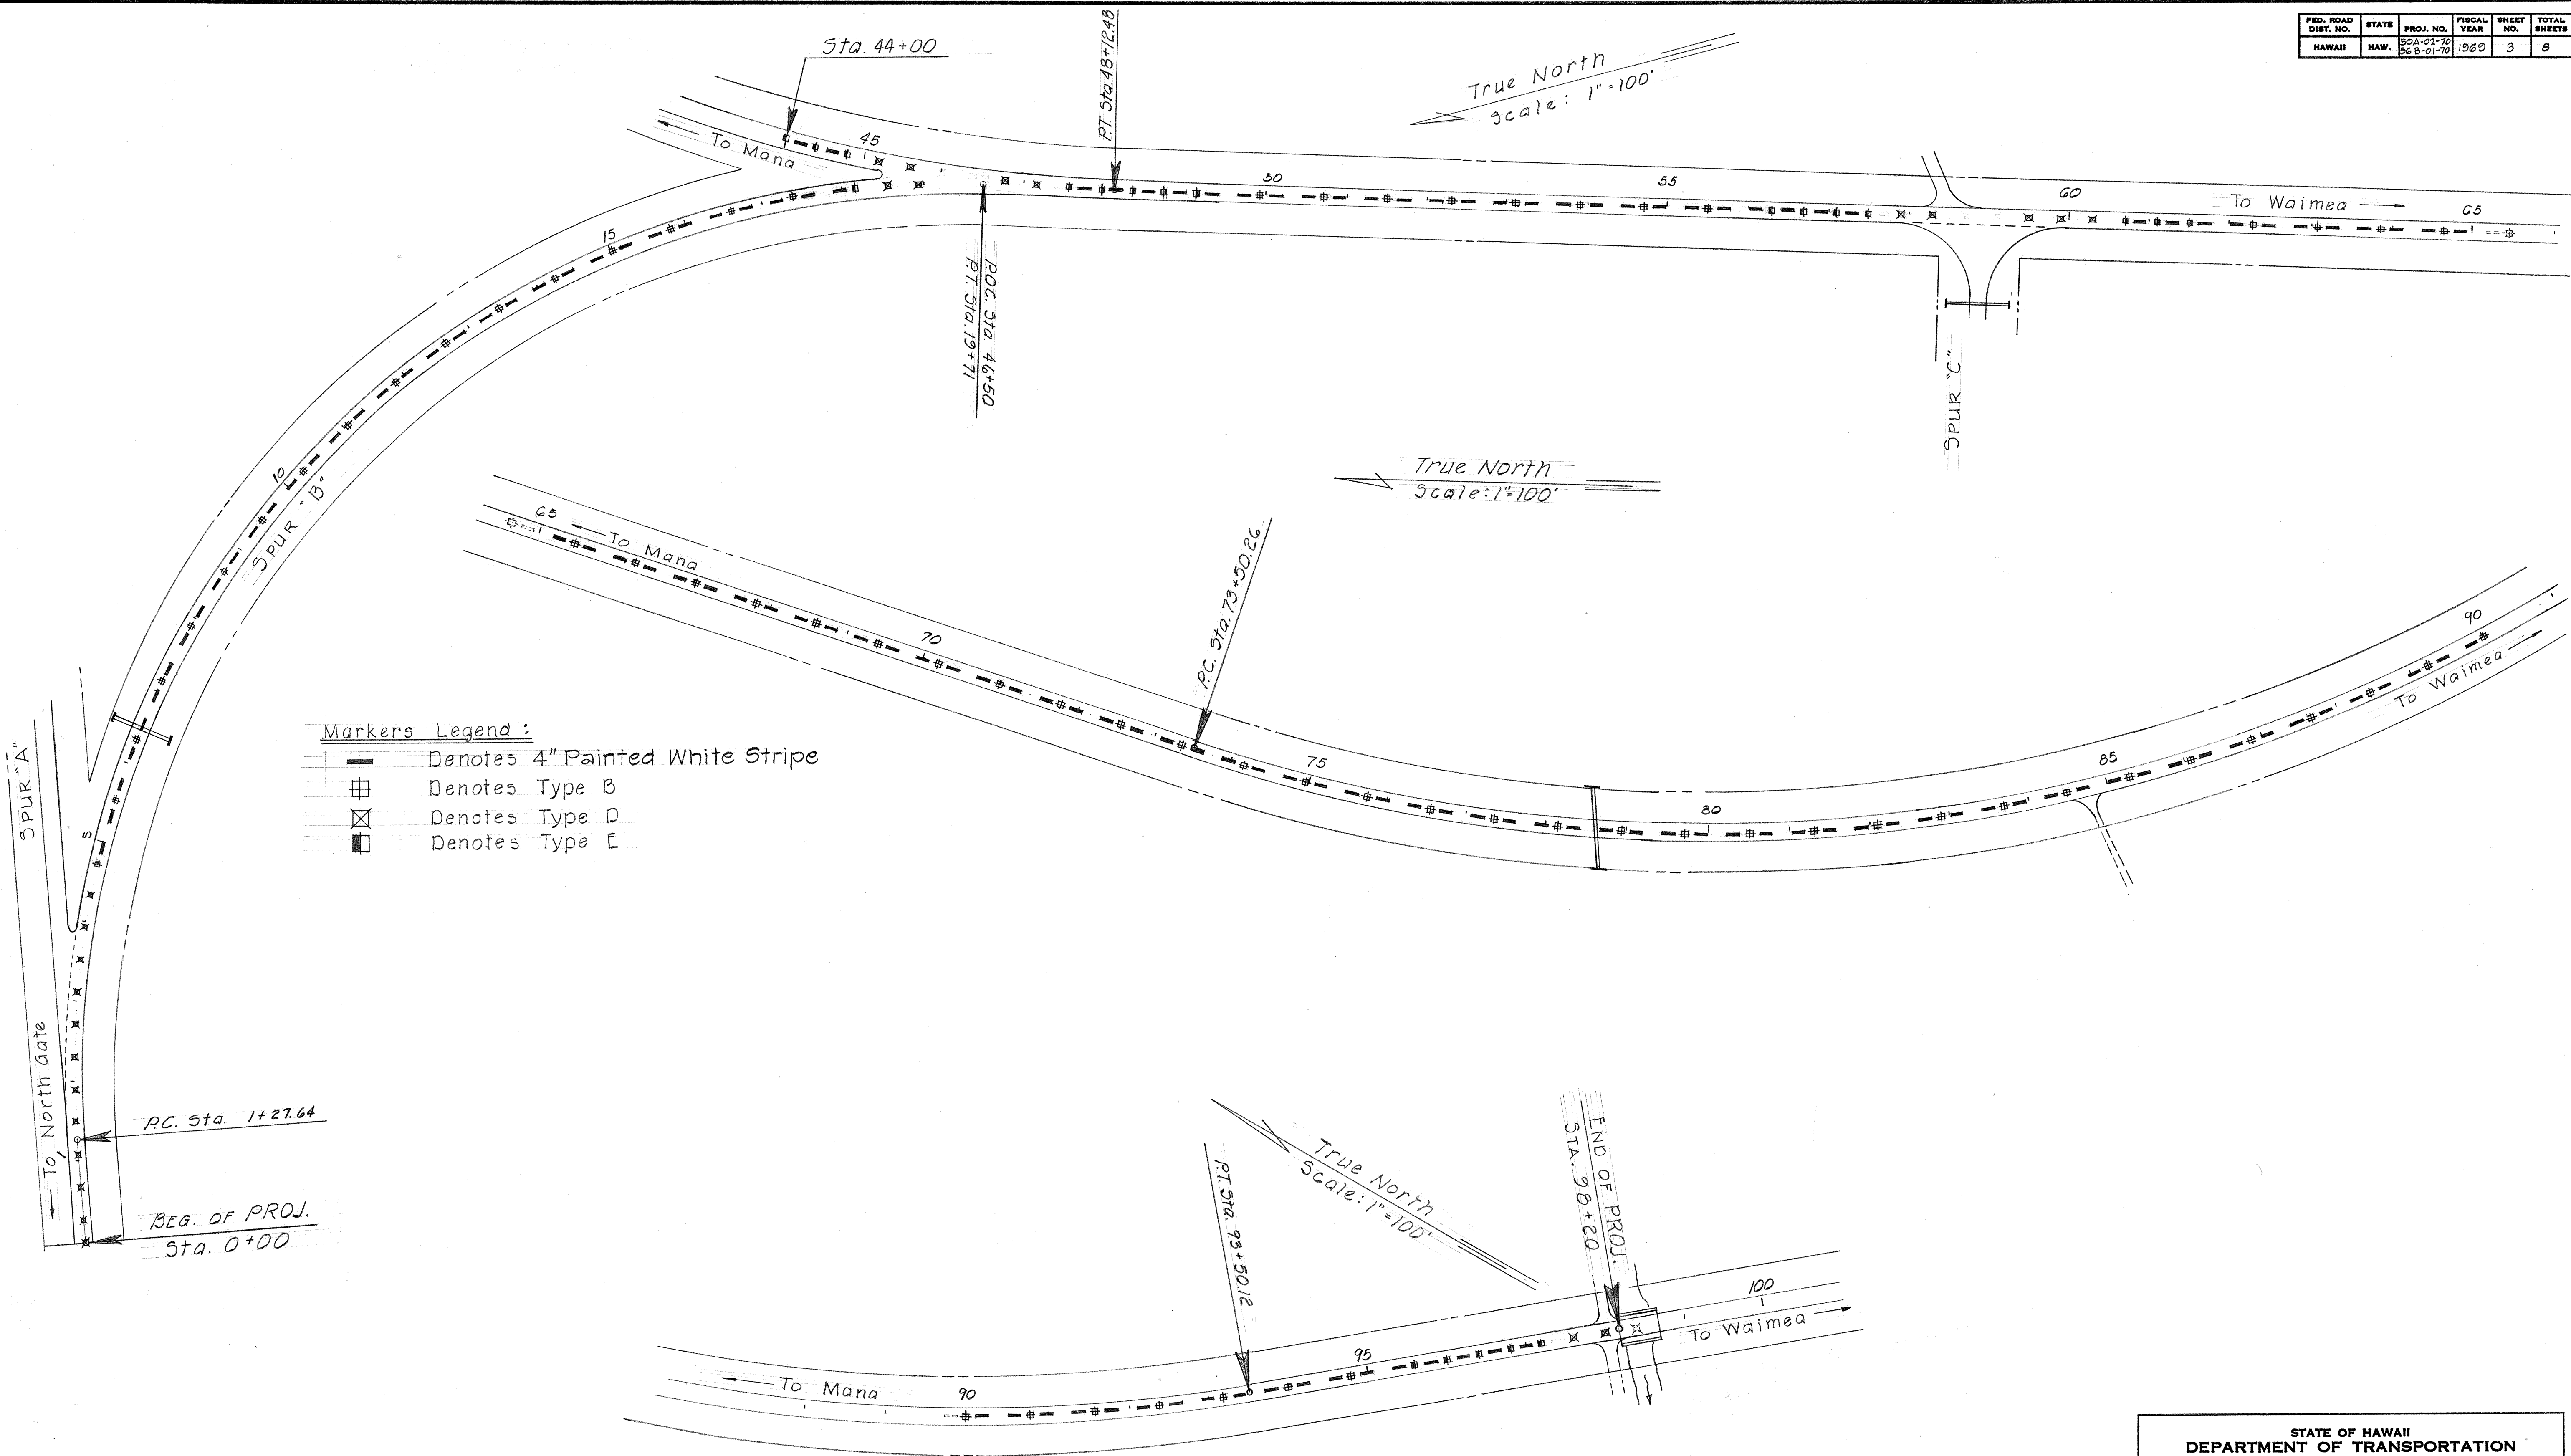


STATE OF HAWAII
DEPARTMENT OF TRANSPORTATION
HIGHWAYS DIVISION

PLAN &
PAVEMENT MARKINGS
KAUAI BELT ROAD
PROJ. NO. 50A-02-70

SCALE: AS SHOWN DATE: Oct., 1969
SHEET No. 1 OF 2 SHEETS

FED. ROAD DIST. NO.	STATE	PROJ. NO.	FISCAL YEAR	SHEET NO.	TOTAL SHEETS
HAWAII	HAW.	50A-0270 S&S-0170	1969	4	8

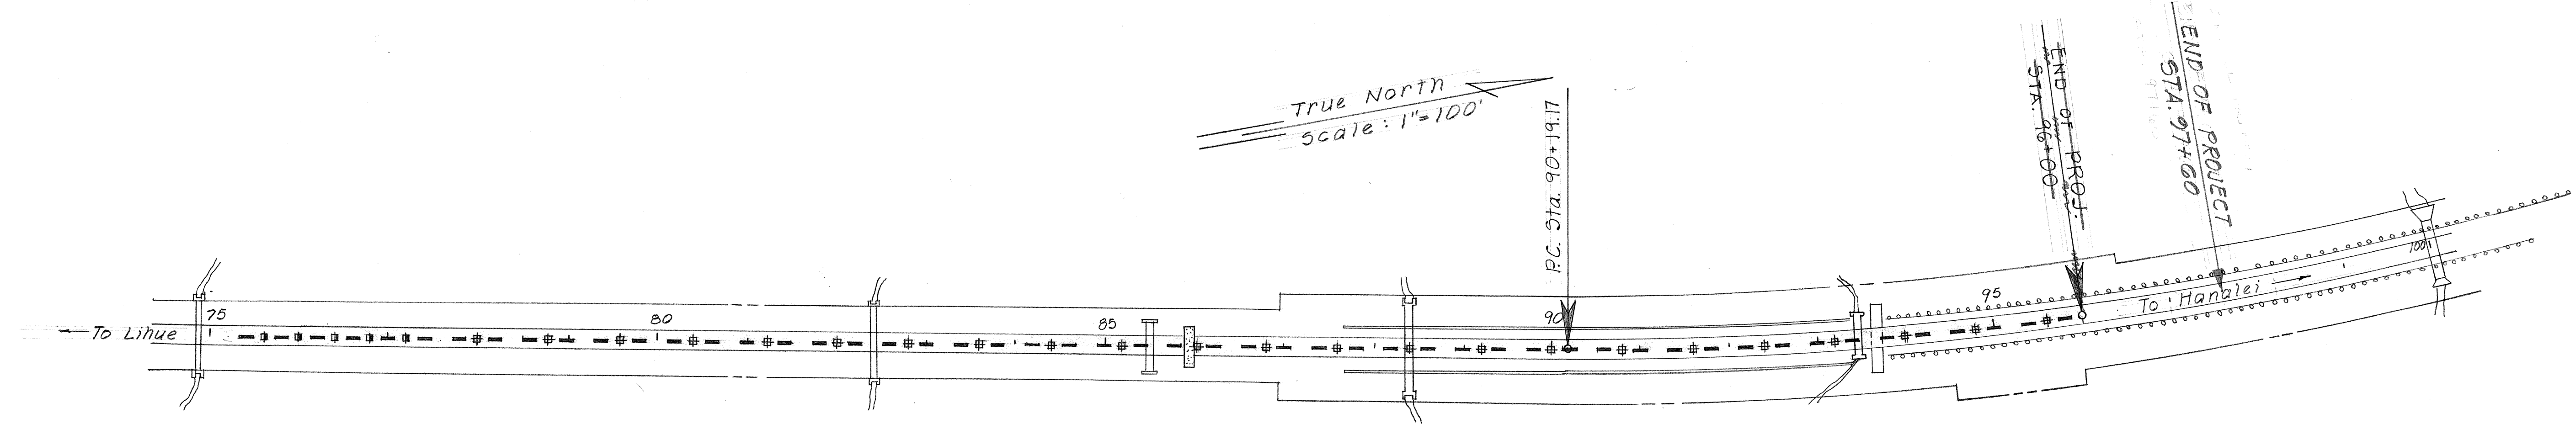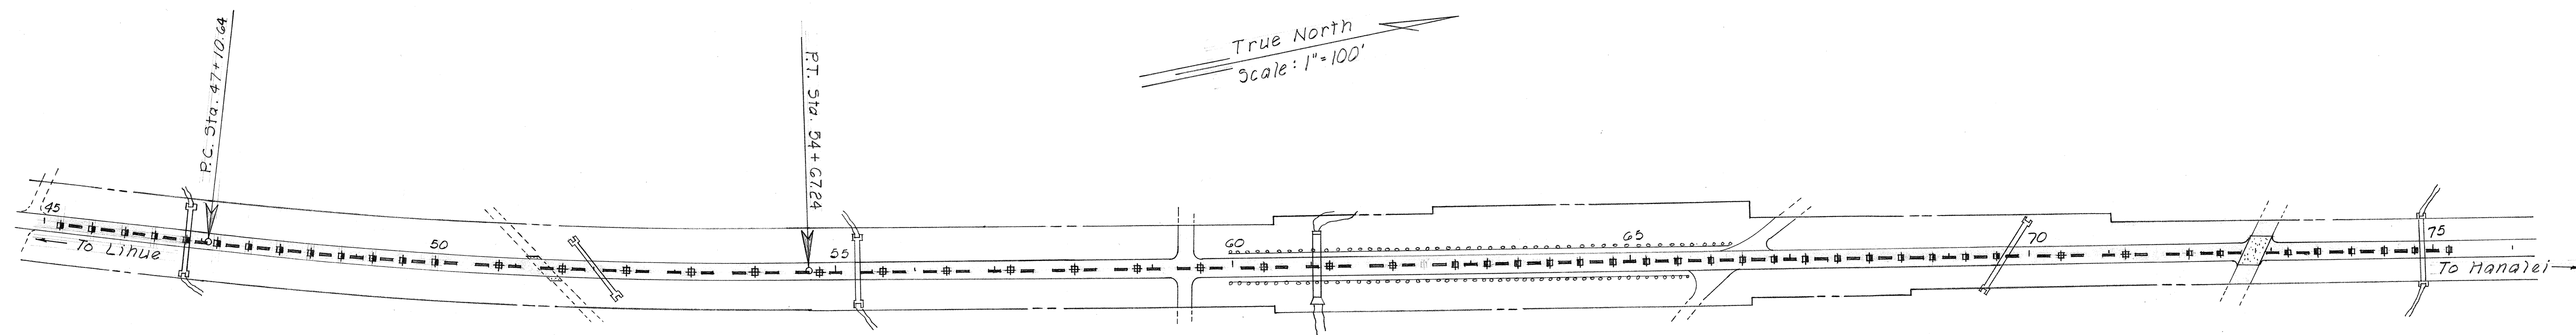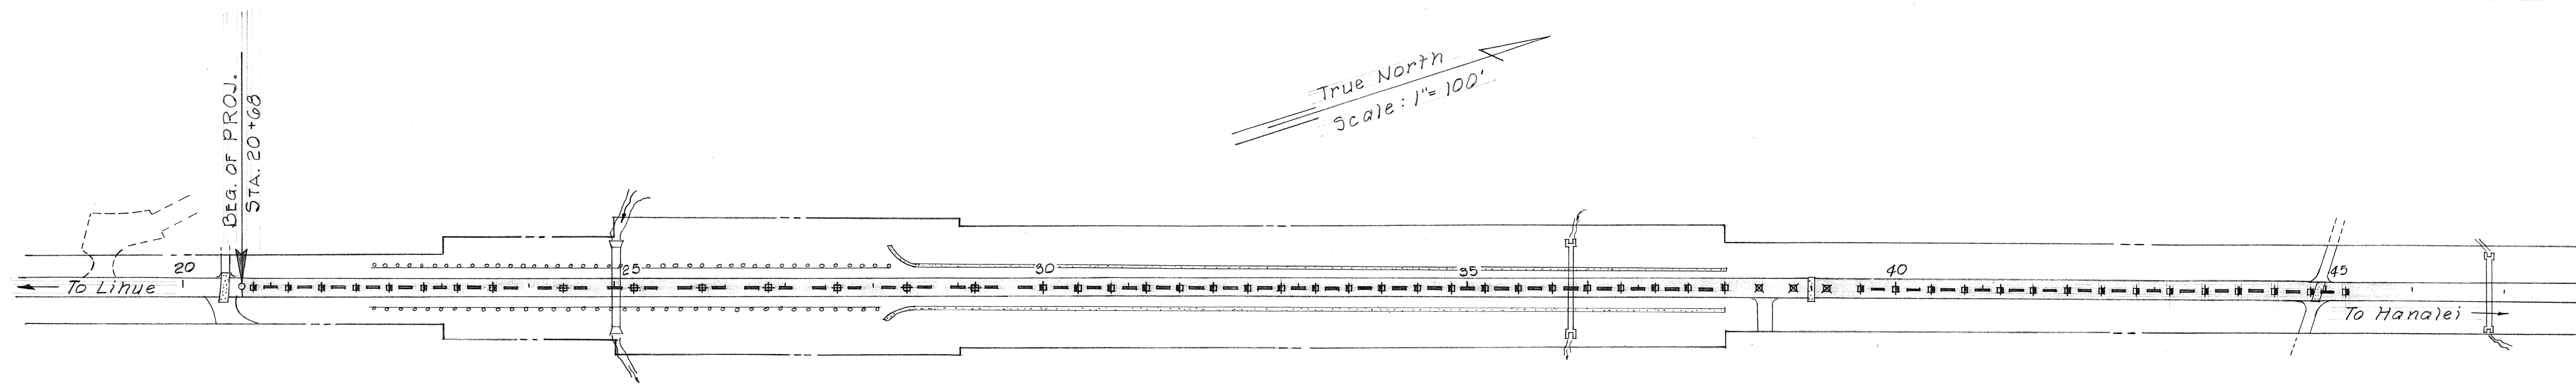

- Markers Legend:**
- Denotes 4" Painted White Stripes
 - ⊕ Denotes Type B
 - ⊗ Denotes Type D
 - Denotes Type E

STATE OF HAWAII
DEPARTMENT OF TRANSPORTATION
HIGHWAYS DIVISION

**PLAN &
PAVEMENT MARKINGS
KAUAI BELT ROAD
PROJ. NO. 50B-01-70**

SCALE: AS SHOWN DATE: Oct., 1969

SHEET No. 2 OF 2 SHEETS

ORIGINAL PLAN	SURVEY PLOTTED BY	DATE
NO. 1	DRAWN BY	
NO. 2	DESIGNED BY	
NO. 3	QUANTITIES BY	
NO. 4	CHECKED BY	