


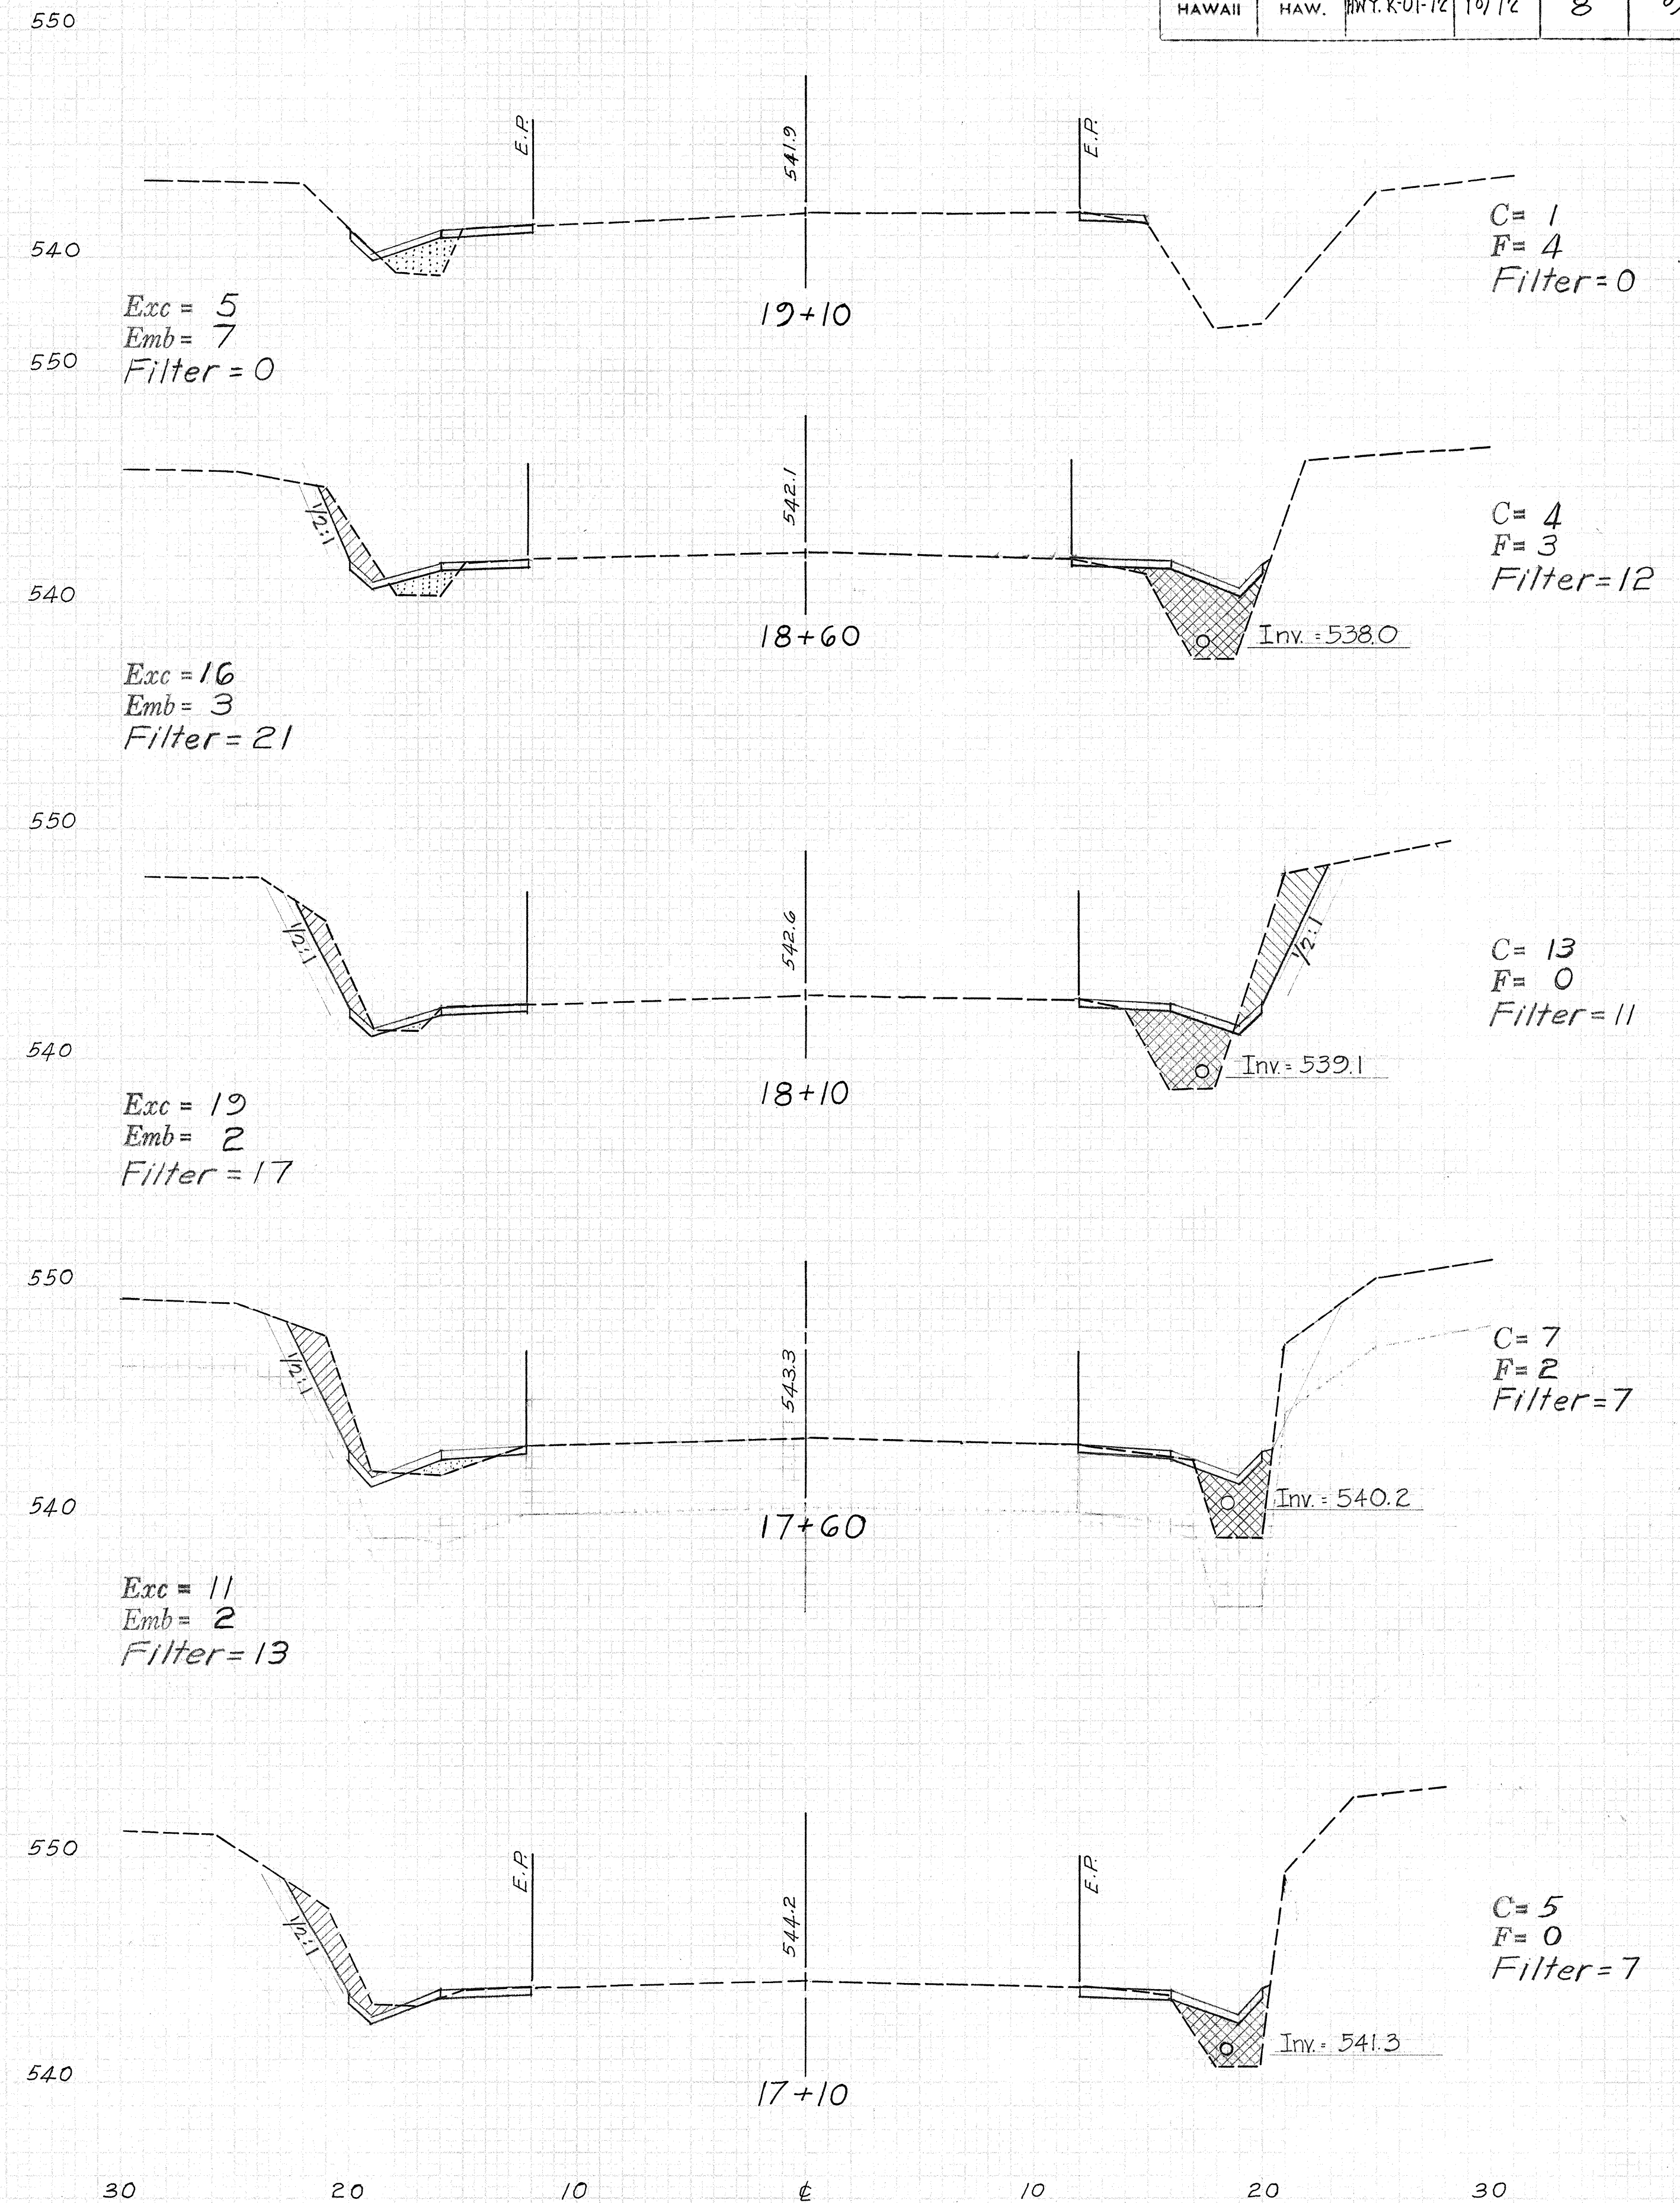

Scale: 1" = 5' Horiz. & Vert.

S