

INDEX TO DRAWINGS	
SHEET NO.	DESCRIPTION
1	TITLE SHEET
2	TYPICAL SECTIONS & GENERAL NOTES

STATE OF HAWAII

DEPARTMENT OF TRANSPORTATION

HIGHWAYS DIVISION

"AS BUILT"

PLANS FOR



RESURFACING AT VARIOUS LOCATIONS

ON KUHIO AND KAUMUALI HIGHWAYS

PROJECT NO. HWY-K-01-77M

DISTRICTS OF KOLOA, KAWAIHAU & HANAIEI

ISLAND OF KAUAI

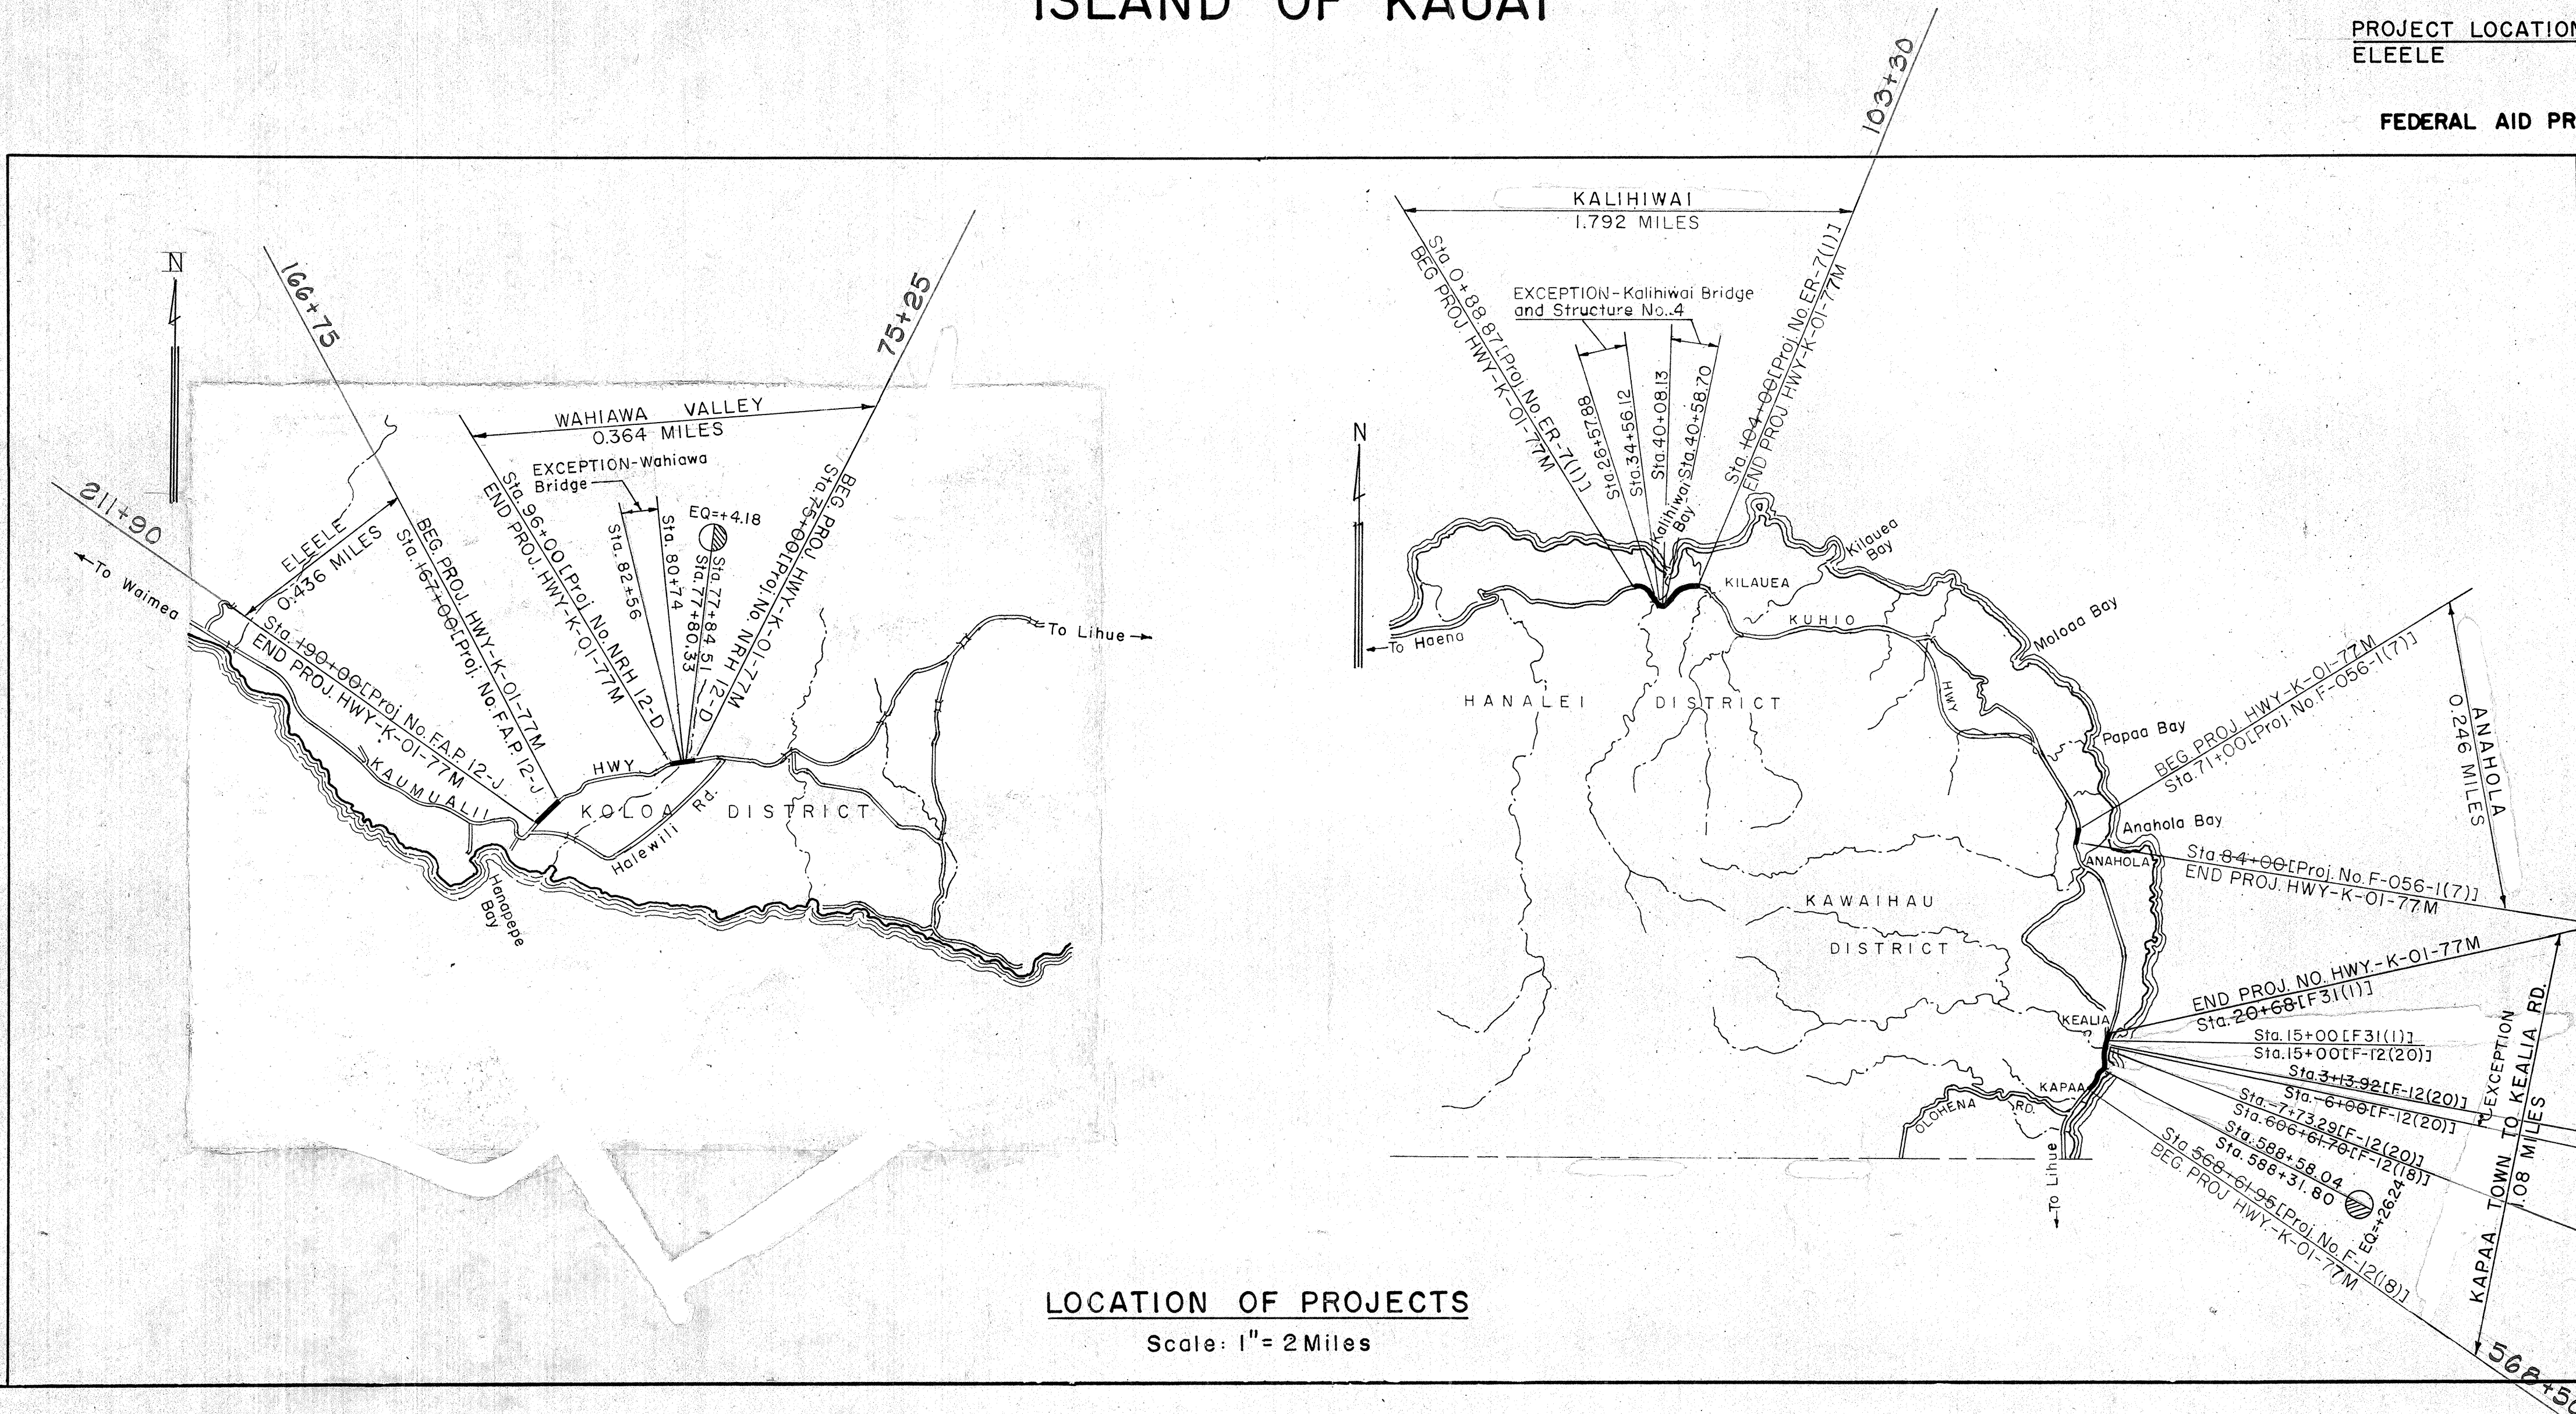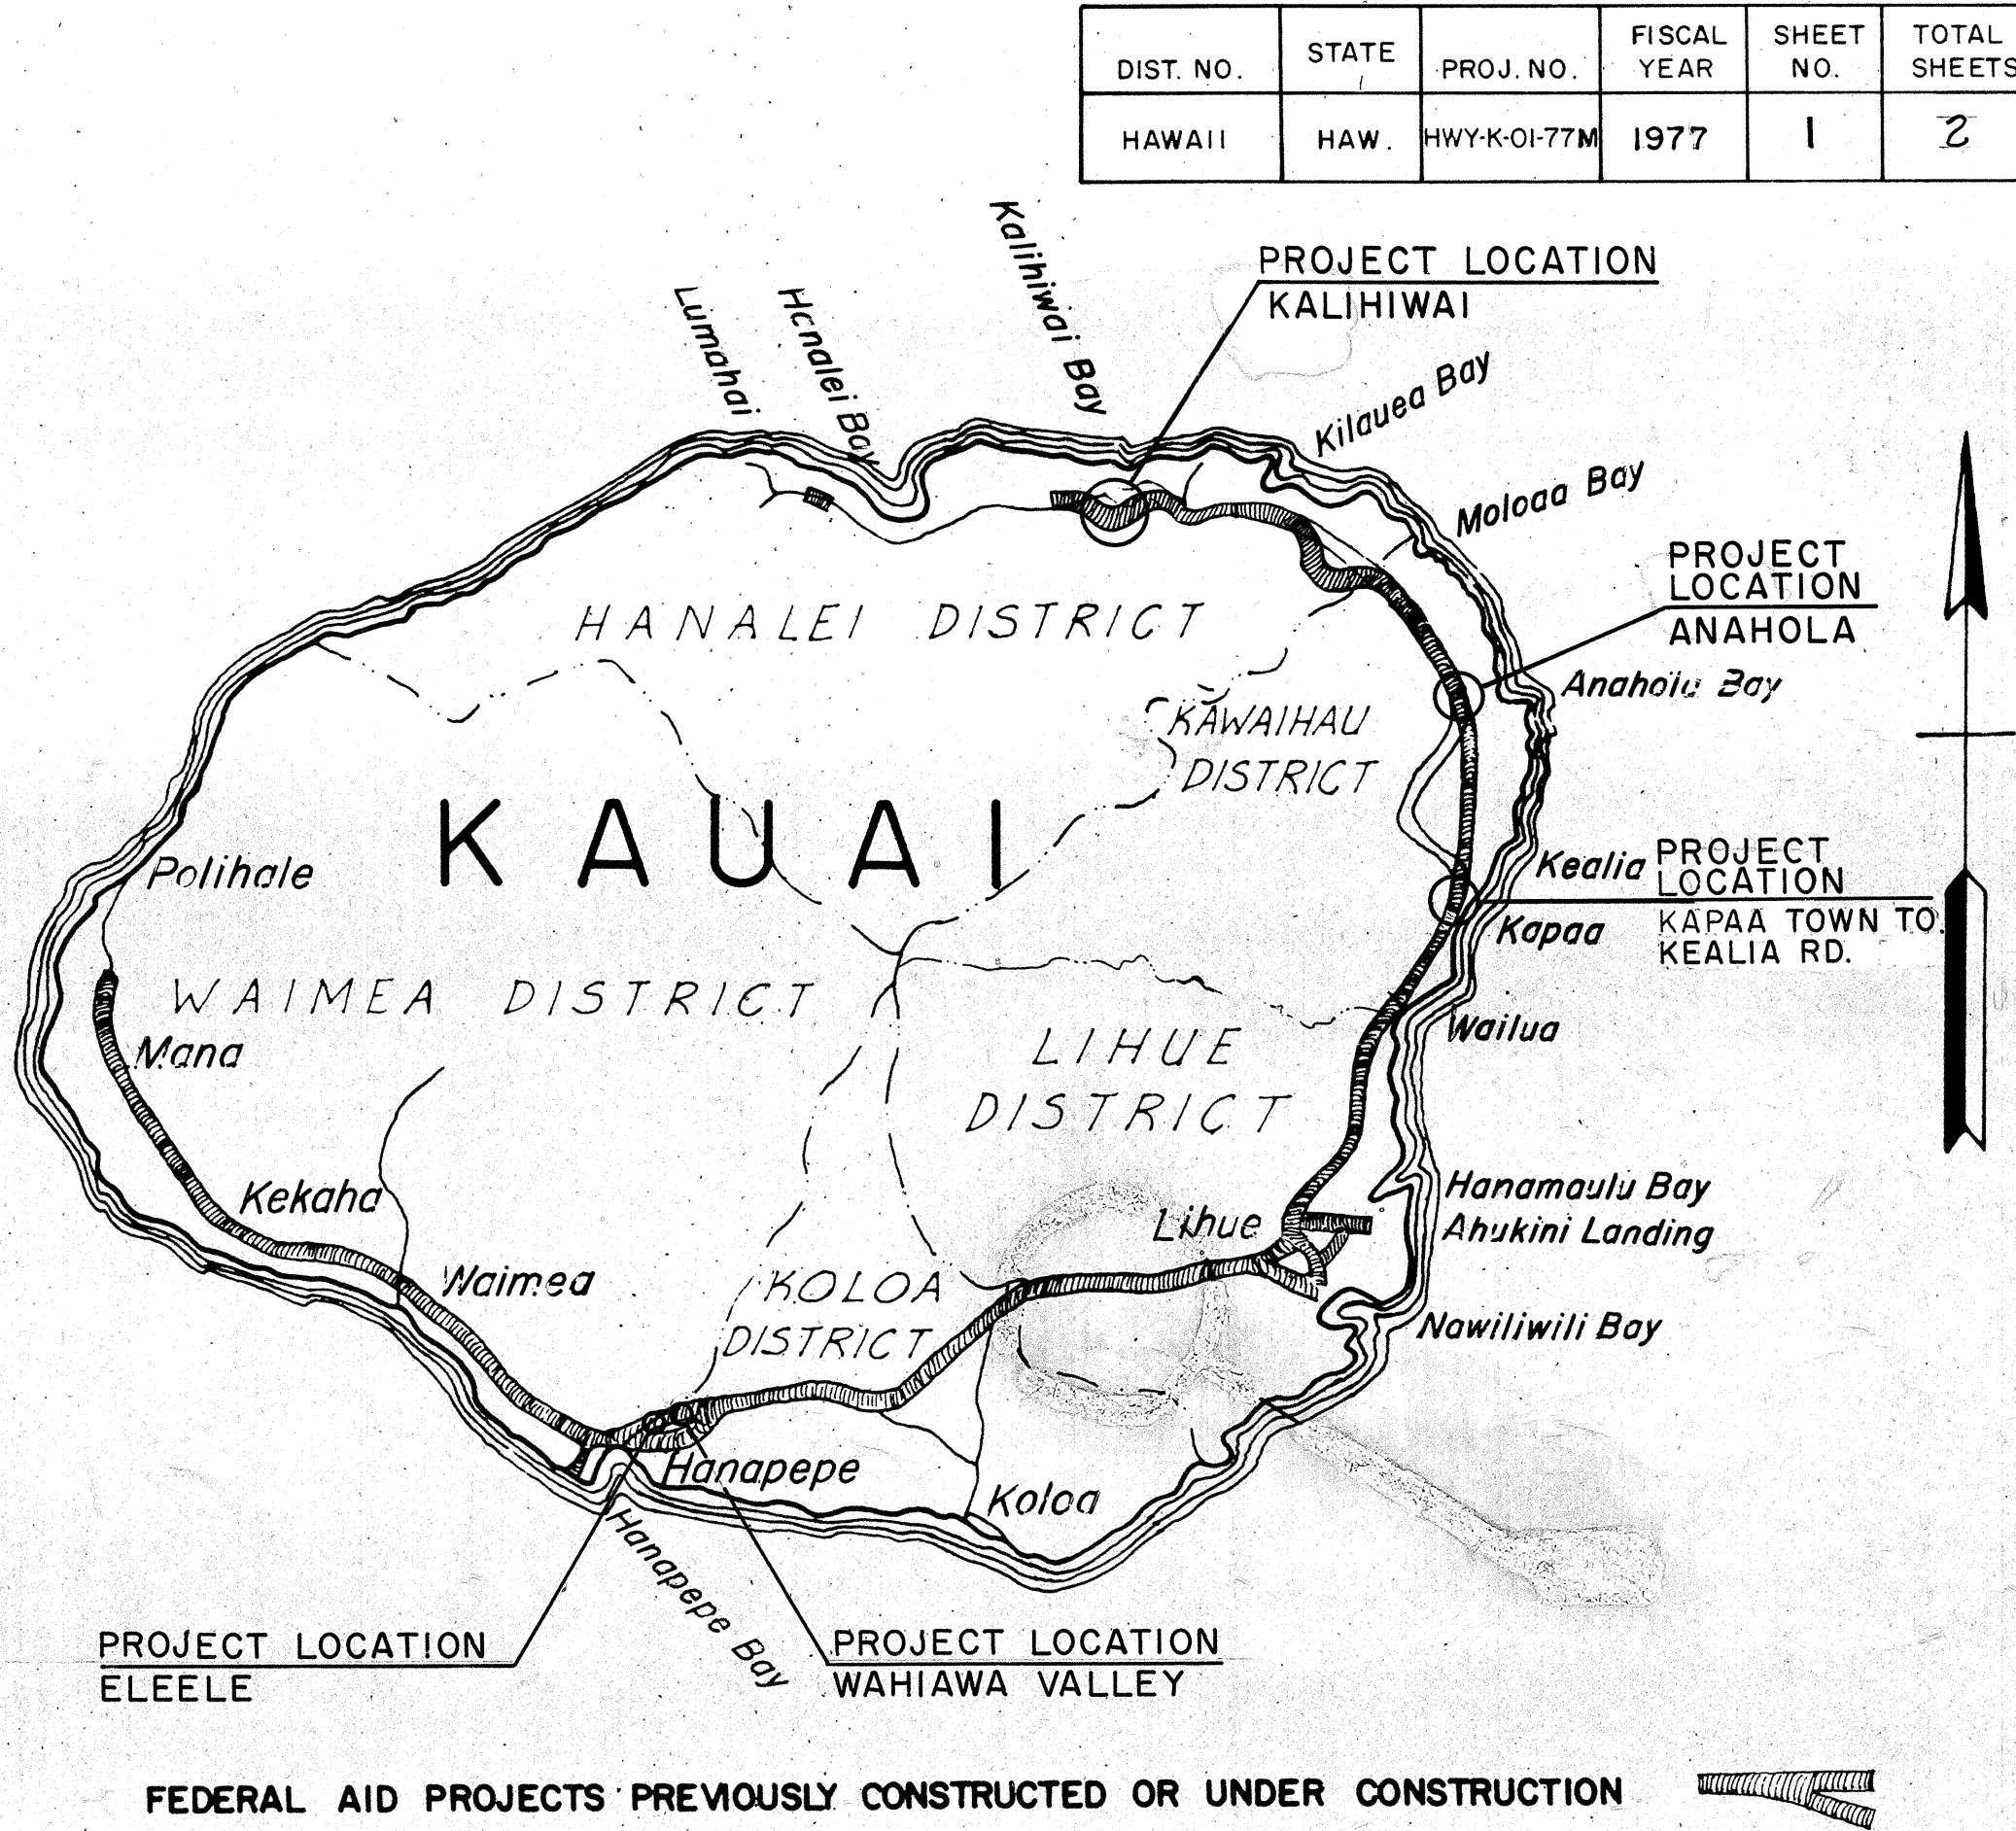

NOTE:

ALL CHANGES MADE DURING CONSTRUCTION HAVE BEEN NOTED IN RED ON THESE TRACINGS AND CHECKED BY:

[Signature]

PROJECT ENGINEER

7-6-77

DATE

DEPARTMENT OF TRANSPORTATION

STATE OF HAWAII

APPROVED:

R. Higashionna

11/30/76

for DIR. OF TRANSPORTATION

DATE

Date

548-7537

Phone-Loc

D. Bevier

PS&E By

Kauai District

Designed By

6817-2122 577-0360

ORIGINAL

DESIGNED BY

DATE

PLAN

DRAWN BY

QUANTITIES BY

NOTE BOOK

QUANTITIES CHECKED BY

NO.