
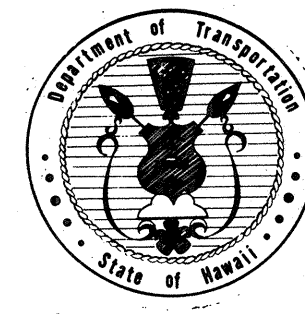


INDEX TO DRAWINGS	
SHEET NO.	DESCRIPTION
1	TITLE SHEET
2	TYPICAL SECTIONS, CONSTRUCTION
	NOTES & SUMMARY OF QUANTITIES
3	PLANS & GENERAL NOTES

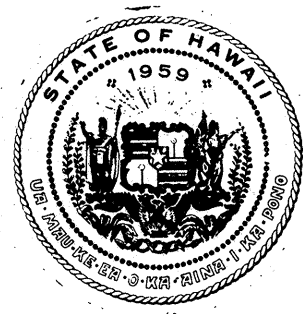


STATE OF HAWAII
DEPARTMENT OF TRANSPORTATION
LAND TRANSPORTATION FACILITIES DIVISION

"AS BUILT"
PLANS FOR
RESURFACING VARIOUS LOCATIONS
ON KAUAI BELT ROAD

PROJECT NO. HWY-K-01-78M

DISTRICTS OF WAIMEA, LIHUE & KAWAIHAU
ISLAND OF KAUAI

FED. ROAD DIST. NO.	STATE	PROJ. NO.	FISCAL YEAR	SHEET NO.	TOTAL SHEETS
HAWAII	HAW.	HWY-K-01-78M	1977	1	3

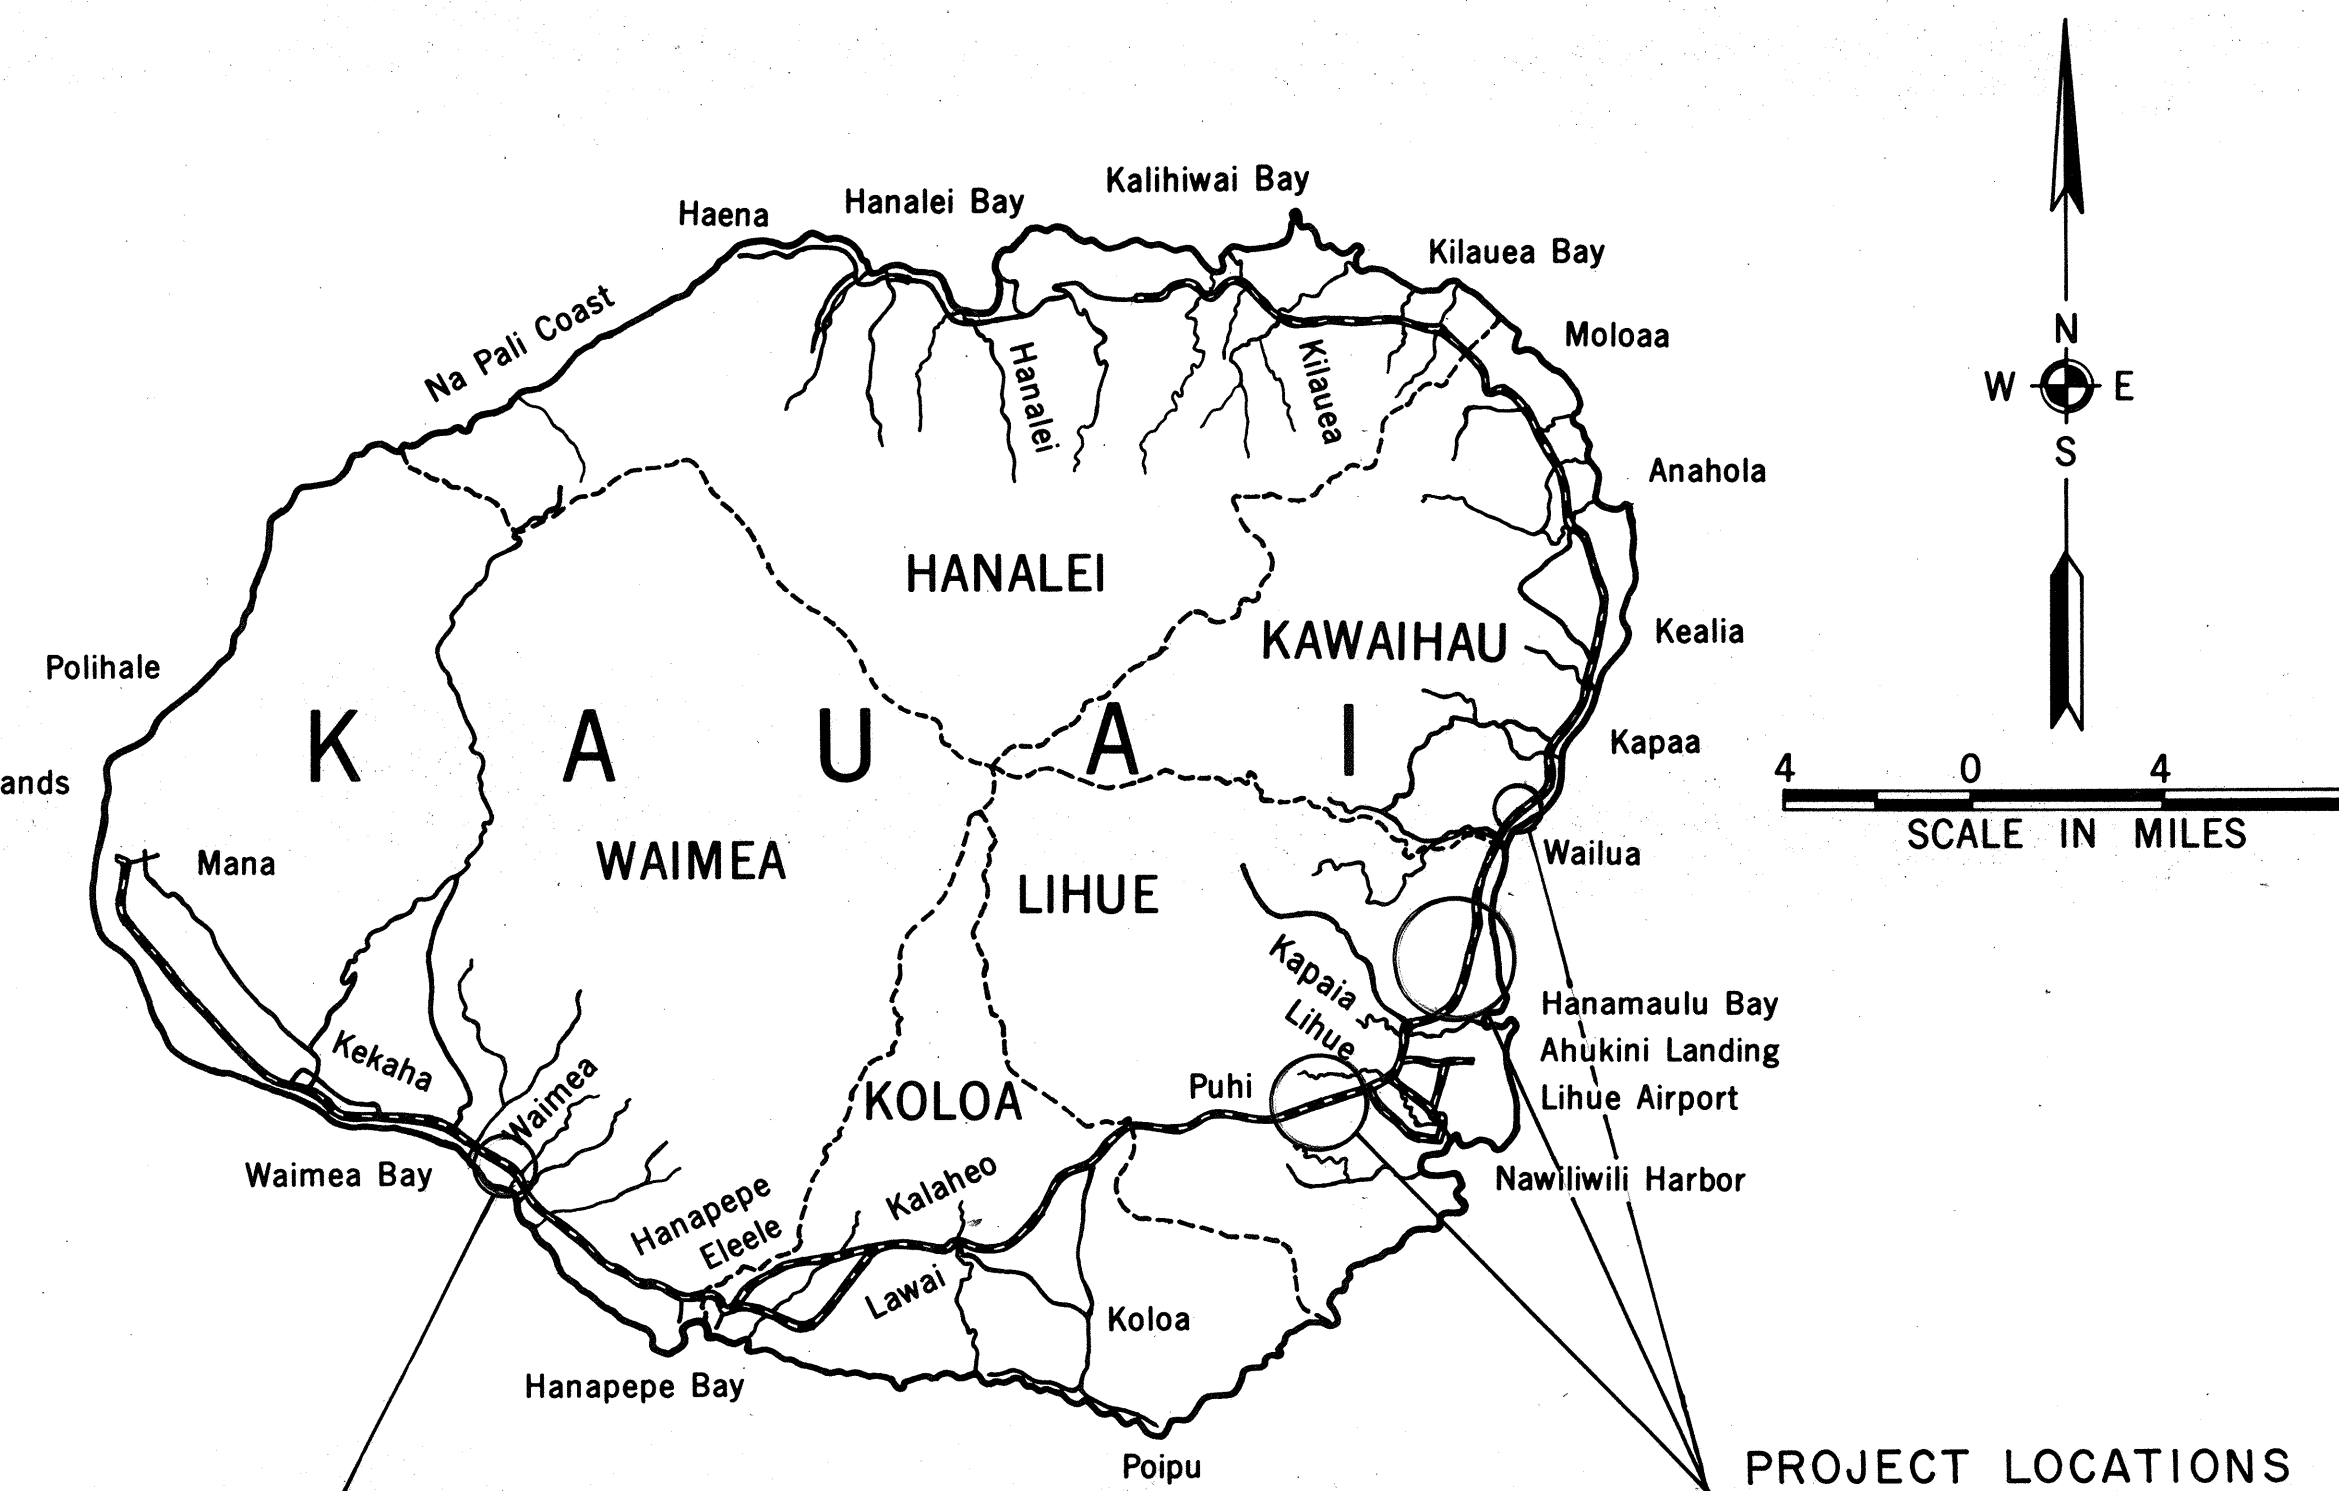

FEDERAL AID PROJECTS PREVIOUSLY CONSTRUCTED
OR UNDER CONSTRUCTION


NOTE:

ALL CHANGES MADE DURING CONSTRUCTION
HAVE BEEN INCORPORATED ON THESE
PLANS IN RED EXCEPT CHANGES IN THE
ORIGINAL THEORETICAL QUANTITIES.


[Signature]
PROJECT ENGINEER

8-8-78
DATE


KAUAI DISTRICT
DESIGNED BY
D. BEVIER
P. S. & E. BY
548-7537
NOV. 15, 1977
DATE

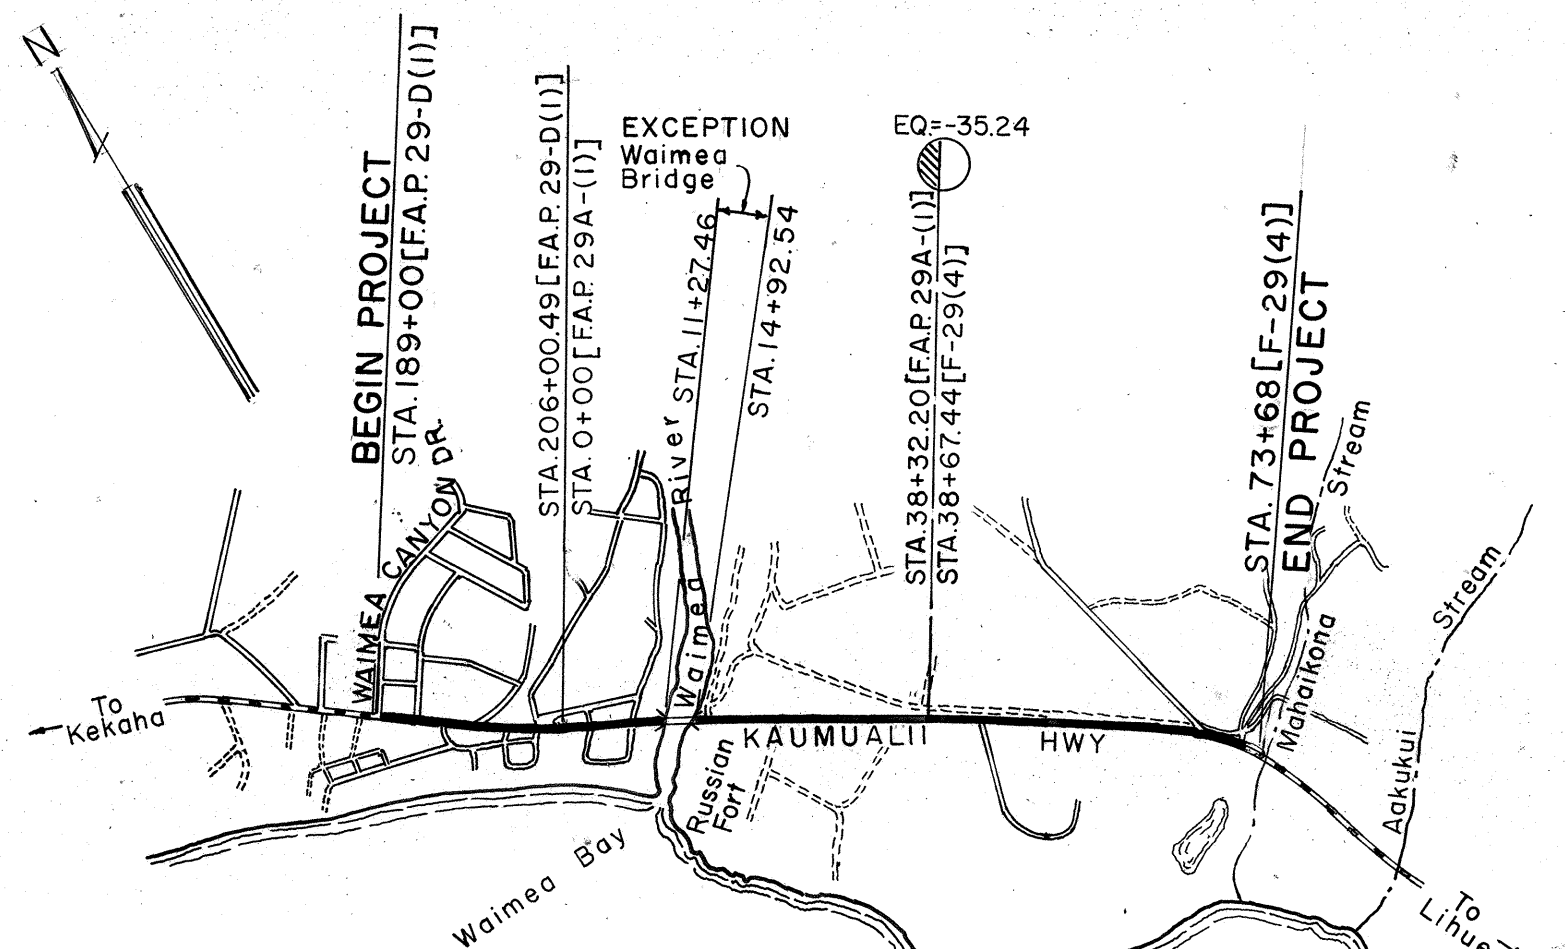


WAIMEA CANYON DRIVE TO MAHAIKONA BRIDGE
LENGTH OF PROJECT = 1.642 MI.

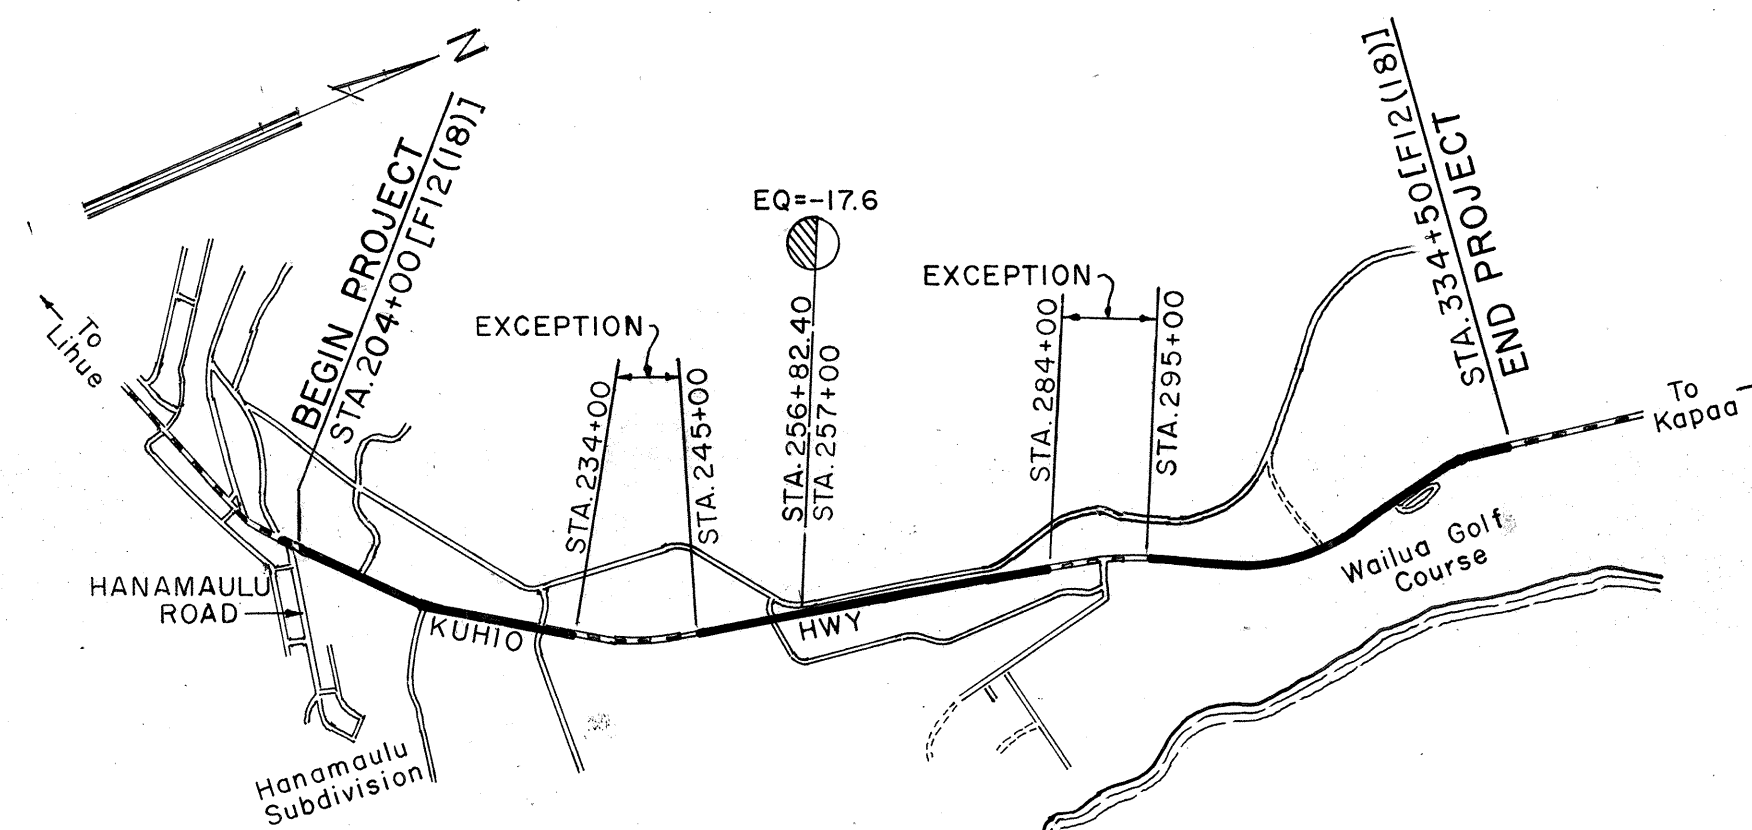

HANALEI TO WAILUA GOLF COURSE
LENGTH OF PROJECT = 2.052 MI.

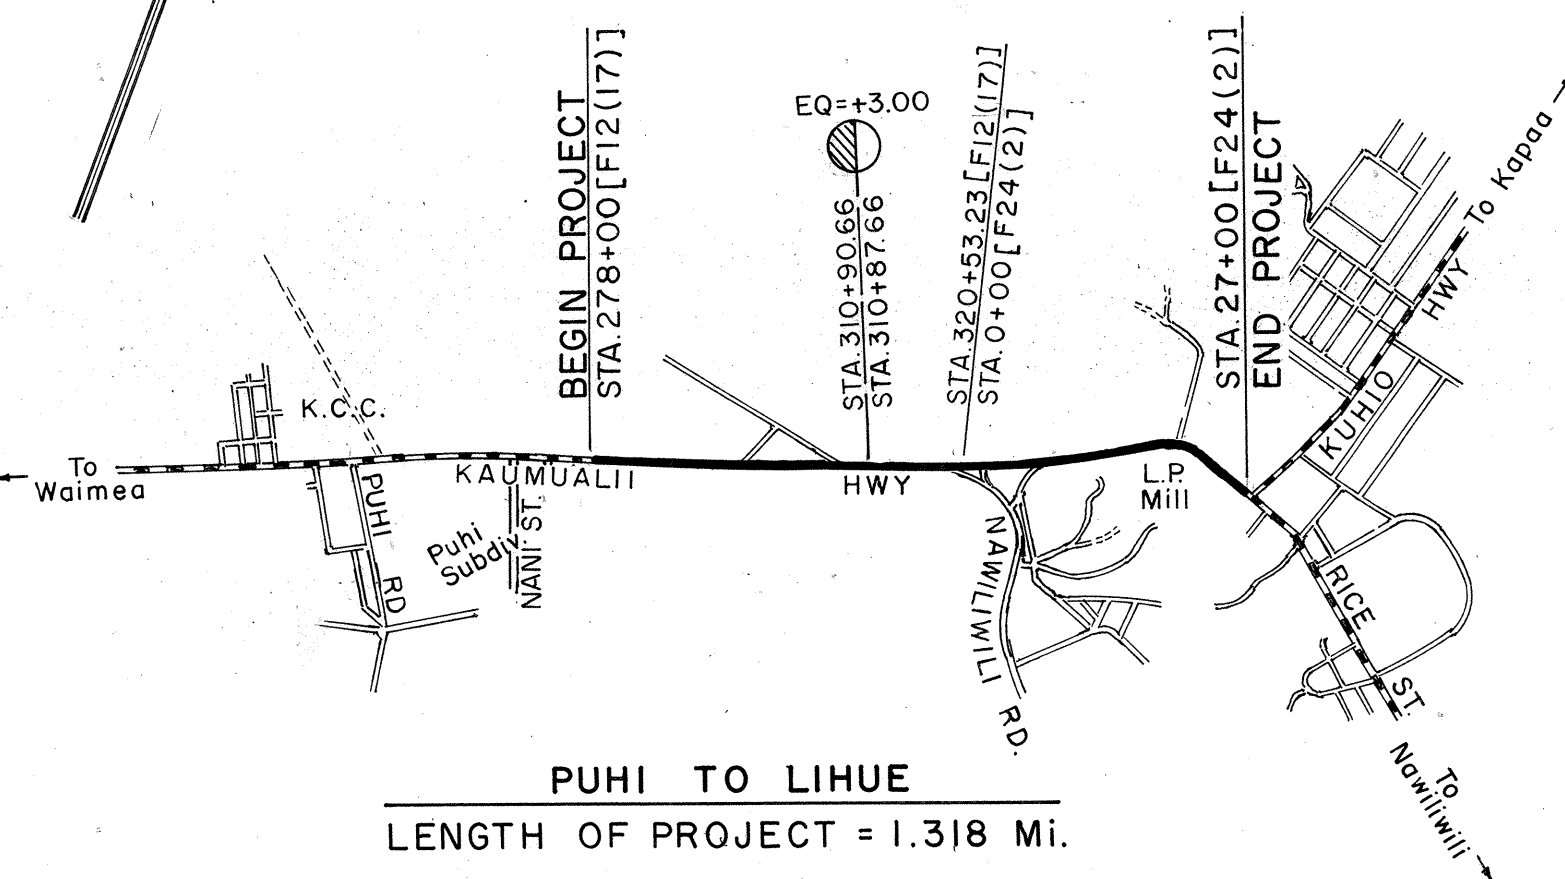

PUHI TO LIHUE
LENGTH OF PROJECT = 1.318 MI.

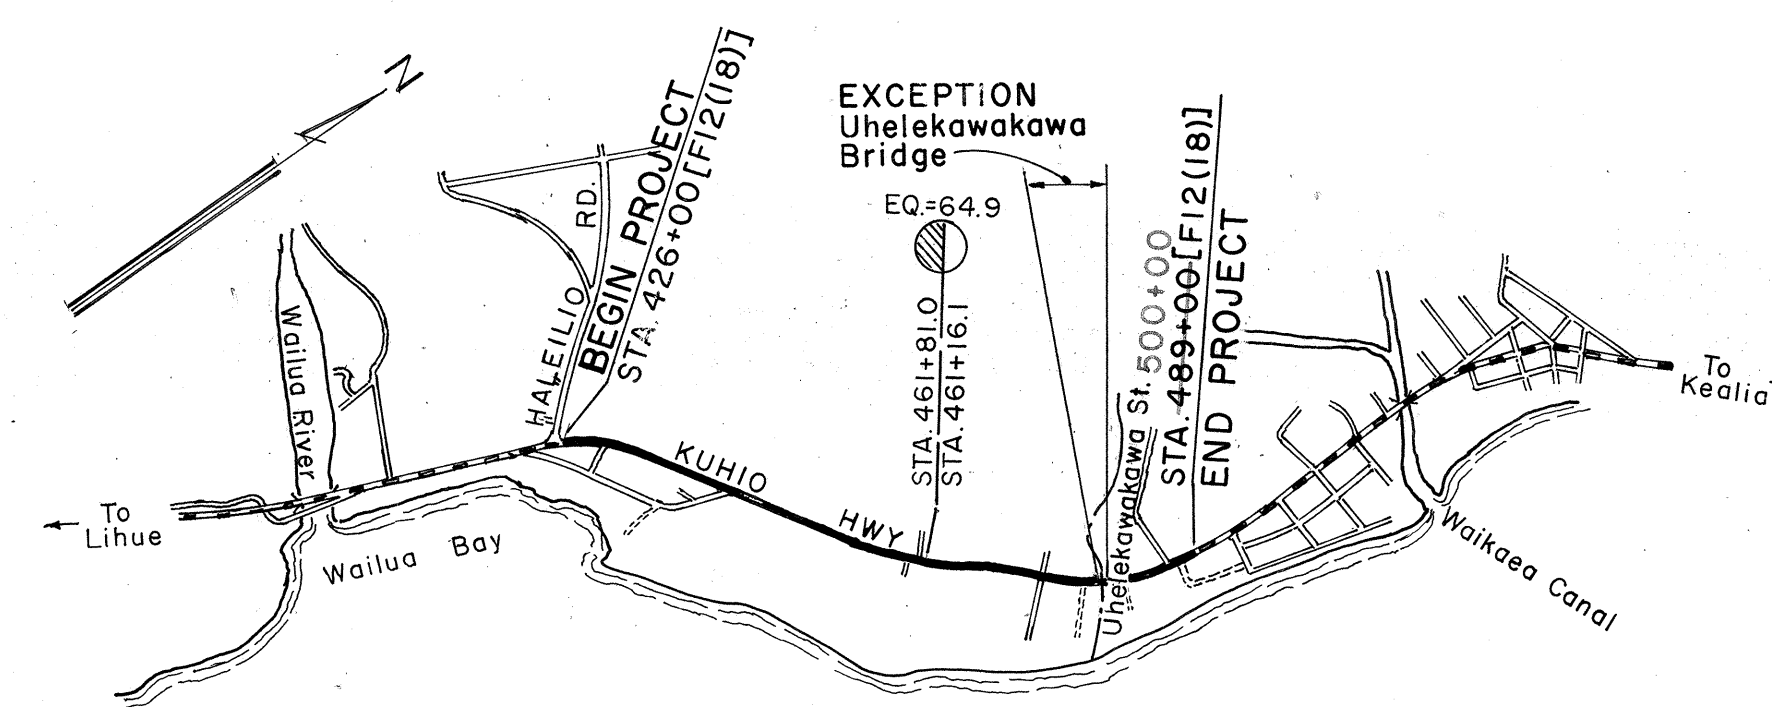

WAILUA TO WAIPOULI
LENGTH OF PROJECT = 1.205 MI.

LAYOUT OF PROJECTS
SCALE: 1" = 2000'

DEPARTMENT OF TRANSPORTATION STATE OF HAWAII	
APPROVED:	
<i>R. Higashimura</i>	11/6/77
DIR. OF TRANSPORTATION	DATE