


FED. ROAD DIST. NO.	STATE	PROJ. NO.	FISCAL YEAR	SHEET NO.	TOTAL SHEETS
HAWAII	HAW.	LT-K-04-78	1978	3	6

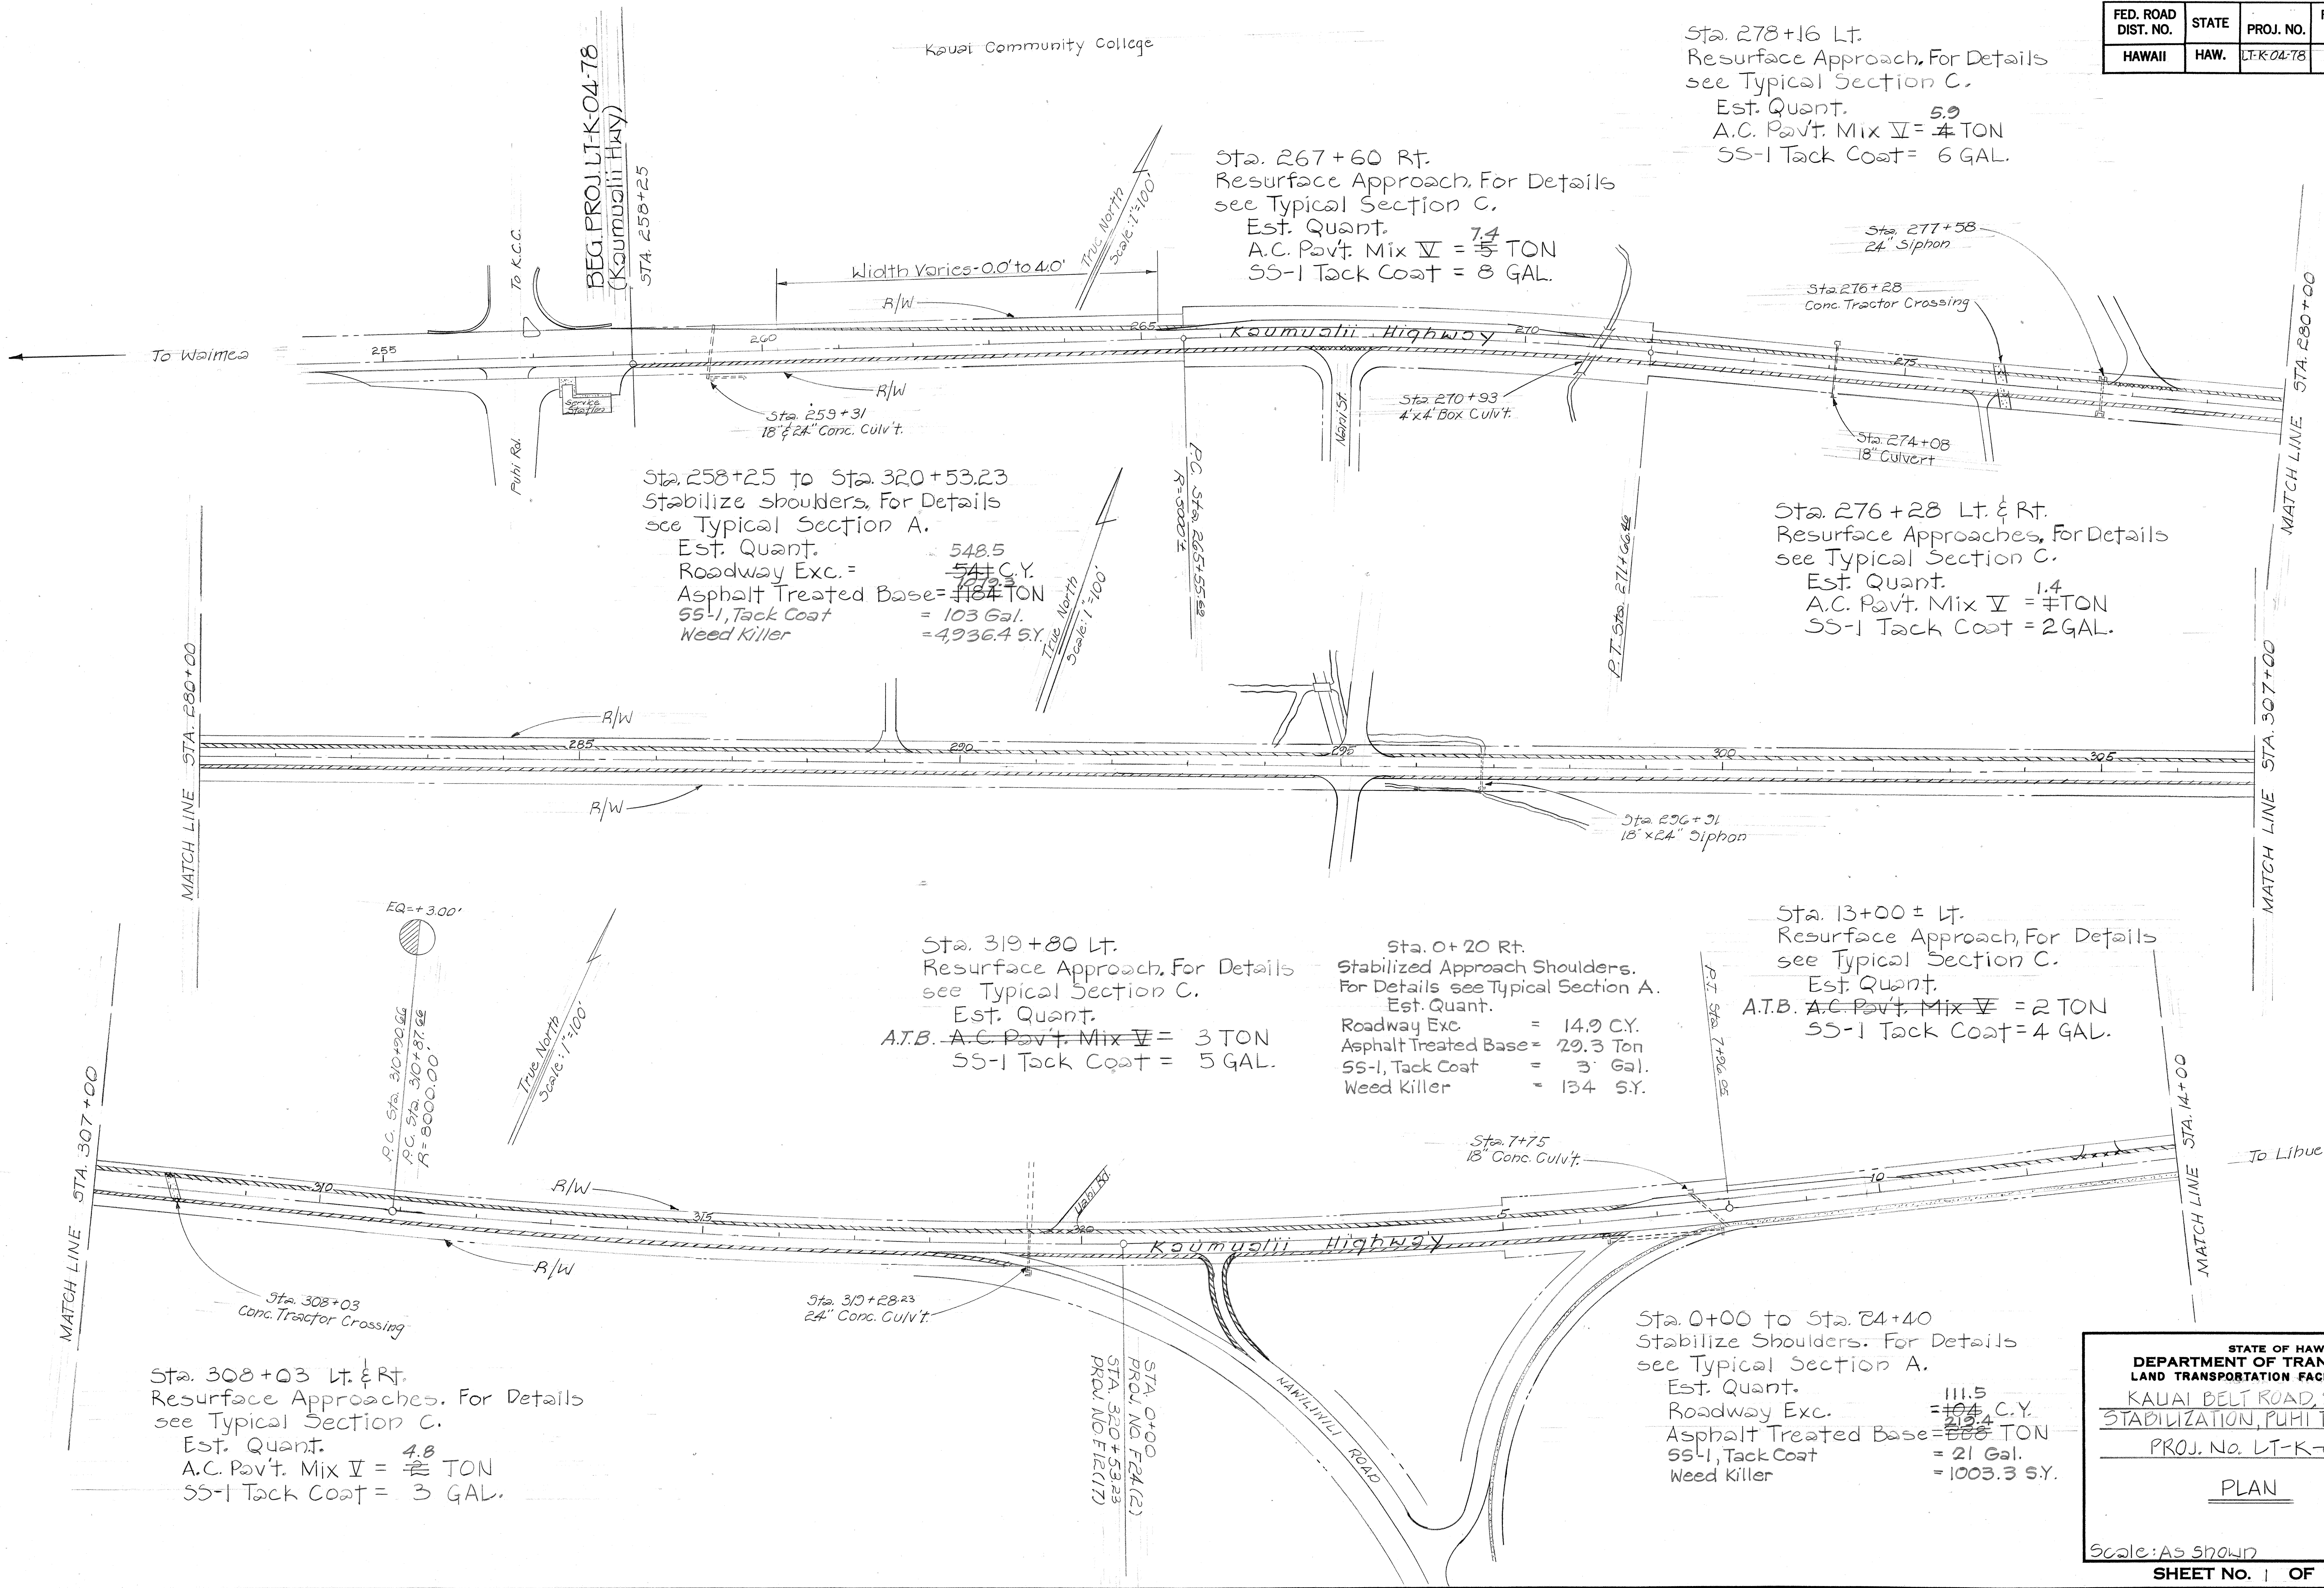


SURVEY PLOTTED BY	DATE
DRAWN BY	
DESIGNED BY	
NOTED BY	
CREATED BY	
ORIGINAL PLAN	
NOTE BOOK	
No.	

STATE OF HAWAII
DEPARTMENT OF TRANSPORTATION
LAND TRANSPORTATION FACILITIES DIVISION
KAUAI BELT ROAD, SHOULDER
STABILIZATION, PUHI TOWARD KAPAA
PROJ. No. LT-K-04-78
PLAN
Scale: AS SHOWN
Feb. 1978
SHEET NO. 1 OF 3 SHEETS

3

FED. ROAD DIST. NO.	STATE	PROJ. NO.	FISCAL YEAR	SHEET NO.	TOTAL SHEETS
HAWAII	HAW.	LT-K-04-78	1978	4	6

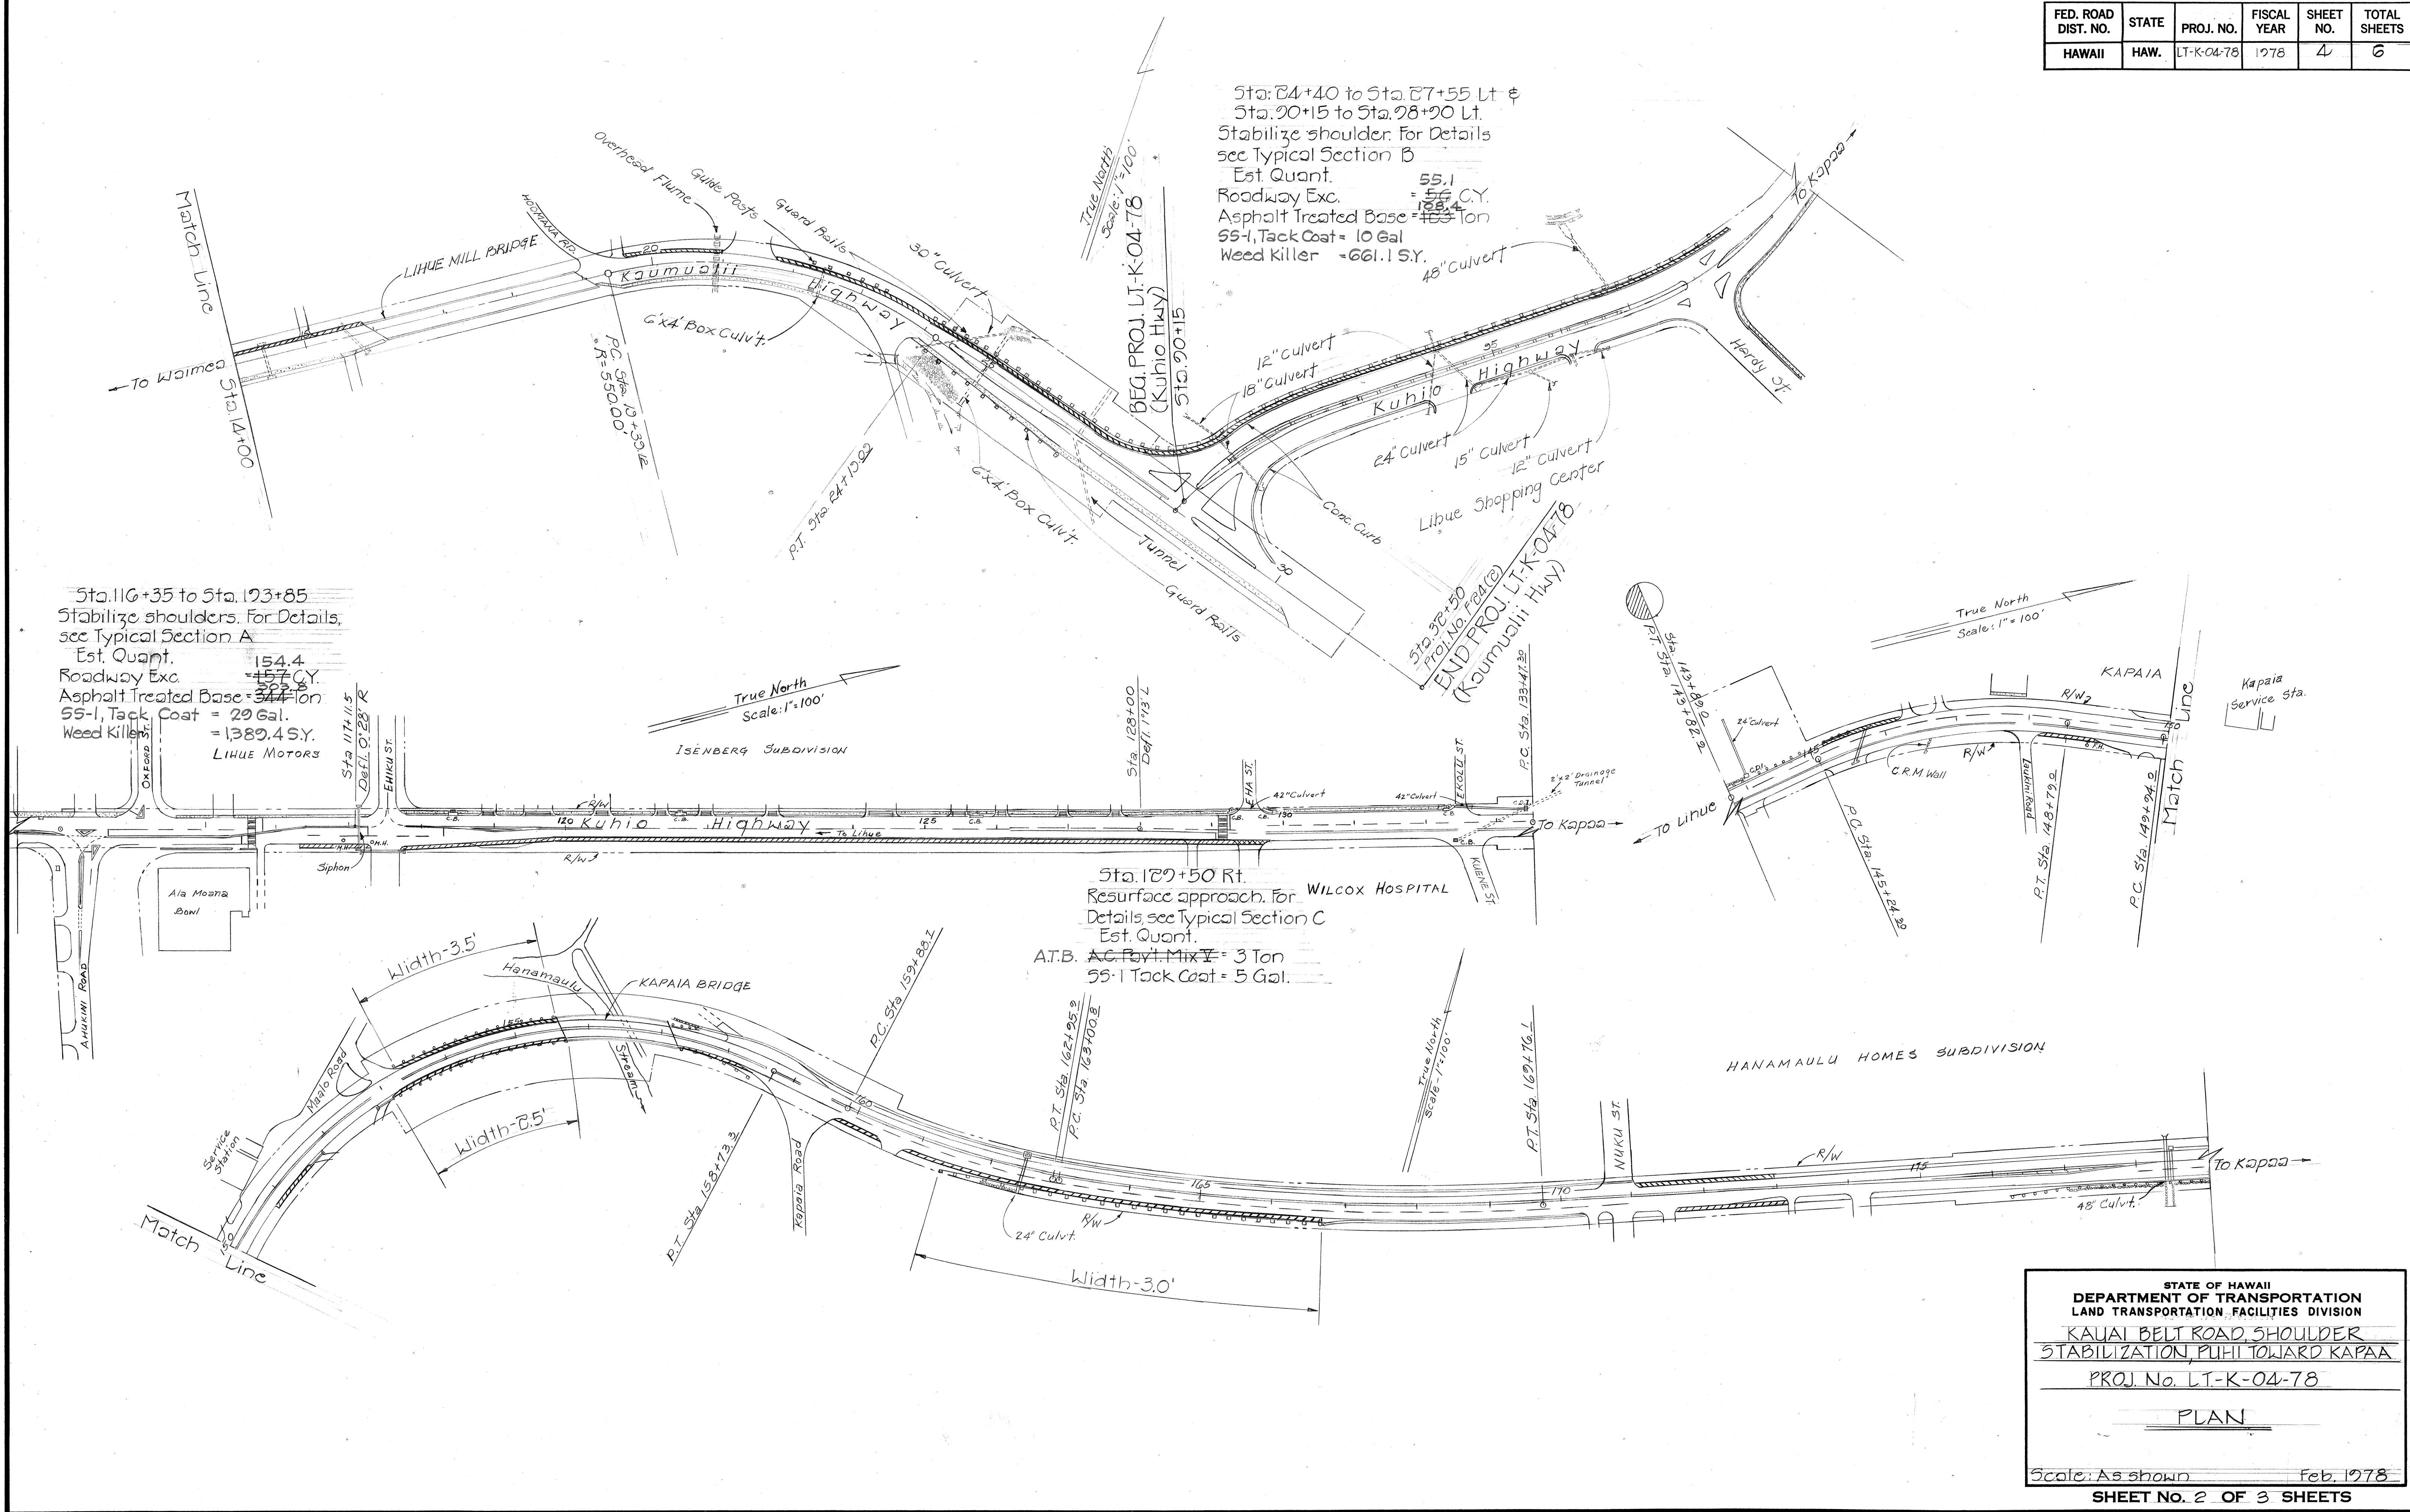

DATE	_____
SURVEY PLOTTED BY	_____
DRAWN BY	_____
DESIGNED BY	_____
CHECKED BY	_____
NOTE BOOK	_____
No.	_____

STATE OF HAWAII
DEPARTMENT OF TRANSPORTATION
LAND TRANSPORTATION FACILITIES DIVISION

KAUAI BELT ROAD SHOULDER
STABILIZATION, PUHI TOWARD KAPAA

PROJ. No. LT-K-04-78

PLAN

Scale: As shown Feb. 1978

SHEET No. 2 OF 3 SHEETS

FED. ROAD DIST. NO.	STATE	PROJ. NO.	FISCAL YEAR	SHEET NO.	TOTAL SHEETS
HAWAII	HAW.	LT-K-0478	1978	5	6

Sta. 205+30 Lt.
Resurface approach. For Details, see Typical Section C
Est. Quant.
A.T.B. A.C. Pavt. Mix V = 2 Ton
55-1 Tack Coat = 4 Gal.

Sta. 203+00 to Sta. 234+00
Stabilize shoulders. For Details, see Typical Section A
Est. Quant.
Roadway Exc. = 302.6
Asphalt Treated Base = 598 Ton 595.4
55-1, Tack Coat = 57 Gal.
Weed Killer = 2723.1 S.Y.

Sta. 233+10 Lt.
Resurface approach. For Details, see Typical Section C
Est. Quant.
A.T.B. A.C. Pavt. Mix V = 3 Ton
55-1 Tack Coat = 5 Gal.

Sta. 242+15 to Sta. 322+27 Lt.
Sta. 241+65 to Sta. 307+00 321+00 Rt.
Stabilize shoulders. For Details, see Typical Section A
Est. Quant.
Roadway Exc. = 687 C.Y. 767.2
Asphalt Treated Base = 1378 Ton 1509.7
55-1, Tack Coat = 144 Gal.
Weed Killer = 6904.89 S.Y.

Sta. 229+15 Rt.
Resurface approach. For Details, see Typical Section C
Est. Quant.
A.T.B. A.C. Pavt. Mix V = 2 Ton
55-1 Tack Coat = 3 Gal.

Sta. 306+65 Rt.
Resurface approach. For Details, see Typical Section C
Est. Quant.
A.T.B. A.C. Pavt. Mix V = 2 Ton
55-1 Tack Coat = 4 Gal.

STATE OF HAWAII
DEPARTMENT OF TRANSPORTATION
LAND TRANSPORTATION FACILITIES DIVISION

KAUAI BELT ROAD, SHOULDER
STABILIZATION, PUHI TOWARD KAPAA

PROJ. No. LT-K-04-78

PLAN

Scale: As Shown Feb 1978

SHEET NO. 3 OF 3 SHEETS

ORIGINAL PLAN	SURVEY PLOTTED BY	DATE
TRACED BY		
DESIGNED BY		
QUANTITIES BY		
CHECKED BY		

