


FED. ROAD DIST. NO.	STATE	PROJ. NO.	FISCAL YEAR	SHEET NO.	TOTAL SHEETS
HAWAII	HAW.	LT-K-01-79M	1979	4	5

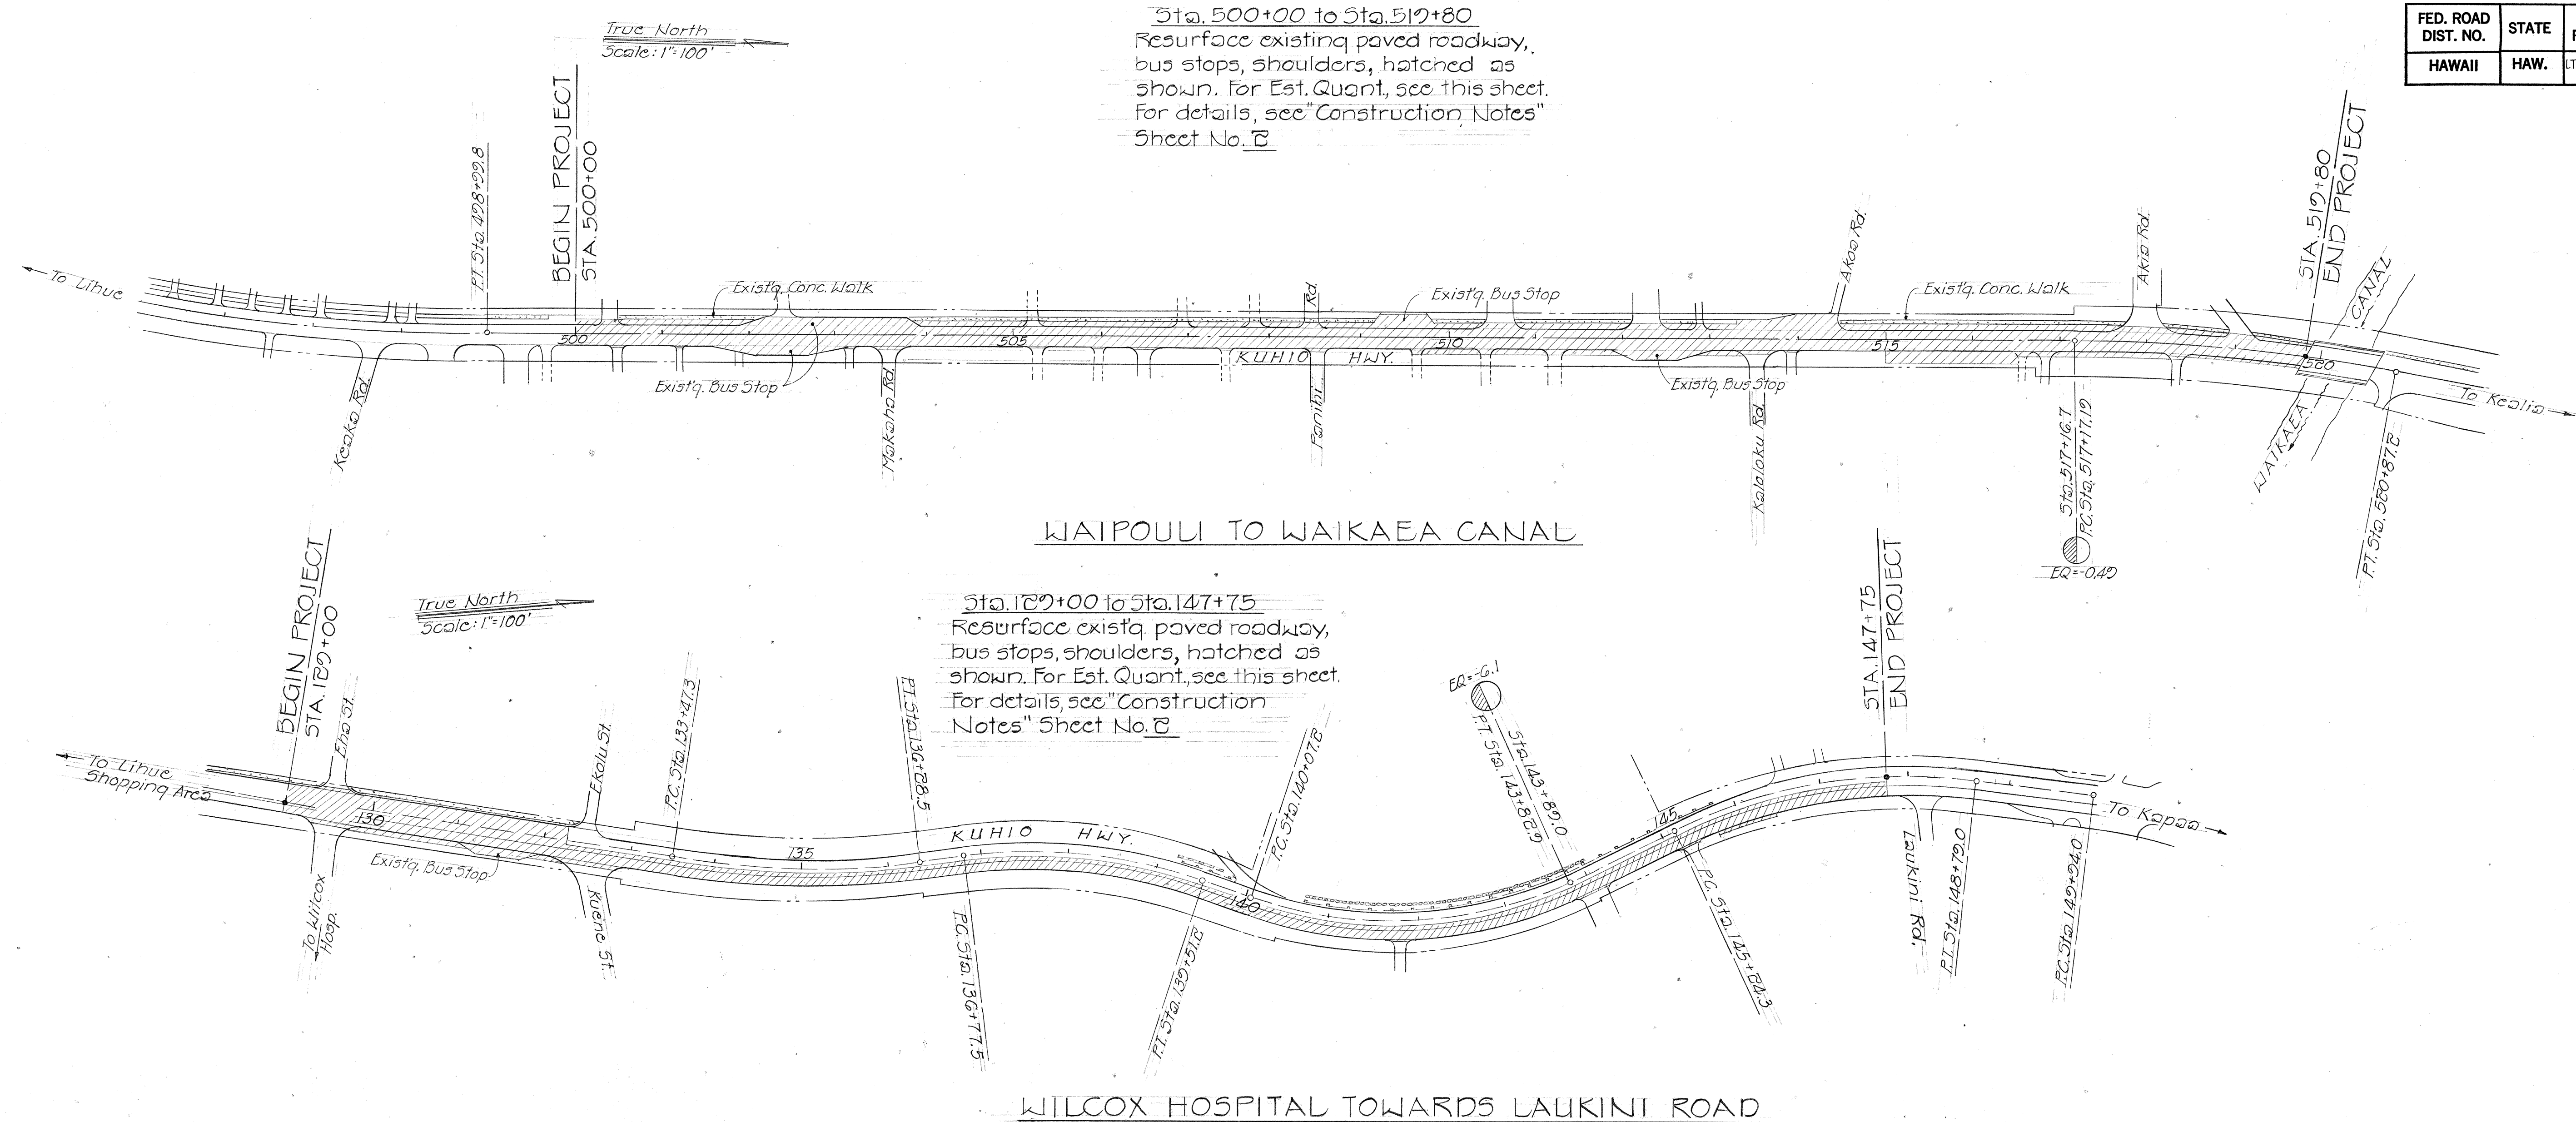

EST. QUANT.

WILCOX HOSPITAL TOWARDS LAUKINI RD.

A.C. Pav't. Mix V	= 400 Ton 376.8
SS-I Tack Coat	= 780 Gal. 702
Adjusting M.H. Frame & Cover	= 1 Ea.
Adjusting W.V. Frame & Cover	= 9 Ea. 10

WAIPOULI TO WAIKAEA CANAL

A.C. Pav't. Mix V	= 700 Ton 652.7
SS-I Tack Coat	= 1380 Gal. 1170
Adjusting W.V. Frame & Cover	= 5 Ea.

HANAPEPE

A.C. Pav't. Mix V	= 960 Ton 1082.7
SS-I Tack Coat	= 1700 Gal. 2816

ELEELE

Aggregate Base Course	= 35 C.Y. 0
A.C. Pav't. Mix V	= 530 Ton 565.1
SS-I Tack Coat	= 850 Gal. 550
A.C. Curb Type G	= 980 L.F. 0

WAIHAWA TO KALAHEO

A.C. Pav't. Mix V	= 860 Ton 840.6
SS-I Tack Coat	= 1550 Gal. 1502
Adjusting M.H. Frame & Cover	= 2 Ea.
Adjusting W.V. Frame & Cover	= 2 Ea.

NAWILIWILI RD. TO LALA RD.

A.C. Pav't. Mix V	= 150 Ton 139.5
SS-I Tack Coat	= 260 Gal. 262

AHUKINI RD.

A.C. Pav't. Mix V	= 2650 Ton 2604.7
SS-I Tack Coat	= 4650 Gal. 4652

ANAHOLA TOWARDS PAPAA

A.C. Pav't. Mix V	= 600 Ton 652.7
SS-I Tack Coat	= 1085 Gal. 1449

KEALIA TOWARDS ANAHOLA

A.C. Pav't. Mix V	= 677.0 Ton
SS-I Tack Coat	= 1568 Gal.

LOCATION OF M.H.'s & W.V.'s

WILCOX HOSPITAL TO LAUKINI RD.

Sta. 126+50 Rt. 1 W.V.'s	Sta. 130+25 Rt. 1 W.V.
Sta. 126+50 Lt. 1 M.H.	Sta. 130+55 Rt. 1 W.V.
Sta. 132+80 Rt. 3 W.V.'s	Sta. 133+05 Rt. 1 W.V.
Sta. 143+95 Rt. 4 W.V.'s	Sta. 133+25 Rt. 1 W.V.
	Sta. 133+45 Rt. 1 W.V.

WAIPOULI TO WAIKAEA CANAL

Sta. 508+30 Lt. 1 W.V.
Sta. 508+50 Rt. 1 W.V.
Sta. 513+70 Lt. 2 W.V.'s
Sta. 514+40 Lt. 1 W.V.

WAIHAWA TO KALAHEO

Sta. 4+75 Rt. 2 W.V.
Sta. 5+10 Rt. 2 M.H.

AHUKINI RD.

Sta. 2+45 Lt. 2 W.V.
Sta. 5+90 Lt. 1 W.V.
Sta. 8+90 Lt. 1 W.V.
Sta. 10+00 Lt. 1 W.V.

STATE OF HAWAII
DEPARTMENT OF TRANSPORTATION
LAND TRANSPORTATION FACILITIES DIVISION
RESURFACING STATE HIGHWAYS
VARIOUS LOCATIONS

PROJ. No. LT-K-01-79M

PLANS & EST. QUANT.

Scale: As Shown May 1978

SHEET NO. 1 OF 1 SHEETS